


Duct to roof


Extracted air from  
Kitchen below



New Air Ducting

New Fan Location

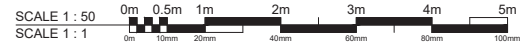

AS BUILT ROOF PLAN

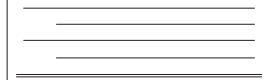

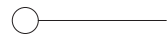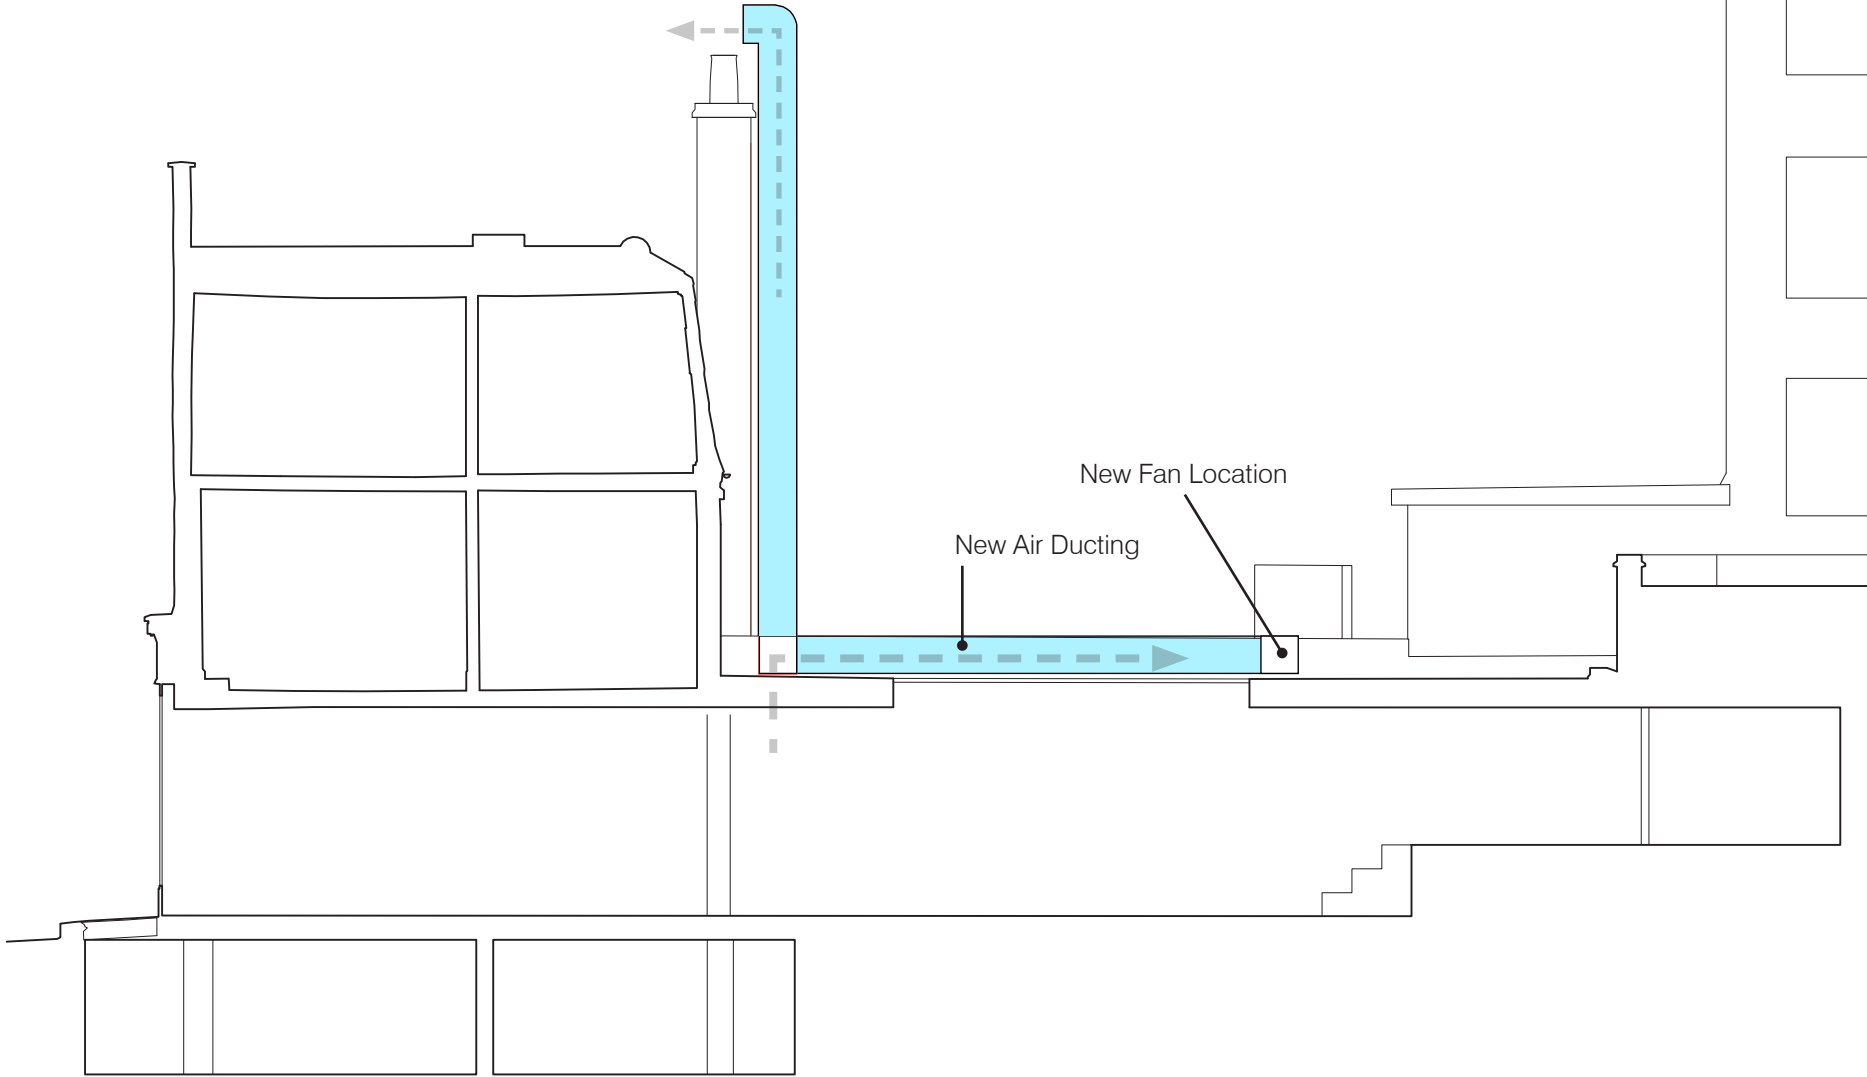

SCALE 1 : 50  
SCALE 1 : 1

0m 0.5m 1m 2m 3m 4m 5m  
0m 10mm 20mm 40mm 60mm 80mm 100mm

AS BUILT SECTION

---

---

---

---