


PROPOSED COURTYARD ELEVATION ON D-D
1:50 @ A0

SCALE BAR 1:50 @ A0

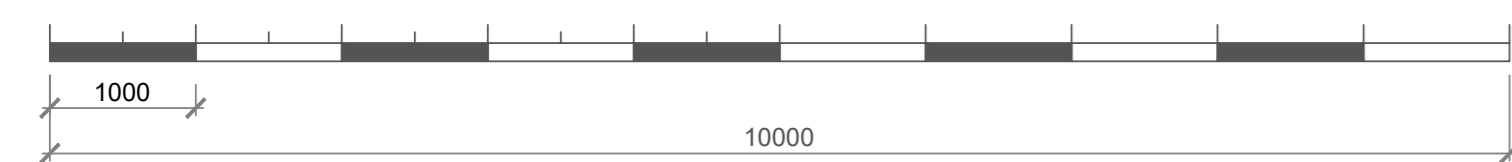

D1 01.08.19
TIMBER SCREEN ADDED



LOCATION PLAN
1:250 @ A0

Rev	Description	Drawn by	Date
D	New higher screen added	AN	01.08.19
C	Plaster details updated	AN	11.07.19
B	Plaster details added	AN	09.07.19
A	First issue to WeWork for review	TK	20.07.18
-	Drawing first produced	LM	10.07.18
Pre-Design - Construction - As Built			

Client
WeWork

Client Contact
Account Manager

Site Address
125 KINGSWAY

Drawing Title
Proposed 1st Floor Courtyard Elevation On D-D

Designer/ Senior Tech. Designer / Project Manager
Claire Elliott / Jordan Reay

Scale
AsShown @ A0

Contract Number	Building	Floor	Detail	Revision
1128	01	ALL	PL13.4	D

1st floor,
322 High Holborn,
London, WC1V 7PB
T: +44 (0)20 7553 9500

© 2019. This drawing is the exclusive Copyright of Itb and may not be copied or handed to any Third parties without prior consent. All dimensions must be checked on site and not scaled from the drawing. All drawings and proposals are subject to approval by statutory authorities.