




SECTION D - 1 EXISTING ELEVATION OF BALUSTRADE
1:25 @ A0

13.08.19
HIGHER TIMBER SCREEN
ADDED


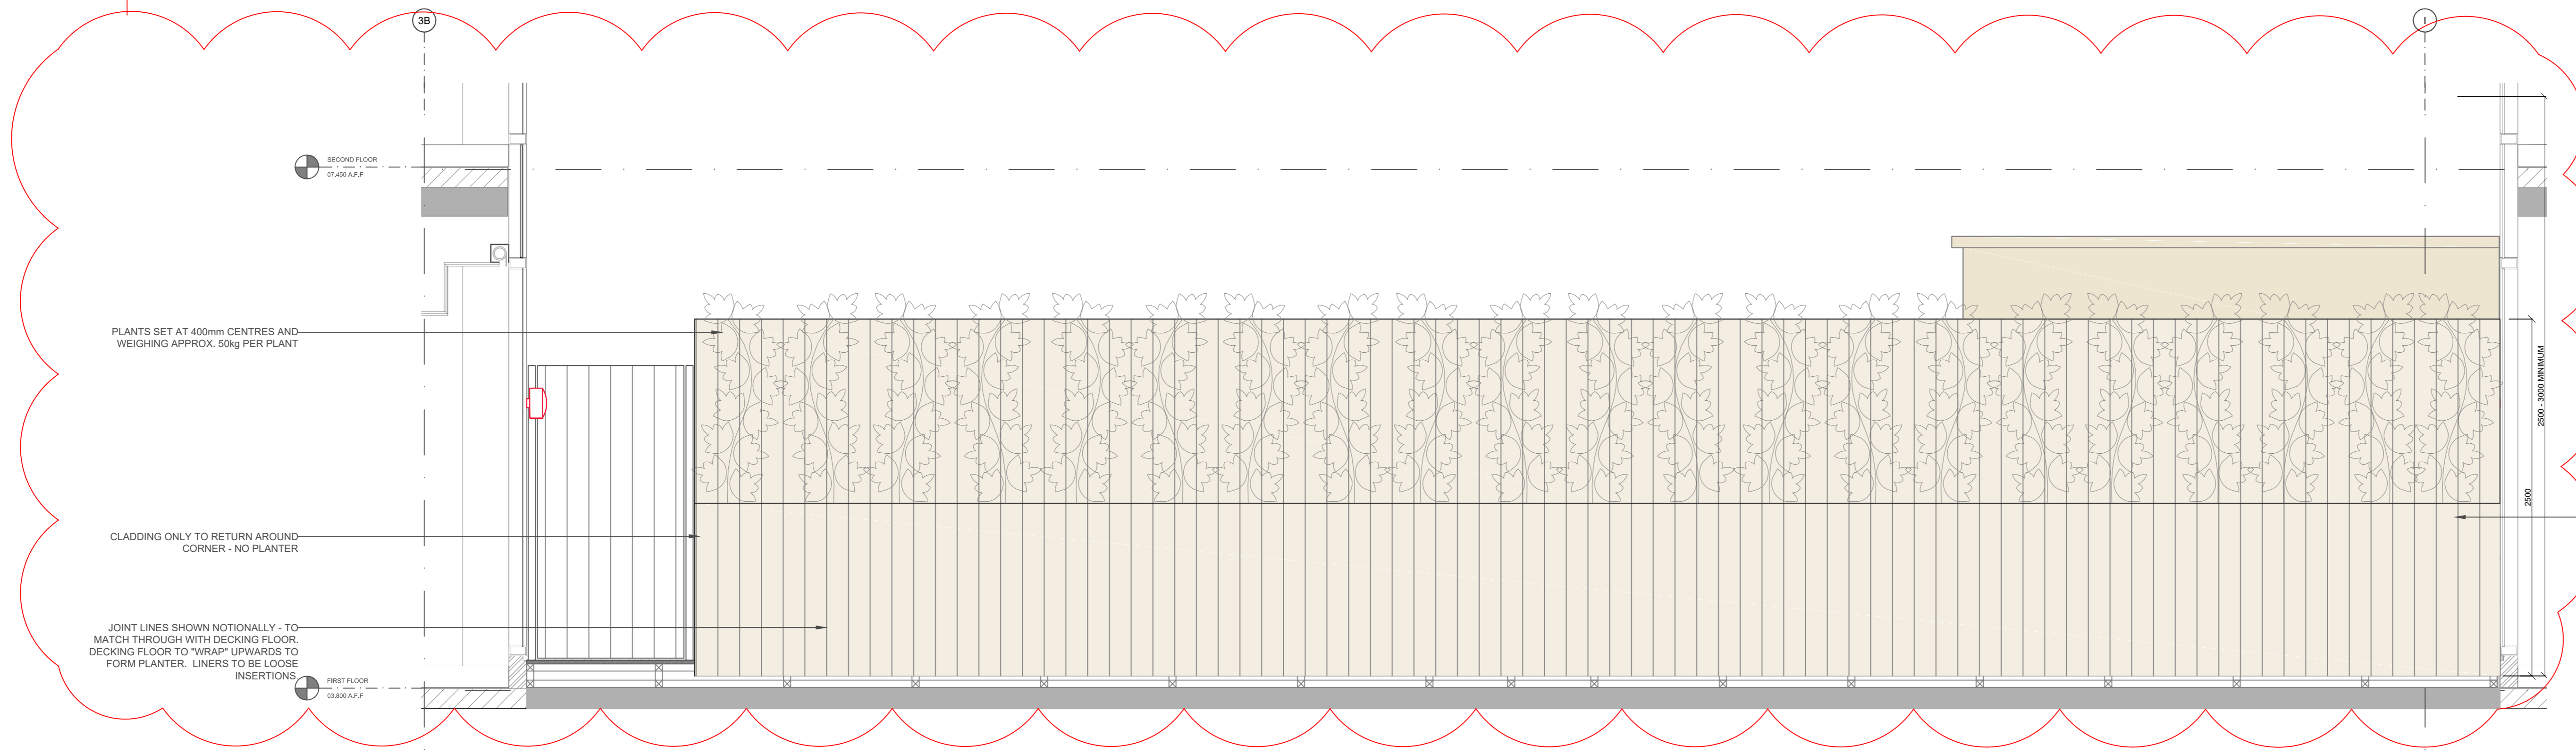


SECTION D - 2 PROPOSED ELEVATION OF BALUSTRADE
1:25 @ A0




SECTION D - 3 PROPOSED ELEVATION OF NEW TIMBER DOOR
1:25 @ A0

SCALE BAR 1:25 @ A0

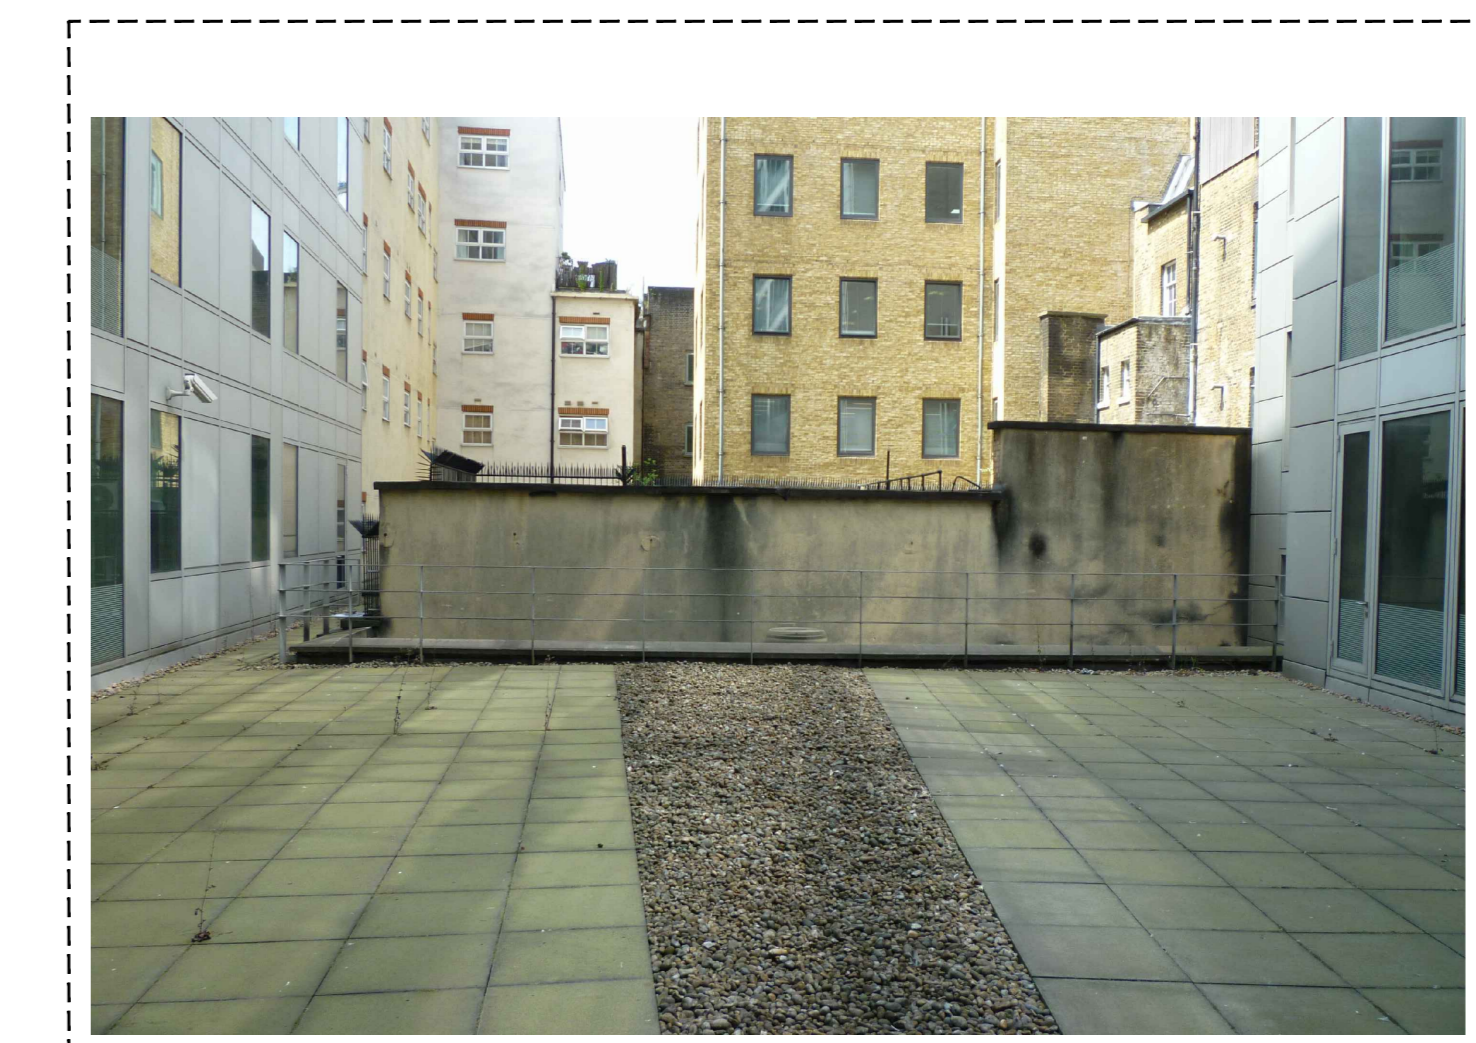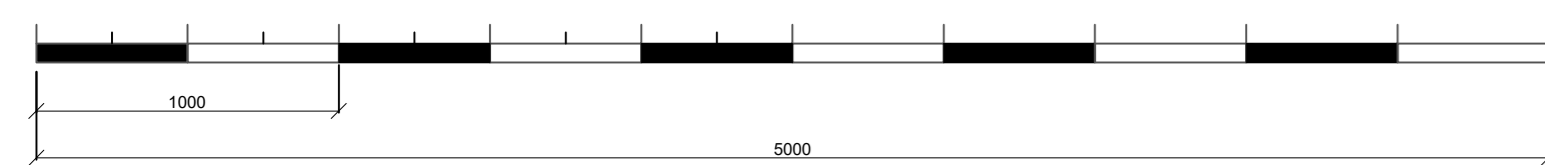

EXISTING SITE PHOTO

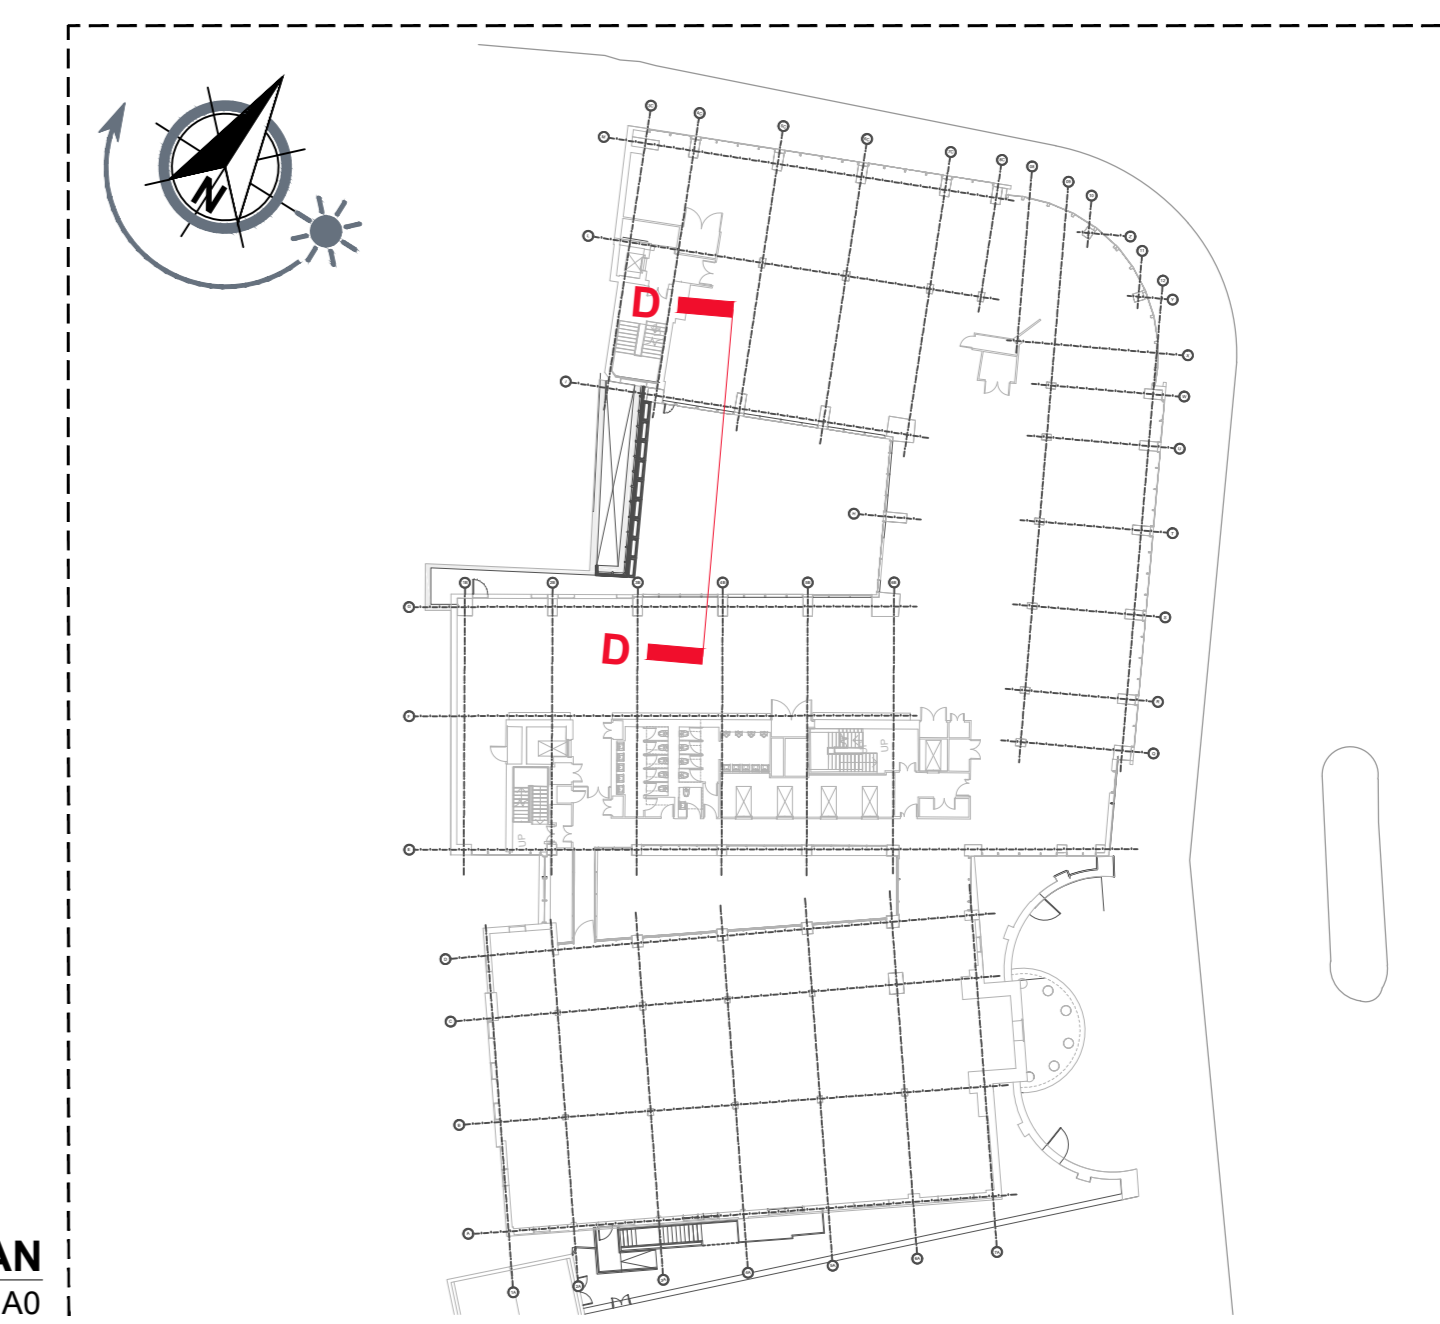

LOCATION PLAN
1:250 @ A0

Rev	Descriptive amendments	Drawn by	Date
-	Drawing first produced	LM	10.07.18
A	First issue to WeWork for review	TK	20.07.18
B	Plant screen added to form visual barrier	AN	09.07.19
C	Plant screen updated	AN	11.07.19
D	New higher screen added	AN	01.08.19
E	Planting amended	AN	13.08.19

Pro-Design - Construction - As Built
PLANNING

Client
WeWork

Client Contact
Site Address
125 KINGSWAY

Drawing Title
Details Of Proposed Balustrade - 1st Floor Courtyard
Account Manager

Designer Senior Tech. Designer / Project Manager
Claire Elliott / Jordan Reay

Scale
AsShown @ A0

Drawn By
LM

First Drawing Date
10/07/2018

Contract Number
1128

Building
01

Floor
ALL

Detail
PL-13.7

Revision
E

ltb. 1st floor,
322 High Holborn,
London, WC1V 7PB
T: +44 (0)20 7553 9500

NOTES: This drawing is the exclusive Copyright of ltb and may not be copied or handed to any Third parties without prior consent. All dimensions must be checked on site and not scaled from the drawing. All drawings and proposals are subject to approval by regulatory authorities.