


Drawings provided as a basis for these proposals are all previously approved (consented under ref: 2018/3788/P & 2018/4086/L)

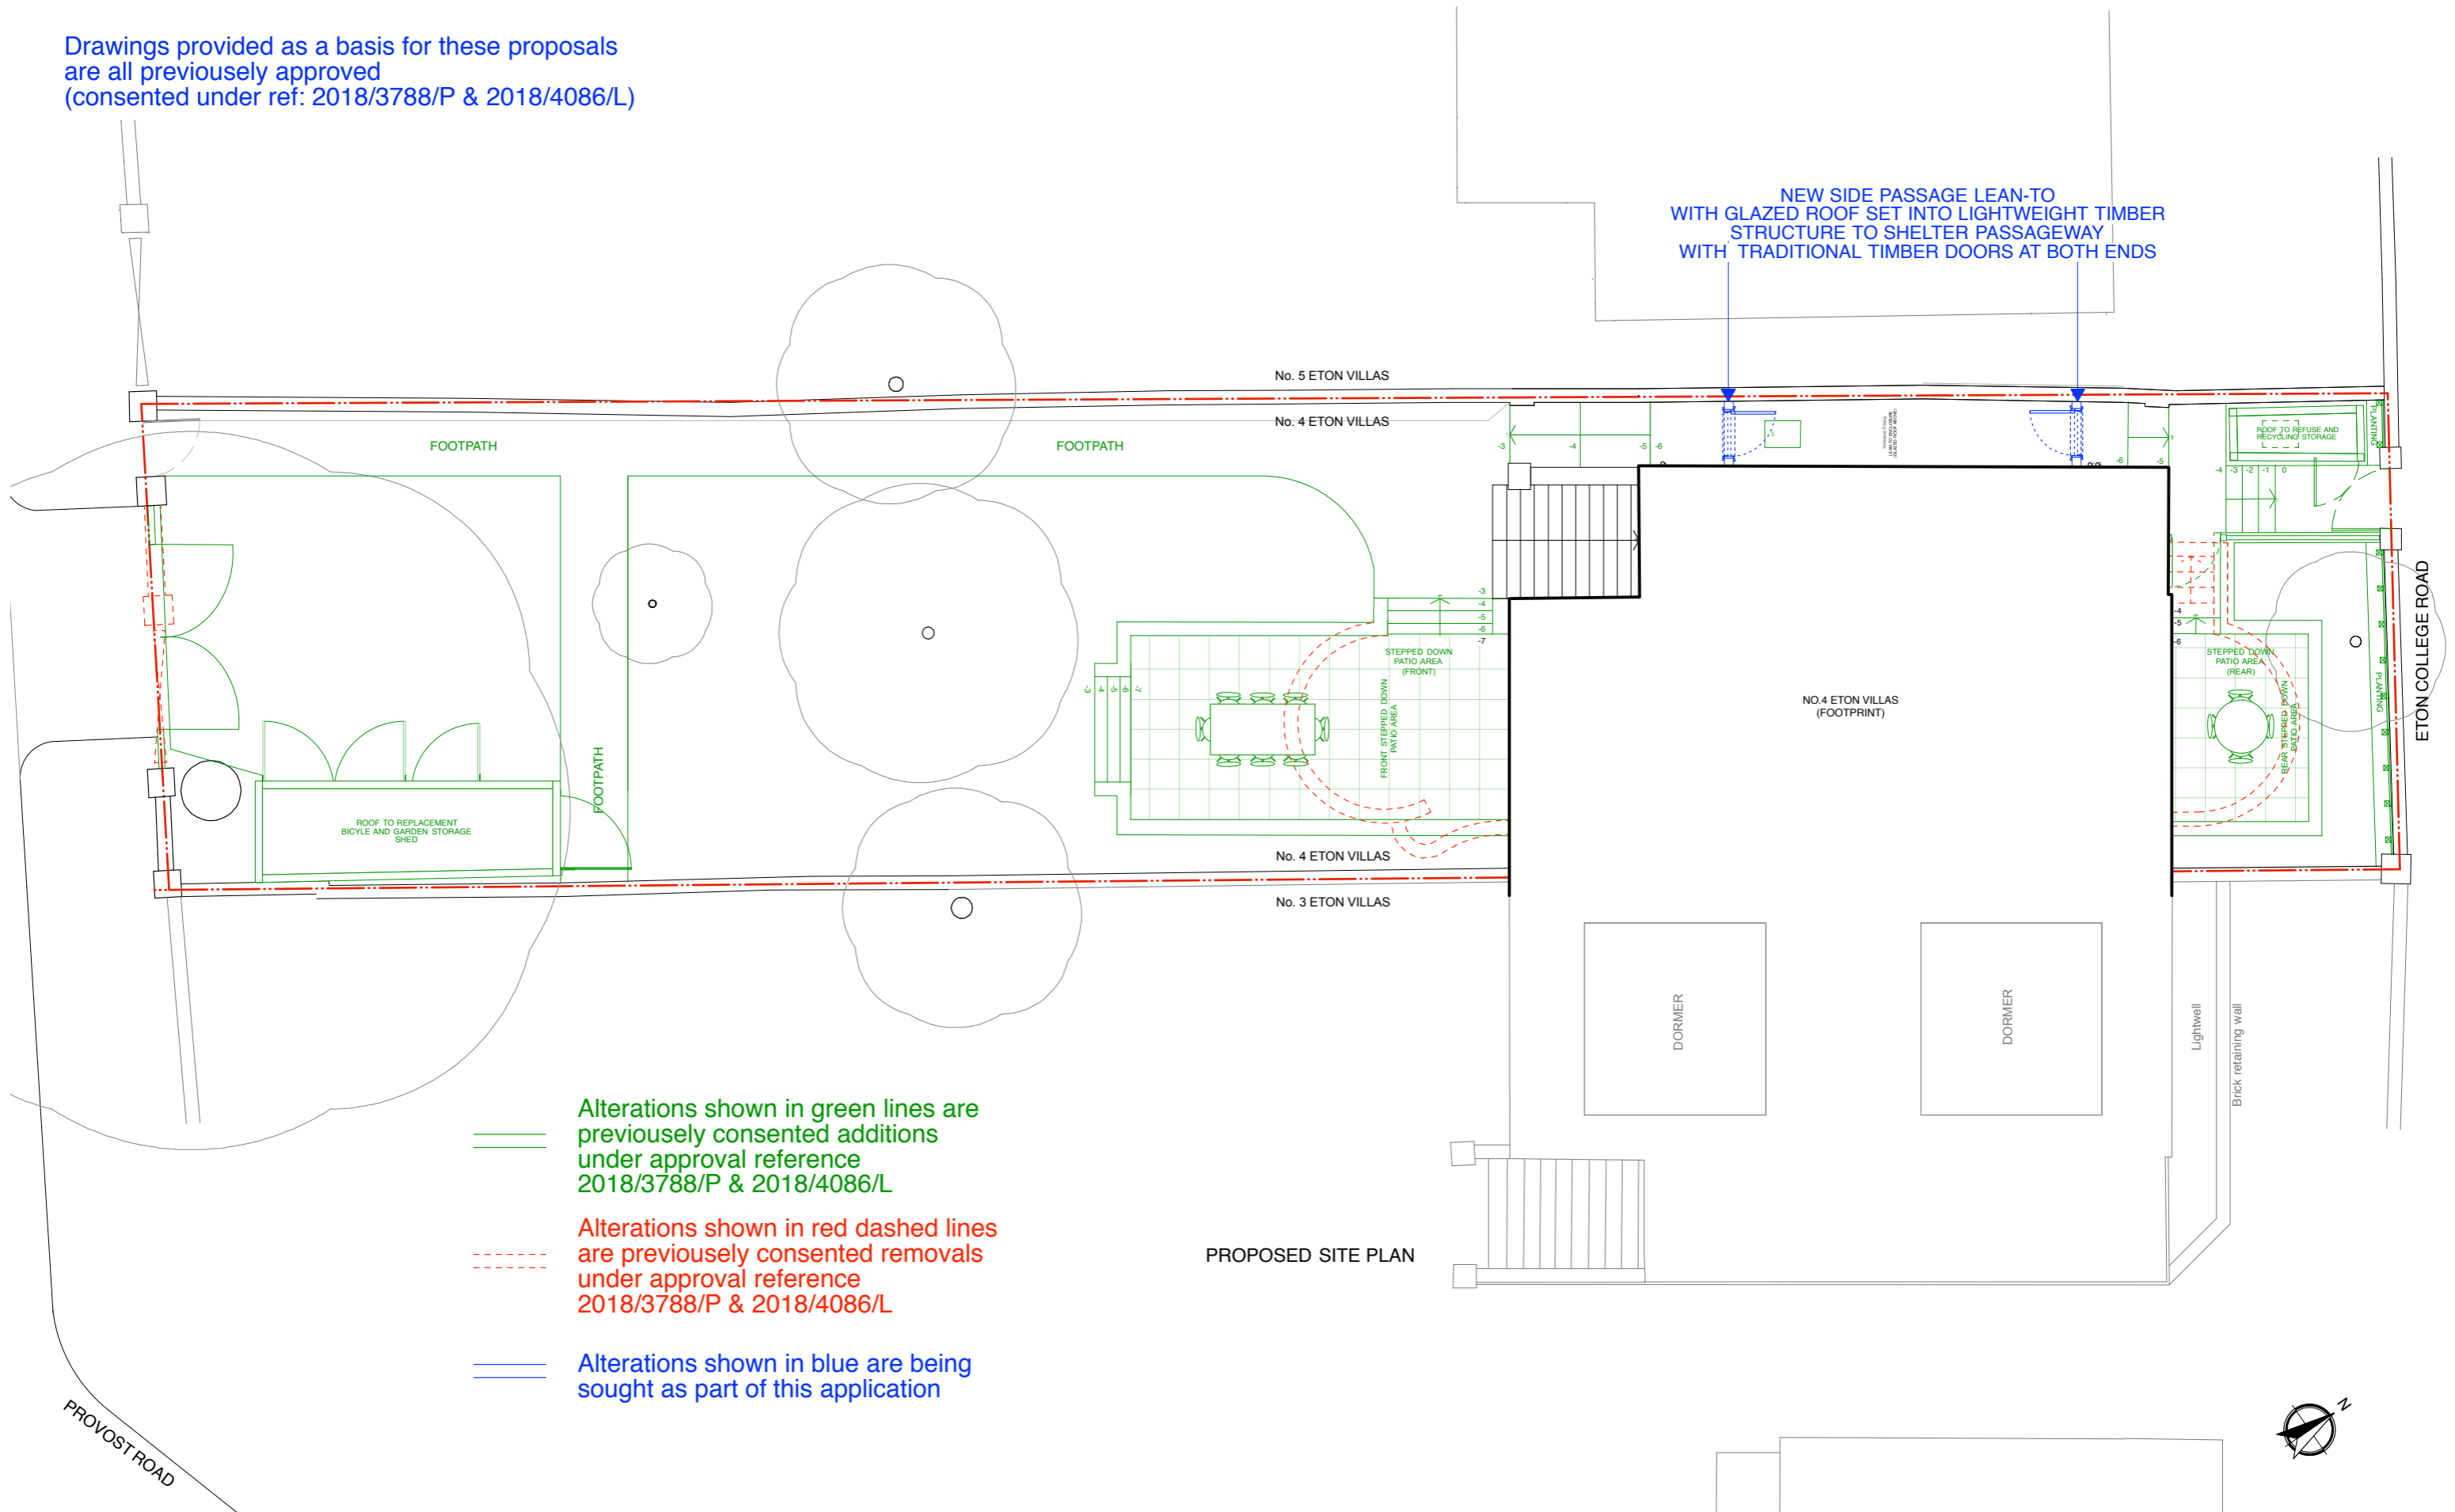


- Alterations shown in green lines are previously consented additions under approval reference 2018/3788/P & 2018/4086/L
- - - - - Alterations shown in red dashed lines are previously consented removals under approval reference 2018/3788/P & 2018/4086/L
- Alterations shown in blue are being sought as part of this application

PROPOSED SITE PLAN

PROVOST ROAD

ETON COLLEGE ROAD

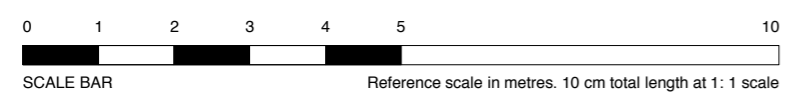


Rev.	Comments	Date

Project	NO. 4 ETON VILLAS • LONDON • NW3 4SX		
Drawing Title	PROPOSED SITE PLAN		
Dwg No.	430 / 101	Revision	
Scale	1:100 @ A3	Date	AUGUST 2019
		Drawn by	TW


ATELIERwest
 ARCHITECTURE / DESIGN / PROJECT MANAGEMENT
 SUITE 5 / 26 CADOGAN SQUARE / LONDON / SW1X 0JP
 INFO@ATELIERWEST.CO.UK / WWW.ATELIERWEST.CO.UK
 0203 587 7227
 07801 650 531

DO NOT SCALE FROM THIS DRAWING. USE FIGURED DIMENSIONS ONLY. ANY DISCREPANCIES ARE TO BE REPORTED TO AW IMMEDIATELY. PRIOR TO THE EXECUTION OF THE WORKS ON SITE ALL DIMENSIONS TO BE VERIFIED ON SITE BEFORE ANY WORK IS PUT IN HAND

Drawings provided as a basis for these proposals are all previously approved (consented under ref: 2018/3788/P & 2018/4086/L)

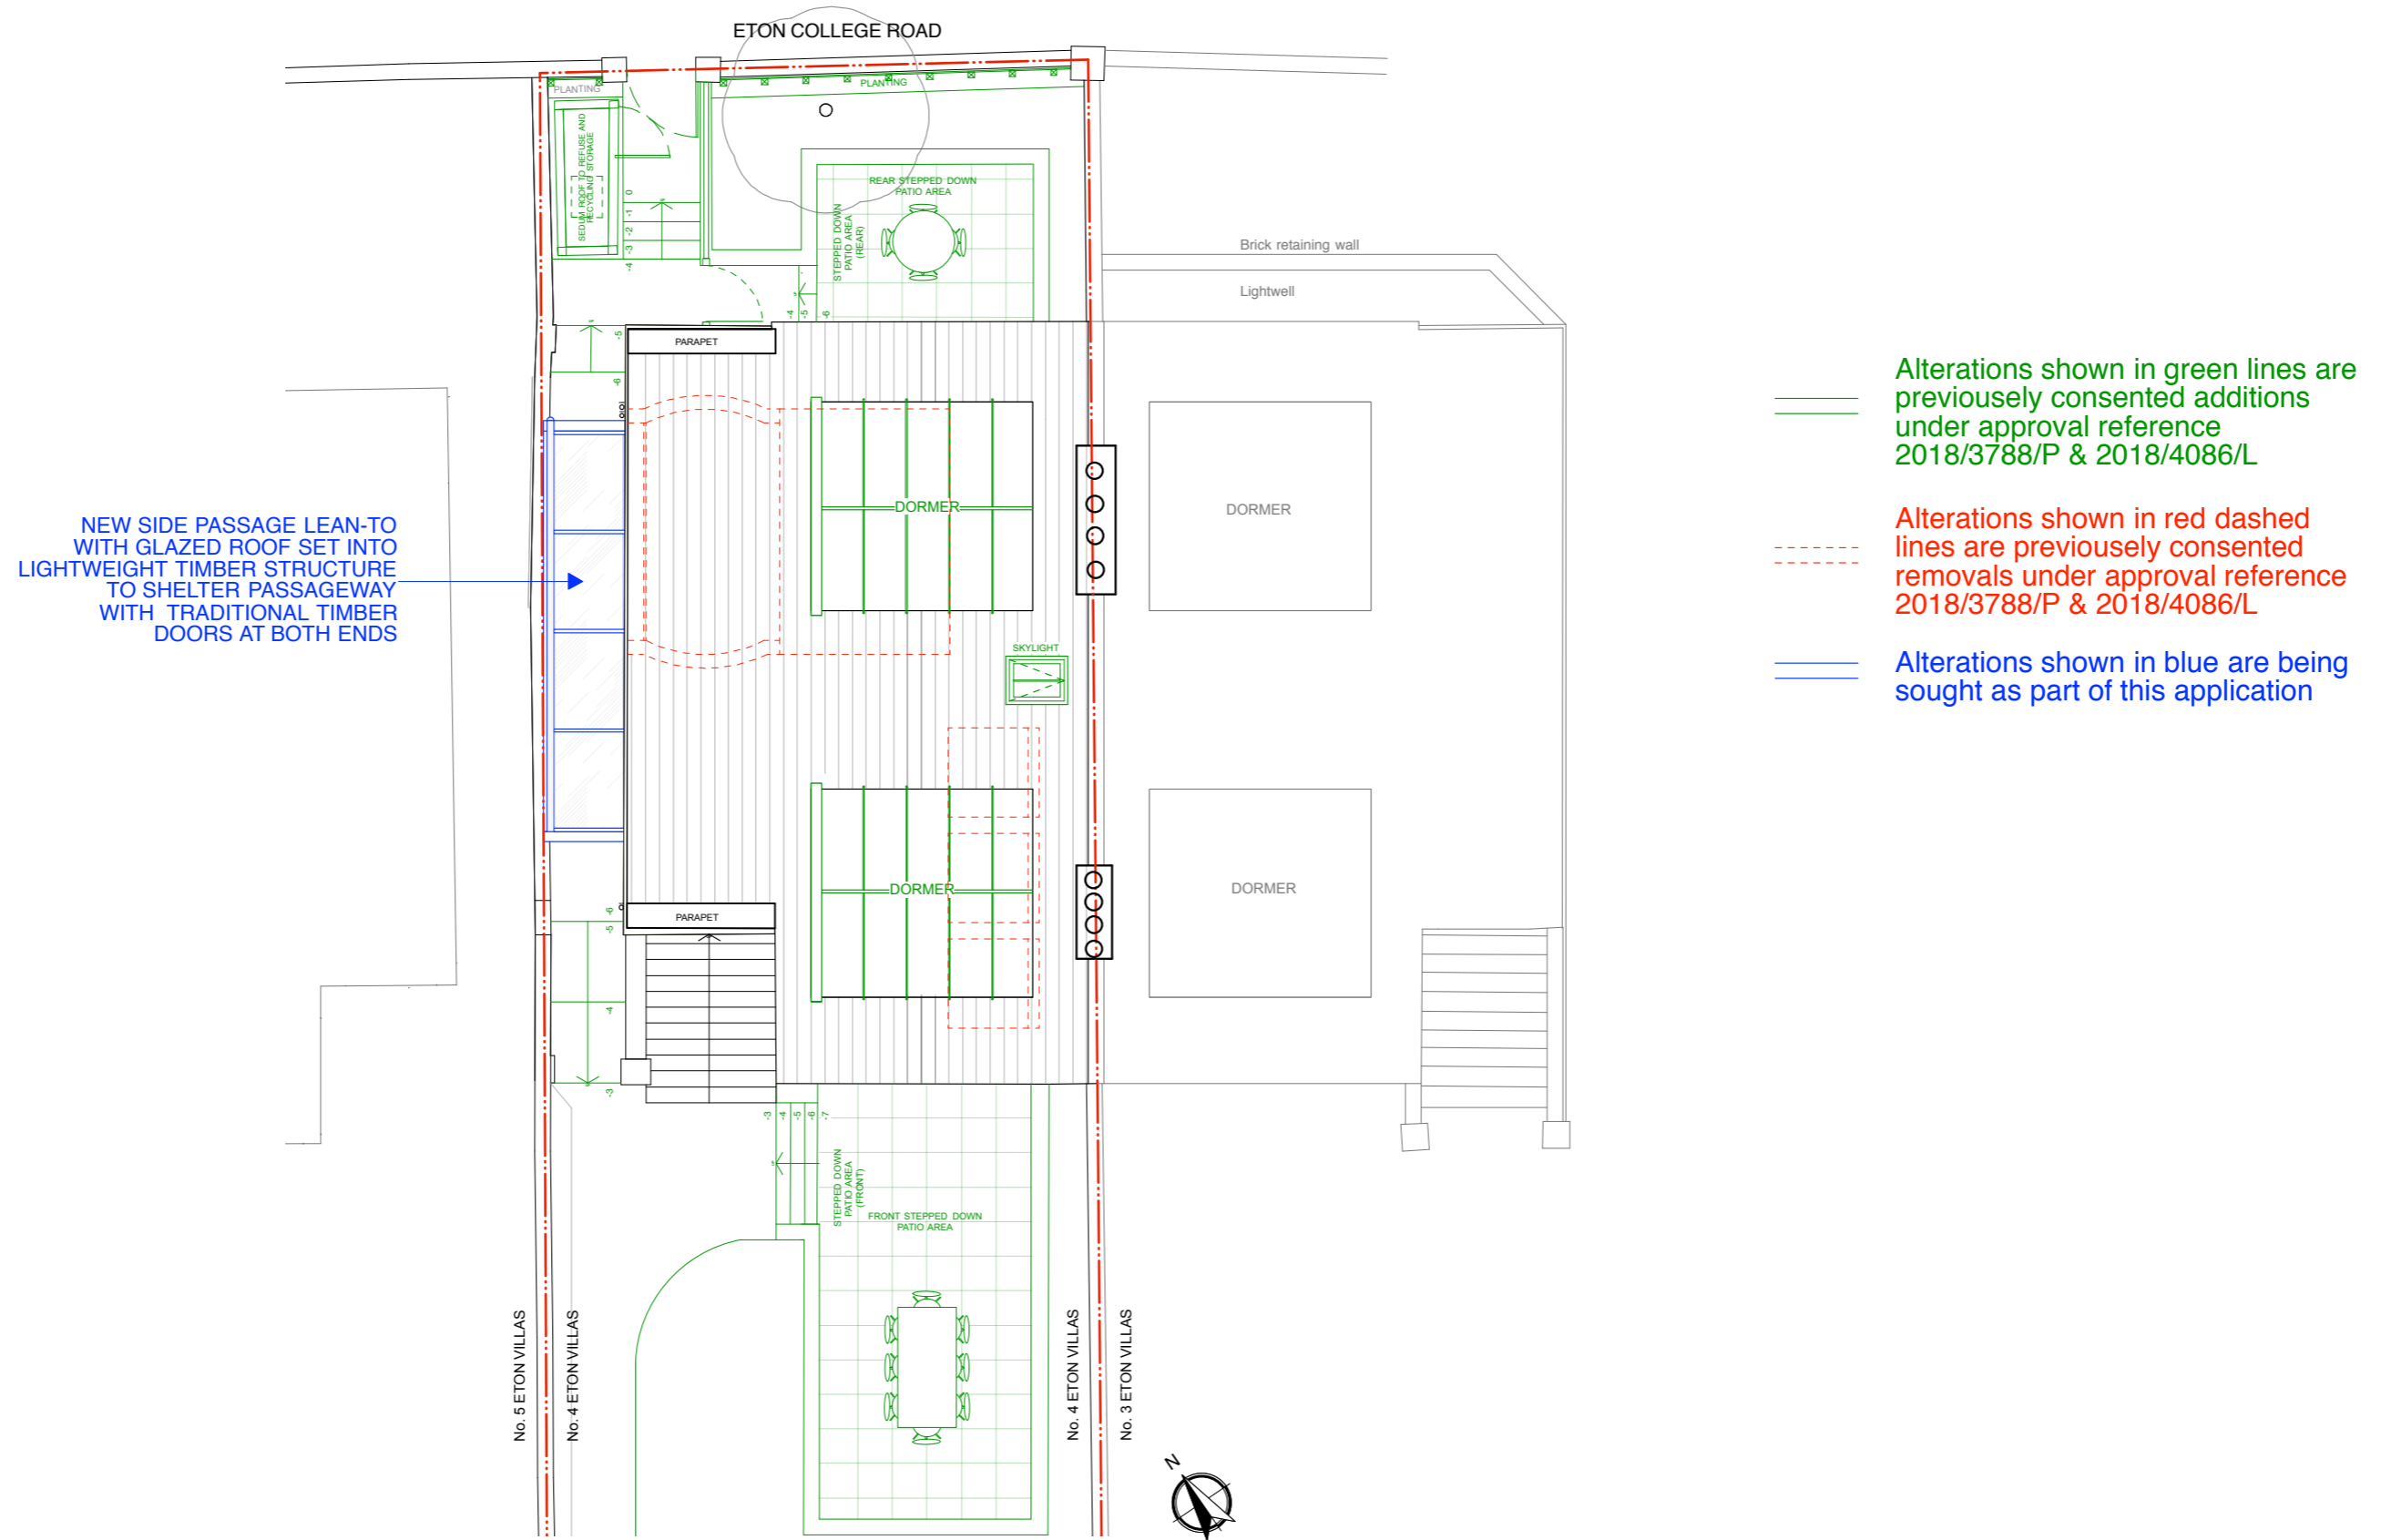

- Alterations shown in green lines are previously consented additions under approval reference 2018/3788/P & 2018/4086/L
- - - Alterations shown in red dashed lines are previously consented removals under approval reference 2018/3788/P & 2018/4086/L
- Alterations shown in blue are being sought as part of this application

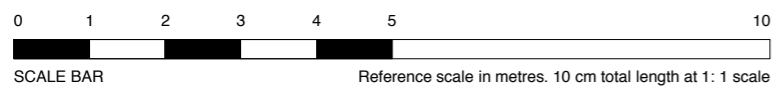

Rev. Comments Date

Project NO. 4 ETON VILLAS • LONDON • NW3 4SX
 Drawing Title PROPOSED ROOF PLAN
 Dwg No. 430 / 106 Revision
 Scale 1:100 @ A3 Date AUGUST 2019 Drawn by TW

ATELIERwest
 ARCHITECTURE / DESIGN / PROJECT MANAGEMENT
 SUITE 5 / 26 CADOGAN SQUARE / LONDON / SW1X 0JP
 INFO@ATELIERWEST.CO.UK / WWW.ATELIERWEST.CO.UK
 0203 587 7227
 07801 650 531


DO NOT SCALE FROM THIS DRAWING. USE FIGURED DIMENSIONS ONLY. ANY DISCREPANCIES ARE TO BE REPORTED TO AW IMMEDIATELY. PRIOR TO THE EXECUTION OF THE WORKS ON SITE ALL DIMENSIONS TO BE VERIFIED ON SITE BEFORE ANY WORK IS PUT IN HAND

Drawings provided as a basis for these proposals are all previously approved (consented under ref: 2018/3788/P & 2018/4086/L)



- Alterations shown in green lines are previously consented additions under approval reference 2018/3788/P & 2018/4086/L
- - - Alterations shown in red dashed lines are previously consented removals under approval reference 2018/3788/P & 2018/4086/L
- Alterations shown in blue are being sought as part of this application

NEW SIDE PASSAGE LEAN-TO WITH GLAZED ROOF SET INTO LIGHTWEIGHT TIMBER STRUCTURE TO SHELTER PASSAGEWAY WITH TRADITIONAL TIMBER DOORS AT BOTH ENDS

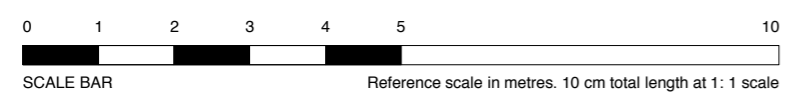



Rev.	Comments	Date

Project	NO. 4 ETON VILLAS • LONDON • NW3 4SX		
Drawing Title	PROPOSED FRONT ELEVATION		
Dwg No.	430 / 107	Revision	
Scale	1:100 @ A3	Date	AUGUST 2019
		Drawn by	TW

ATELIERwest
 ARCHITECTURE / DESIGN / PROJECT MANAGEMENT
 SUITE 5 / 26 CADOGAN SQUARE / LONDON / SW1X 0JP
 INFO@ATELIERWEST.CO.UK / WWW.ATELIERWEST.CO.UK
 0203 587 7227
 07801 650 531

DO NOT SCALE FROM THIS DRAWING. USE FIGURED DIMENSIONS ONLY. ANY DISCREPANCIES ARE TO BE REPORTED TO AW IMMEDIATELY. PRIOR TO THE EXECUTION OF THE WORKS ON SITE ALL DIMENSIONS TO BE VERIFIED ON SITE BEFORE ANY WORK IS PUT IN HAND

Drawings provided as a basis for these proposals are all previously approved (consented under ref: 2018/3788/P & 2018/4086/L)

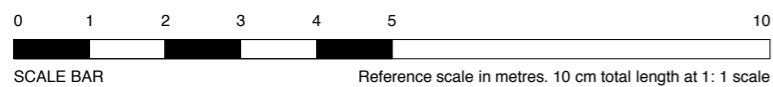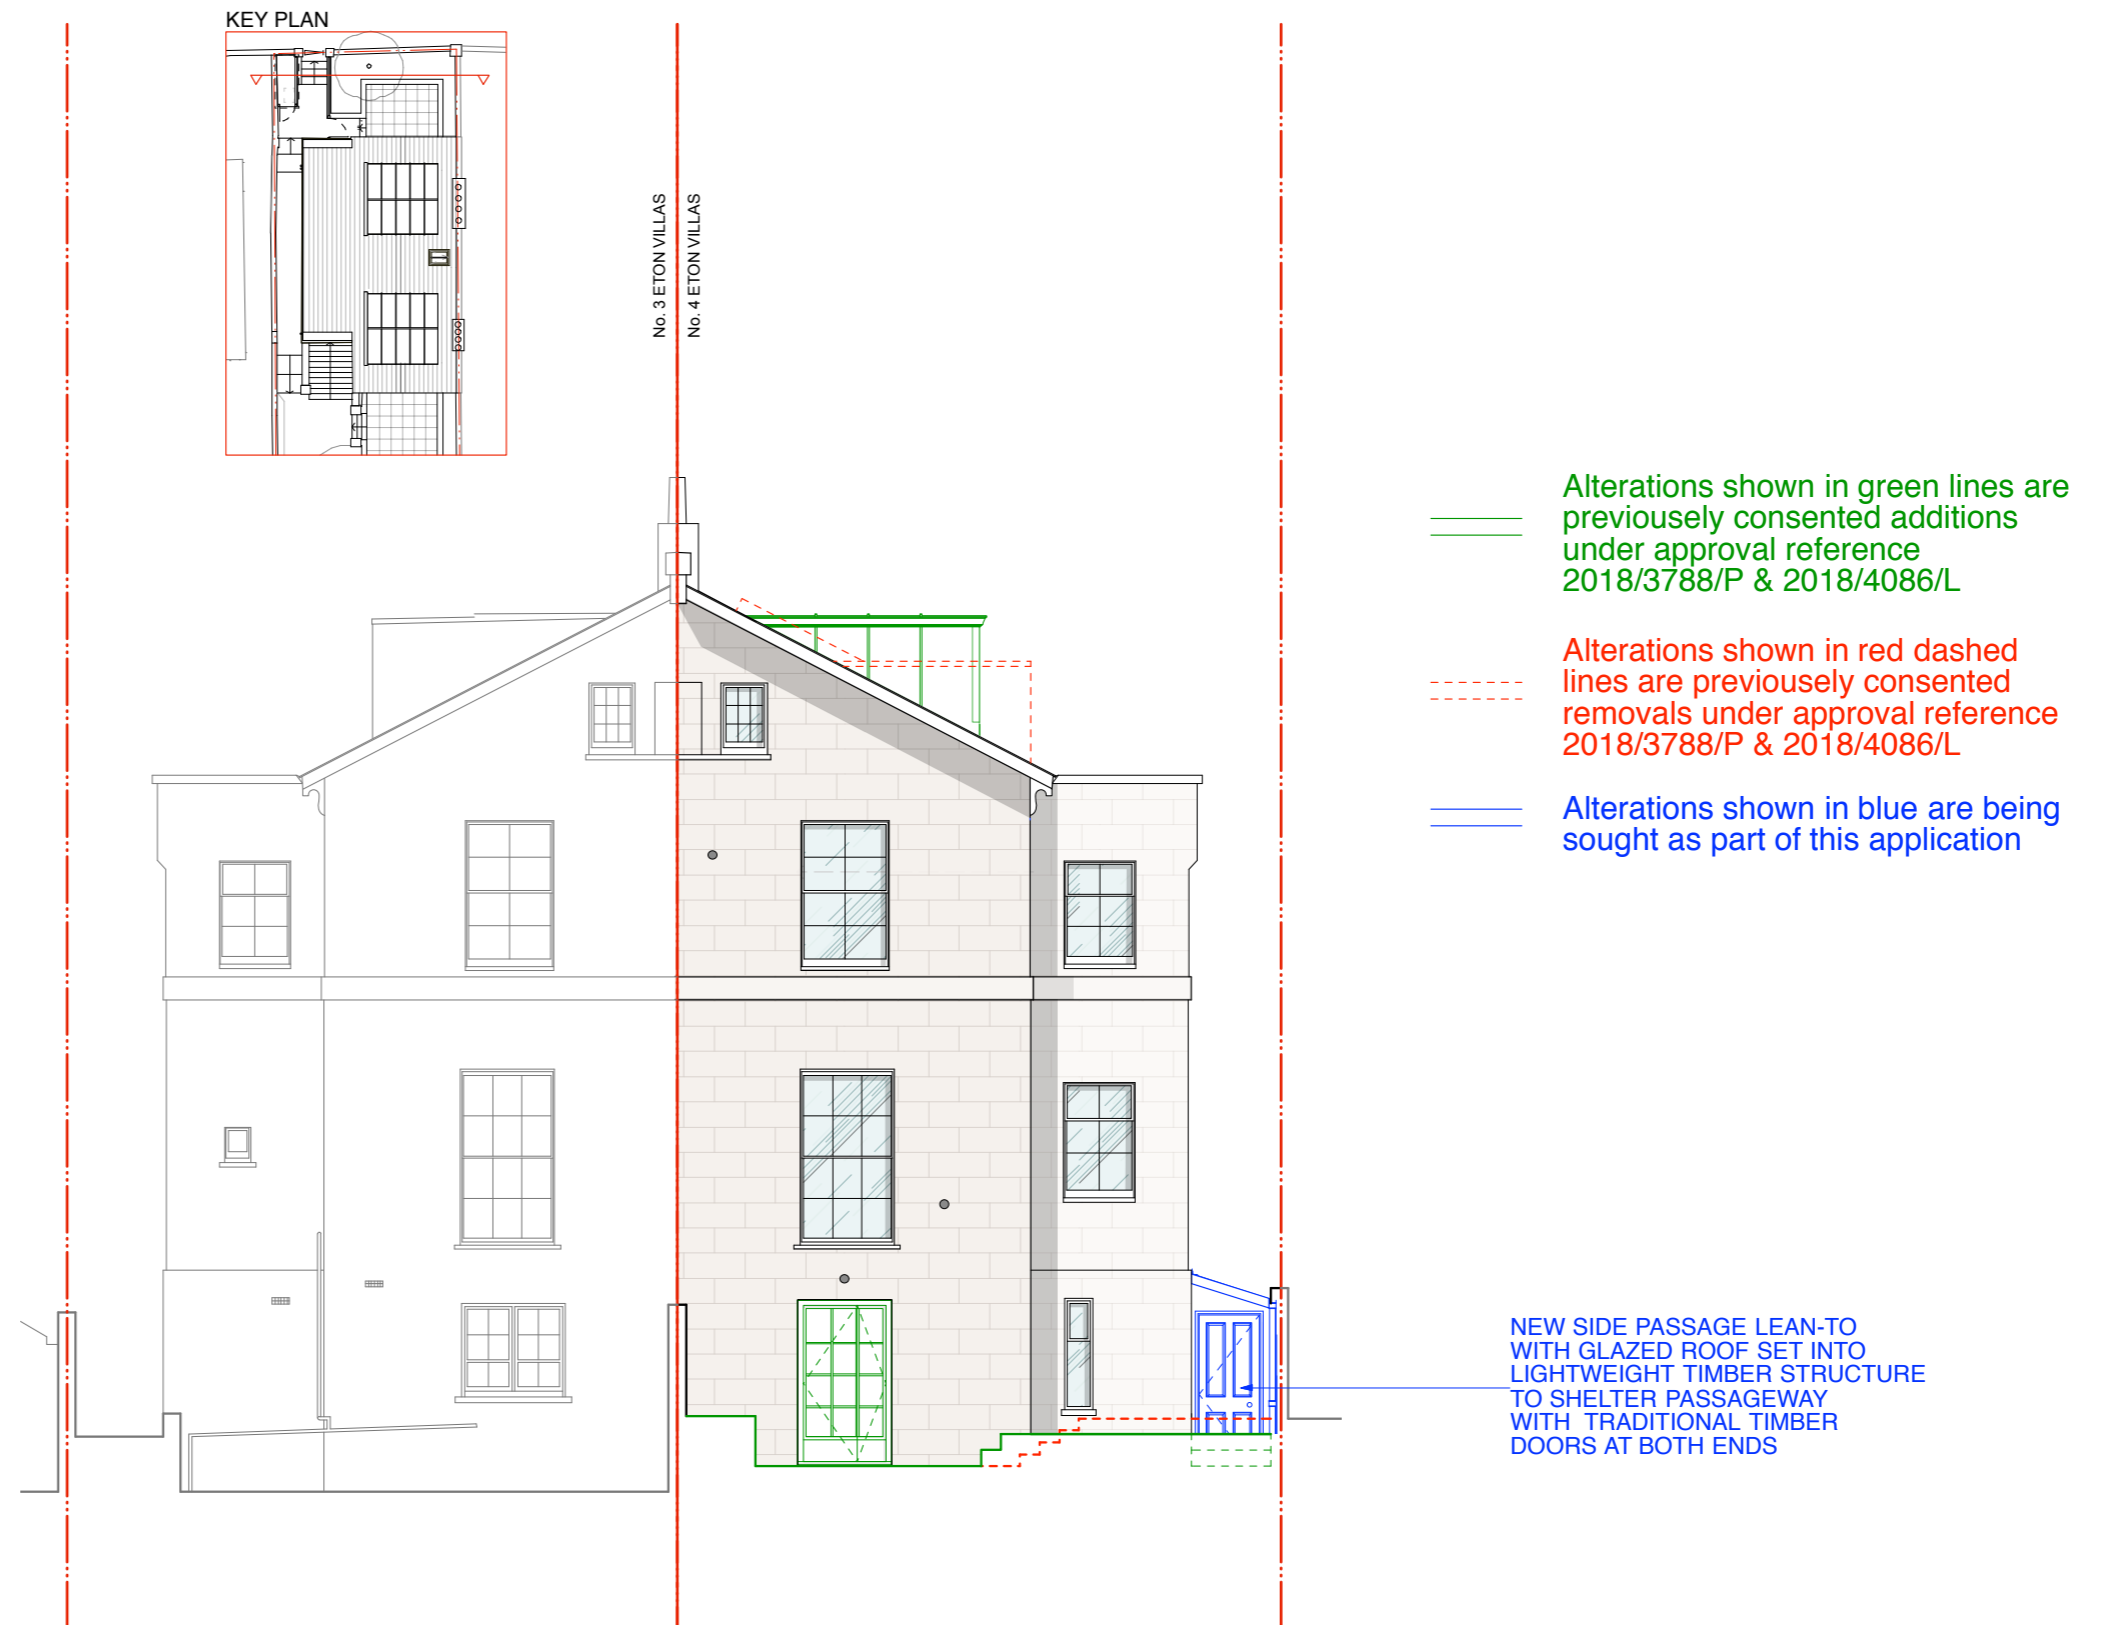

Rev. Comments

Date

Project NO. 4 ETON VILLAS • LONDON • NW3 4SX

Drawing Title PROPOSED REAR ELEVATION

Dwg No. 430 / 108

Revision

Scale 1:100 @ A3

Date AUGUST 2019

Drawn by TW

ATELIERwest
ARCHITECTURE / DESIGN / PROJECT MANAGEMENT


SUITE 5 / 26 CADOGAN SQUARE / LONDON / SW1X 0JP
INFO@ATELIERWEST.CO.UK / WWW.ATELIERWEST.CO.UK

0203 587 7227
07801 650 531



DO NOT SCALE FROM THIS DRAWING. USE FIGURED DIMENSIONS ONLY. ANY DISCREPANCIES ARE TO BE REPORTED TO AW IMMEDIATELY. PRIOR TO THE EXECUTION OF THE WORKS ON SITE ALL DIMENSIONS TO BE VERIFIED ON SITE BEFORE ANY WORK IS PUT IN HAND

Drawings provided as a basis for these proposals are all previously approved (consented under ref: 2018/3788/P & 2018/4086/L)


ETON COLLEGE ROAD
No. 4 ETON VILLAS

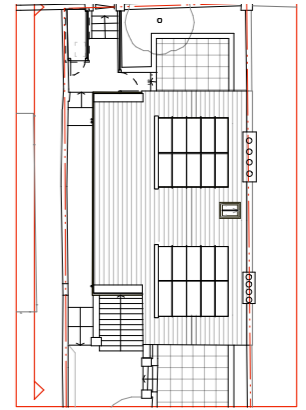

- Alterations shown in green lines are previously consented additions under approval reference 2018/3788/P & 2018/4086/L
- - - Alterations shown in red dashed lines are previously consented removals under approval reference 2018/3788/P & 2018/4086/L
- Alterations shown in blue are being sought as part of this application

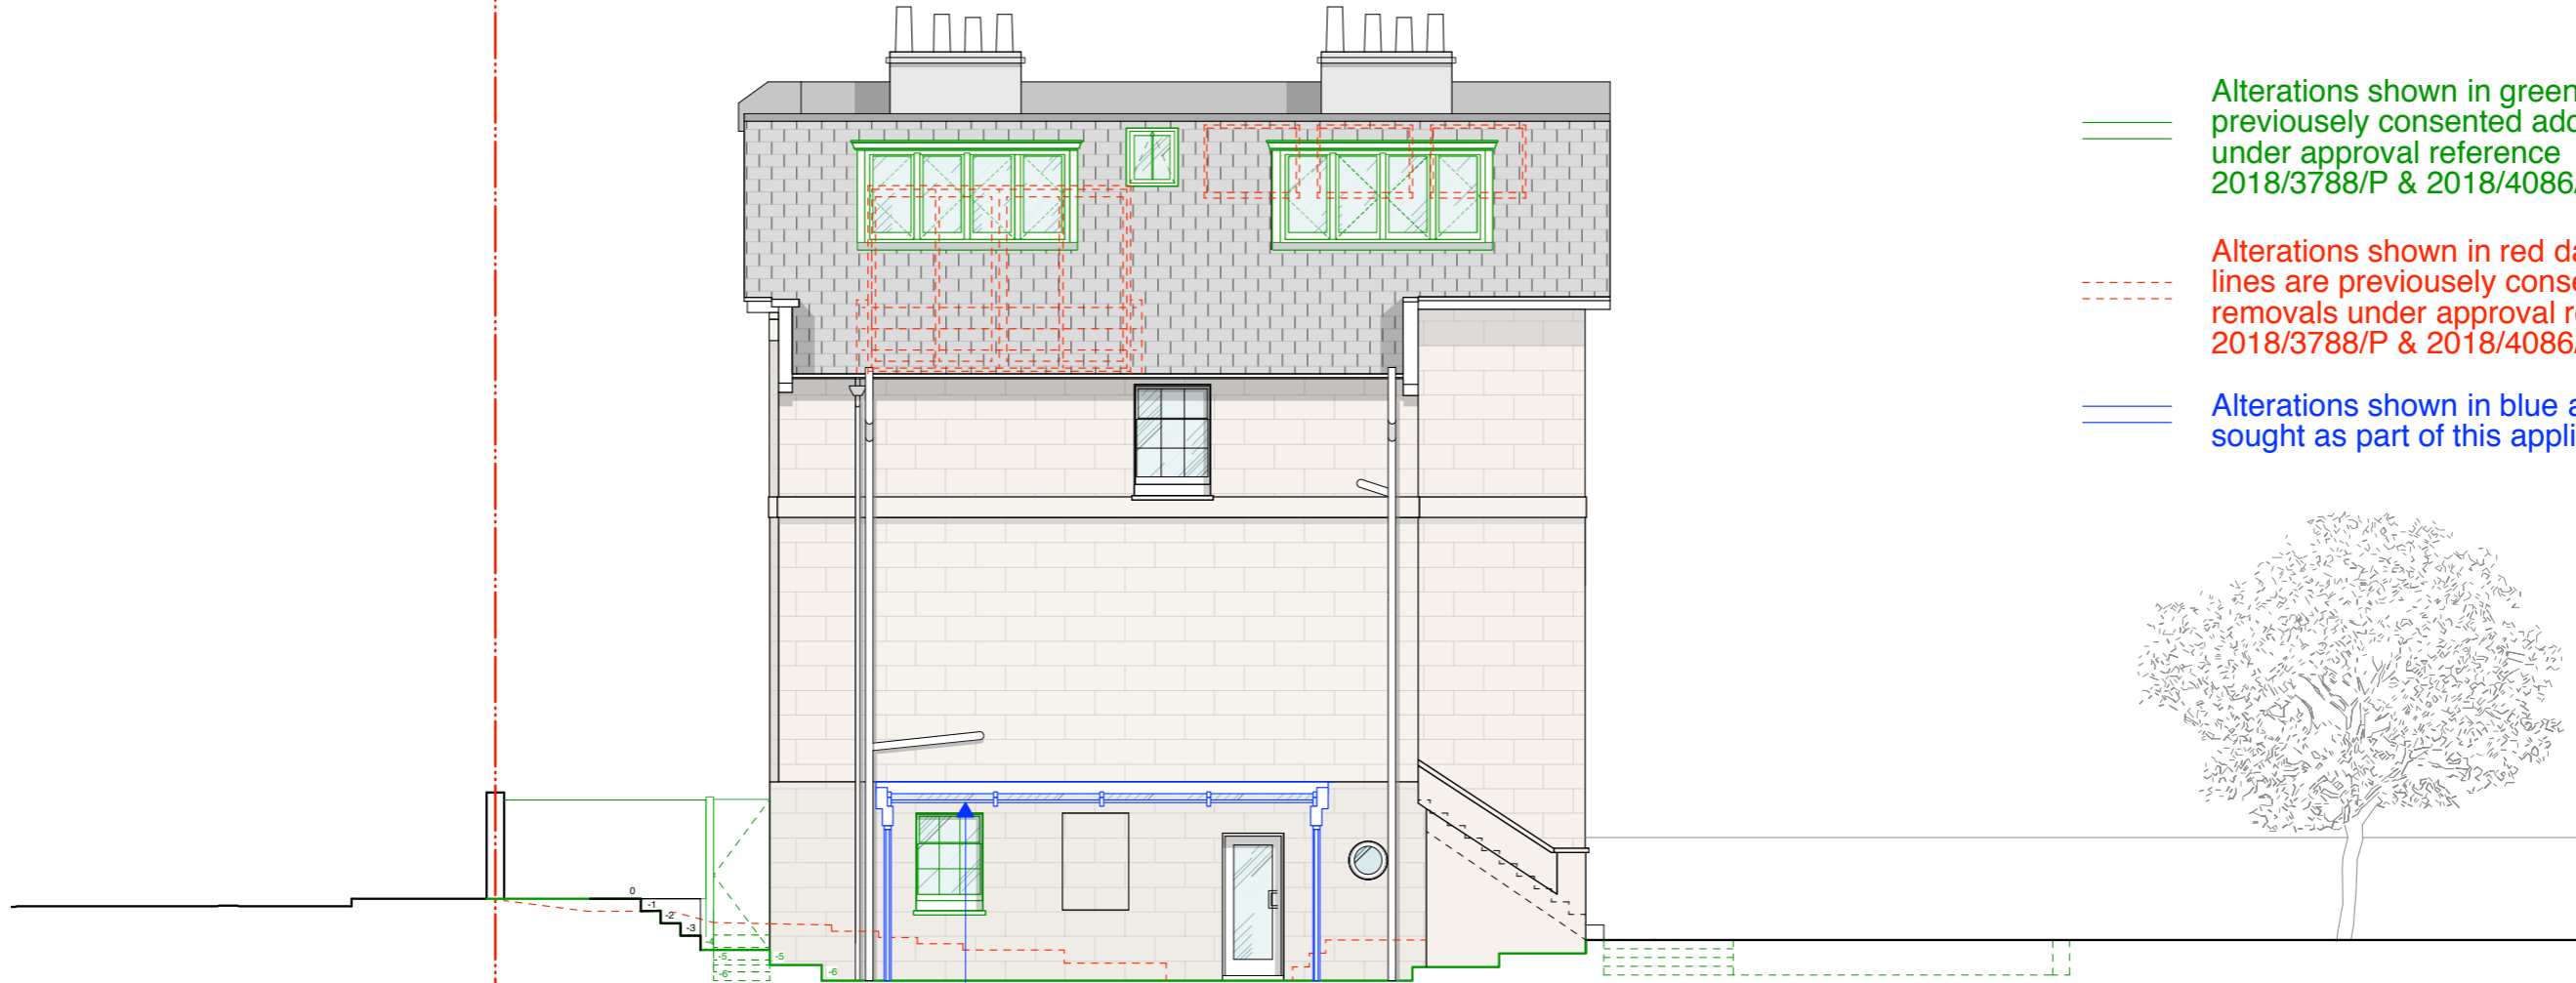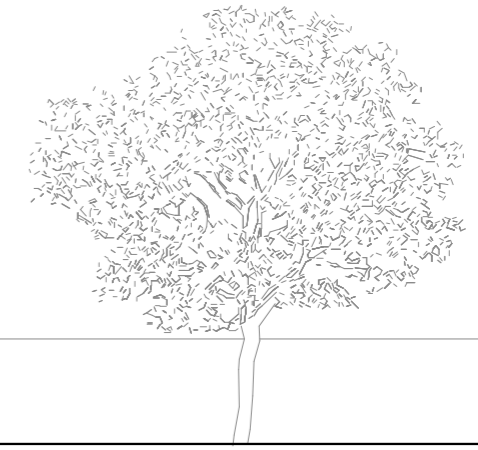

NEW SIDE PASSAGE LEAN-TO WITH GLAZED ROOF SET INTO LIGHTWEIGHT TIMBER STRUCTURE TO SHELTER PASSAGEWAY WITH TRADITIONAL TIMBER DOORS AT BOTH ENDS

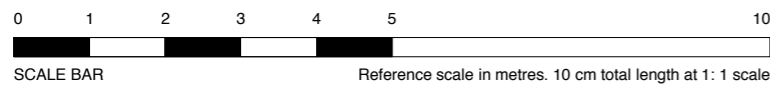

Rev. Comments

Date

Project NO. 4 ETON VILLAS • LONDON • NW3 4SX

Drawing Title PROPOSED SIDE ELEVATION

Dwg No. 430 / 109

Revision

Scale 1:100 @ A3

Date AUGUST 2019

Drawn by TW

ATELIERwest
ARCHITECTURE / DESIGN / PROJECT MANAGEMENT

SUITE 5 / 26 CADOGAN SQUARE / LONDON / SW1X 0JP
INFO@ATELIERWEST.CO.UK / WWW.ATELIERWEST.CO.UK

0203 587 7227
07801 650 531

DO NOT SCALE FROM THIS DRAWING. USE FIGURED DIMENSIONS ONLY. ANY DISCREPANCIES ARE TO BE REPORTED TO AW IMMEDIATELY. PRIOR TO THE EXECUTION OF THE WORKS ON SITE ALL DIMENSIONS TO BE VERIFIED ON SITE BEFORE ANY WORK IS PUT IN HAND