



### 1. SOUTH ELEVATION

Scale: 1:100

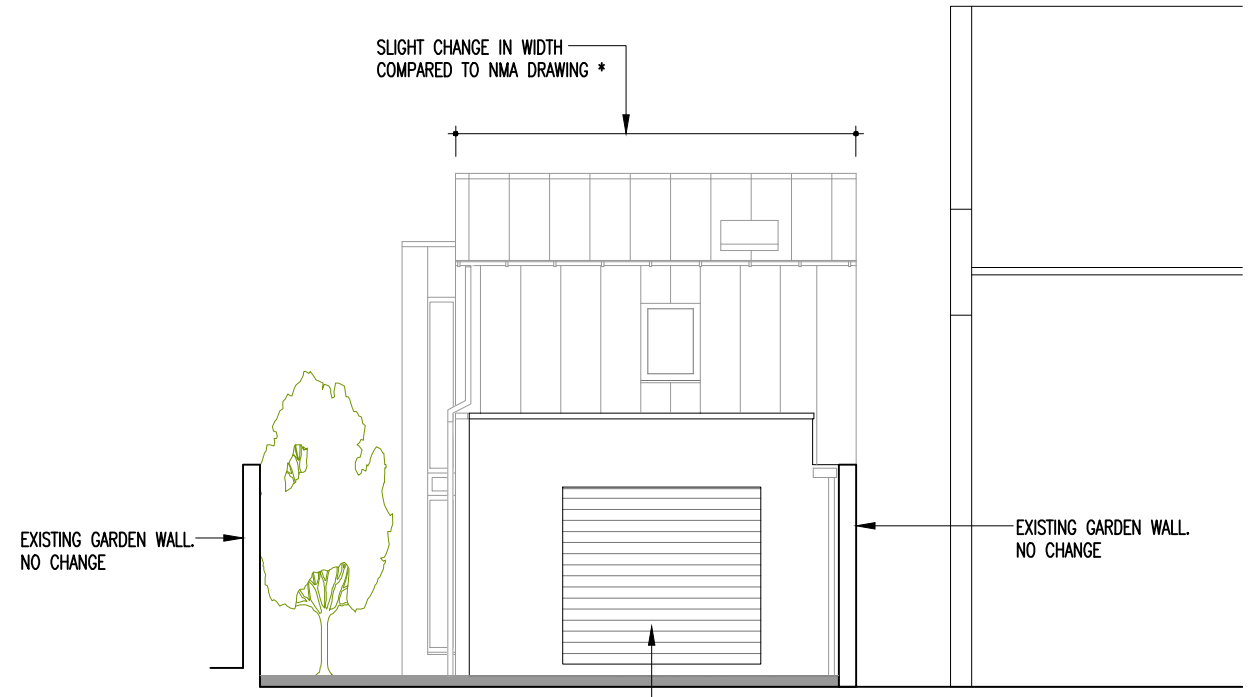


### 2. NORTH ELEVATION

Scale: 1:100

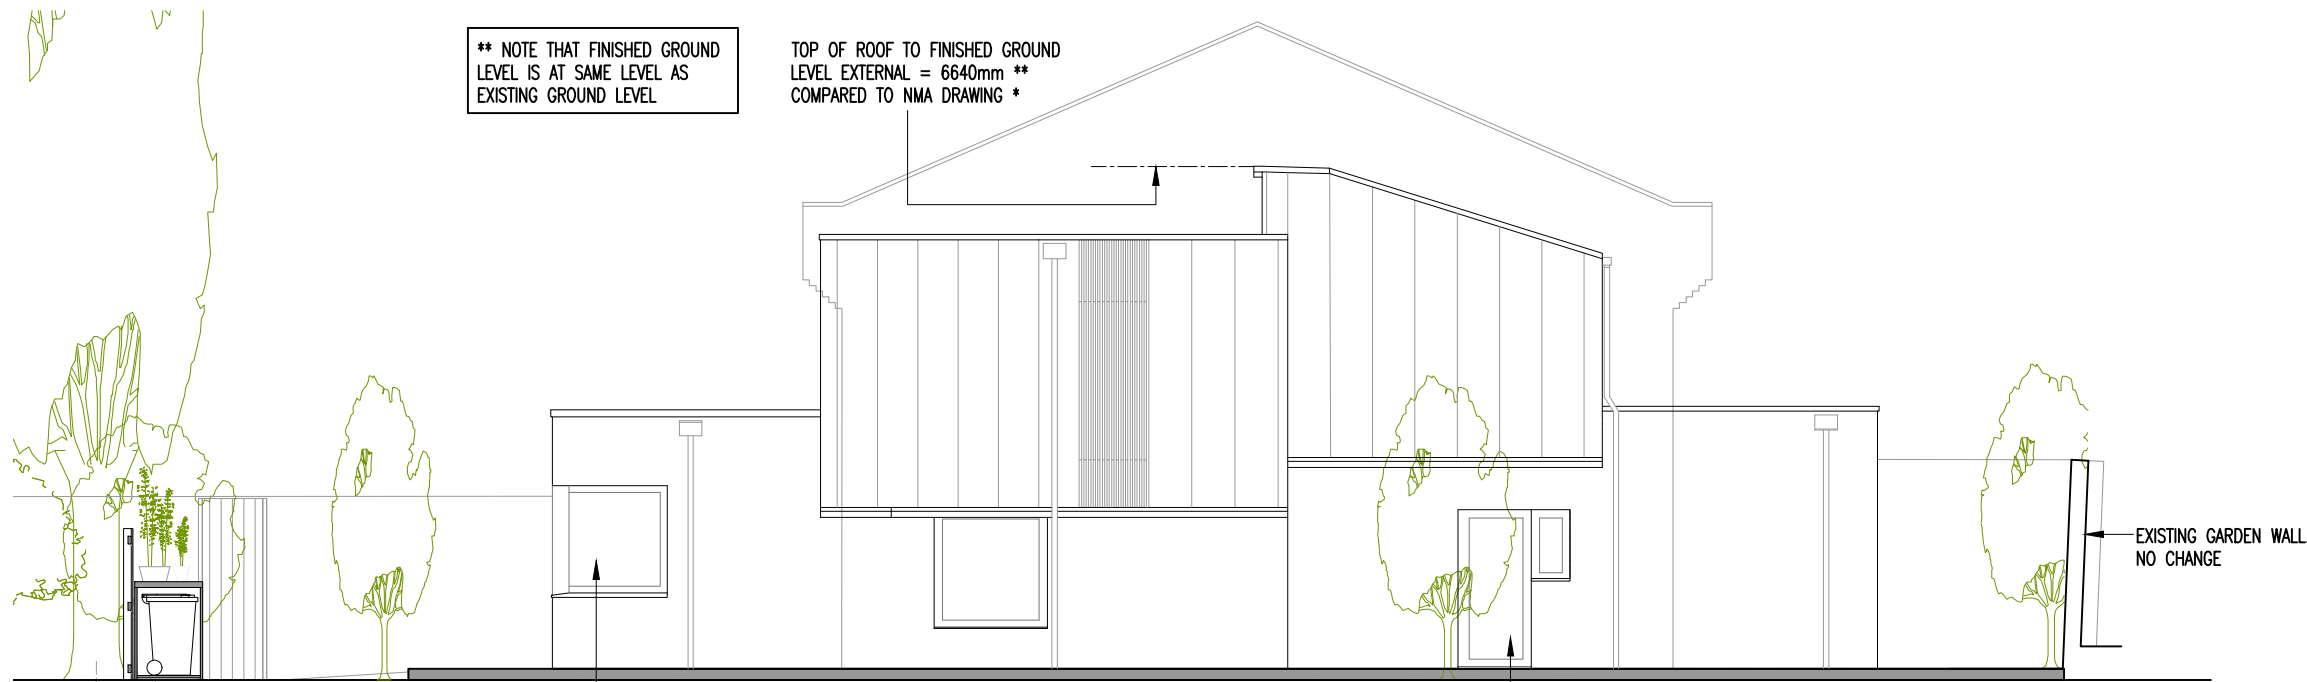

### 3. EAST ELEVATION

Scale: 1:100

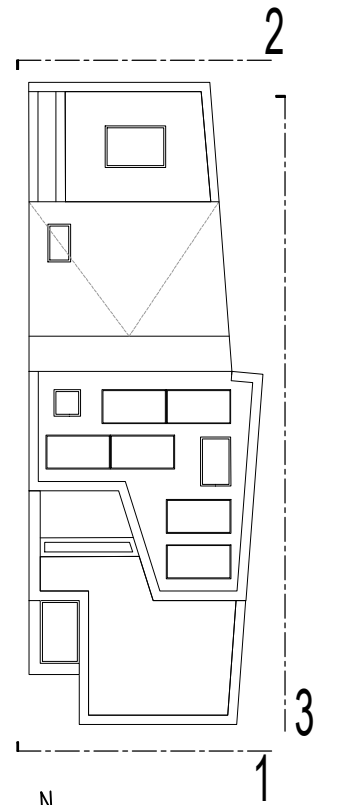


AS-BUILT

R/O 27 LEIGHTON ROAD

\* Refer to Non-Material Amendment (NMA) Planning Application no. 2017/3677/P, Decision Date 23-10-2017, and approved NMA DRAWING 140-P-007 Rev A.

0m 1 2 3 4  
SCALE 1:100

		Drawing Title EXTERIOR ELEVATIONS - AS-BUILT		 Alan Morris Architect Unit 50 One Prince of Wales Road London NW5 3LW
		Drawing Status AS BUILT		
Scale 1:100 @ A3		Date SEPT 2019	Project Title R/O 27 LEIGHTON ROAD, NW5	
Rev. Date Issued for Planning 03.09.19 KJ/AM		Drawing Number 140-P-043		
Rev. Date Description	Rev/Chk By	Rev -		