


Red lines denotes demolition

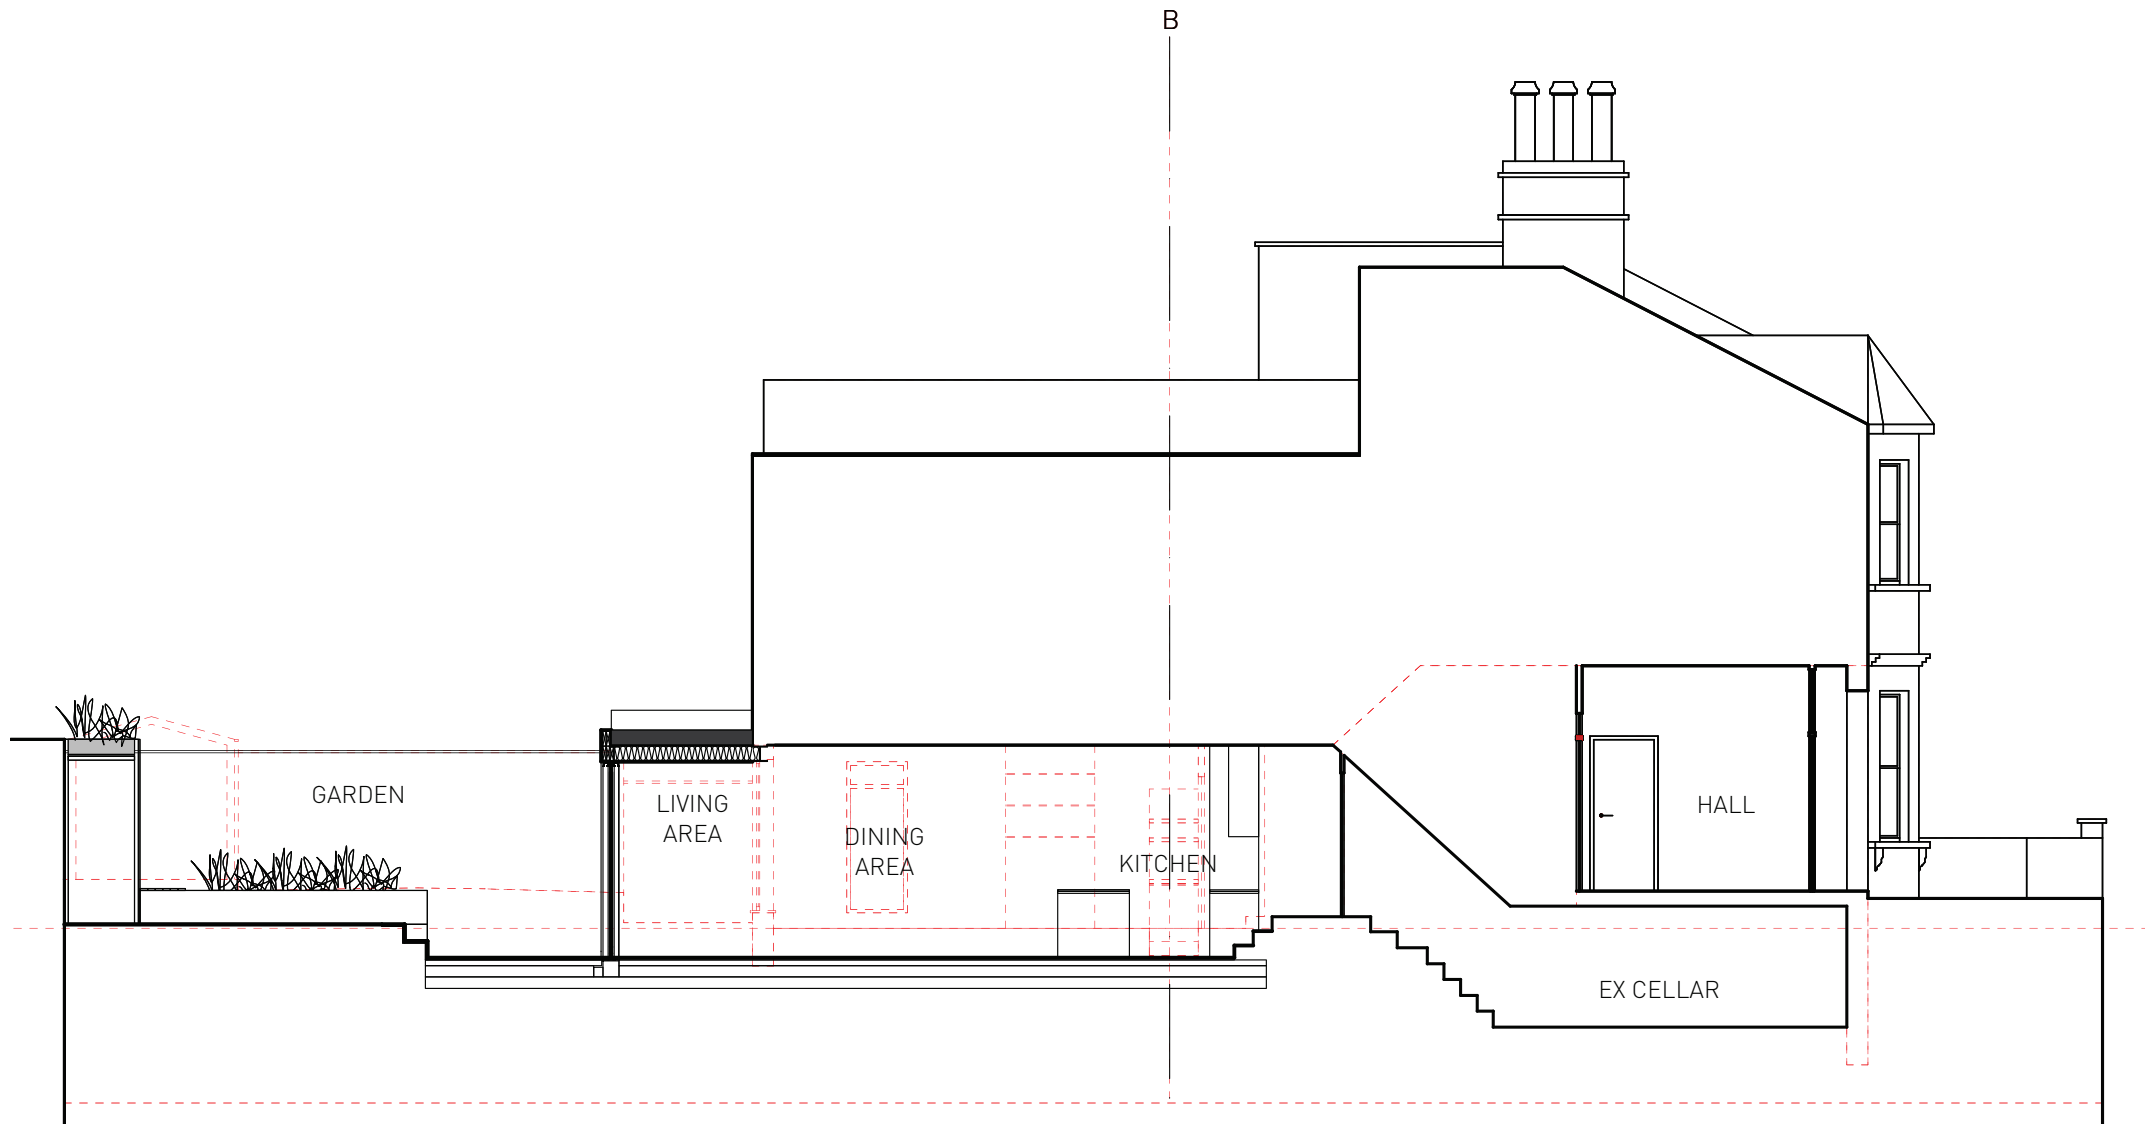

PROPOSED SECTION A-A



FOR PLANNING

rev	date	by	comment	checked
D	19.09.19	DM	GENERAL LAYOUT	PM
C	03.10.18	DM	GENERAL LAYOUT	PM
B	20.08.18	DM	GENERAL LAYOUT	PM
A	13.05.10	DM	GENERAL LAYOUT	PM



Peter Morris Architects  
465-470 High Road, Unit 12, London N19 1DR www.petermorrisarchitects.com n. 0278927218

Client  
Shaun McKinlay

Job

Ground Floor Flat  
54 Sumatra Road  
London NW6 1PR

Drawing Title  
SECTION A-A  
PROPOSED

Scale	1:100	@	A3	
Date	05.07.2018	Drawn	Issued	Checked
		AD	PM	PM

Dwg. No.	217	014	Rev.	D
----------	-----	-----	------	---