


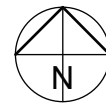
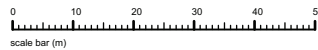


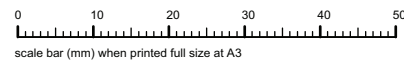


LOCATION PLAN scale 1:1250

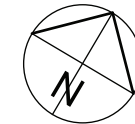


BLOCK PLAN scale 1:500

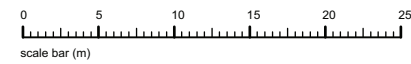


scale bar (mm) when printed full size at A3
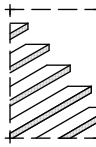
<p>client: Adelene Alani</p>	<p>project: 94 Albert Street London NW1 7NE</p>	<p>scale: 1:100 @ A3 date: July 17 drawn: MW</p>	<p>drawing title: Premises as Existing drawing no: 17-011-01 (sheet 1 of 3)</p>	 <p>the basement design studio Suite 17, Maple Court, Grove Park, White Waltham. SL6 3LW tel: 01628 826066 www.basementdesignstudio.co.uk</p>
-------------------------------------	--	---	---	---

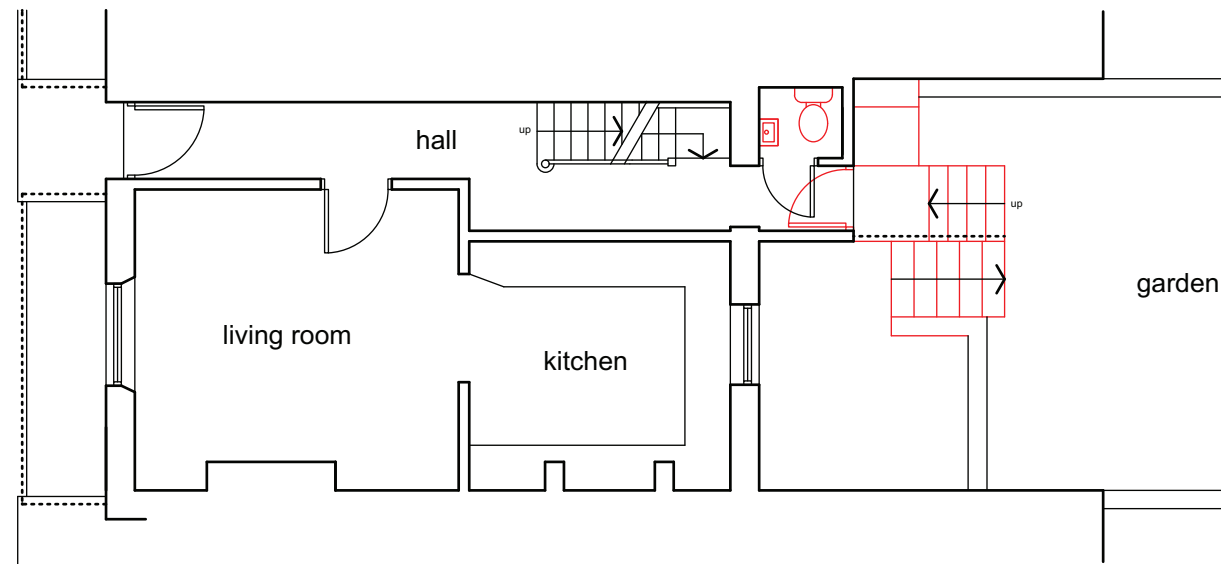



GROUND FLOOR PLAN as existing

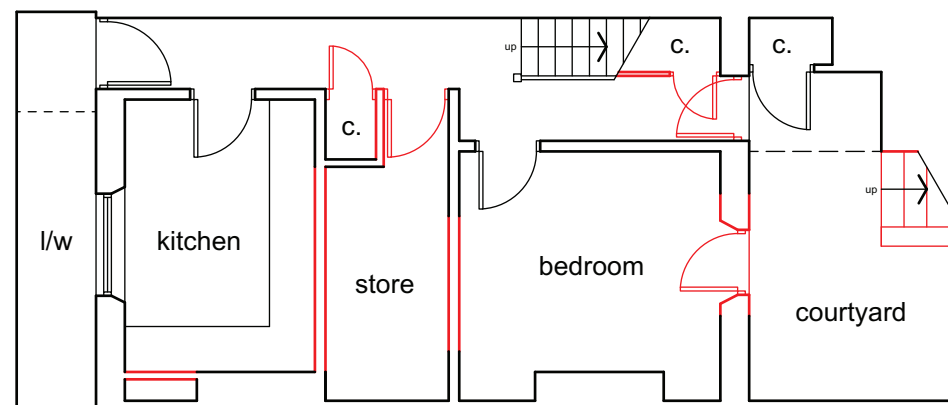

LOWER GROUND FLOOR PLAN as existing

EXTENT OF DEMOLITION SHOWN IN RED

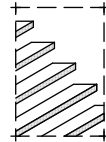
<p>client: Adelene Alani</p>	<p>project: 94 Albert Street London NW1 7NE</p>	<p>scale: 1:100 @ A3 date: July 17 drawn: MW</p>	<p>drawing title: Premises as Existing drawing no: 17-011-01 (sheet 2 of 3)</p>	 <p>the basement design studio Suite 17, Maple Court, Grove Park, White Waltham. SL6 3LW tel: 01628 826066 www.basementdesignstudio.co.uk</p>
-------------------------------------	--	---	--	--

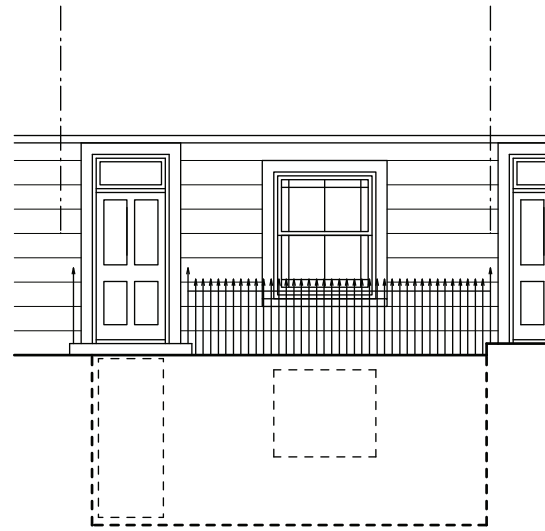


STREET ELEVATION




FRONT LIGHTWELL ELEVATION

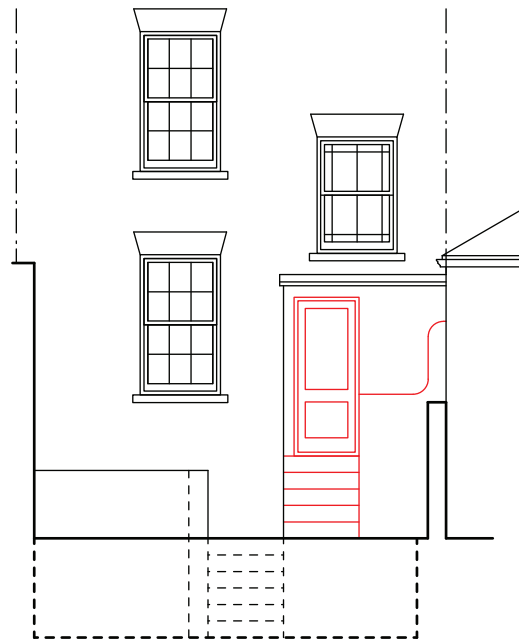

GARDEN ELEVATION

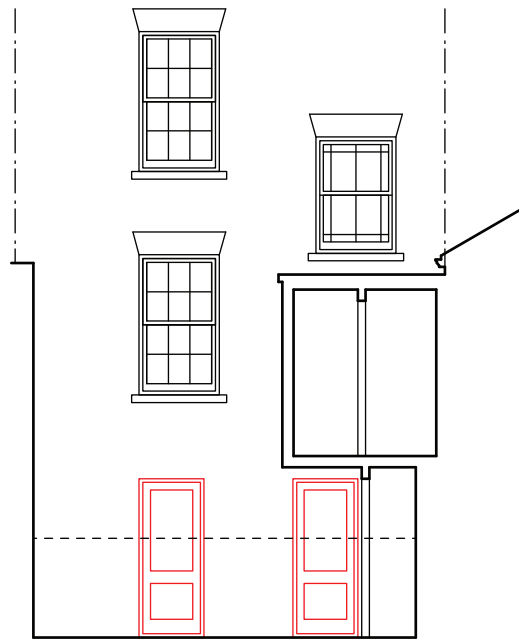


REAR LIGHTWELL ELEVATION

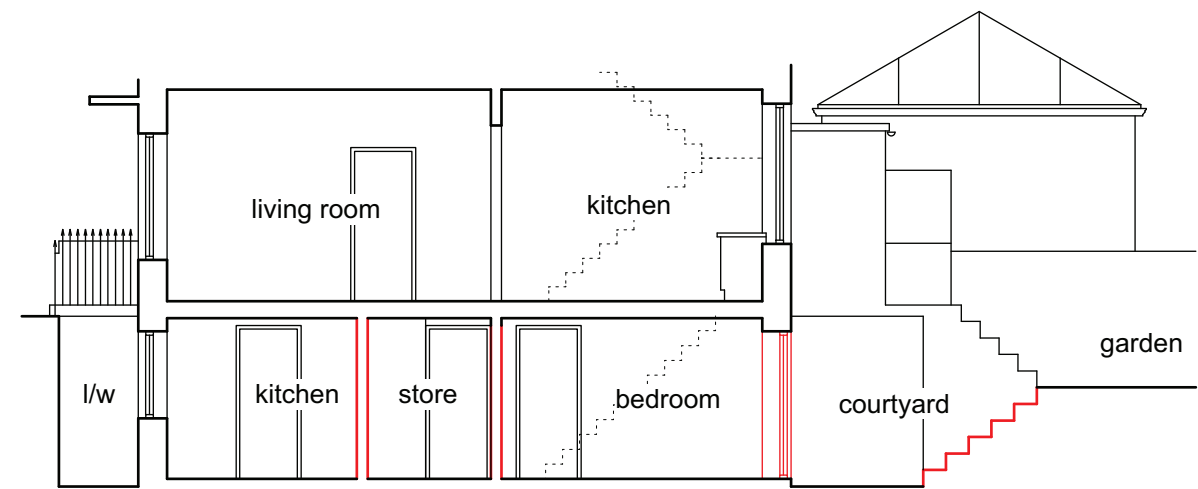

SECTION

EXTENT OF DEMOLITION SHOWN IN RED
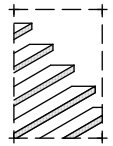
<p>client: Adelene Alani</p>	<p>project: 94 Albert Street London NW1 7NE</p>	<p>scale: 1:100 @ A3 date: July 17 drawn: MW</p>	<p>drawing title: Premises as Existing drawing no: 17-011-01 (sheet 3 of 3)</p>	<p> the basement design studio Suite 17, Maple Court, Grove Park, White Waltham. SL6 3LW tel: 01628 826066 www.basementdesignstudio.co.uk</p>
-------------------------------------	--	---	--	---