



REVISIONS

Rev.	Date	By
-	-	-

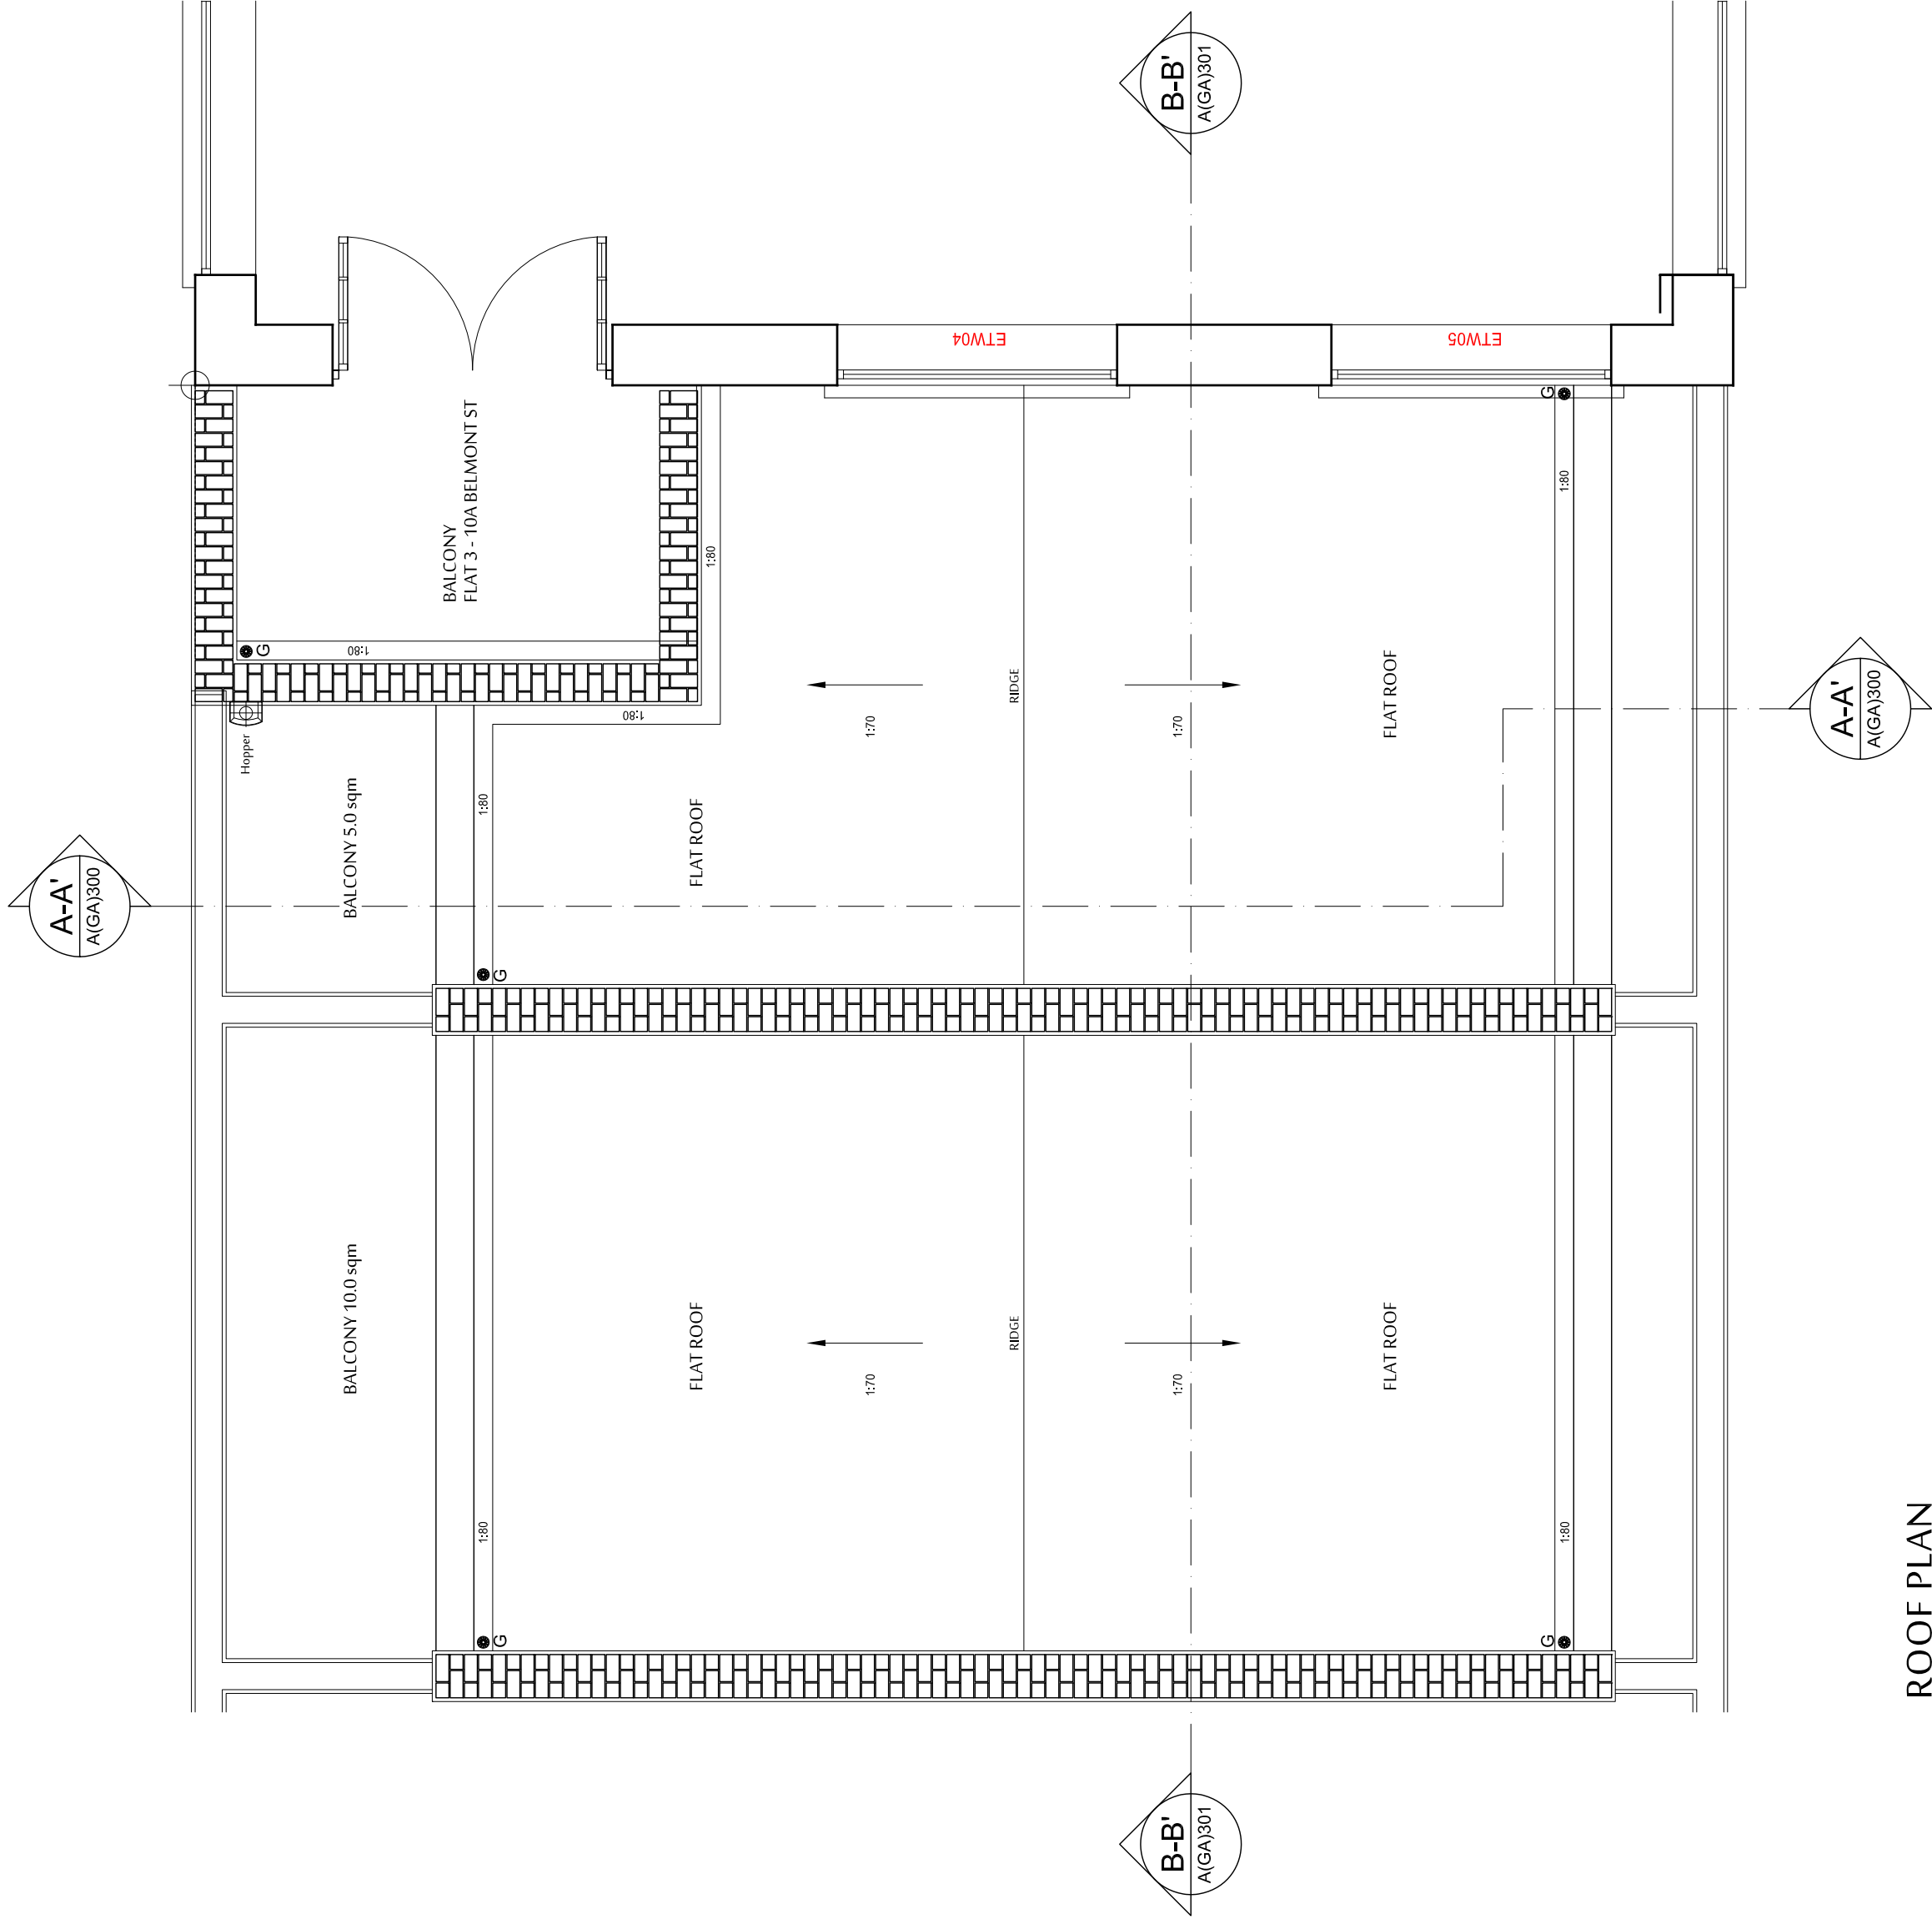


ROOF PLAN

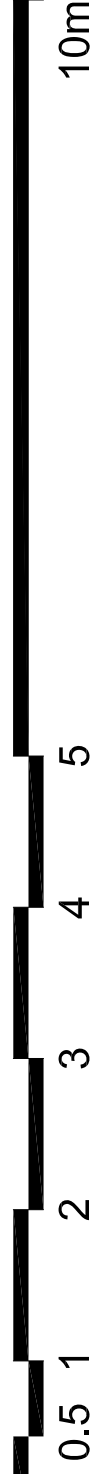

PLANNING APPLICATION

ALL DIMENSIONS TO BE CHECKED ON SITE
WORK TO FINISHED DIMENSIONS ONLY
REPAIRS TO EXISTING STRUCTURE TO BE COMPLETED
AT ONCE BEFORE PROCEEDING

Contemporary Design Solutions

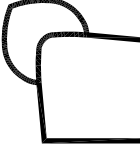

48 Great Marlborough Street
W1F 7JN
London
Telephone: 020 7464 8600 Fax: 020 7464 4644

Client

WARMHAZE LTD

Project Title

New Bay Windows
10-12 Belmont Street, LONDON NW1

Drawing Title

As Built Roof Plan

Scale: 1:50@A1, 1:100@A3 Date: OCTOBER 2019
Drawn: SN Checked: DL
Drawing No.: 160910-A(GA)140 Rev: -

