


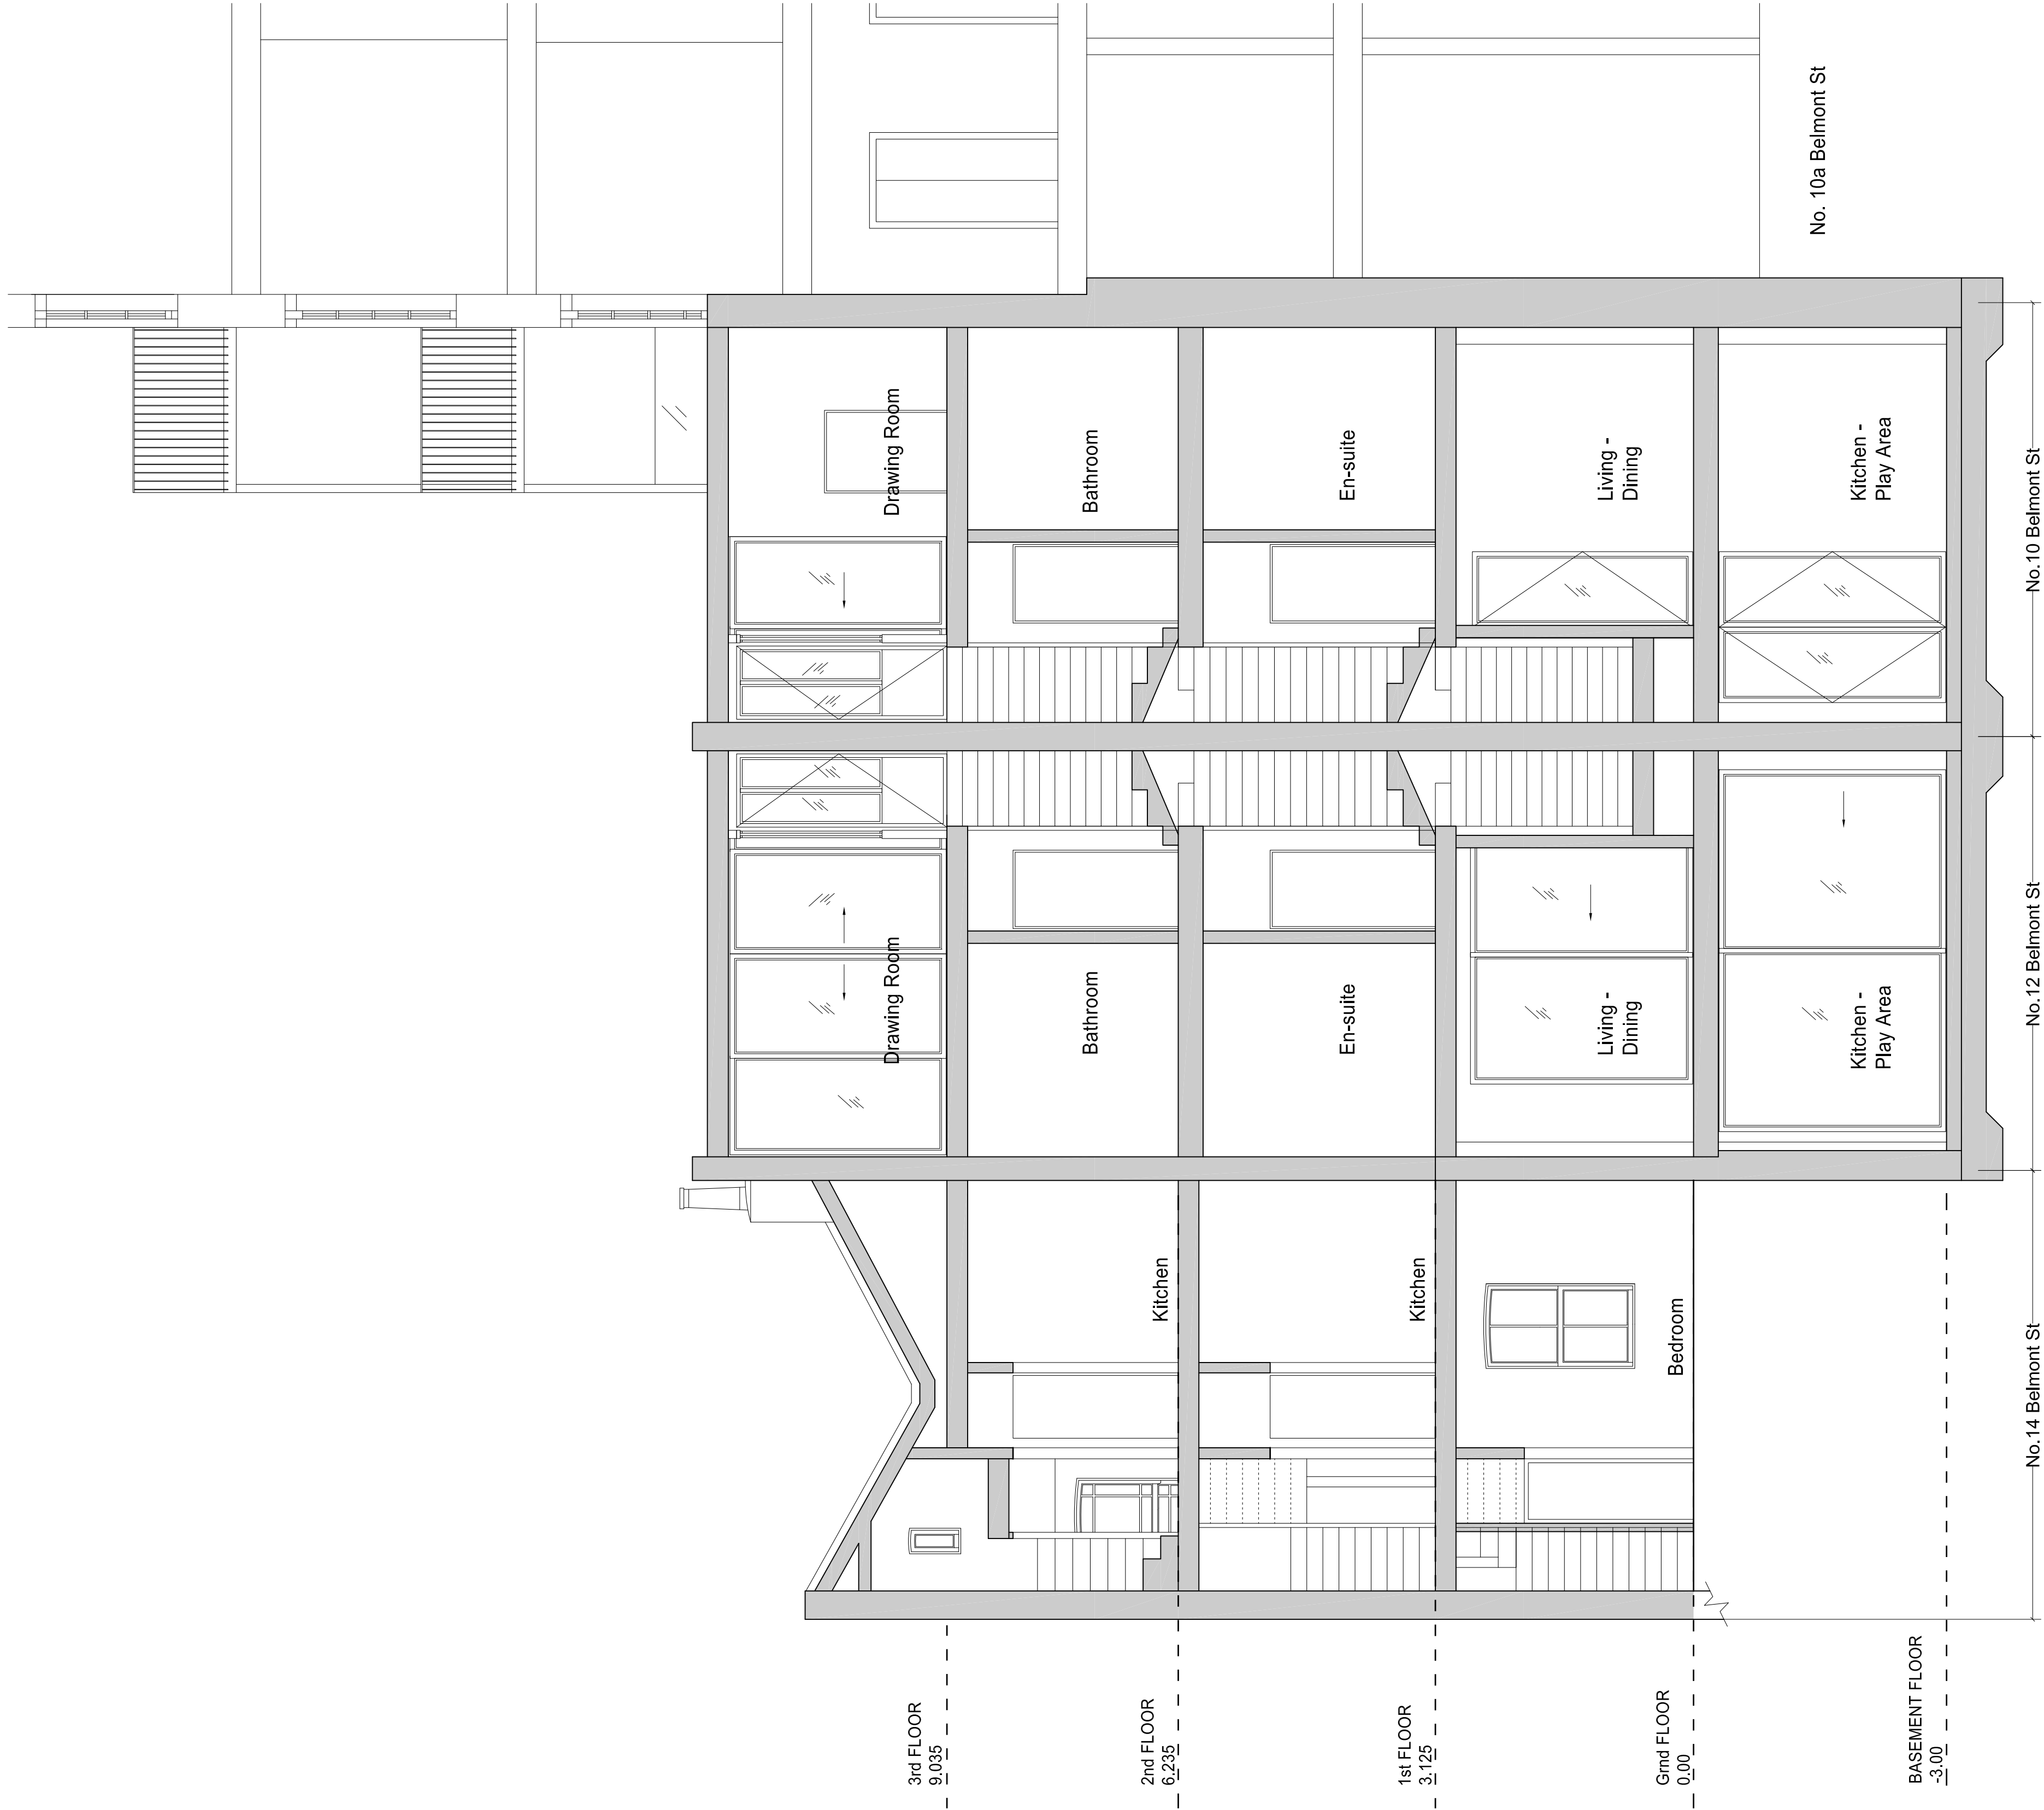


SECTION BB'

REVISIONS		
Rev.	Date	By

PLANNING APPLICATION

ALL DIMENSIONS TO BE CHECKED ON SITE
WORK TO FINISHED DIMENSIONS ONLY
REWORK TO BE COMPLETED TO THE SATISFACTION OF THE ARCHITECT
AT ONCE BEFORE PROCEEDING

Contemporary Design Solutions

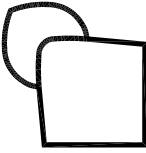

48 Great Marlborough Street
London
W1F 7JN
Telephone: 020 7464 6000 Fax: 020 7464 4044

Client

WARMHAZE LTD

Project Title

New Bay Windows
10-12 Belmont Street, LONDON NW1

Drawing Title

As Built Section BB'

Scale: 1:50@A1, 1:100@A3 Date: OCTOBER 2019
Drawn: LV Checked:
Drawing No. 160910-A(GA)301 Rev: