


REVISIONS


Rev: A, As built elevations.
Date: 07/10/19
By: LV

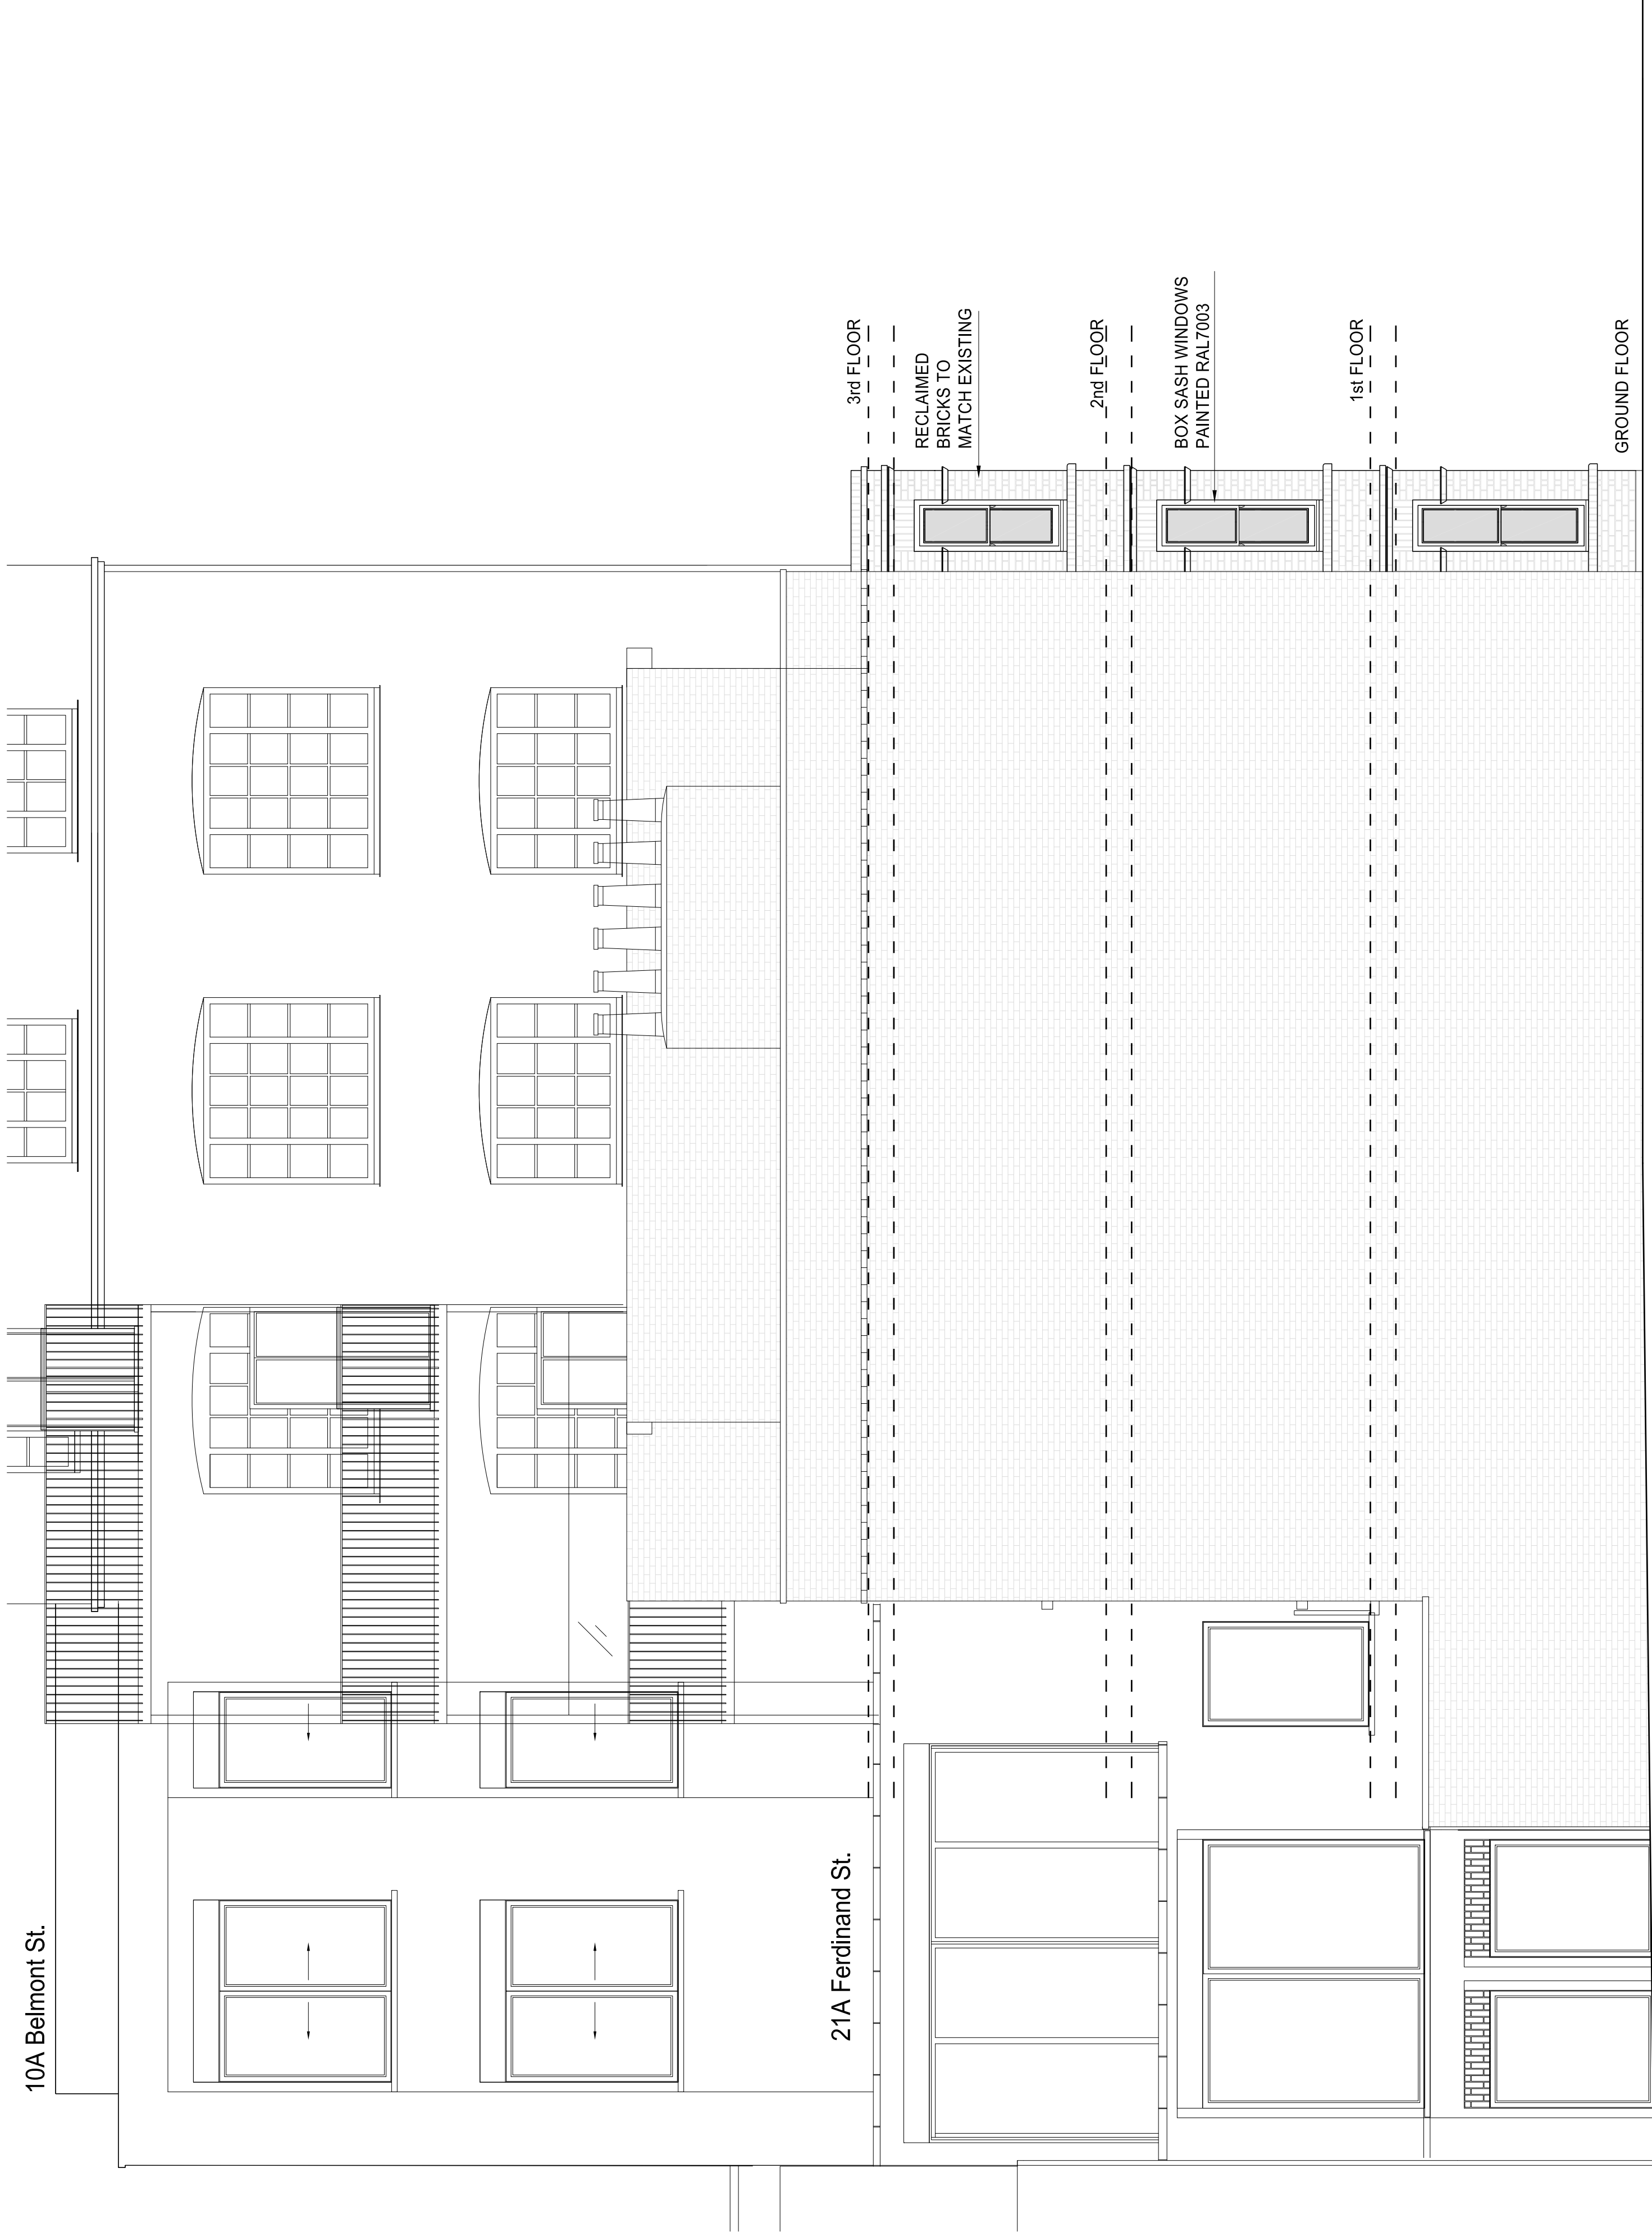

PLANNING APPLICATION

ALL DIMENSIONS TO BE CHECKED ON SITE
WORK TO FINISHED DIMENSIONS ONLY
REWORK TO CORRECT DIMENSIONS TO BE CORRECT
AT ONCE BEFORE PROCEEDING

Contemporary Design Solutions

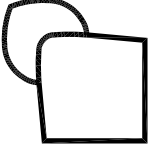

46 Great Marlborough Street
London
W1F 7JN
Telephone: 020 7464 4600 Fax: 020 7464 4644

Client

WARMHAZE LTD

Project Title

New Bay Windows
10-12 Belmont Street, LONDON NW1

Drawing Title

As Built North Elevation

Scale: 1:50@A1, 1:100@A3 Date: SEPTEMBER 2016
Drawn: LV Checked:
Drawing No.:
Rev: A

160910-A(GA)403

PLOT DATE - 10/8/2019 4:52 PM