




Rainwater Pipe Detail

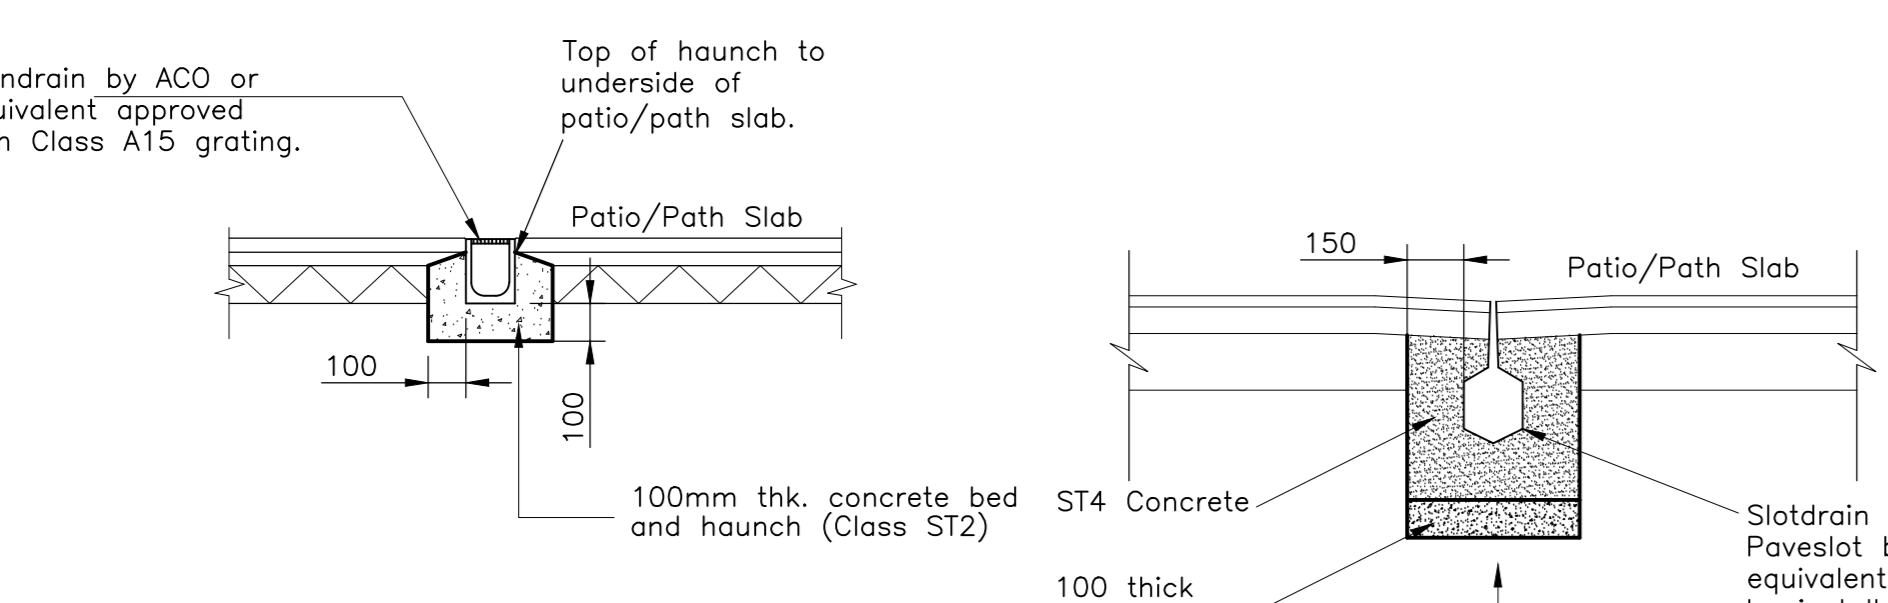


Grated Drainage Channel Detail

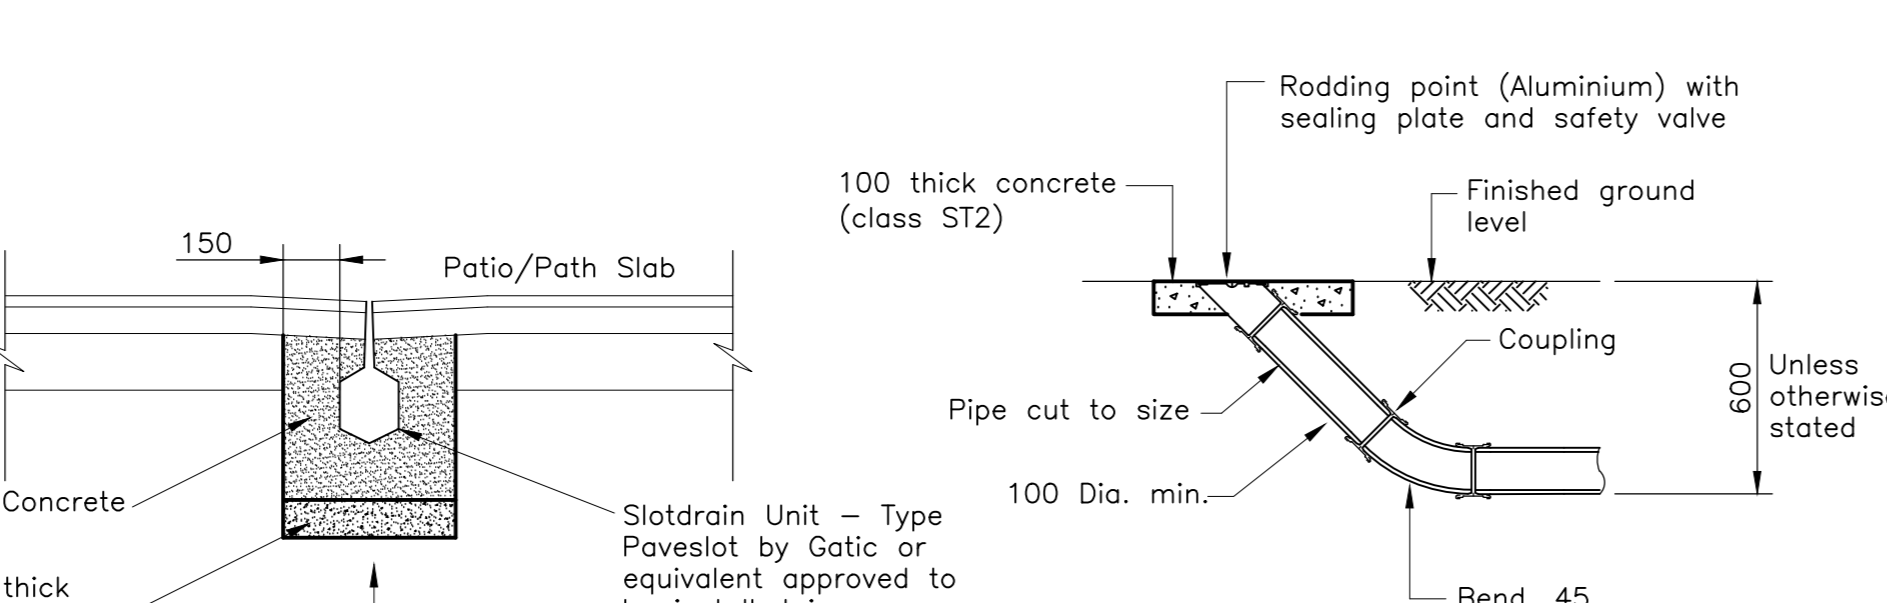


Slotdrain Detail

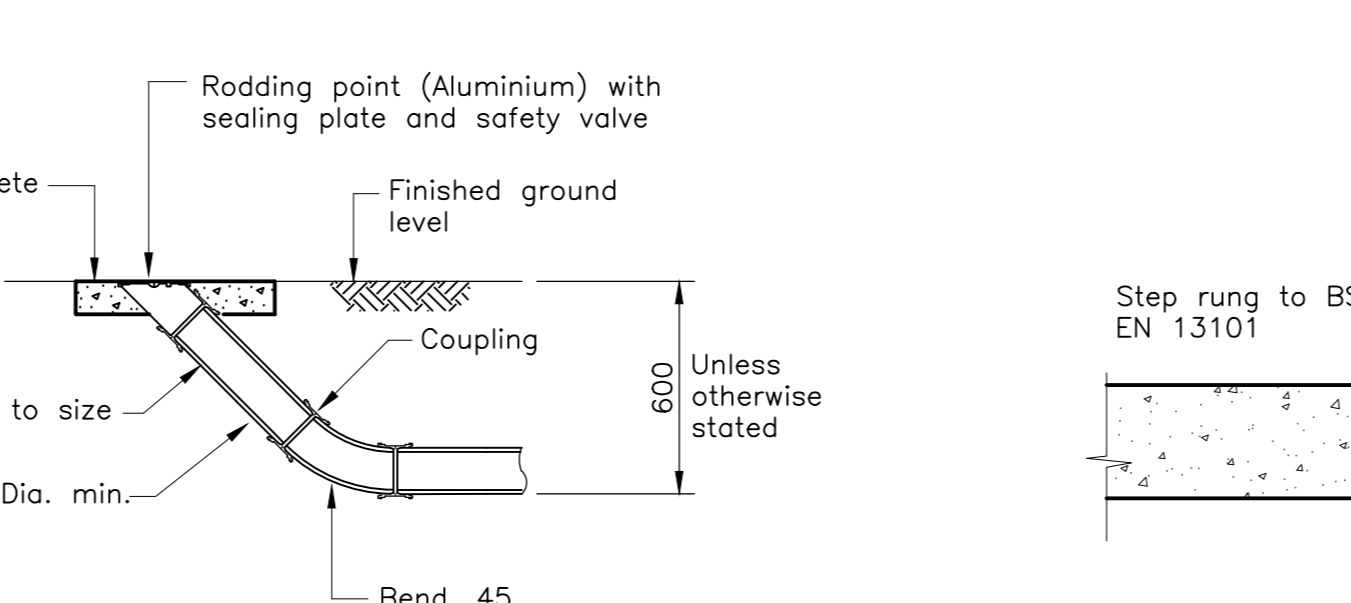

Rodding Eye Detail

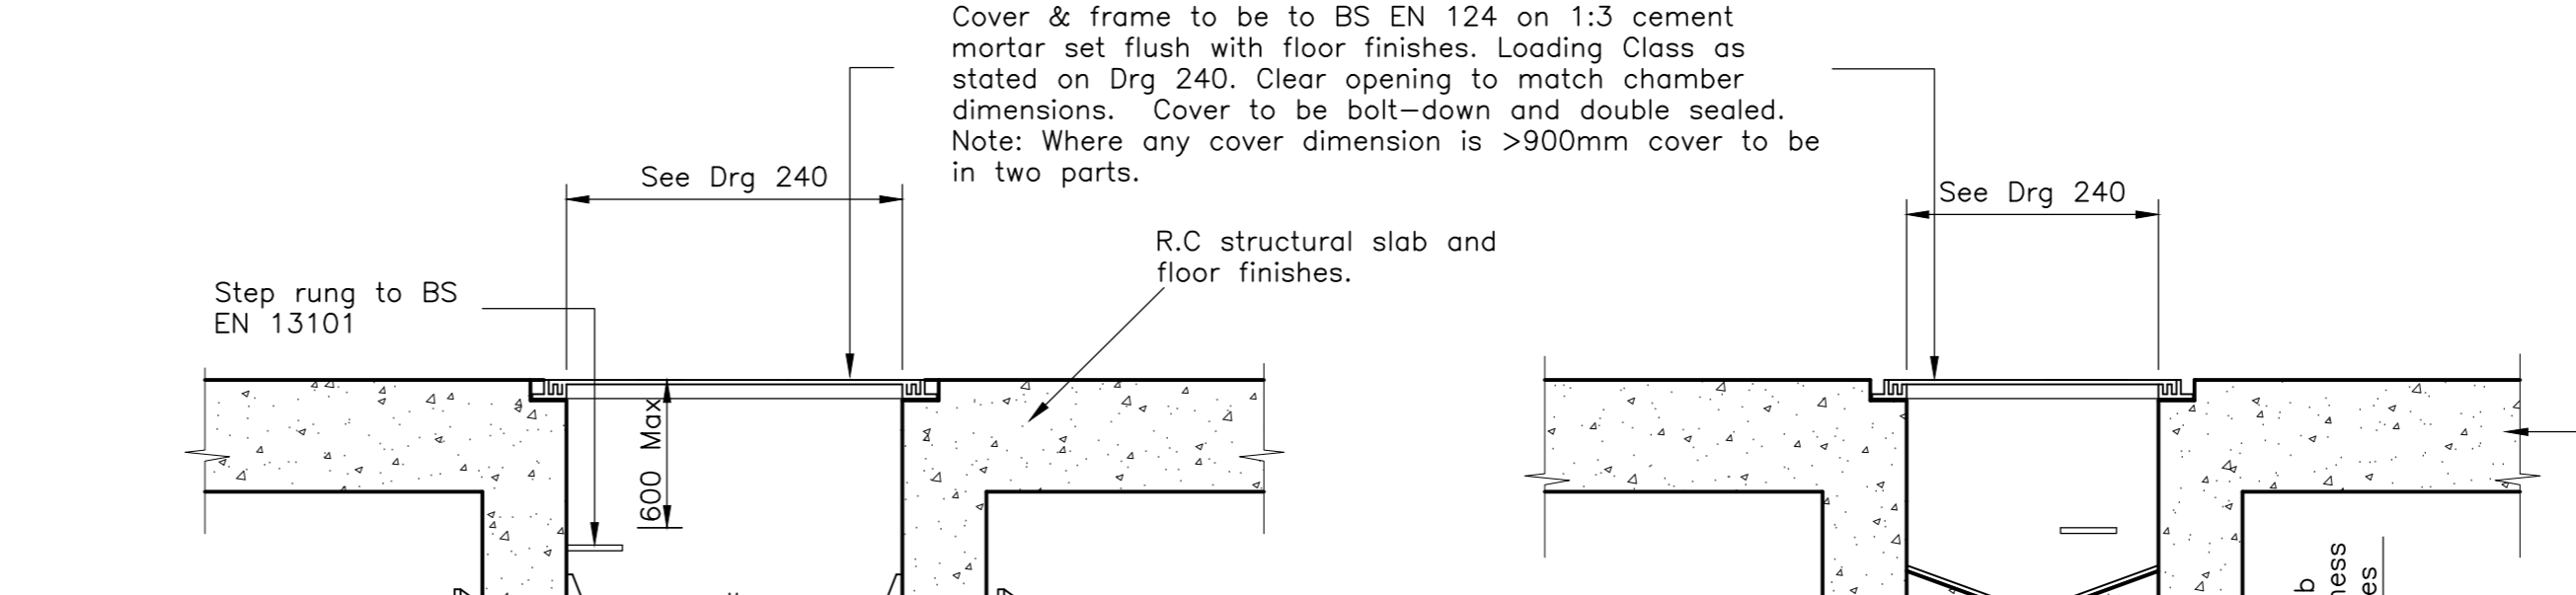


Internal Rectangular Manhole

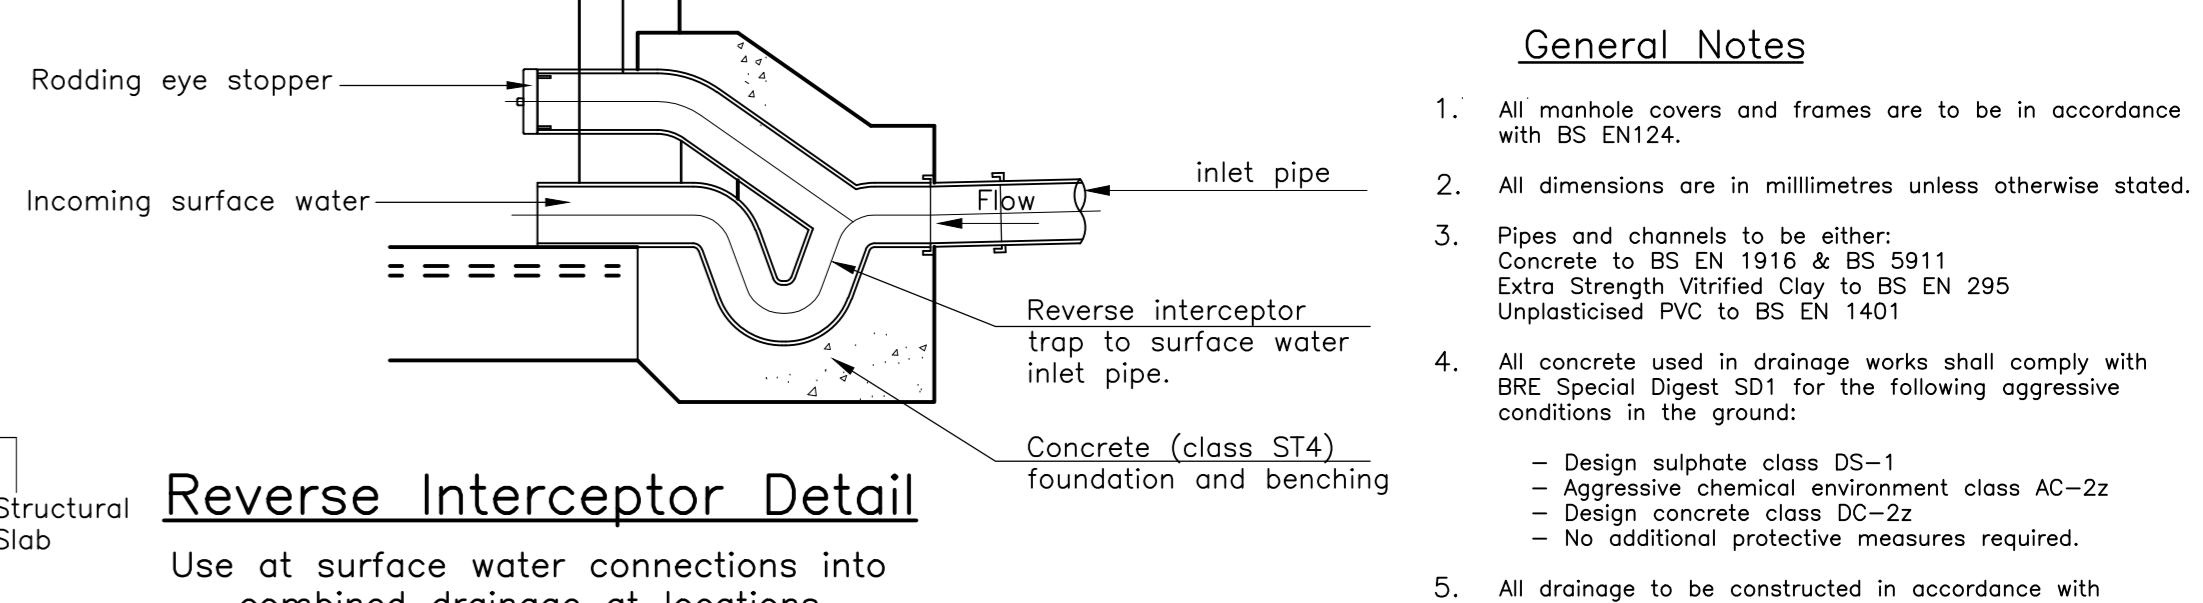

Reverse Interceptor Detail


General Notes

- All manhole covers and frames are to be in accordance with BS EN 124.
- All dimensions are in millimetres unless otherwise stated.
- Pipes and channels to be either:
 - Concrete to BS EN 1318 & BS 5911
 - Extra Strength Verified Clay to BS EN 295
 - Unplasticised PVC to BS EN 1401
- All concrete used in drainage works shall comply with BS 5958 Special Digest S31 for the following aggressive conditions in the ground:
 - Design sulphate class DS-1
 - Aggressive chemical environment class AC-2z
 - Design concrete class DC-2z
 - No additional protective measures required.
- All drainage to be constructed in accordance with BS EN 752.
- Proprietary products shown on drawing shall be installed entirely in accordance with the manufacturer's specification.
- Where a proprietary product is specified an 'equivalent approved' product may be utilised following submission to and approval by the Engineer. It should be noted that use of alternative products may result in various dimensional changes to adjacent elements of the works.
- The Contractor shall provide adequate protection to all drainage works from potential construction plant loading prior to achievement of final proposed surface levels.
- All drainage is to be CCTV surveyed and a copy of the findings issued to the Employer prior to final hand-over.

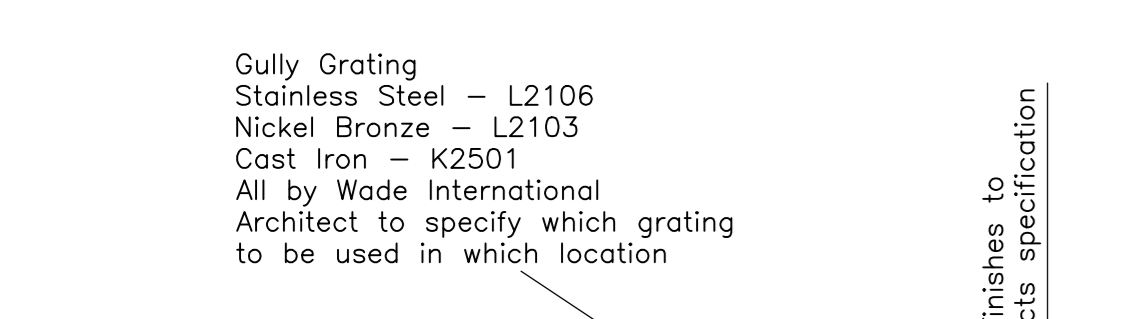


Floor Gully Detail


All product references are Wade International equivalent approved may also be used, See General notes 6 and 7.

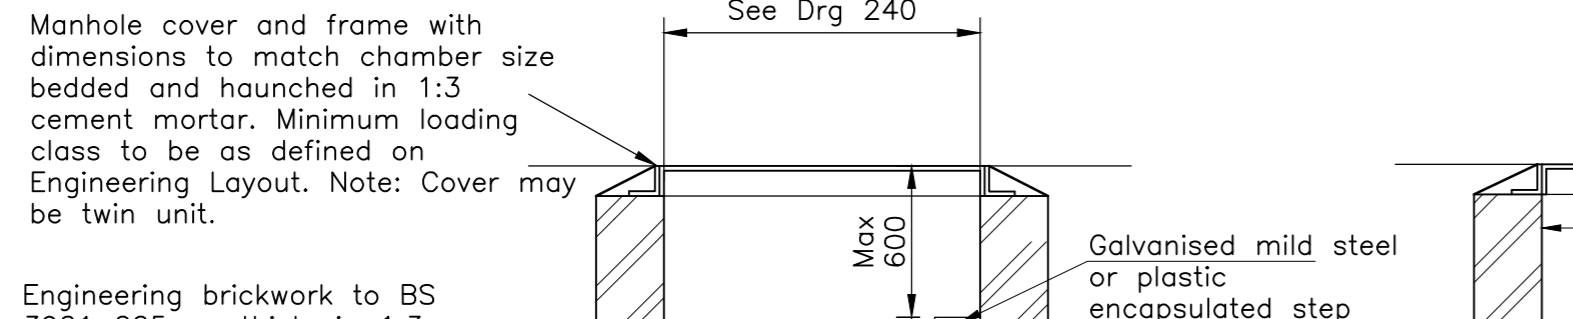


Typical External Rectangular Manhole Detail - Foul Drainage

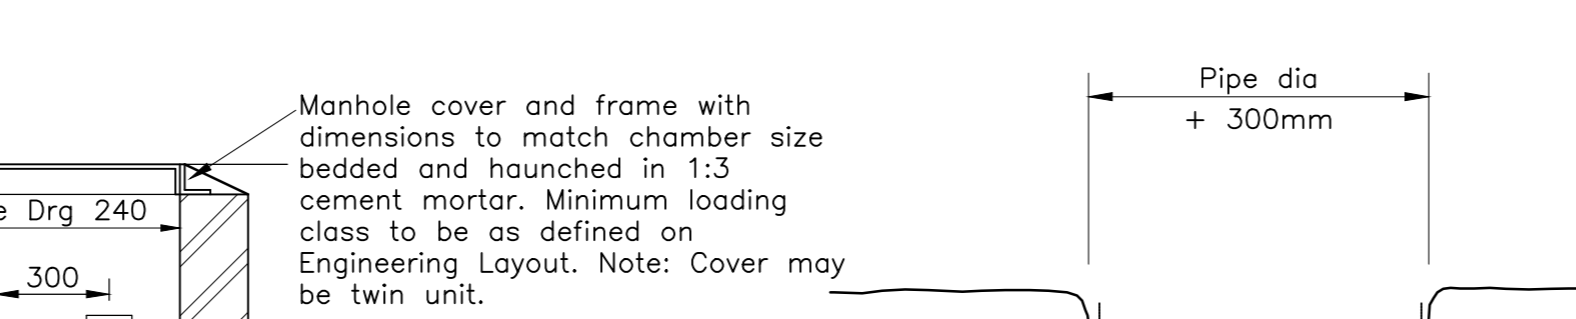


Pumped Main Typical External Section

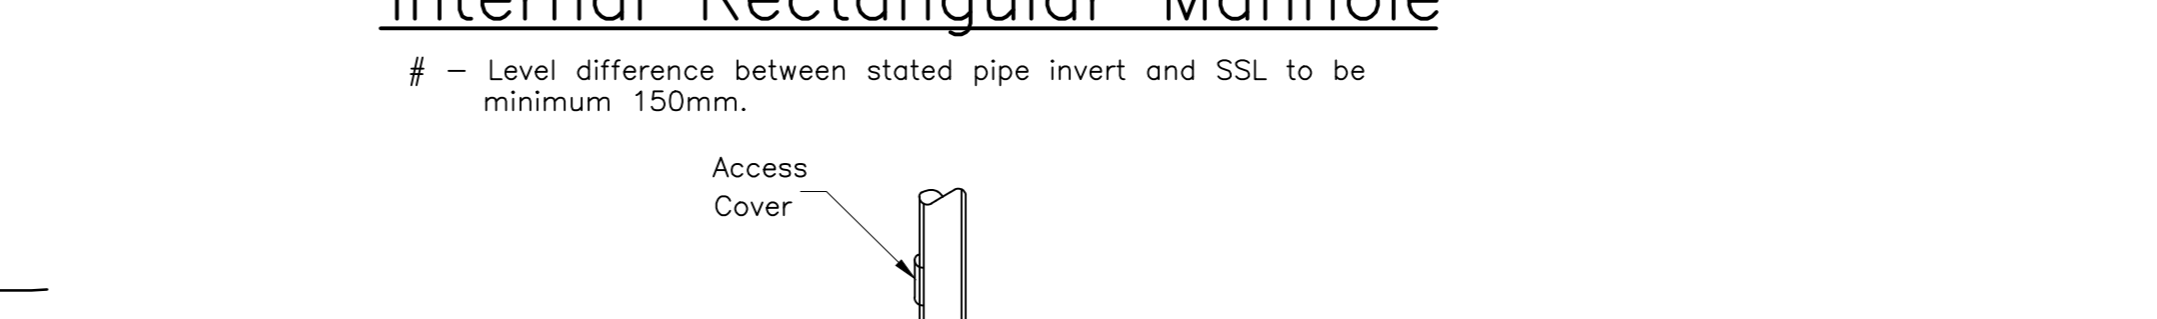


Suspended Drainage Detail

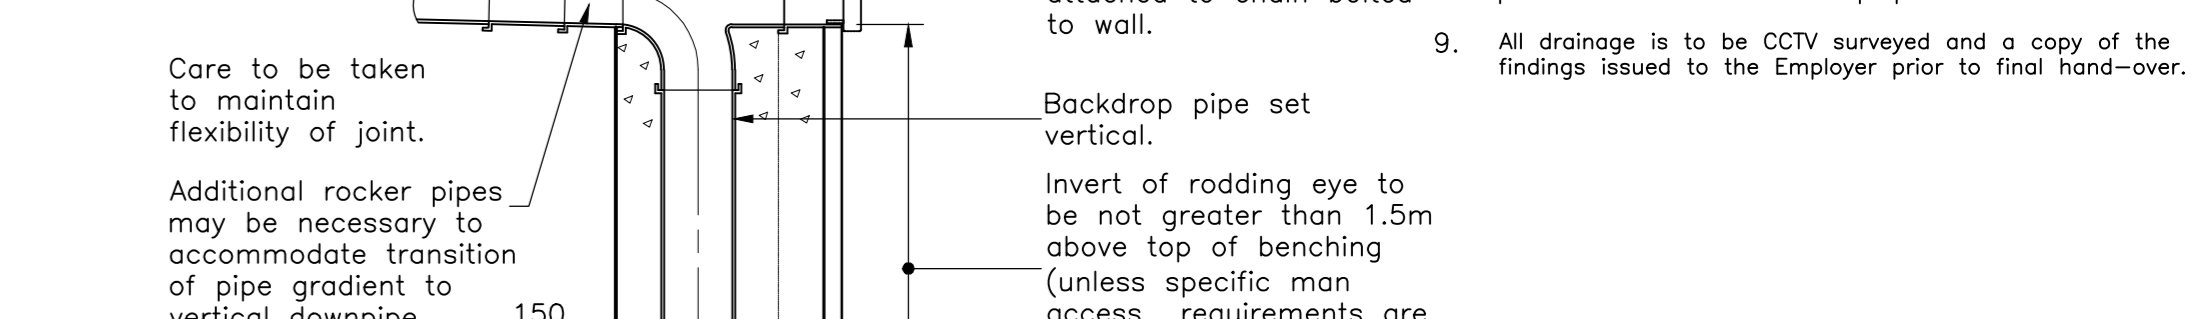


Typical Vertical Backdrop Detail

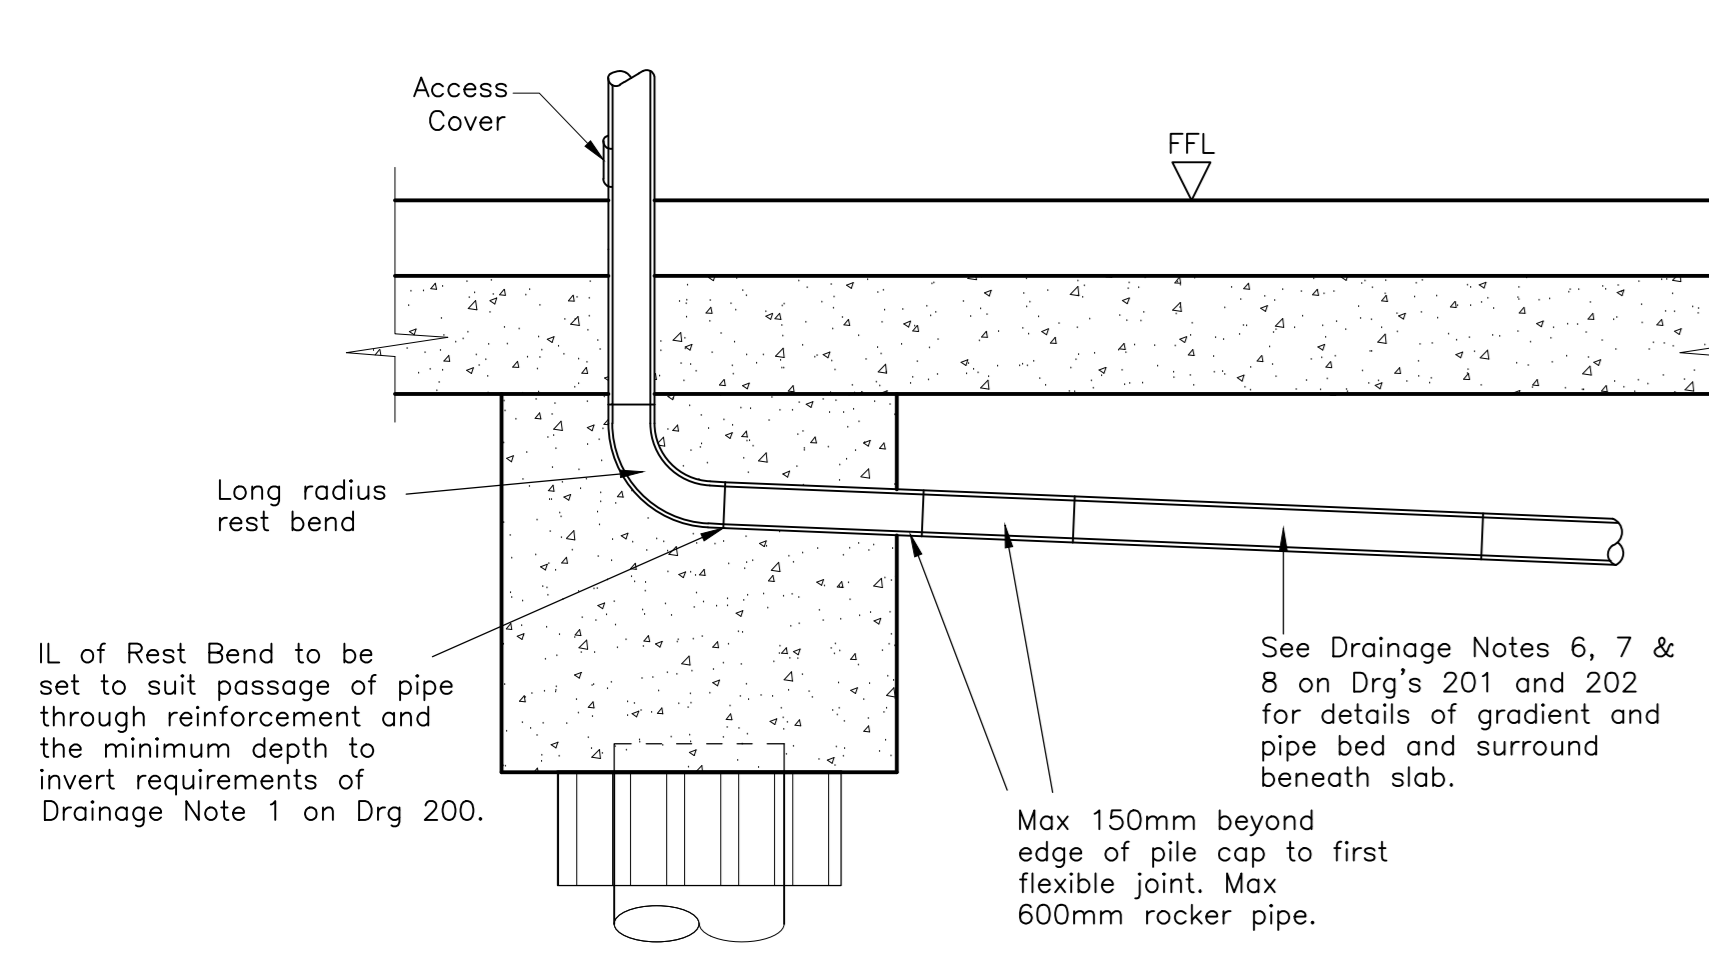


Typical Detail of Rest-Bend Through Ground Beam or Pile Cap

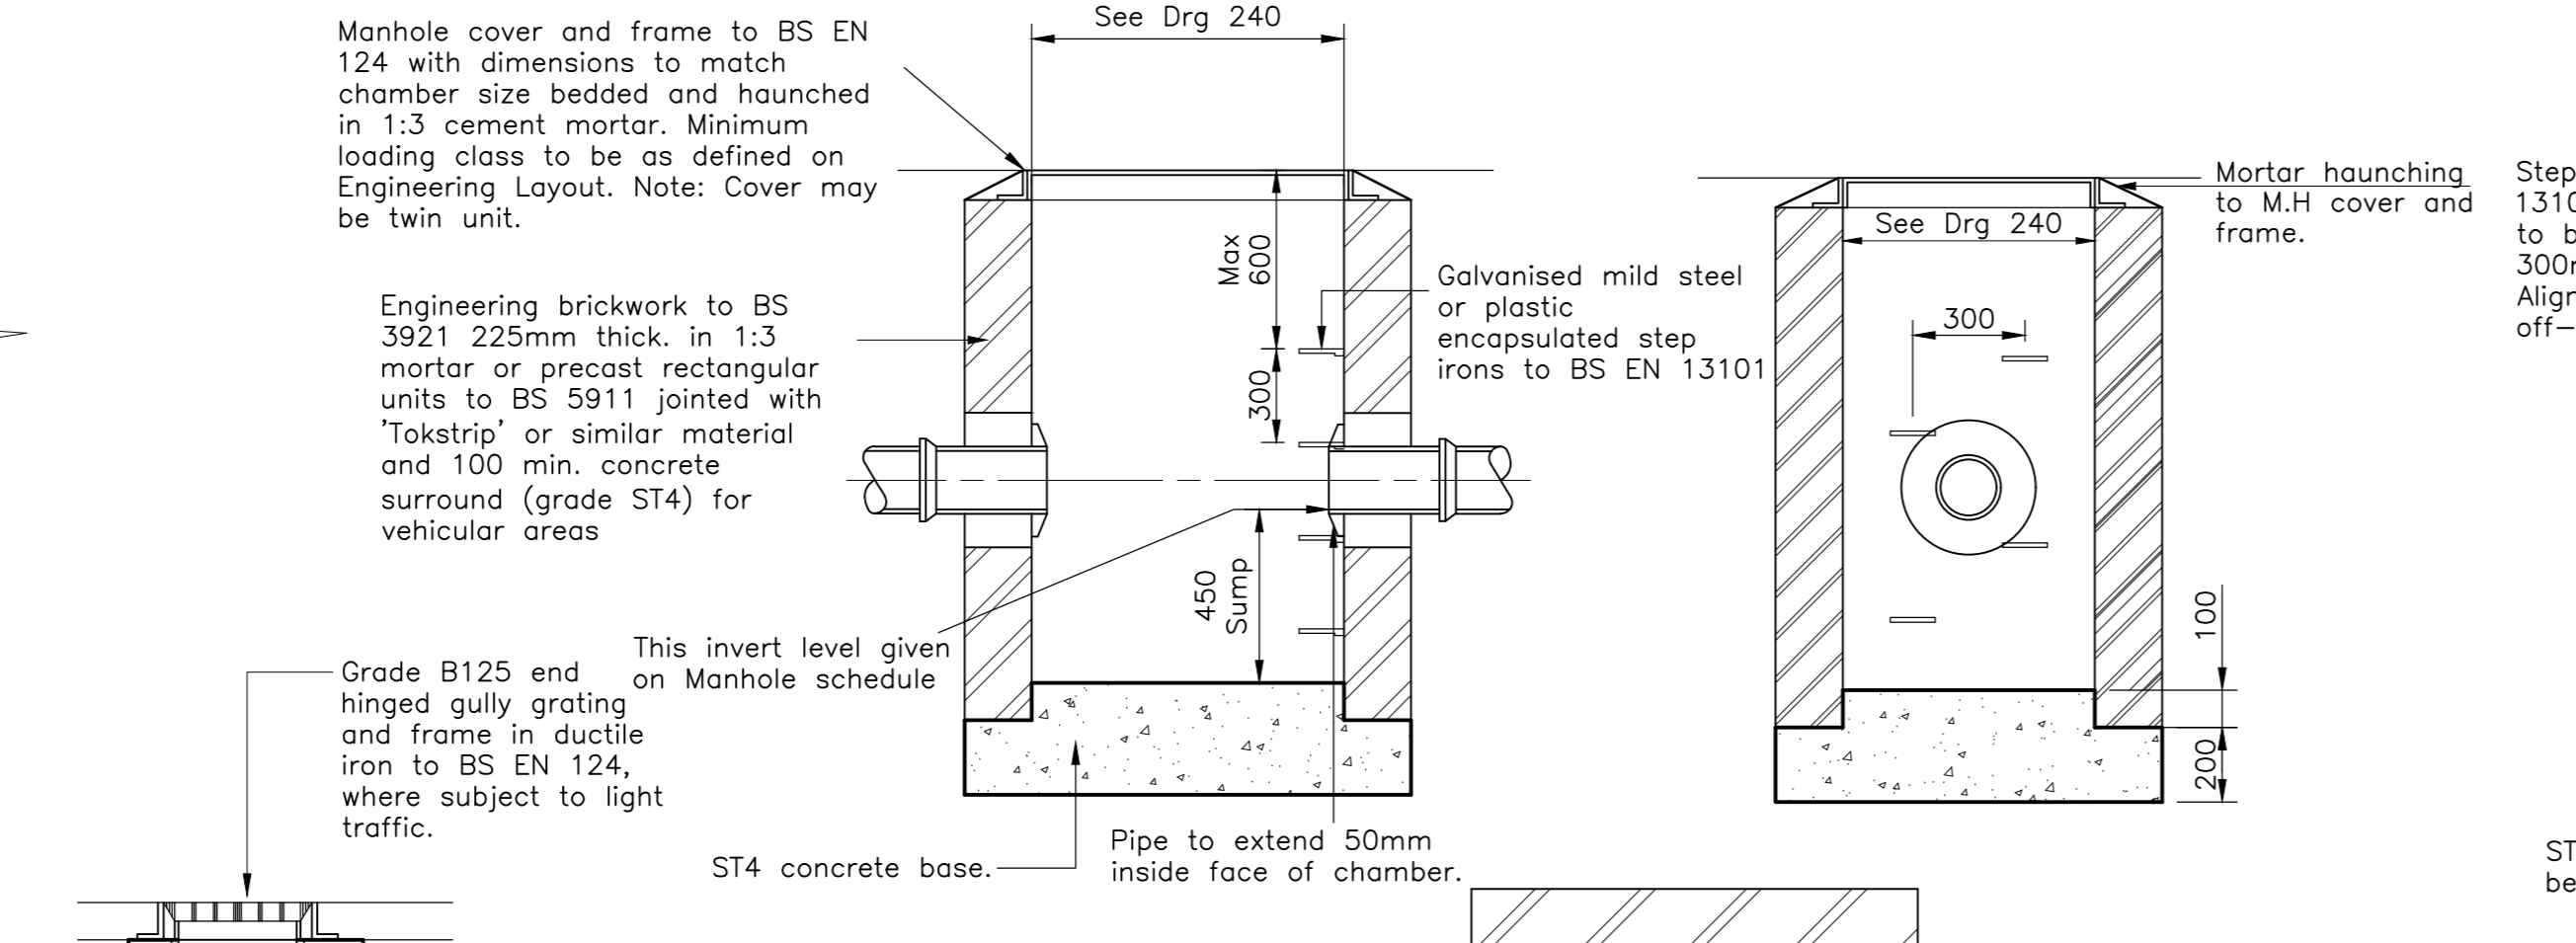


Typical Rectangular Manhole Detail with Sump - Storm Drainage

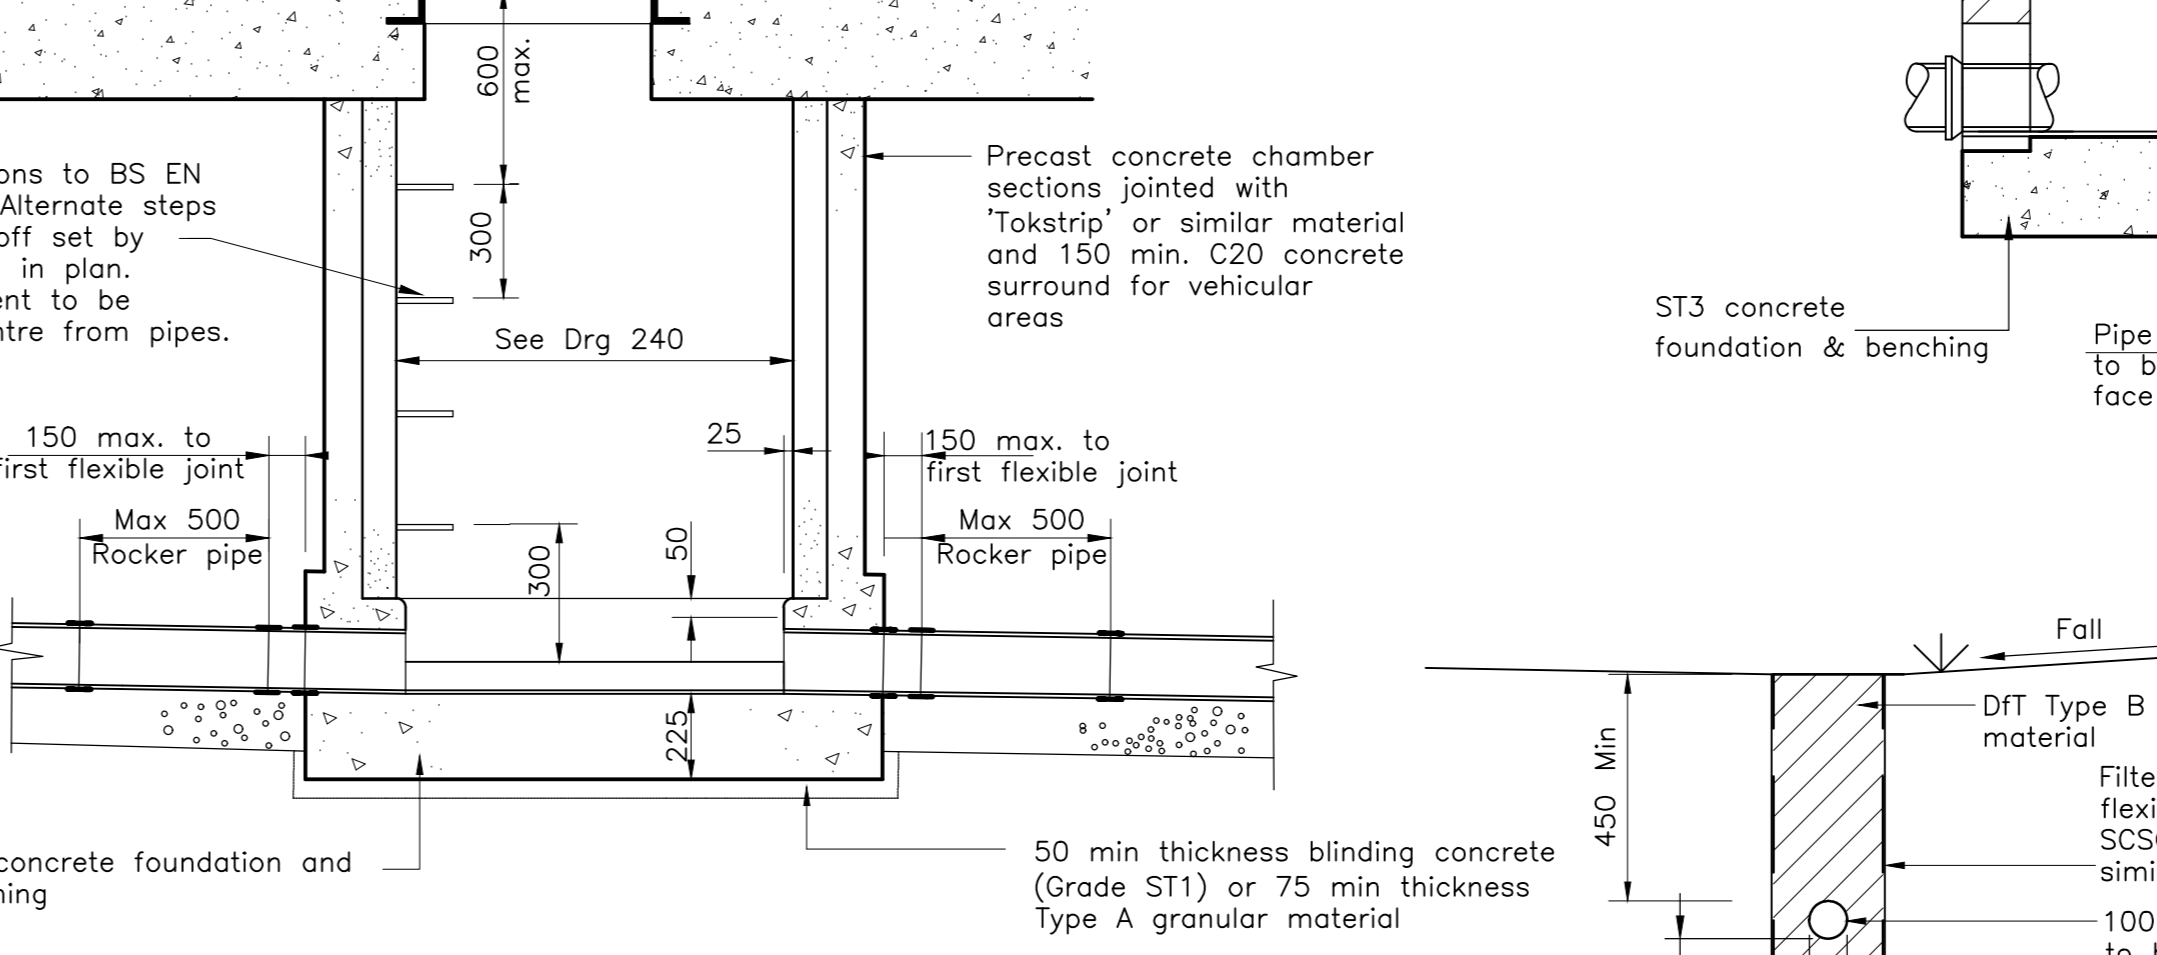


Precast Concrete Ring Inspection Chamber Recessed Cover

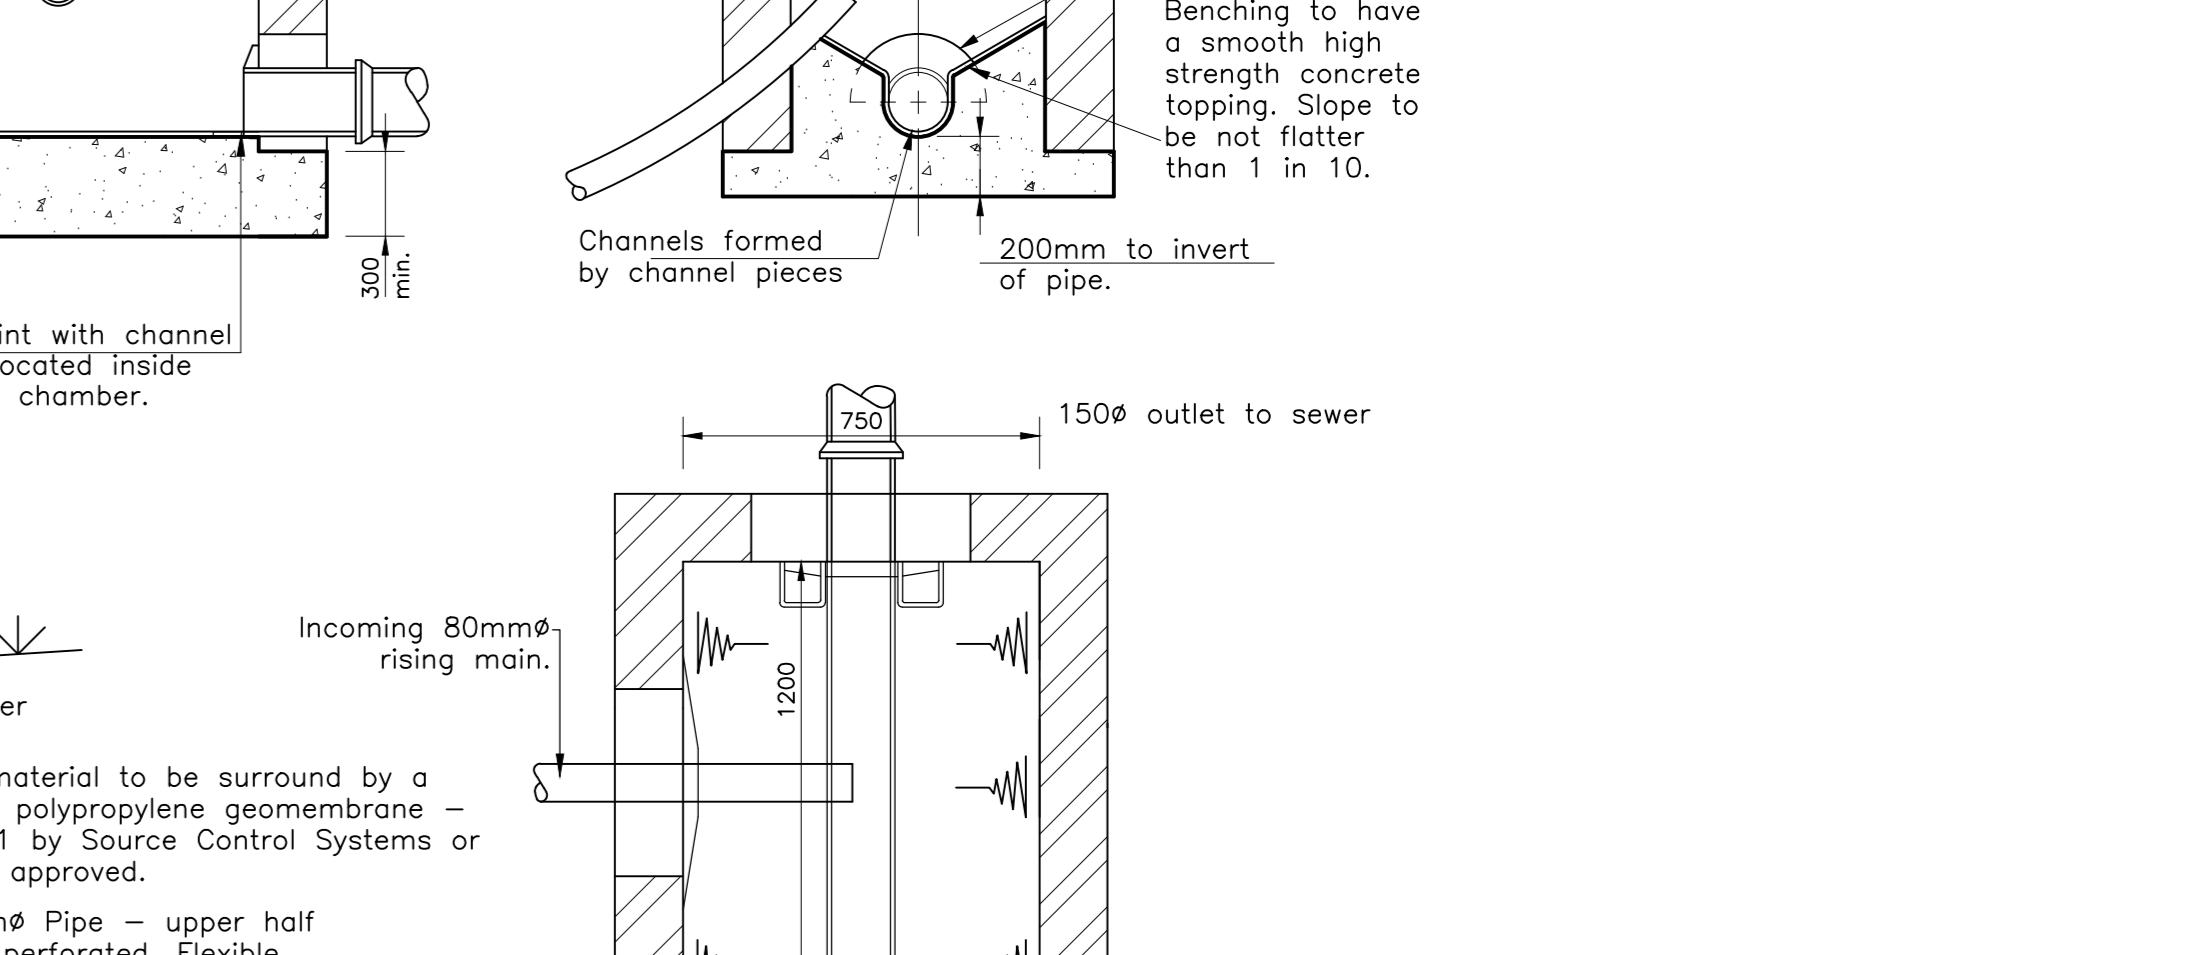


Open-Topped Land Drain

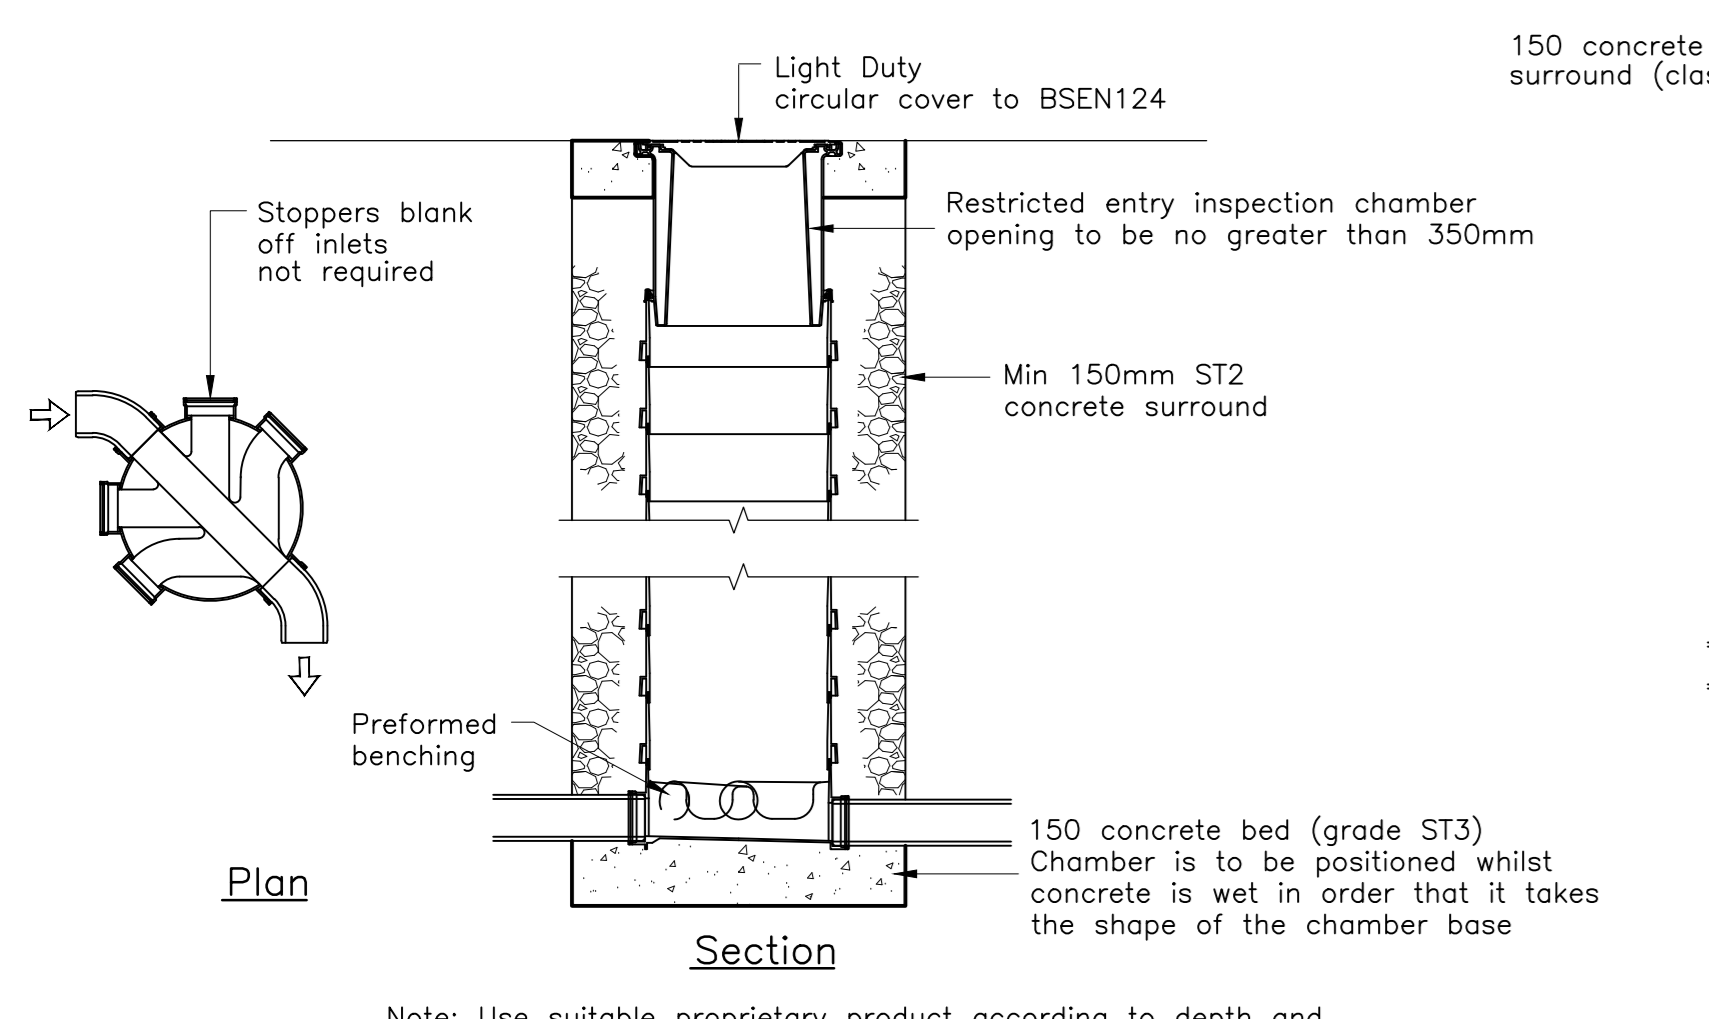


Yard Gully Detail

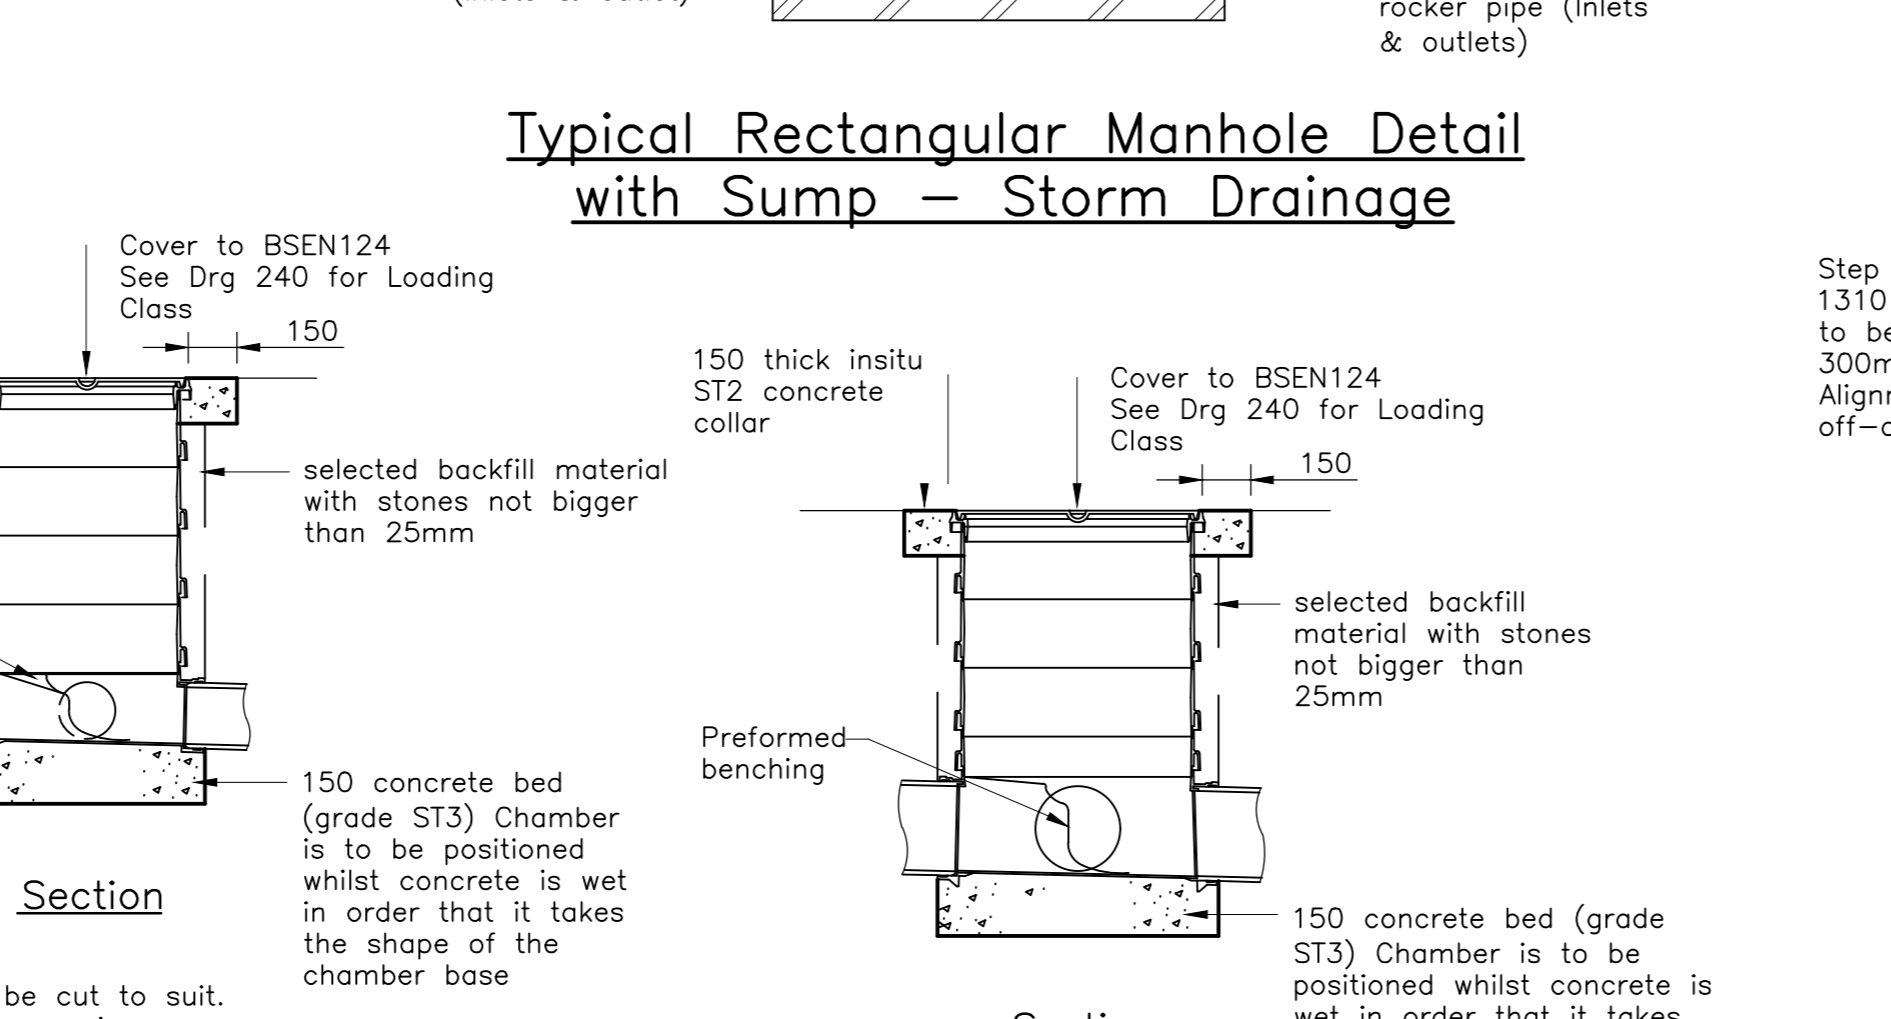


600 Polypropylene Inspection Chamber Details

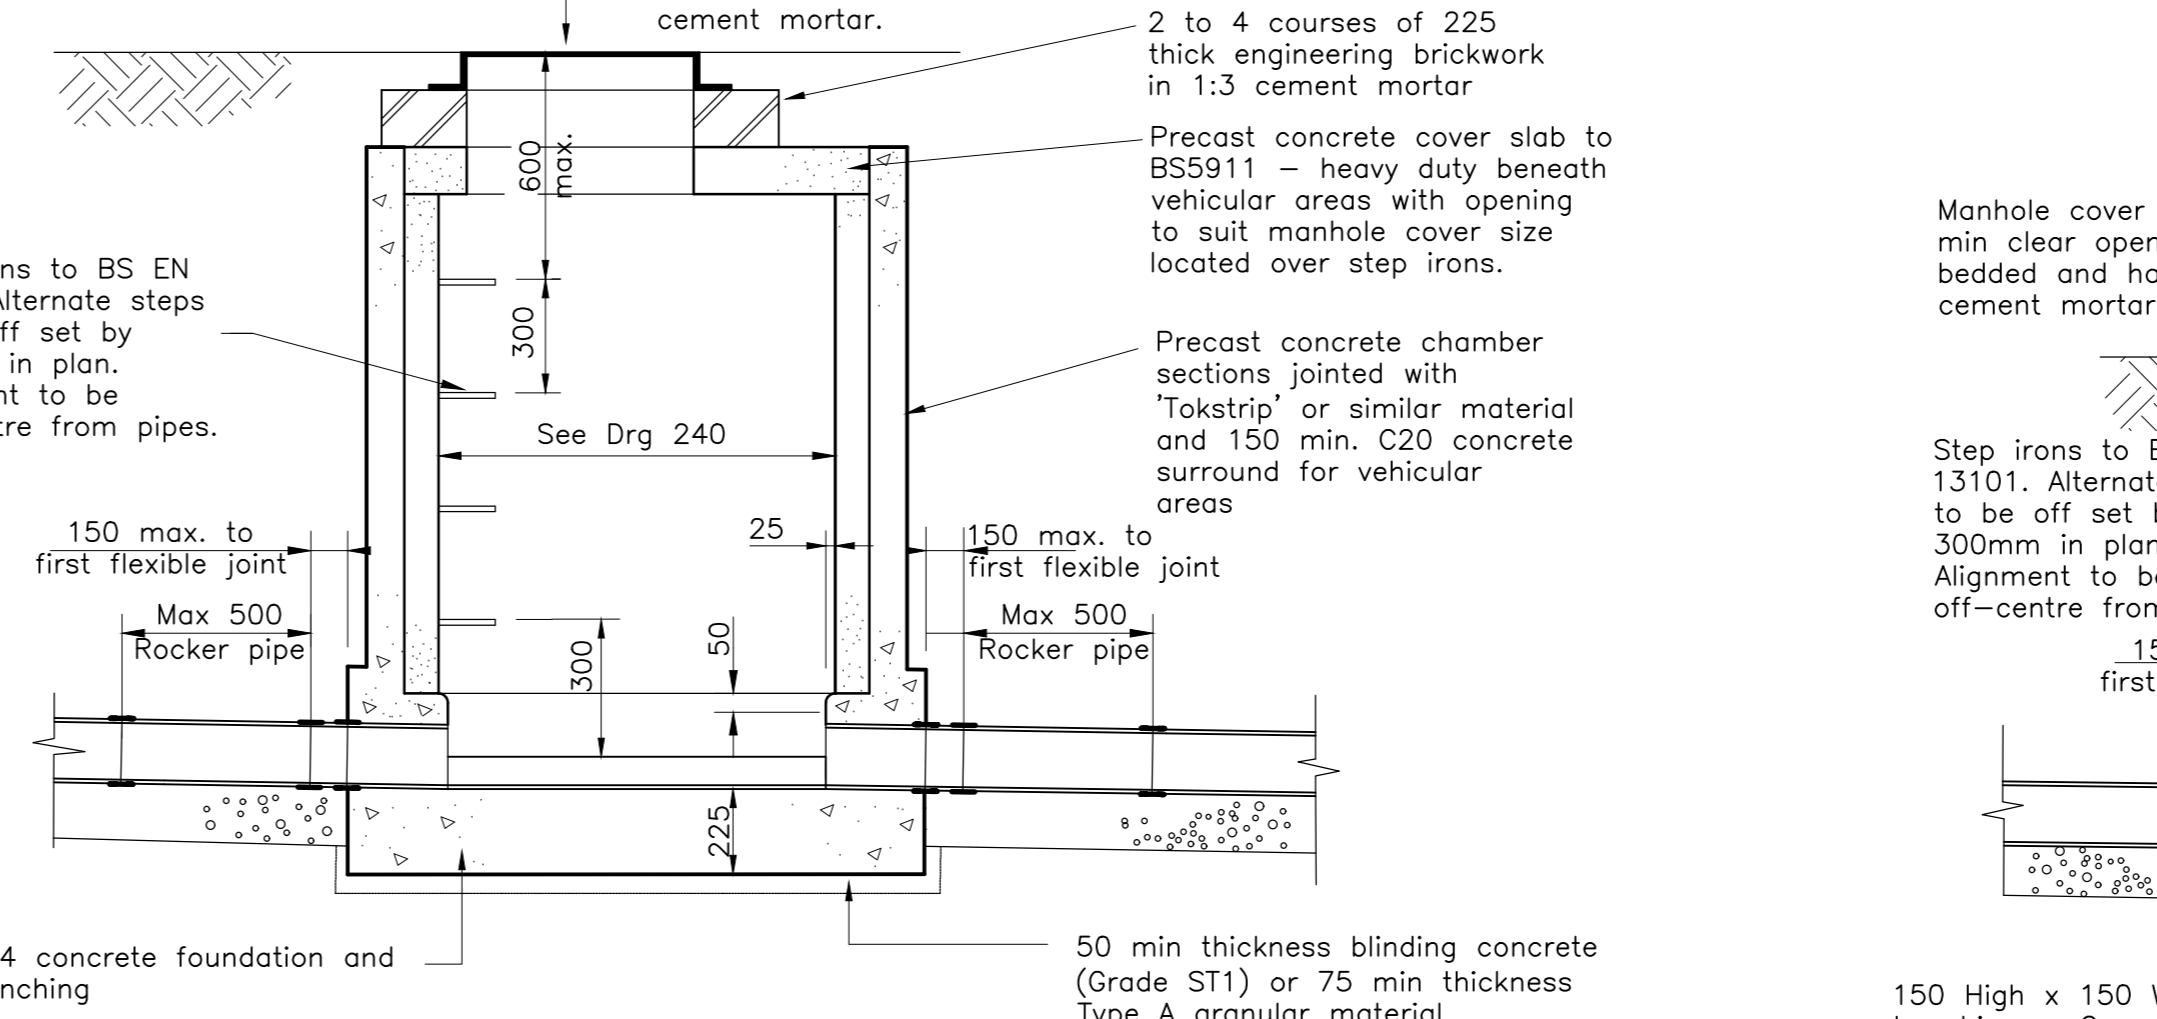


Typical Precast Concrete Ring Inspection Chamber

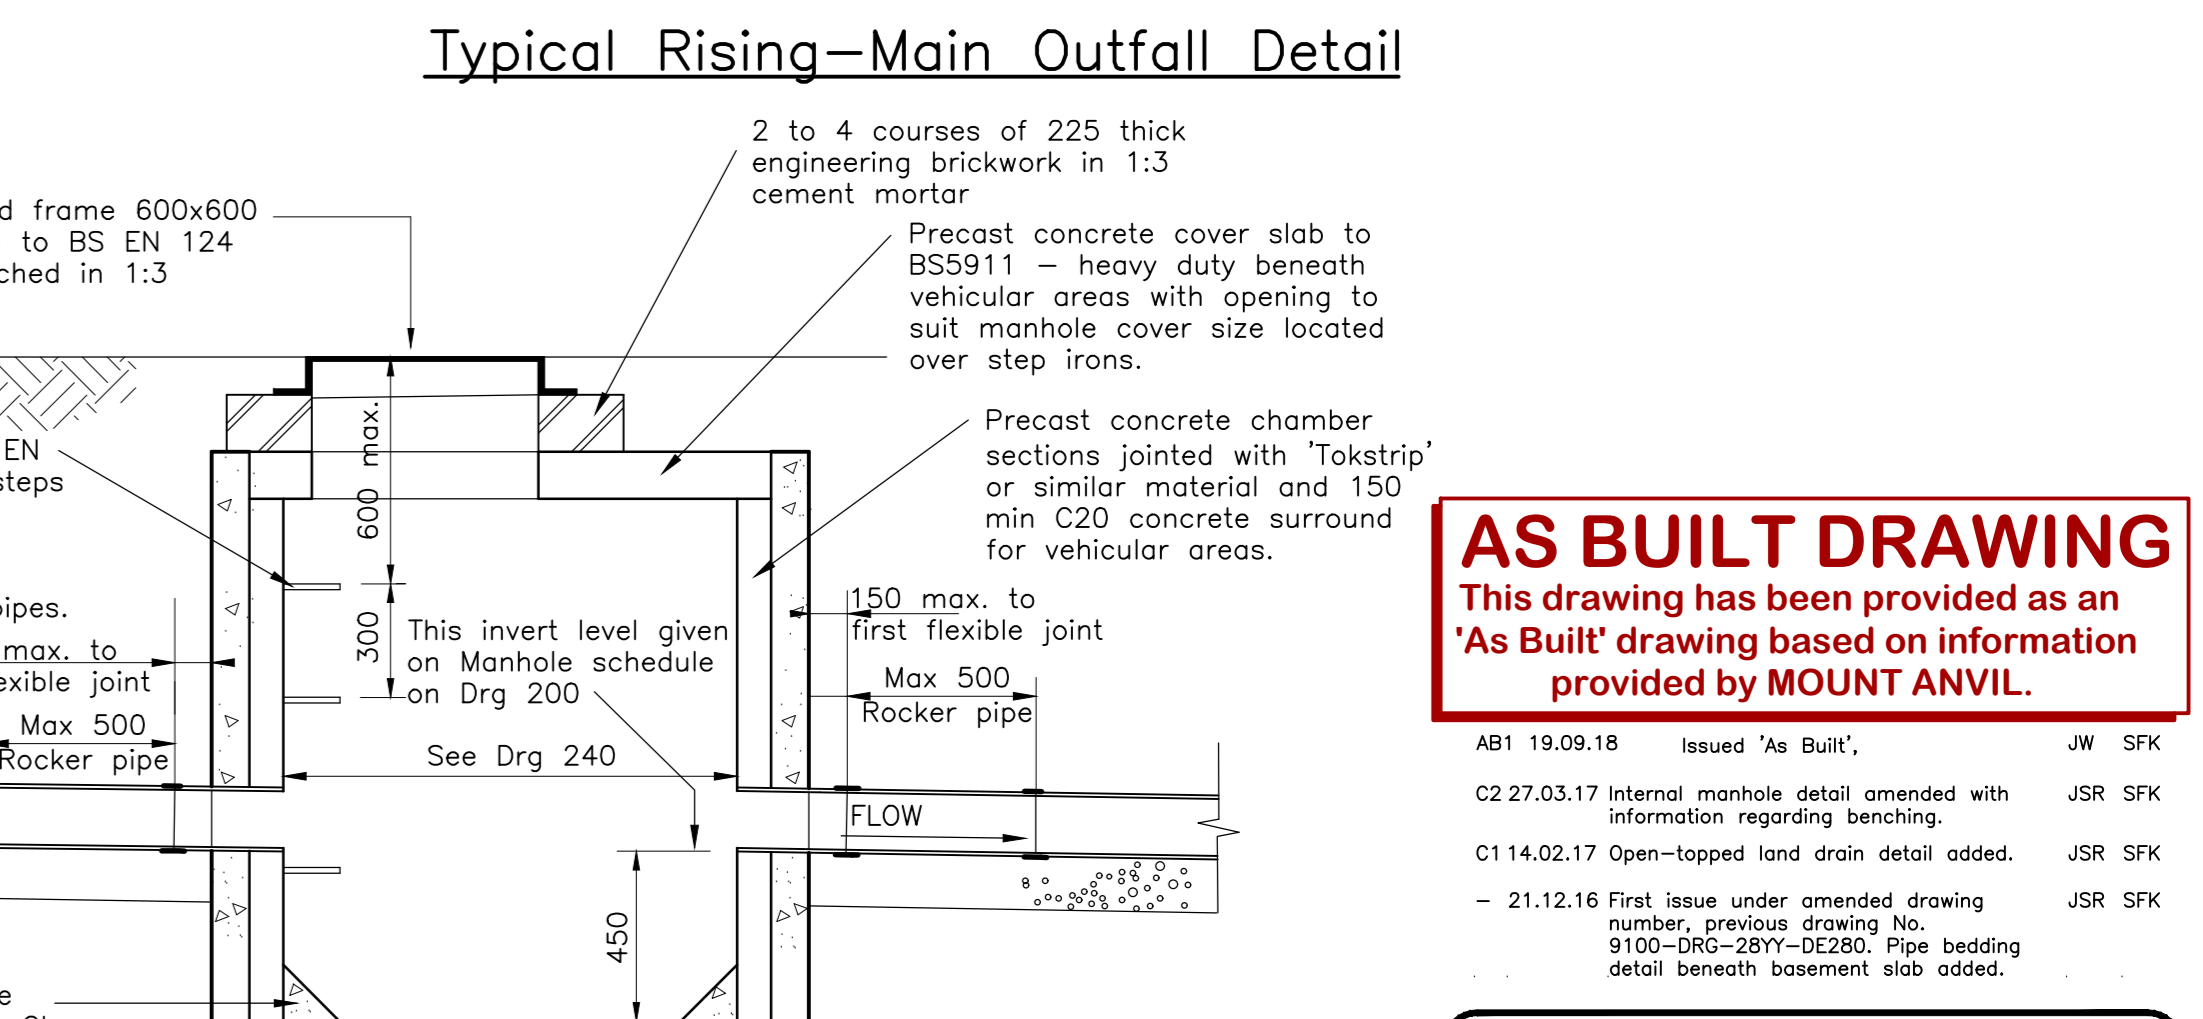


Typical Rising-Main Outfall Detail

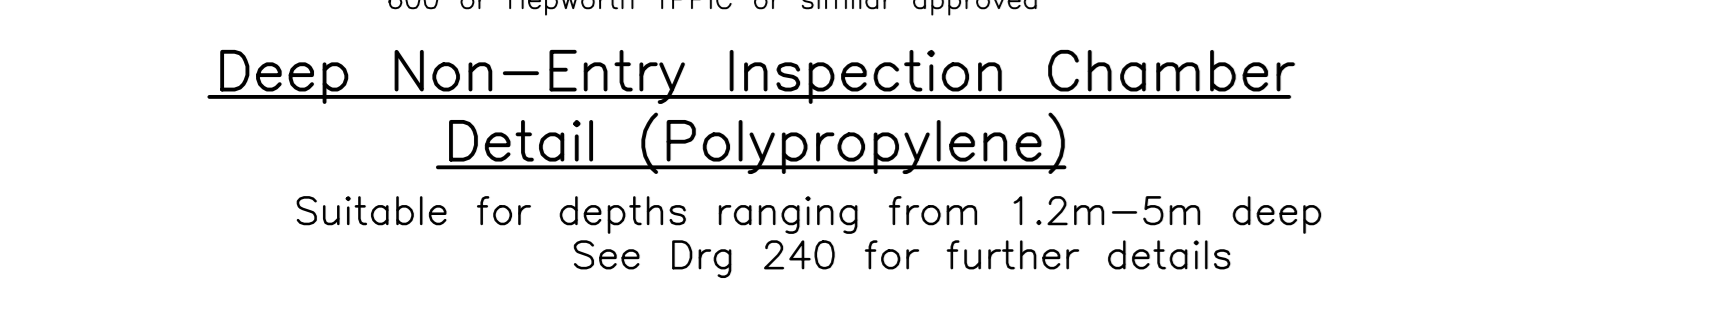

Deep Non-Entry Inspection Chamber Detail (Polypropylene)

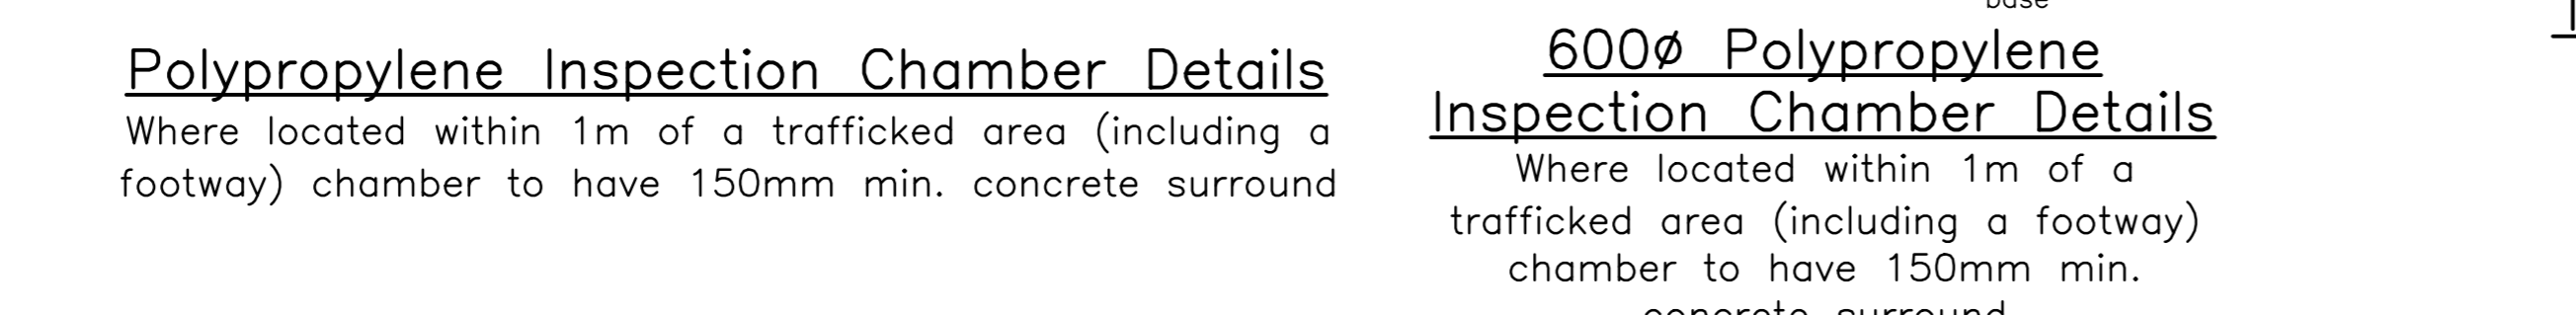

Polypropylene Inspection Chamber Details

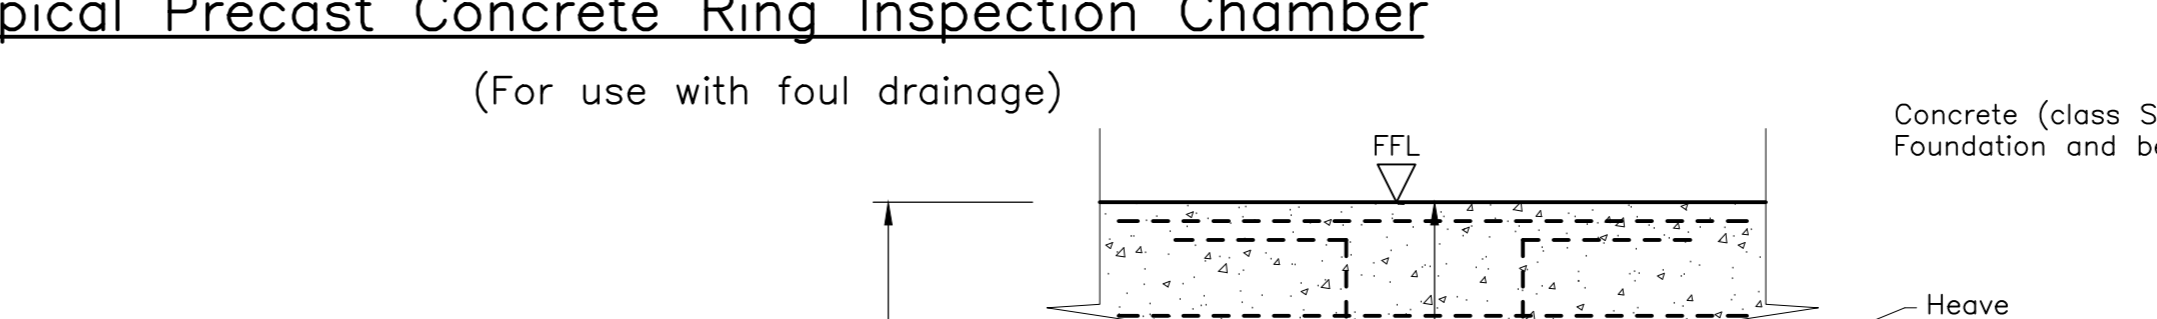

Precast Concrete Ring Inspection Chamber with Sump

Pipe Bedding & Sideliff Materials.

Type A bedding material shall be aggregates conforming to BS EN 12620, or BS EN 1047, nominal single-size or graded complying with the recommendations of WIS No. 4-08-01 as follows:-


TABLE 1 :	Single-size.	Graded.
Over 100 to 150	10mm nominal single-size.	
Over 150 to 500	10 or 14mm nominal single-size.	14mm to 5mm graded.
Over 500	10,14 or 20mm nominal single-size.	14 or 5mm graded or 20mm nominal single-size.

Pipes Laid with a Concrete Bedding Surround


Class A concrete surround to be minimum cube strength 2 at 28 days of 20N/mm for non-aggressive soils. For aggressive soil conditions the concrete mix shall be in accordance with the requirements of BRE Digest 250, or BRE paper CP23/77 as appropriate. The backfill, other than the first 150mm of cover, should not be placed before the compressive strength of the site concrete has reached 14N/mm². The concrete mix should be so designed that it is reached without a compressible filler shall be placed throughout the concrete surround at all pipe joints. This shall consist of bitumen impregnated insulating board to BS 1142, or other equally compressible material. The thickness of compressible filler shall be as follows:-

Nominal diameter of pipe (mm)	Thickness of Compressible filler (mm)
Less than 450	18
450 - 1200	36
Exceeding 1200	54


Compressible packing for use between pipes and precast concrete setting blocks shall consist of bitumen damp-proof sheeting complying with BS 743.

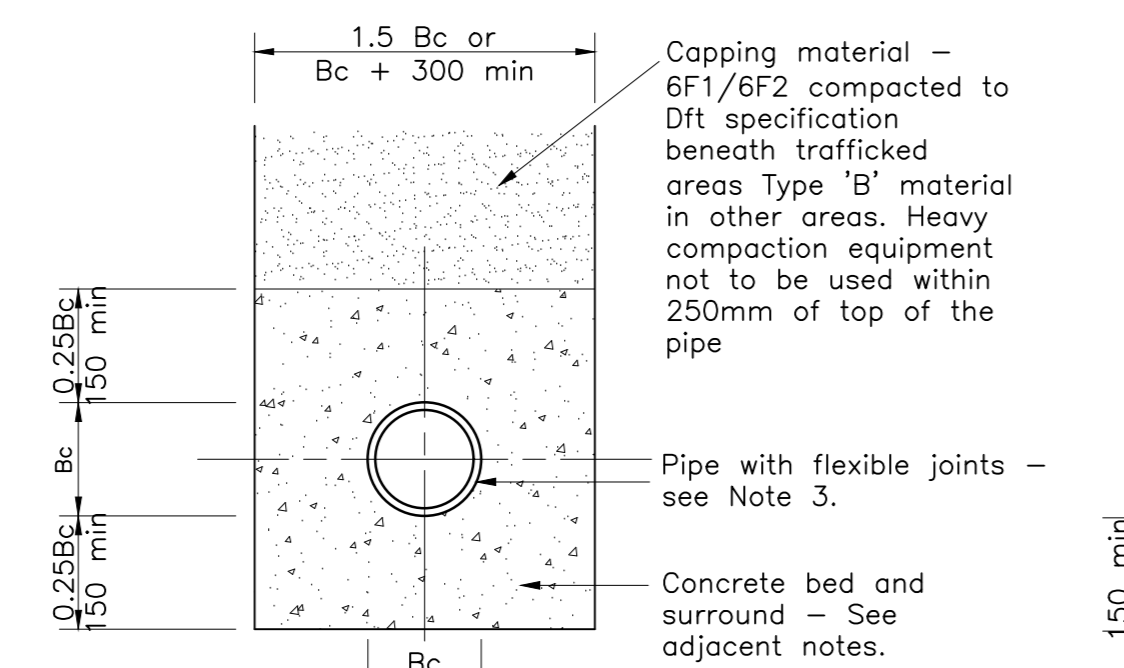

CLASS 'A'

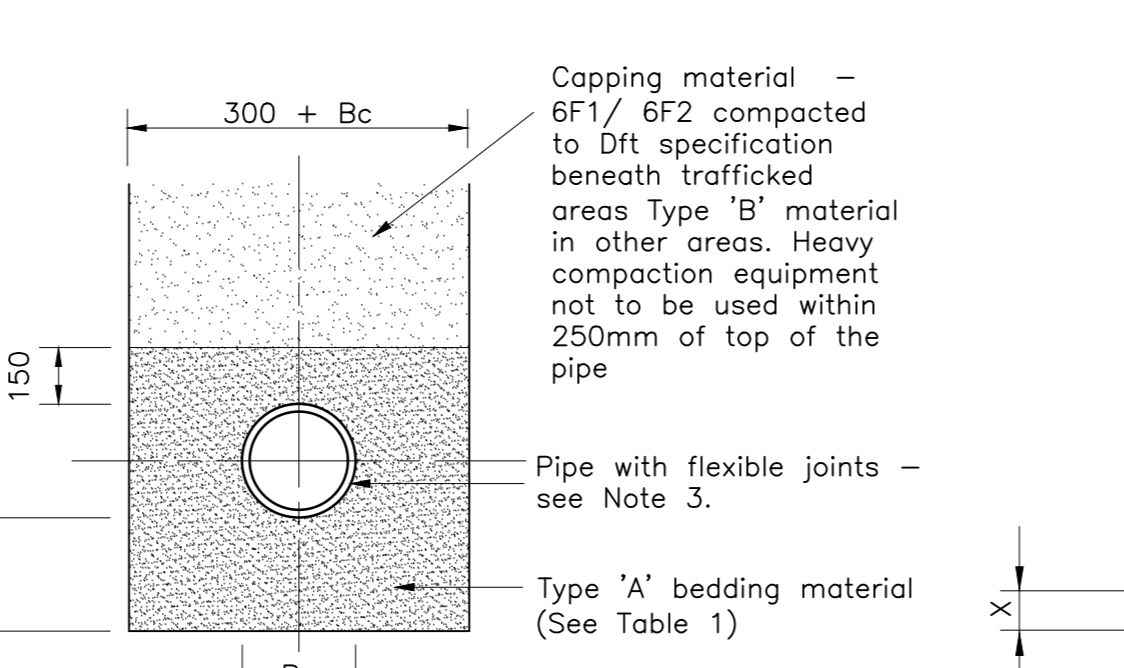

CLASS 'S'

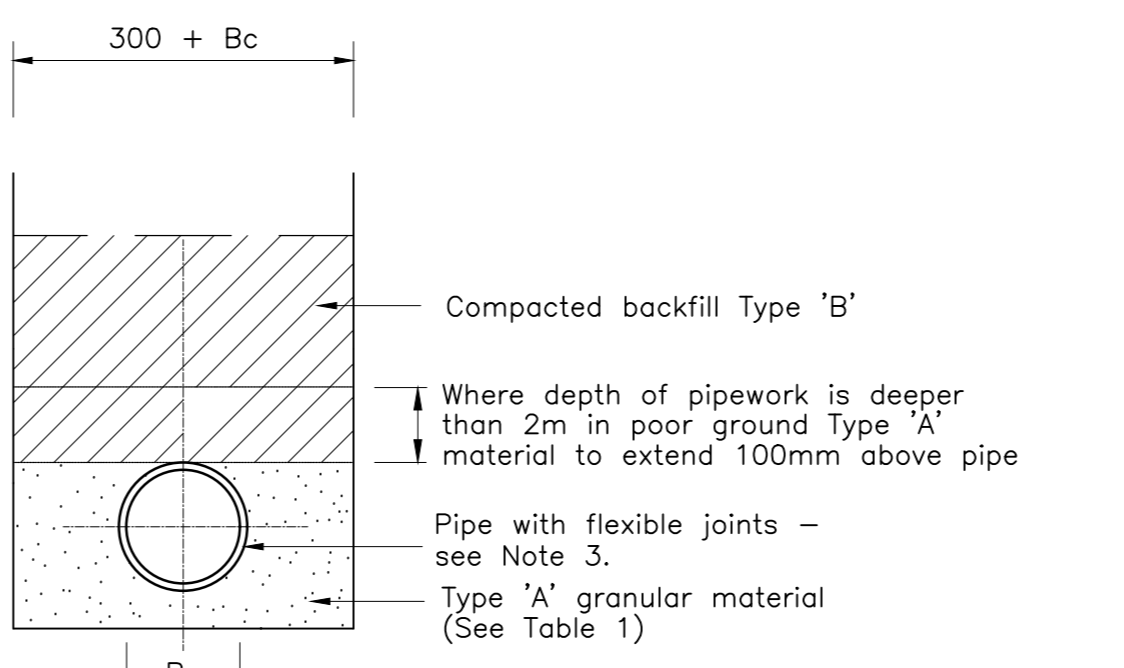


CLASS 'F'

Use where depth to pipe soffit <1200 beneath external trafficked areas, and <600mm beneath all other areas.

Use beneath external trafficked areas where depth to pipe soffit is >1200mm.

Use beneath non-trafficked areas only where depth to pipe soffit is > 600mm

Typical Private Pipe & Bedding Details

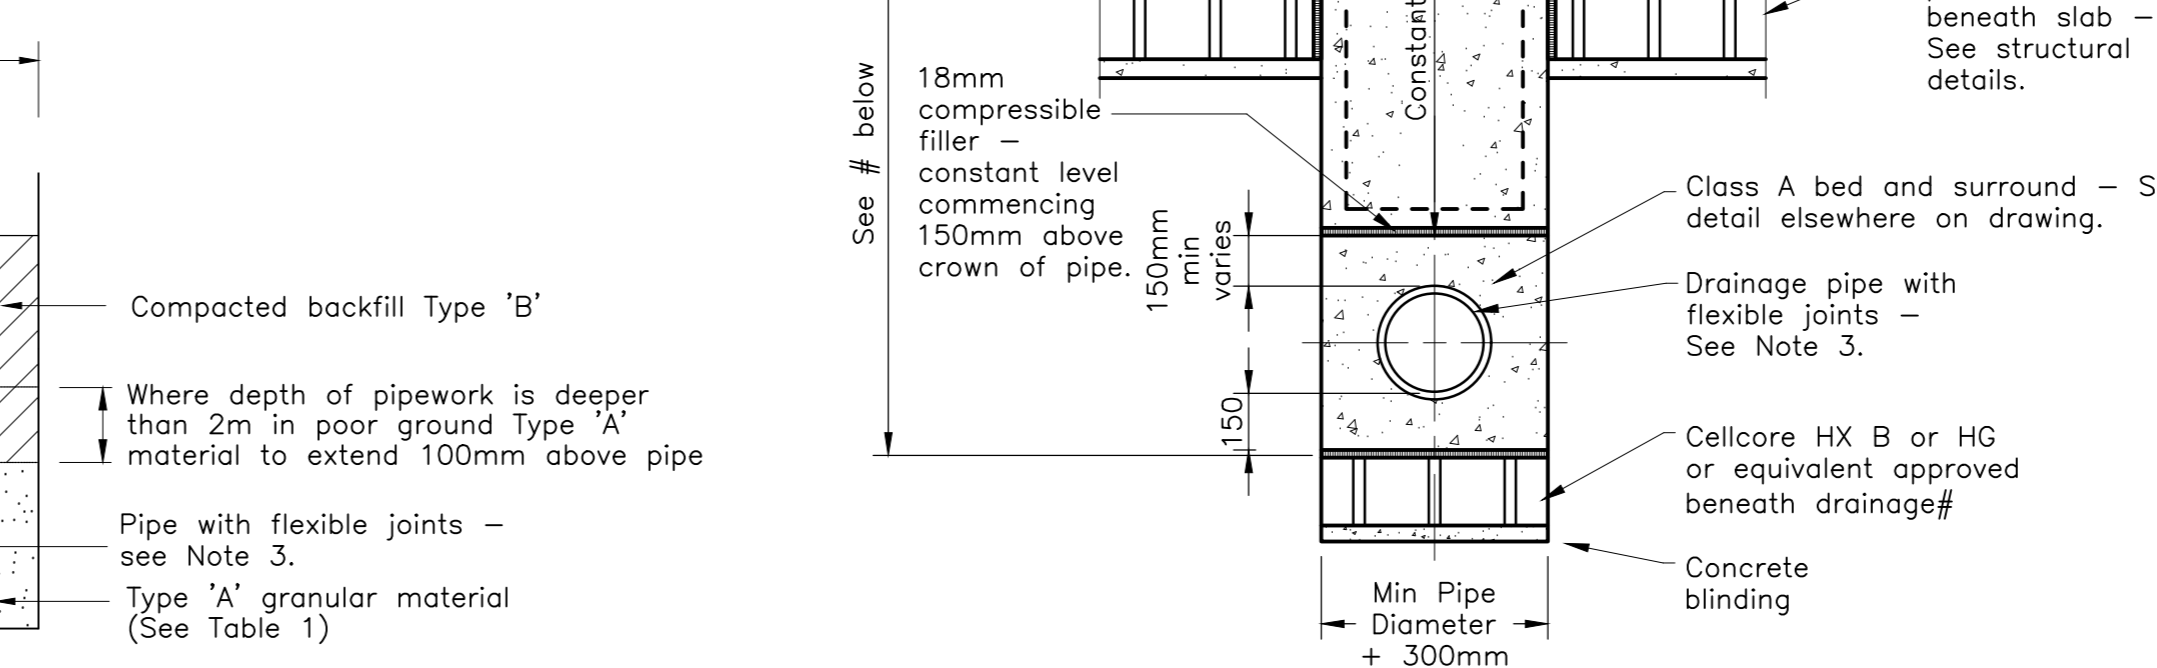

Pipe Bedding Detail Beneath Basement Slab - Where Ground Heave Protection Is Required - See also 9100-DRG-34YY-00201 & 9100-DRG-34YY-00202

The recommended maximum permissible load applied by the wet concrete as associated with the heave protection material shall not be exceeded. Where necessary the concrete shall be placed in stages so as not to exceed this load.

AS BUILT DRAWING
This drawing has been provided as an 'As Built' drawing based on information provided by MOUNT ANVIL.


REV	DATE	DESCRIPTION	BY	CHKD
A21.10.18	Issued 'As Built'		JW	SFK
C27.03.17	Internal manhole detail amended with information regarding benching.		JSR	SFK
C114.02.17	Open-topped land drain detail added.		JSR	SFK
- 21.12.16	First issue under amended drawing number, previous drawing No. 9100-DRG-34YY-00200. Pipe bedding detail beneath basement slab added.		JSR	SFK



Private Drainage Details
Sheet 1 of 2

Project No: 11581
Kidderpore Avenue

SCALE: 1:20000 DATE: June 2016 DRAWN: JSR CHKD: SFK
DRG NO. 9100-DRG-34YY-DE280AB1

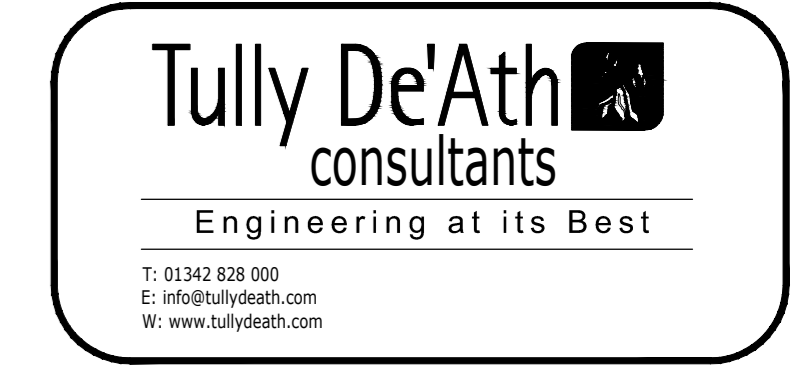

Engineering at its Best