




Section A-A

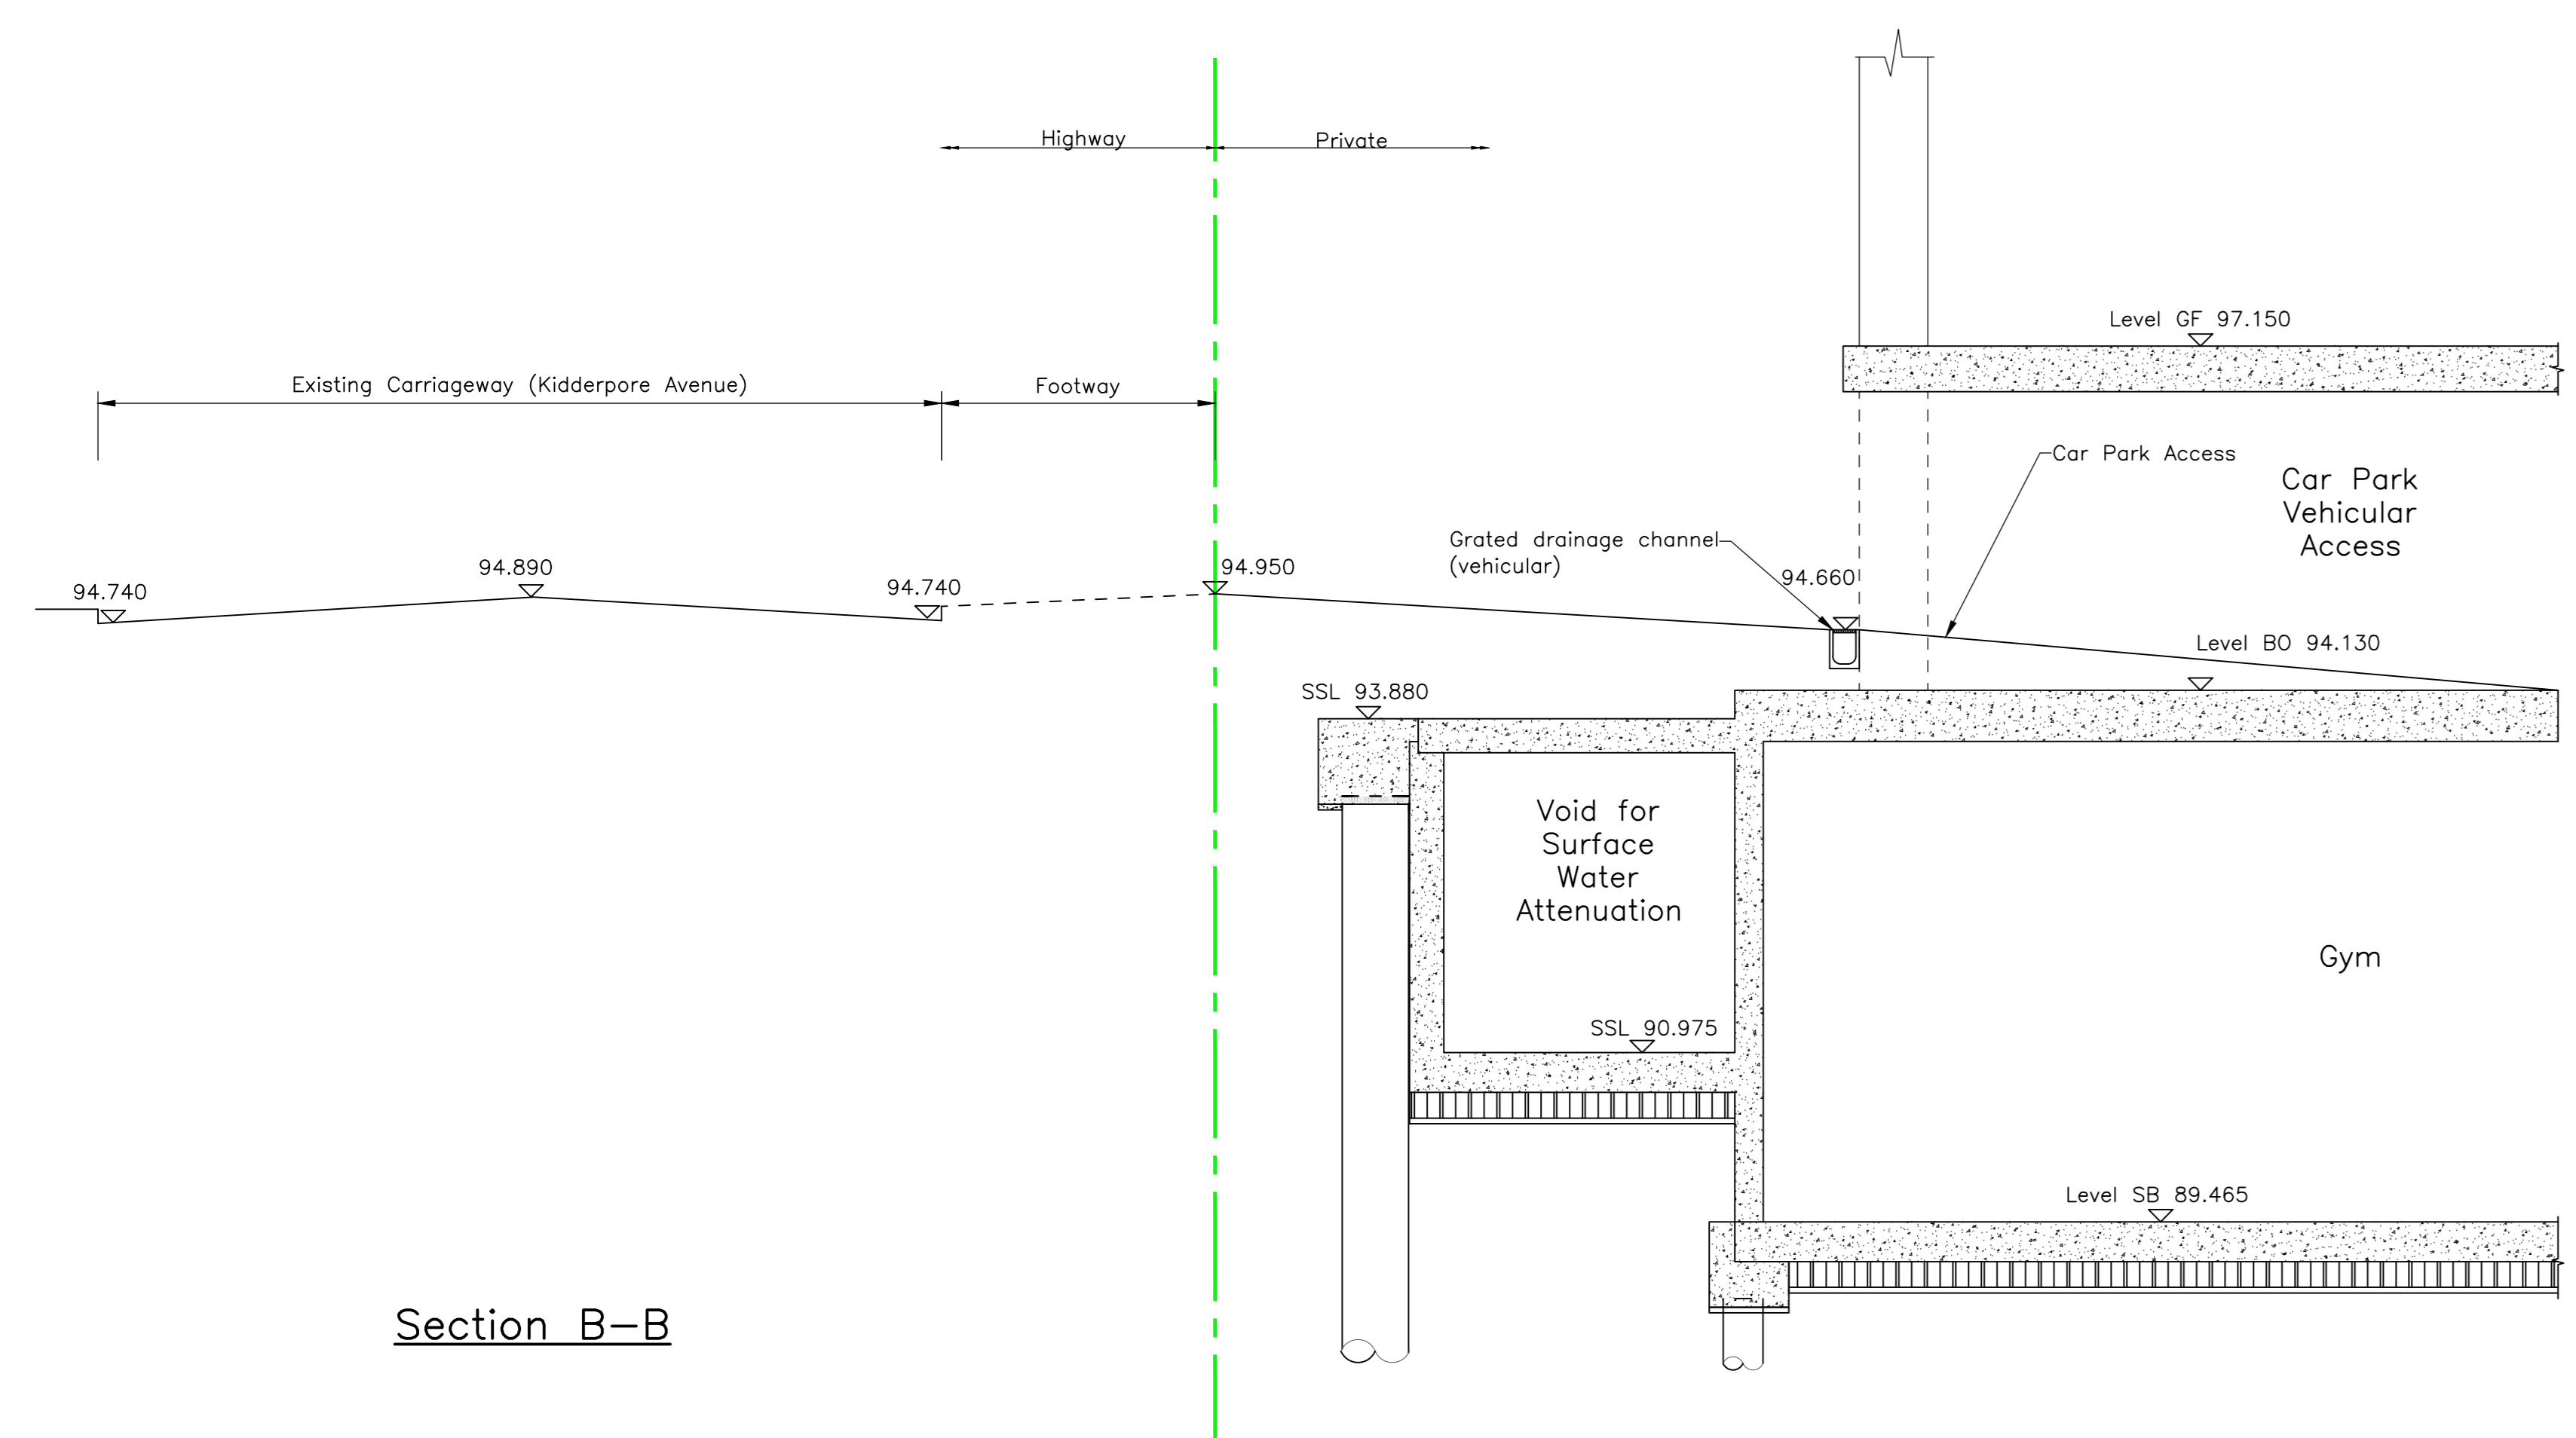


Section B-B

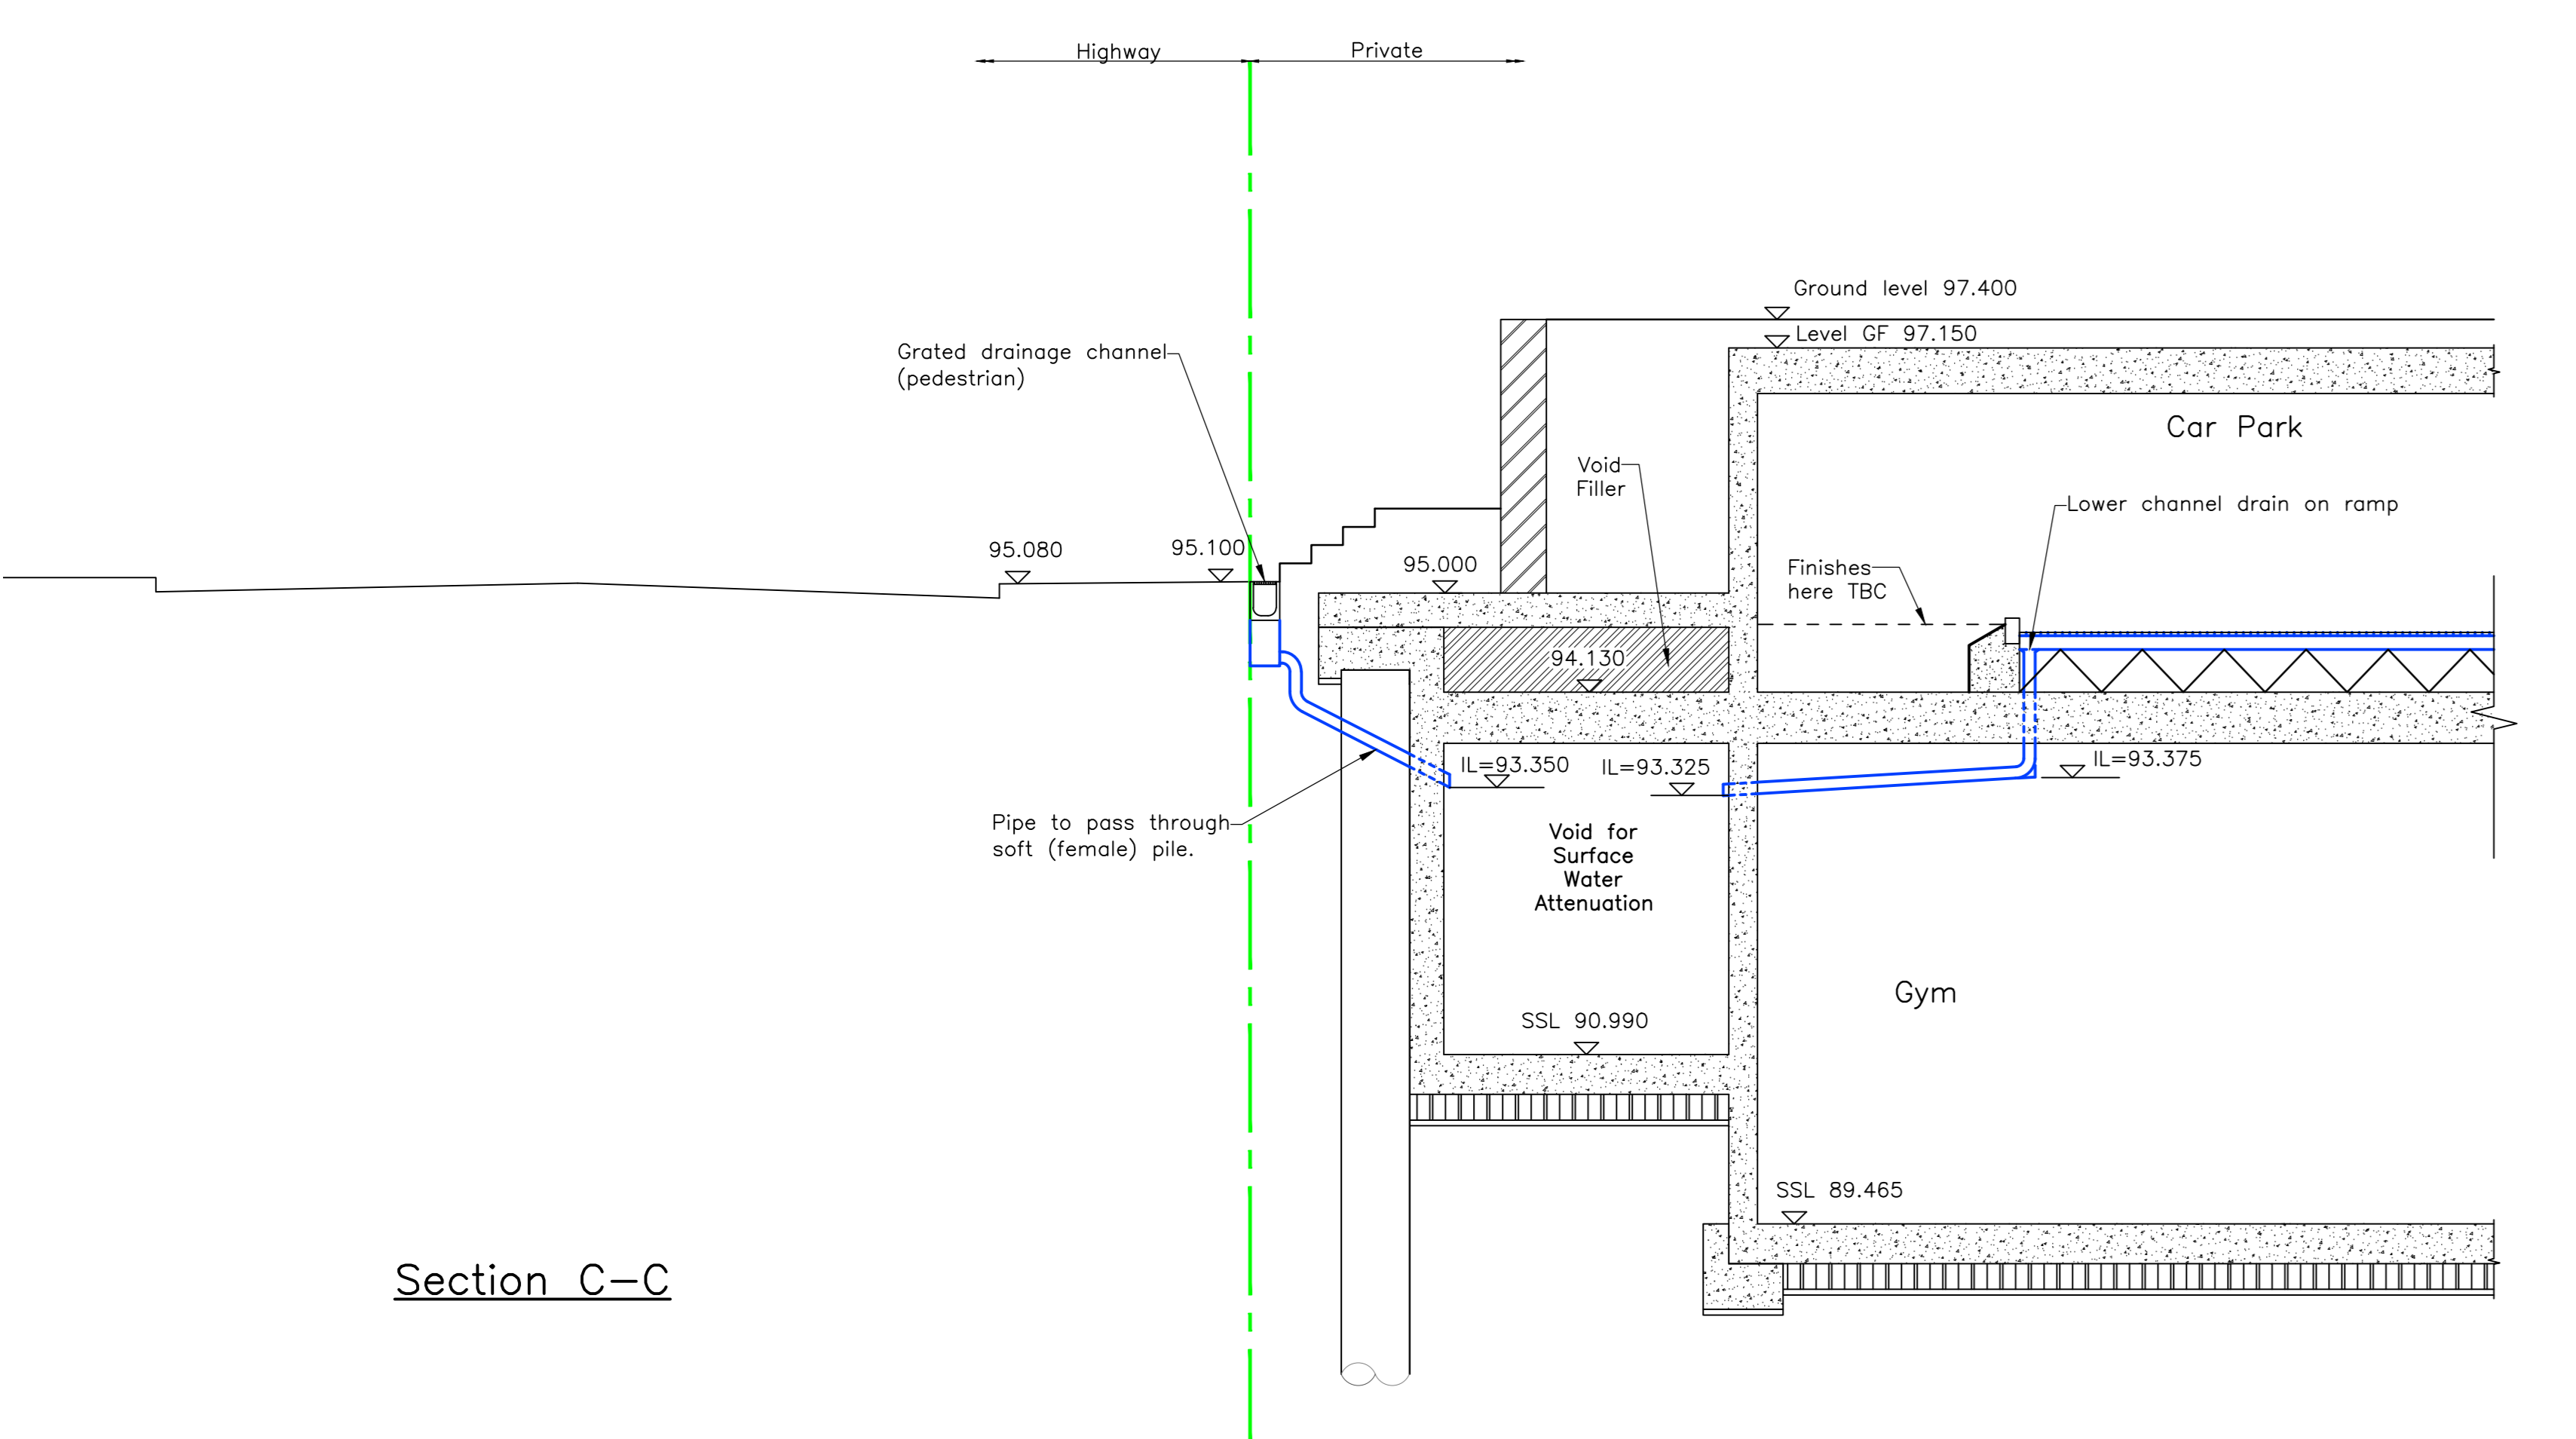


Section C-C

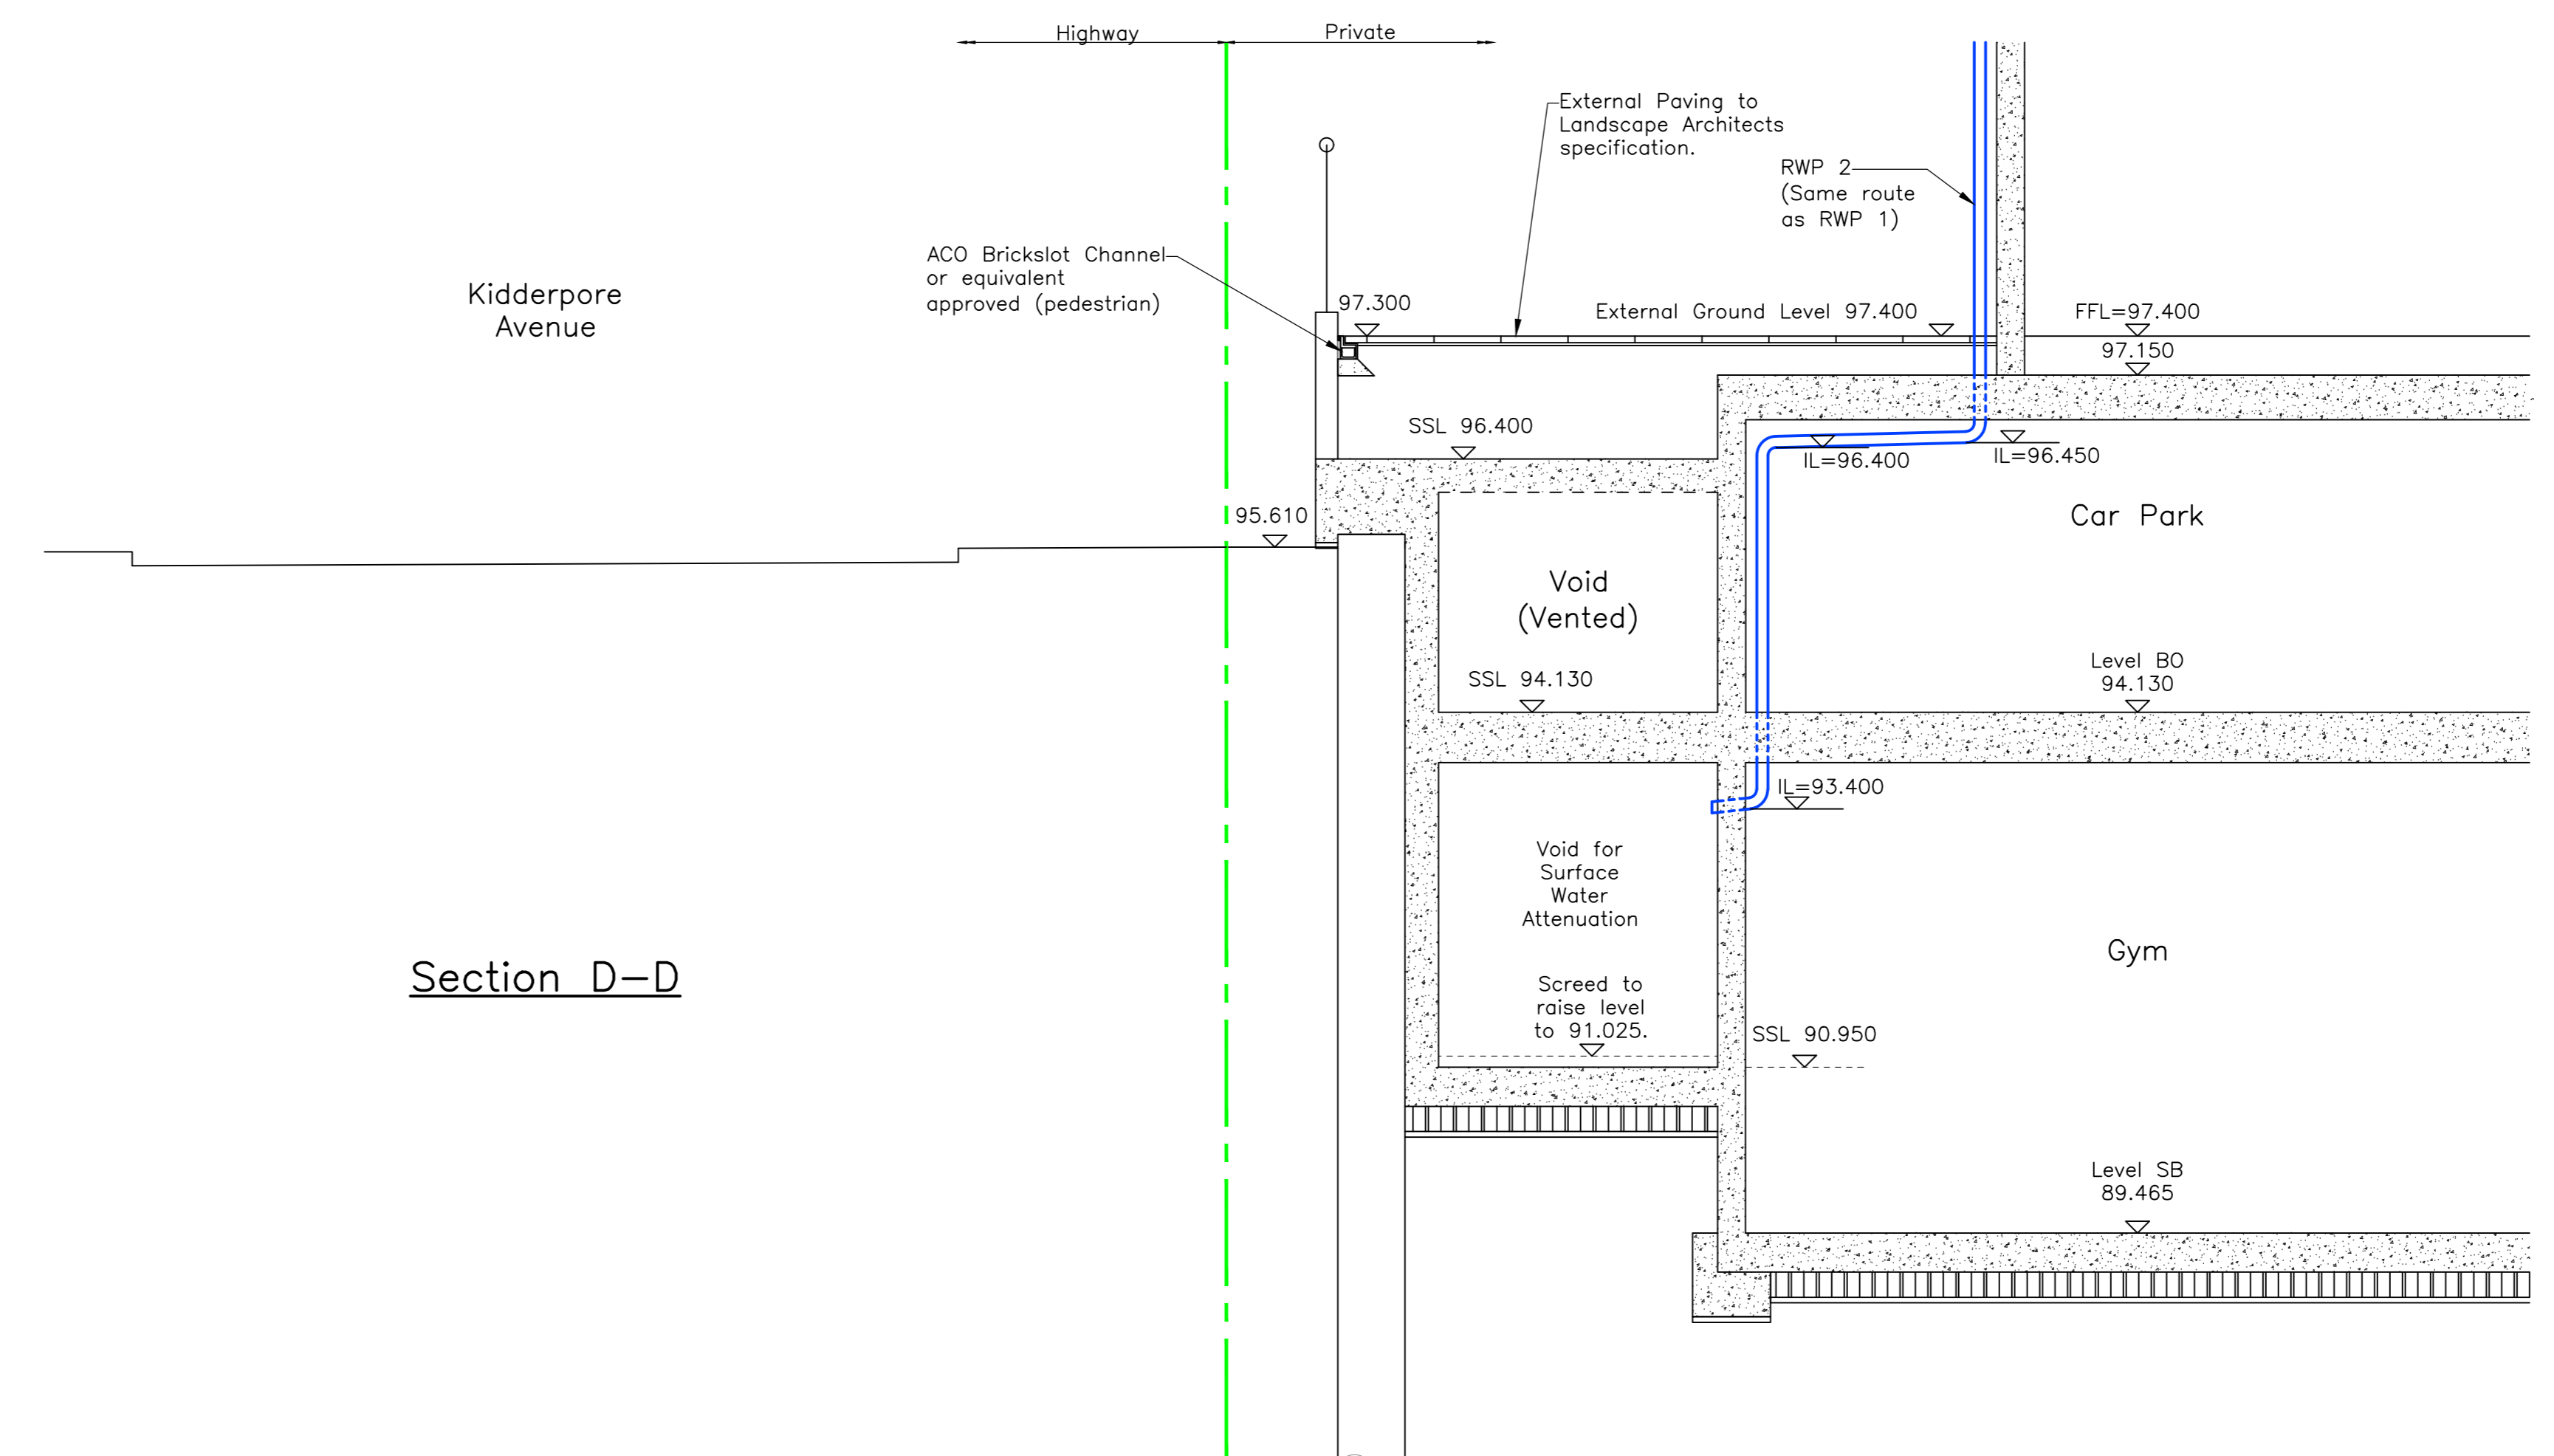

Section D-D

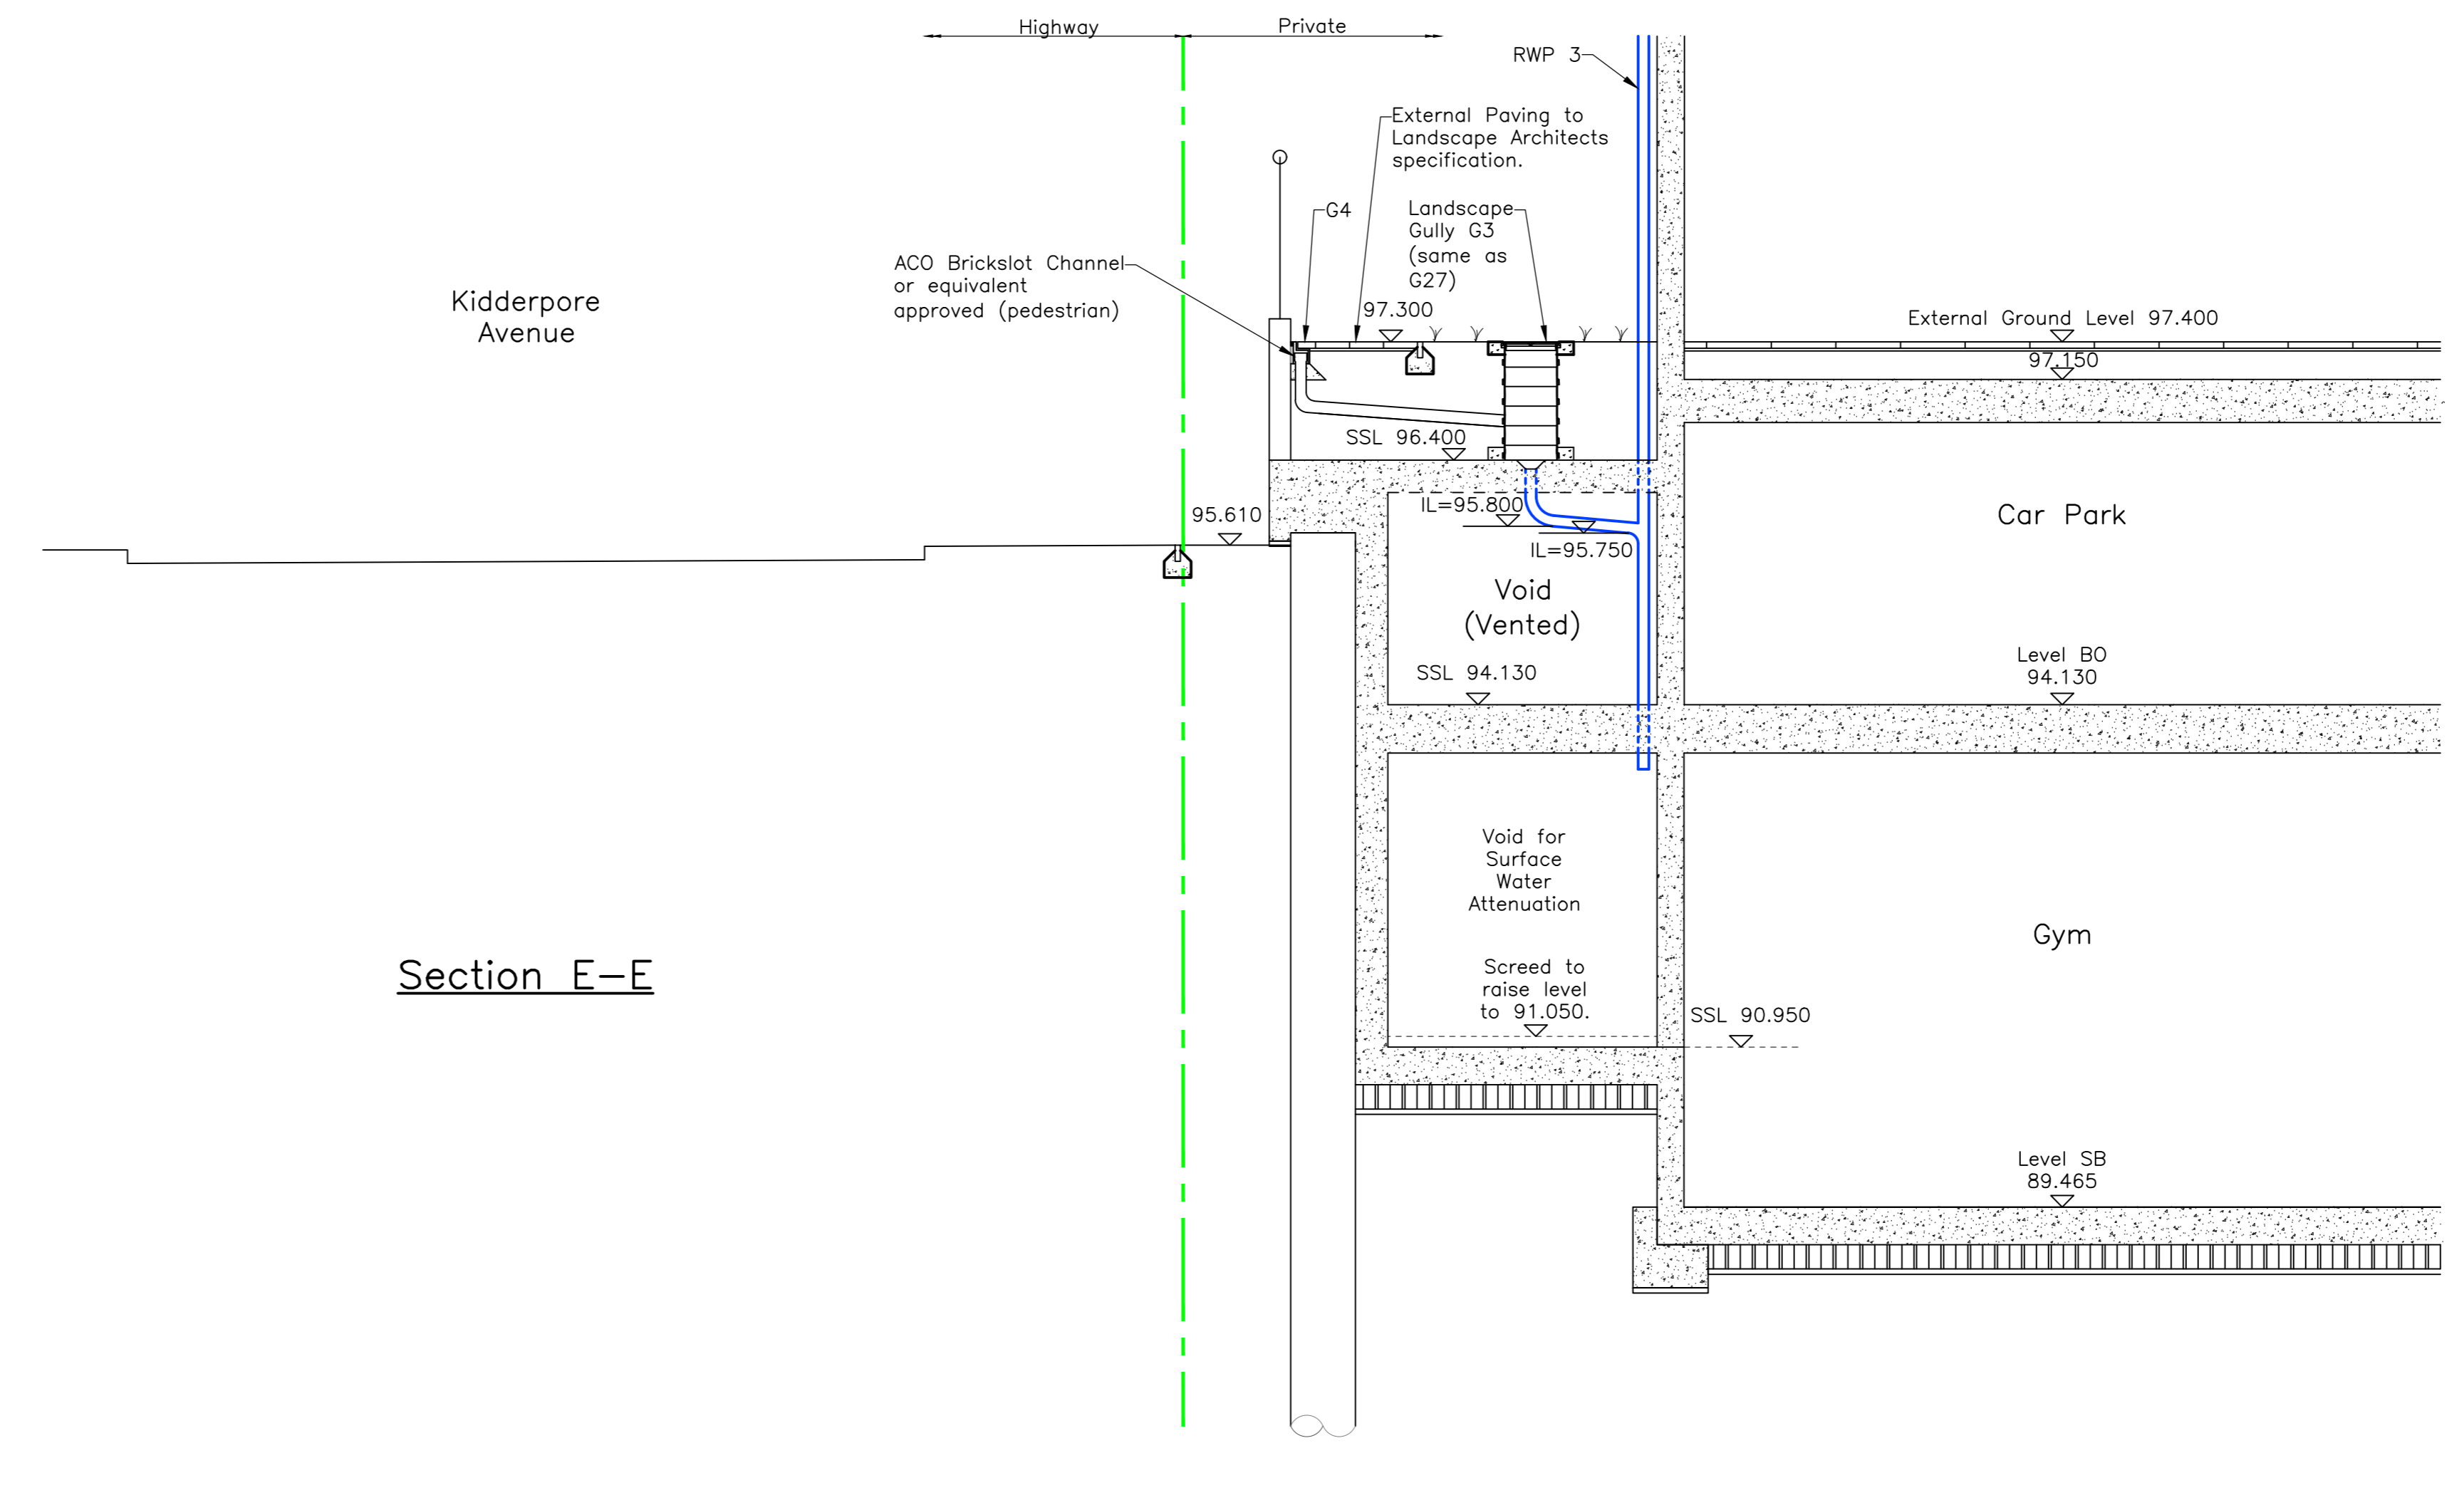

Section E-E

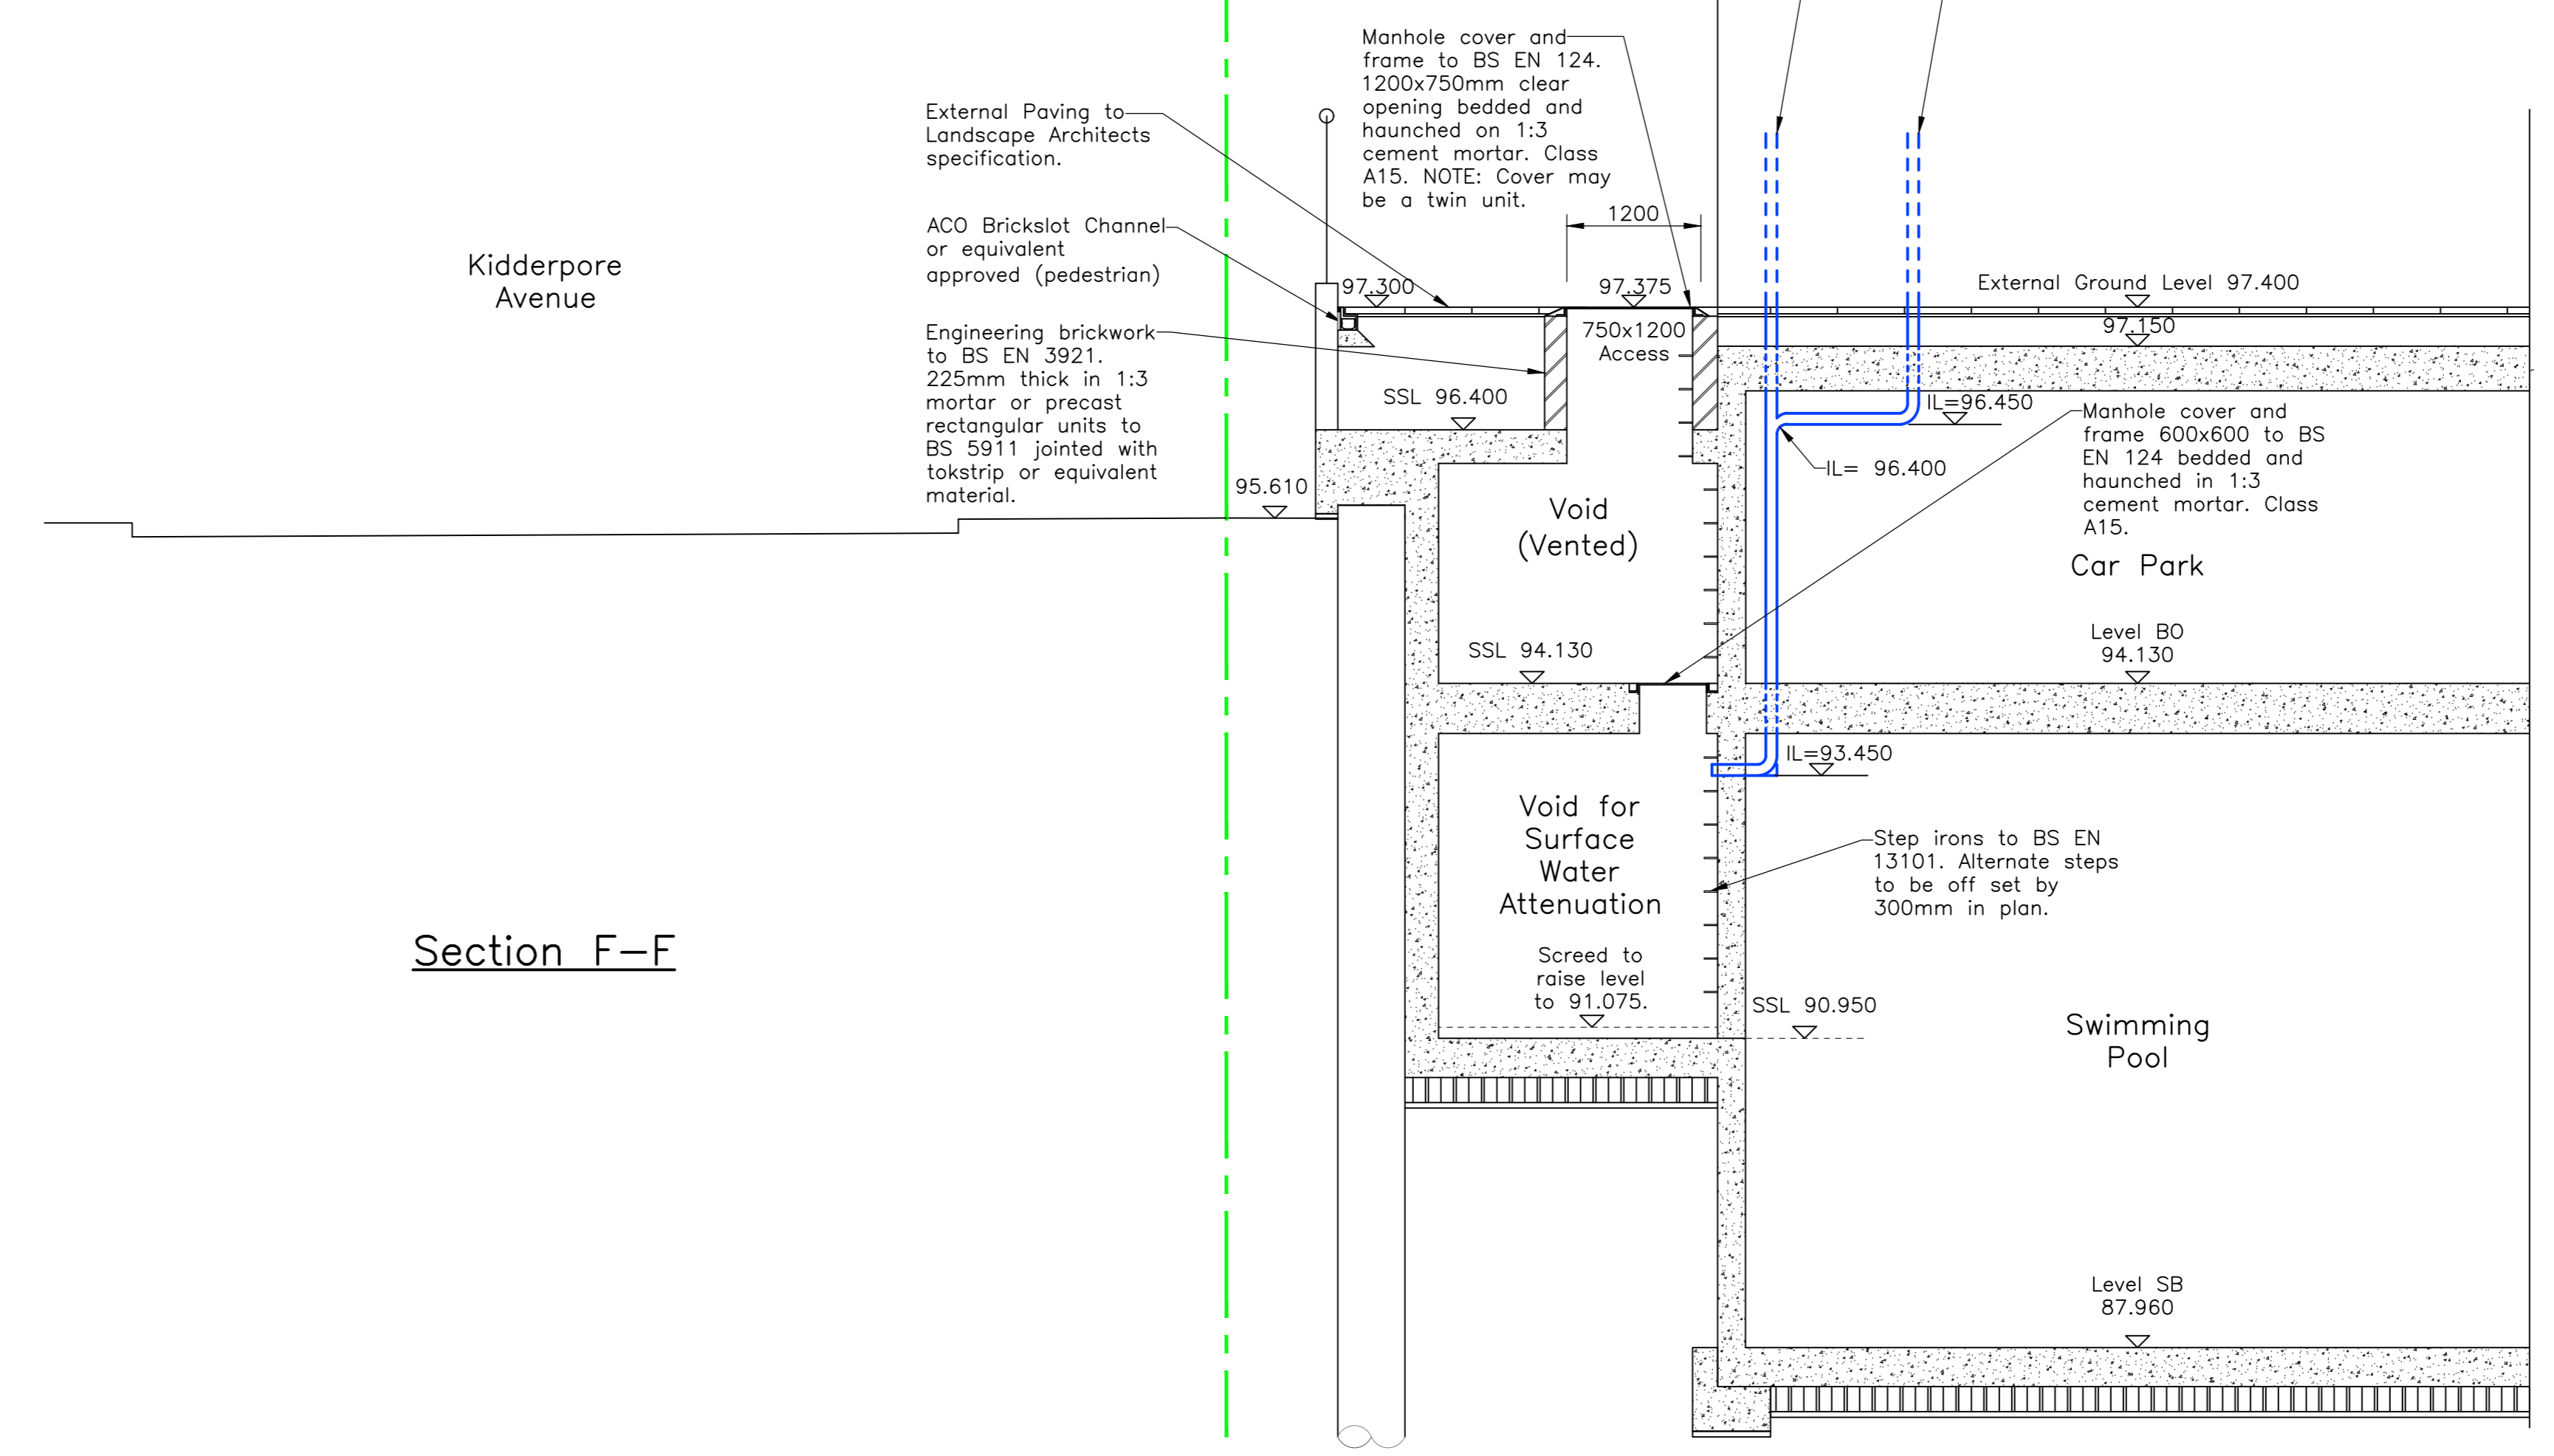

Section F-F

General Notes

- All dimensions are in millimeters unless otherwise stated.
- All buried concrete used in works shall comply with BRE Special Digest S01 for the following aggressive conditions in the ground:
 - Design sulphate class DS-2.
 - Aggressive chemical environment class AC-1a.
 - Design concrete class DC-1.
 - No additional protective measures (AFMs).
- All levels are in metres above ordnance datum.
- All hardstanding construction to be founded in sub-soil free of any organic material.

AS BUILT DRAWING
This drawing has been provided as an 'As Built' drawing based on information provided by MOUNT ANVIL.

AB1 19/09/18	Issued 'As Built'	JW SFK
C2 01.08.17	Sections A-A & B-B updated to show new ramp levels. Section C-C updated to show lower channel drain and outfall.	JSR SFK
C1 07.04.17	Final issue under new drawing number. Manhole cover and sump amended in Section A-A.	JSR SFK

REV	DATE	DESCRIPTION	BY	CHK'D
-----	------	-------------	----	-------



TITLE: Drainage Sections
Queen Mother Hall – South

PROJECT:
Project No:11581
Kidderpore Avenue

SCALE: 1:500@40 DATE: Oct 2016 DRAWN: JSR CHK'D: SFK
DRG NO. 9100-DRG-34QM-SE655 AB1

FOR LOCATION OF SECTIONS REFER TO DRAWING 9100-DRG-34QM-00656.

