



**General Notes**


1. All dimensions shown are in millimetres.
2. All levels shown are in metres above ordinance datum.

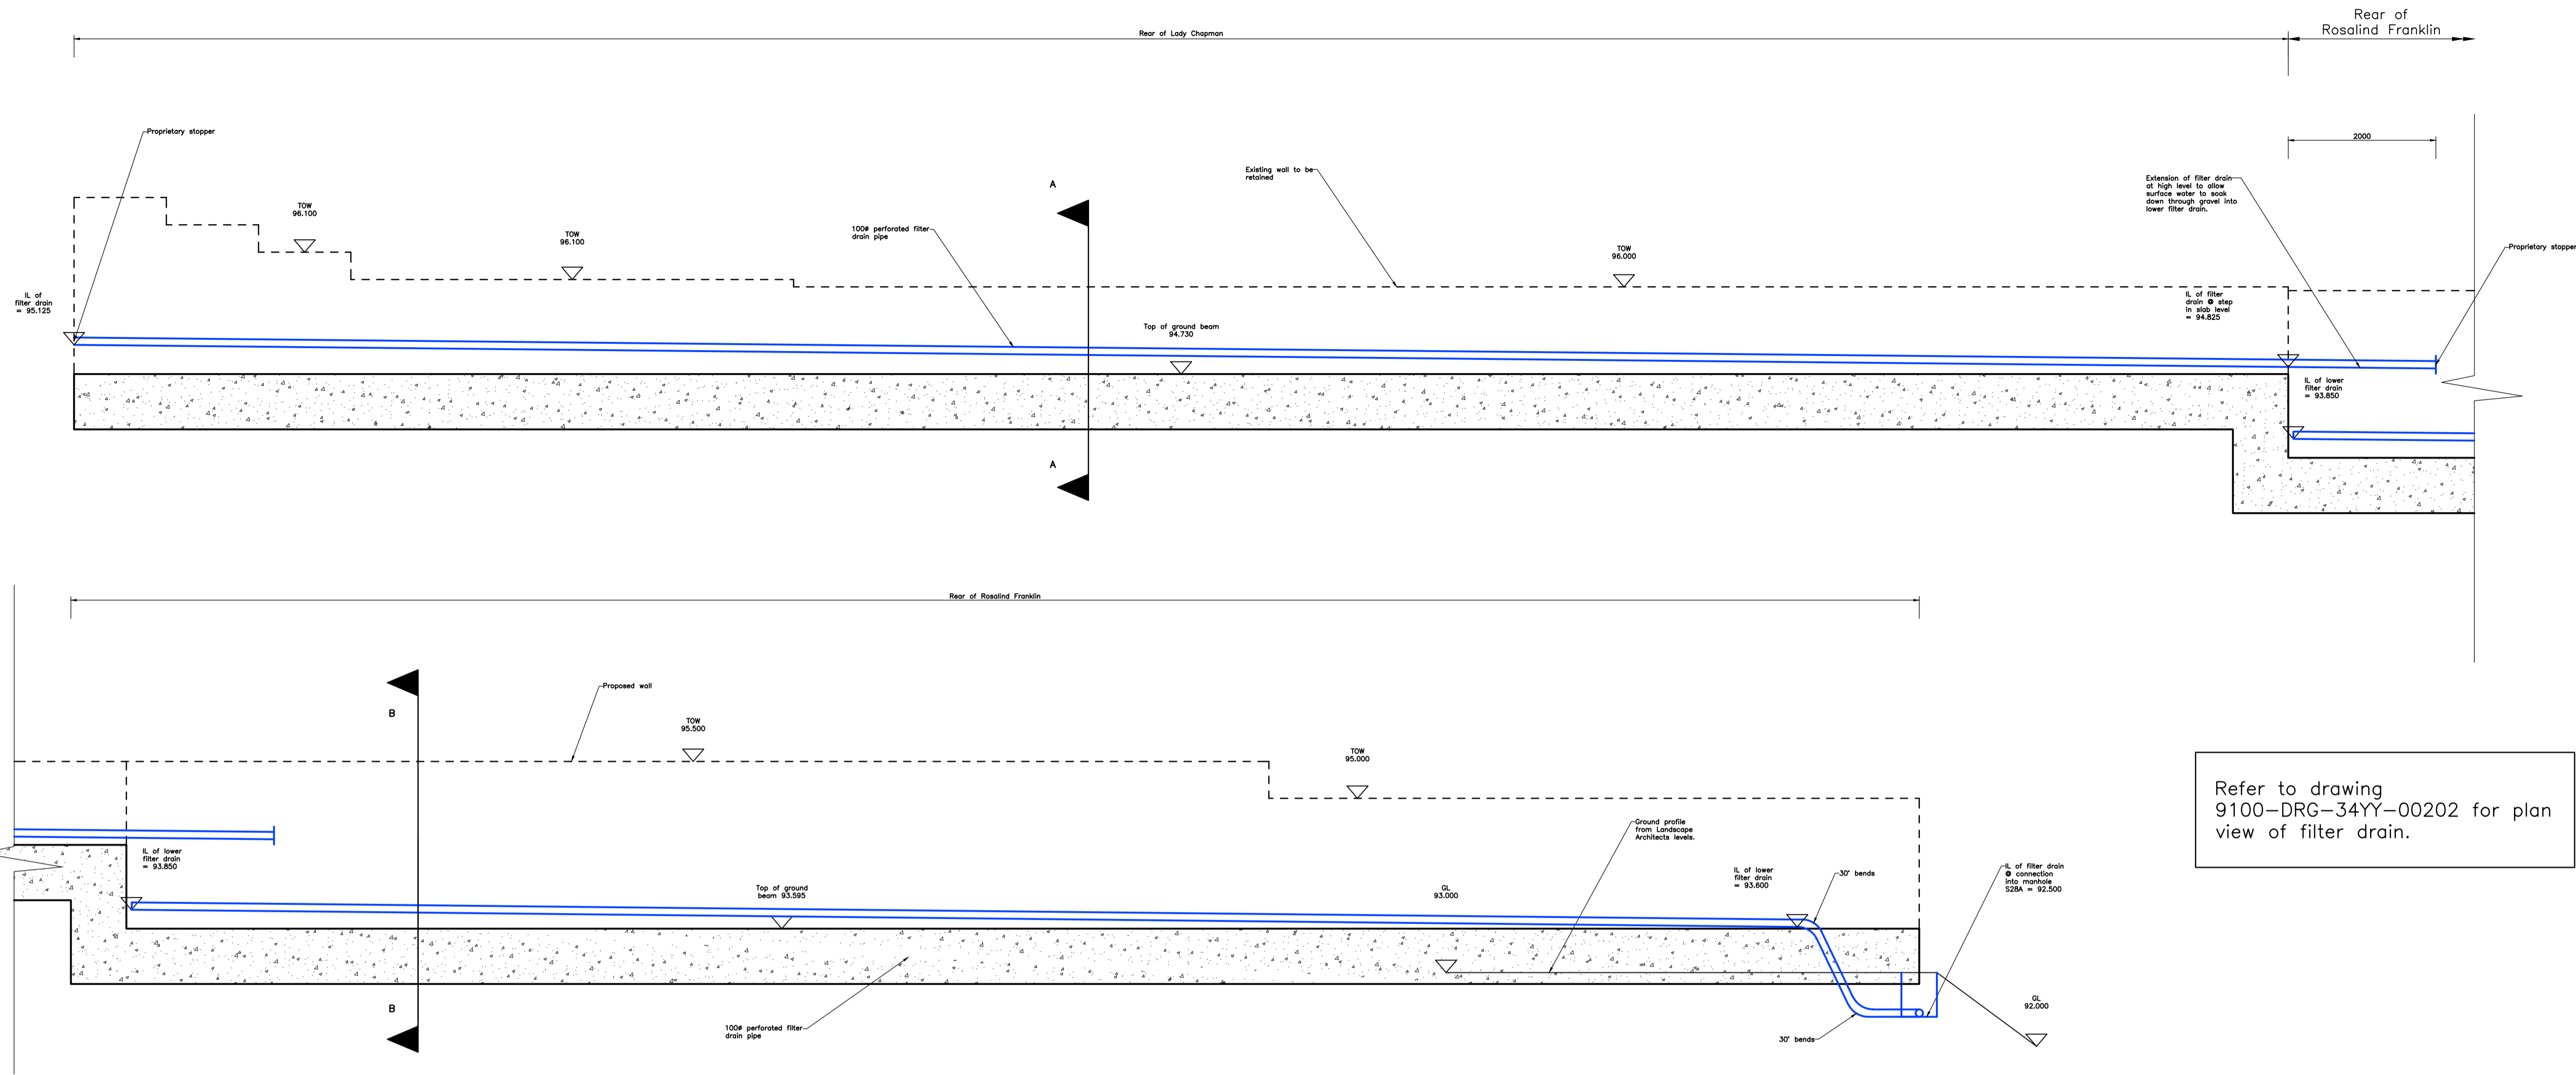

Lady Chapman

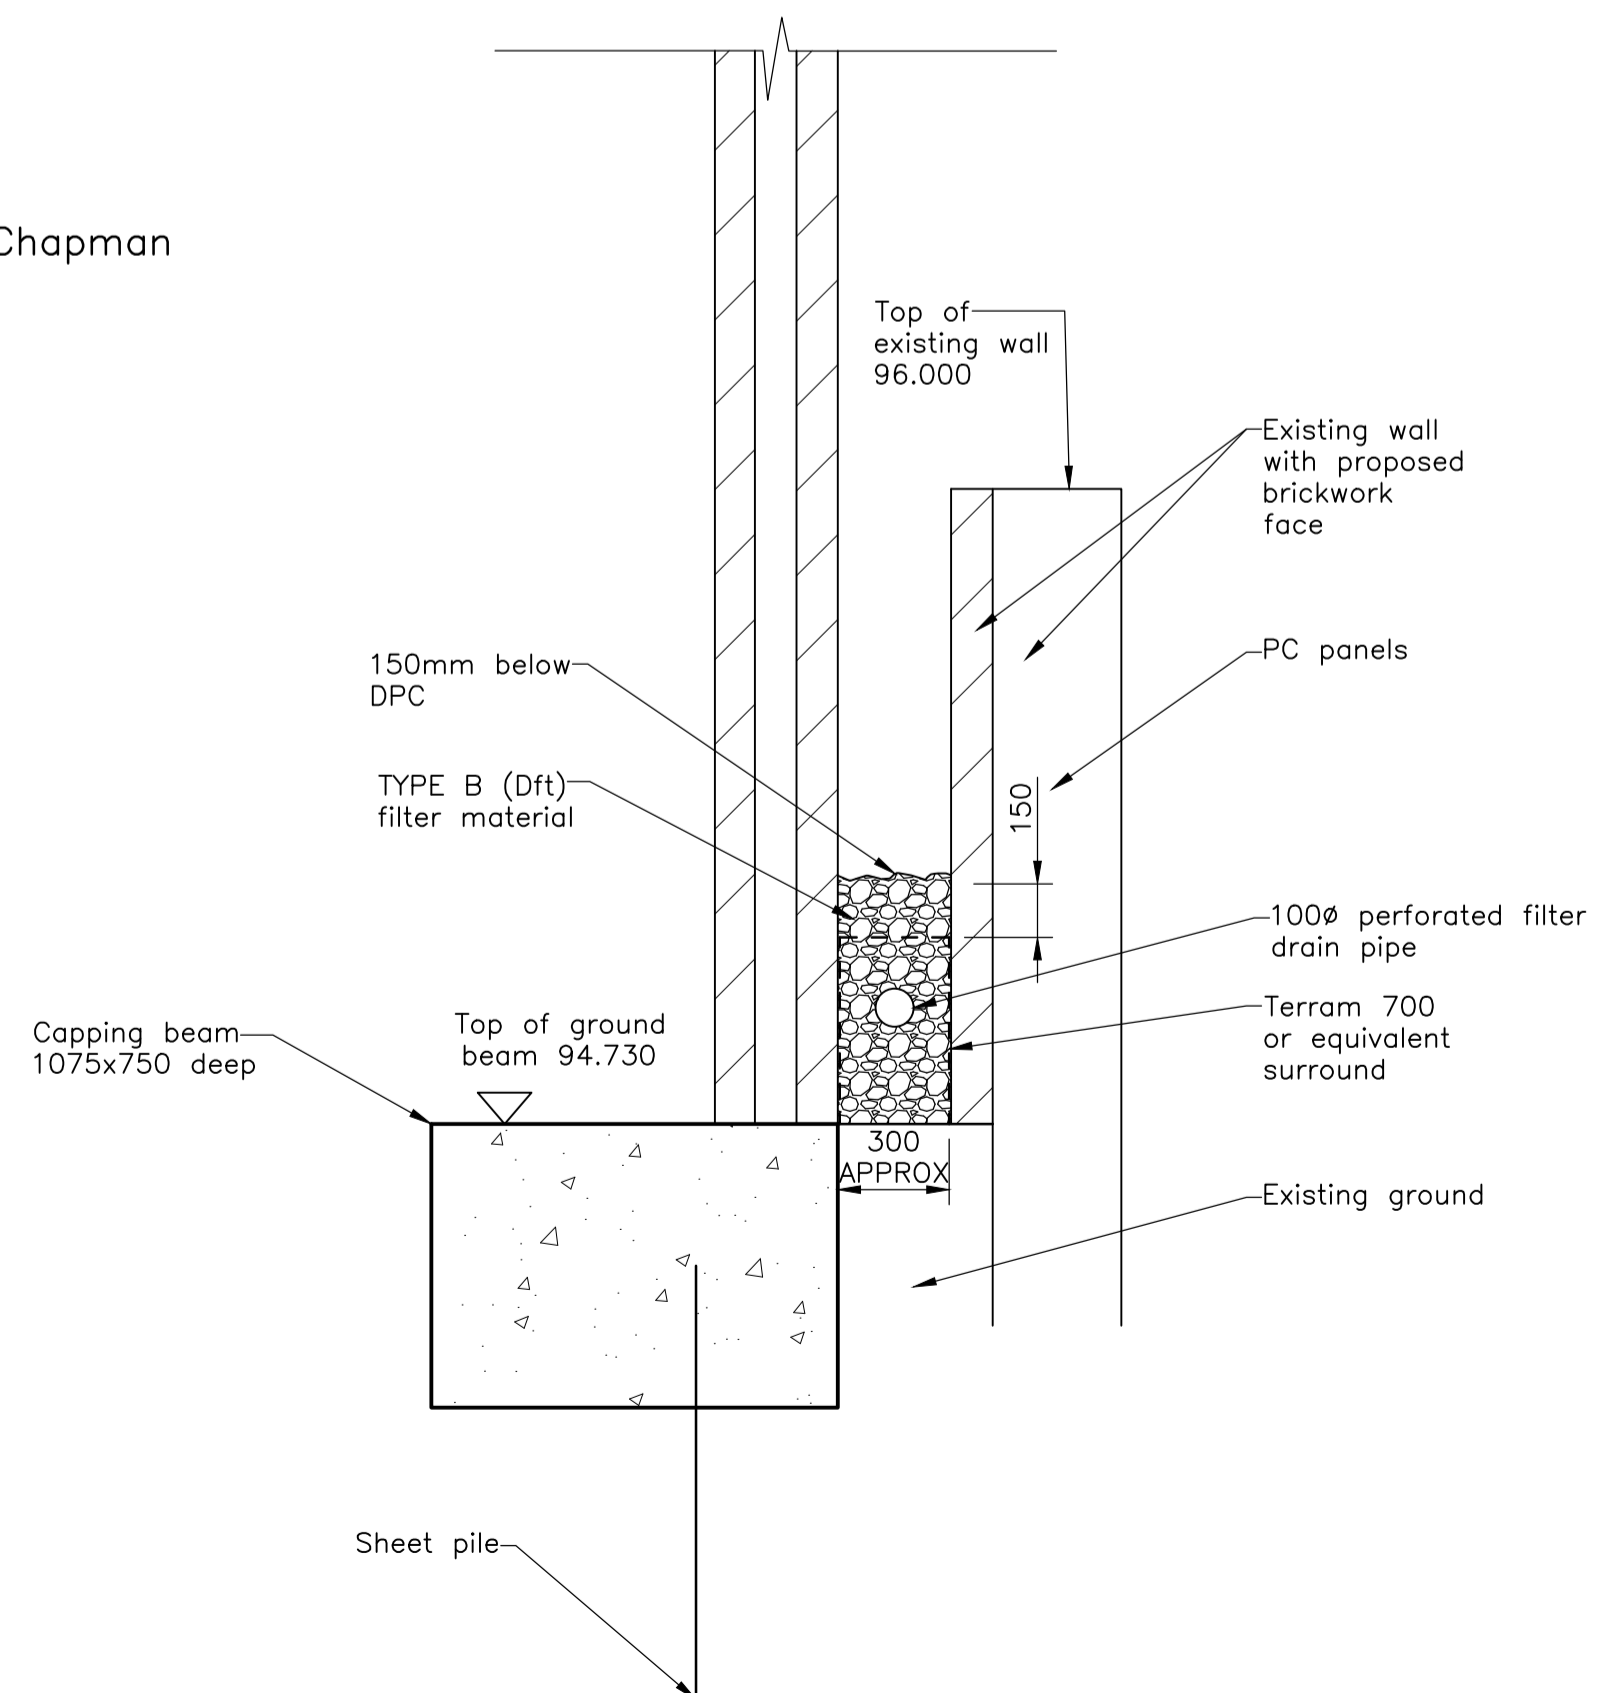

**Section A – A**  
(Scale 1:20)

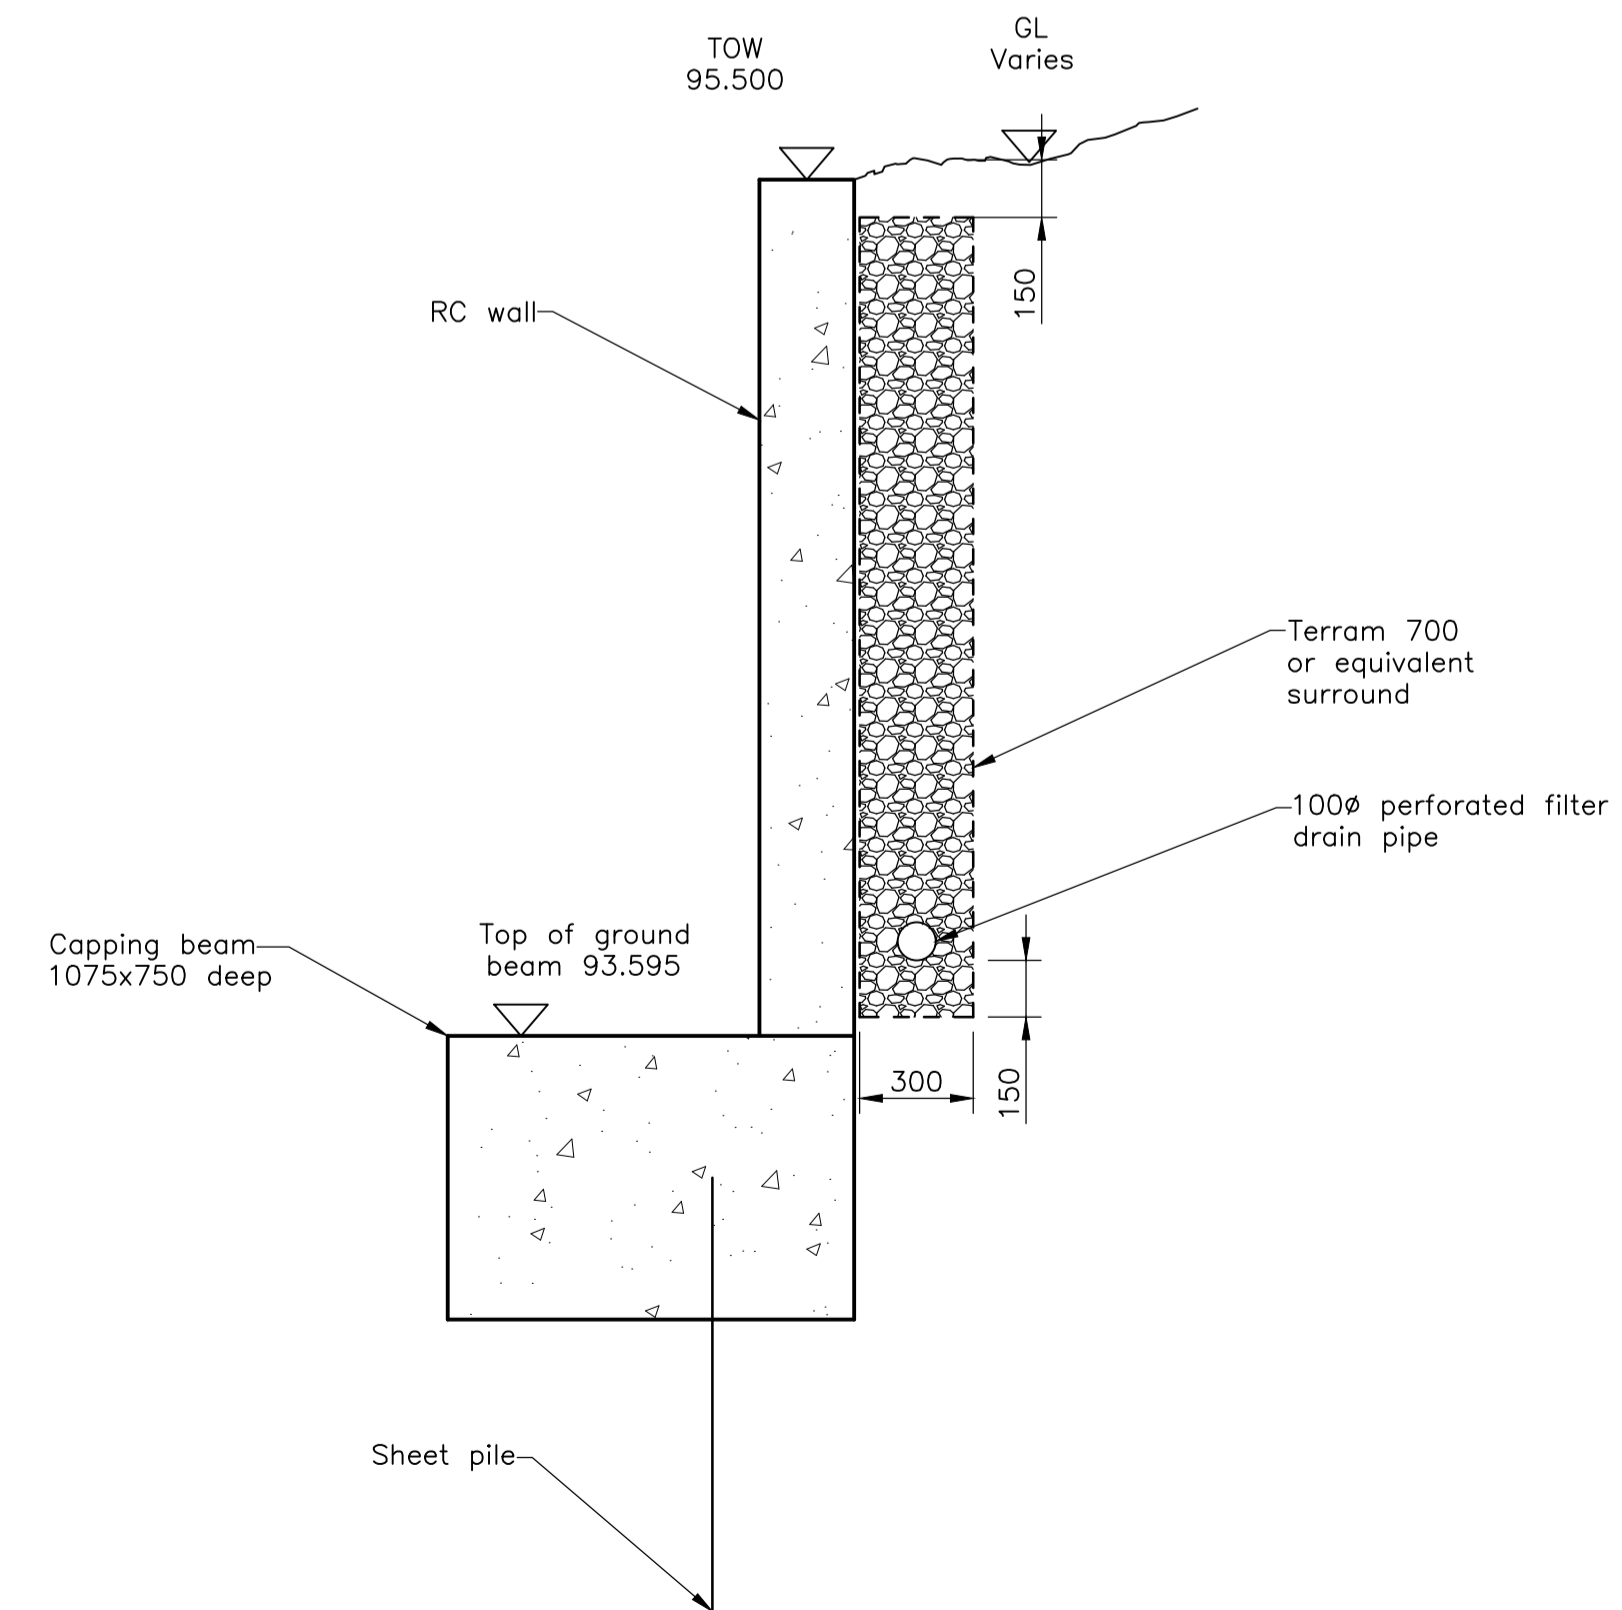

**Section B – B**  
(Scale 1:20)

**AS BUILT DRAWING**  
This drawing has been provided as an 'As Built' drawing based on information provided by MOUNT ANVIL.

AB1 19.09.18 Issued 'As Built', JW SFK  
C1 01.08.17 First Issue, JSR SFK

REV	DATE	DESCRIPTION	BY	CHK'D



TITLE:  
**Filter Drain  
Long Section –  
Rear of LD & RF**

PROJECT:  
**Project No. 11581  
Kidderpore Avenue**

SCALE: 1:50/BA1 DATE: July 2017 DRAWN: JSR CHK'D: SFK  
JOB NO. DRG NO. REV.  
**9100-DRG-34YY-DE354 AB1**

**Tully De'Ath** consultants  
Engineering at its Best

T: 01342 828 000  
E: info@tullydeath.com  
W: www.tullydeath.com