






DELTA BRAVO GROUP LTD NOTES:



Proposed plans & elevations have been prepared on the basis of drawings provided by Survey Solutions to Delta Bravo Ltd.
 Delta Bravo Ltd accept no liability for the accuracy or completeness of the original drawings. "As-built" unit must be checked against the drawings prior to any works.
 Delta Bravo Group Ltd copyright. This drawing shall not be reproduced without express written permission from DBG.
 Delta Bravo Group accept no responsibility or liability for drawing alterations carried out by others and have not checked such alterations.
 This drawing shall not be scaled to ascertain any dimensions.
 Asbestos survey required prior to commencement.
 Contractor/Structural Engineer to confirm load bearing walls.

-  existing walls
-  existing partitions
-  new partitions
-  new FR partitions
-  new insulated dry-lining
-  ceiling height
-  suspended ceiling height
-  existing beam height
-  window cill & head height

GROSS INTERNAL FLOOR AREA
 Ground Floor 66 m² [710.4 ft²]
 Basement 72.5 m² [780ft²]
TOTAL: 138.5 m² [1490.80 ft²]

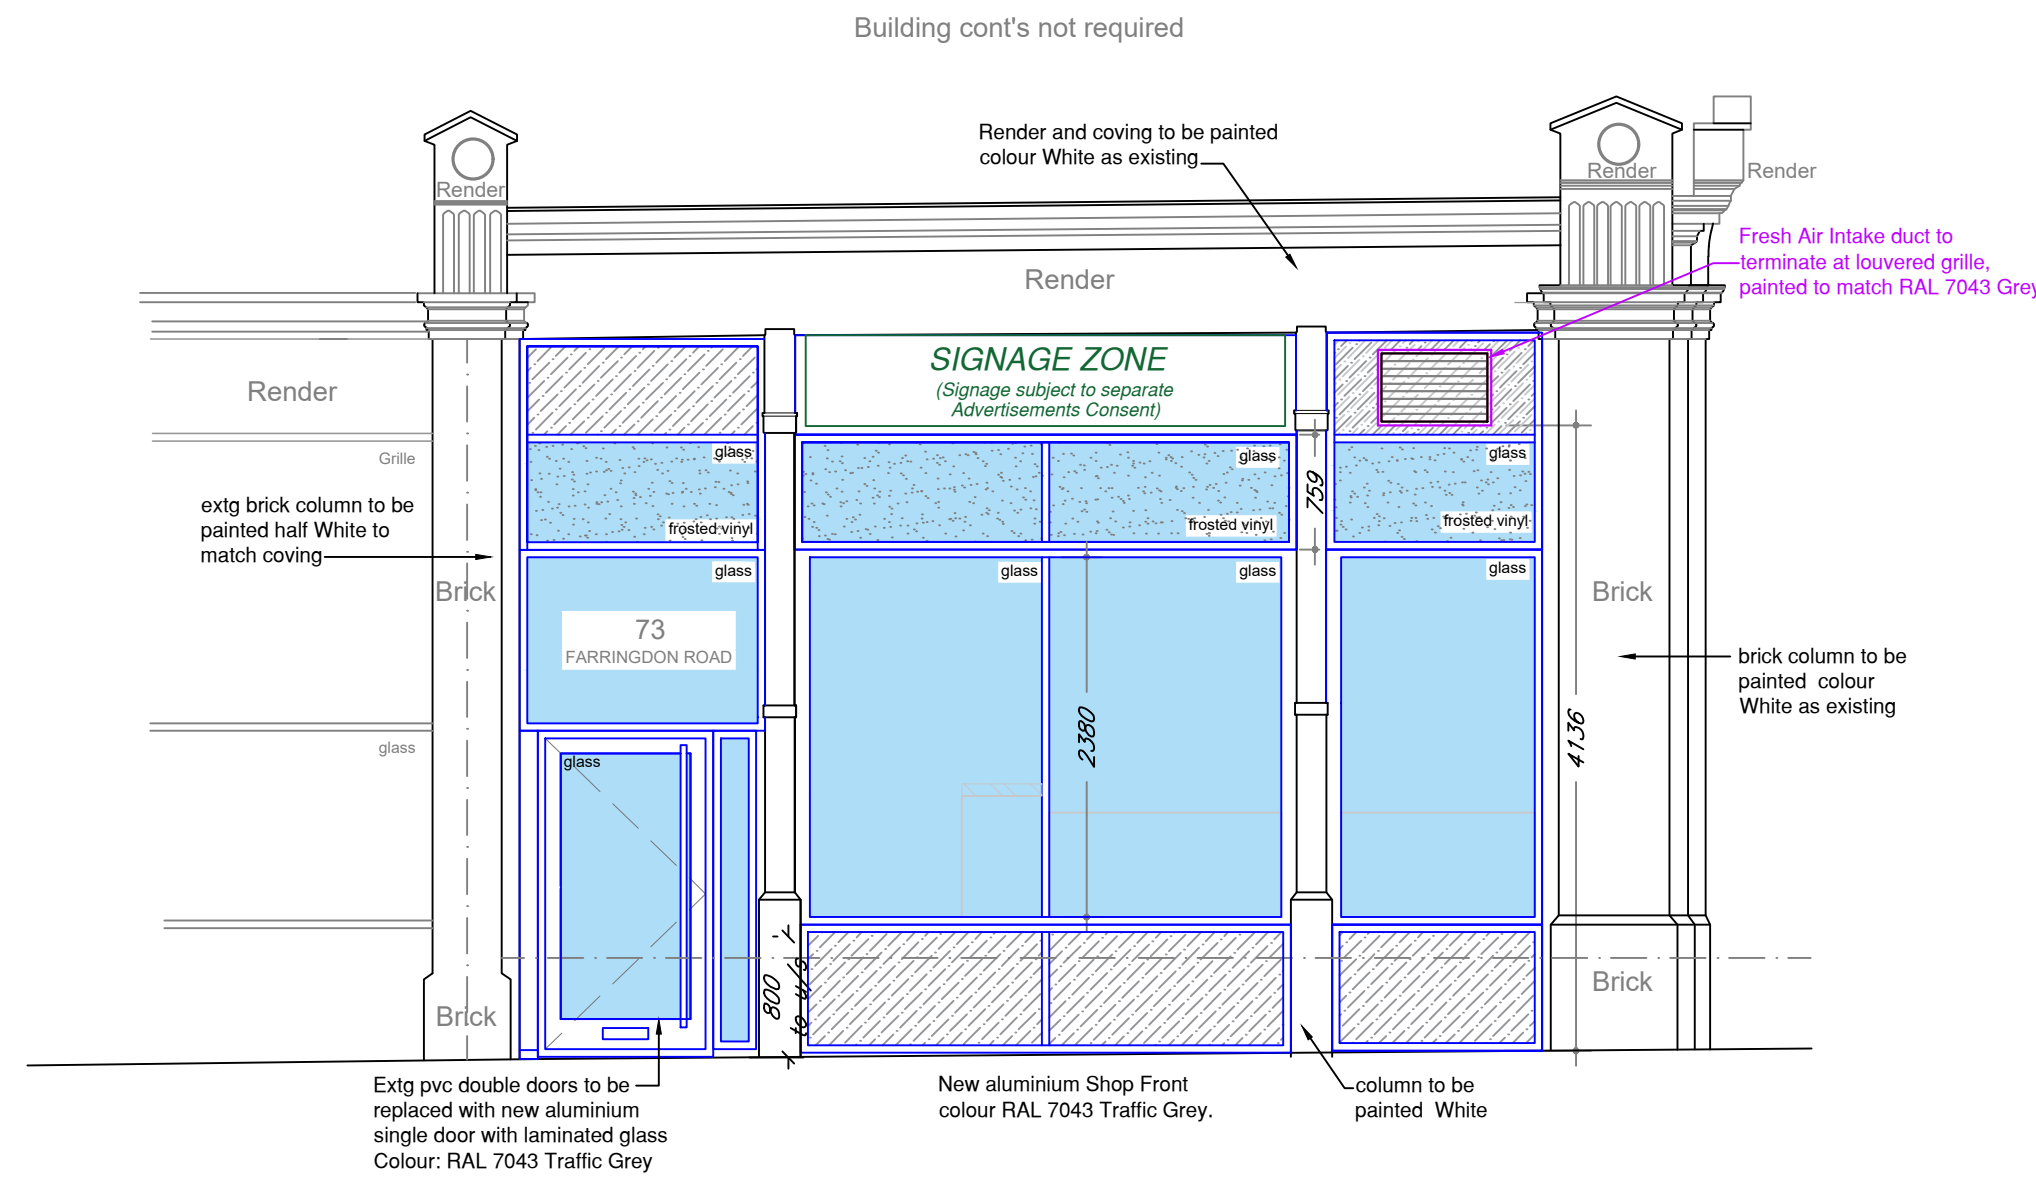

01 FRONT ELEVATION

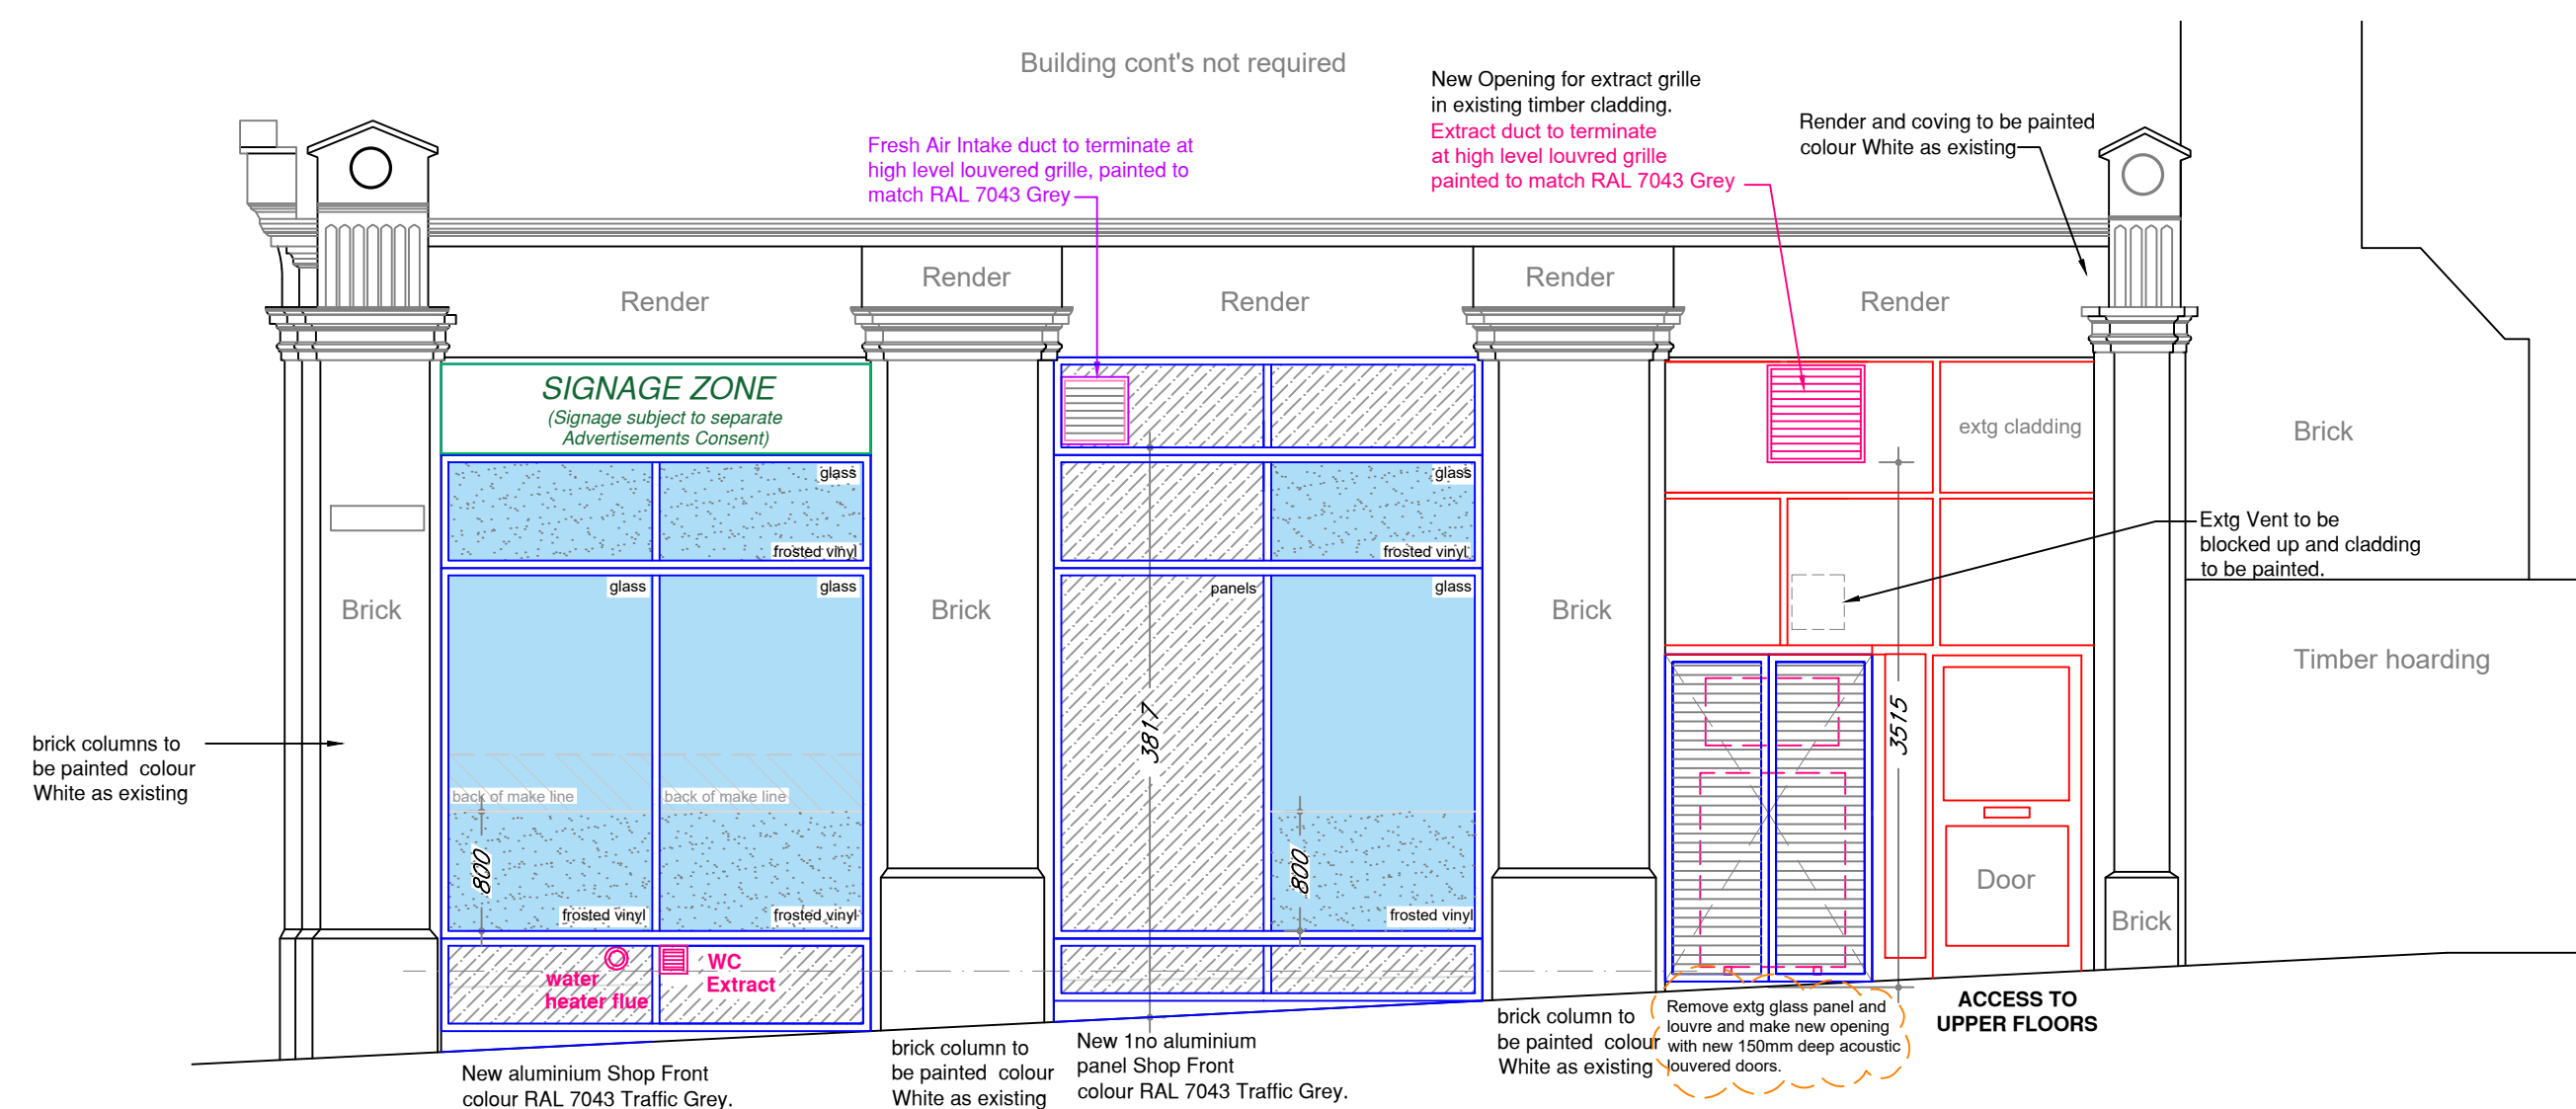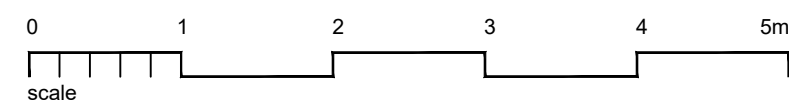

02 SIDE ELEVATION

REV	AMENDMENT	DATE
E	Removed frosted vinyl from Front Elevation main windows as requested by Council.	17.10.19
D	Removed 1no panels in side elevation and reduce frosted vinyl height as req by Council.	16.10.19
C	Revised note in plant room louver doors.	24.06.19
B	Updated Shop Front heights.	06.06.19
A	Revised notes	15.05.19

NOTES:
 CONTRACTORS MUST VERIFY ALL DIMENSIONS ON SITE BEFORE COMMENCEMENT OF ANY WORK OR PREPARING MANUFACTURING DRAWINGS
 ANY DISCREPANCIES ON THIS DRAWING ARE TO BE NOTIFIED TO THE DESIGNER IMMEDIATELY


DELTABRAVO LIMITED
 DESIGN • CONSTRUCTION • SHOPFITTING • PROJECT MANAGEMENT
 Academy House
 London Road
 Camberley
 Surrey
 GU15 3HL

CLIENT THE MSG GROUP		
PROJECT 73 Farringdon Road, London, EC1M 3		
TITLE PROPOSED ELEVATIONS		
SCALE @ A1 1:50	DRAWN BY M W	DATE 15.05.19
DRAWING No DB503- EL06		REVISION E