


KEY:

	TO BE REMOVED
	EXISTING WALLS
	AS BUILT / RETAINED

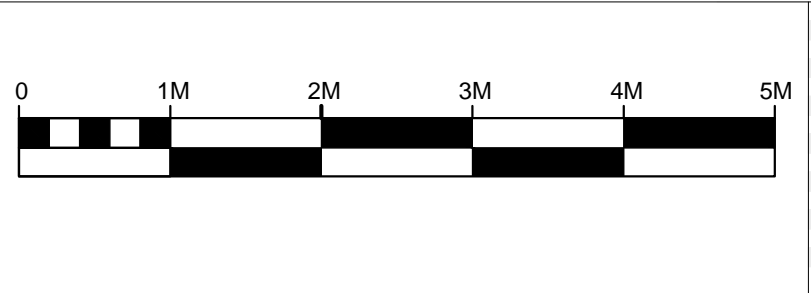

Rev	Date	Description	By

Client
HANLEY LIMITED

scott&twine
ARCHITECTS & INTERIOR DESIGNERS
The Old Power Station, Mortlake High Street
London SW14 8SN
T +44 (0) 20 3355 9699
www.scott-twine.co.uk

Issue
PLANNING
Preliminary / Planning / LBC / Tender / Construction / As Built

Project
Beechwood, London N6
Conversion of Former Squash Court

Title Ground Floor Plan As Built	
Date Sep 2019	Scale 1:50@A3
Drawn By GT	Checked By VS
Drawing Number 2230-06/10/01	Revision -