



WEST ELEVATION

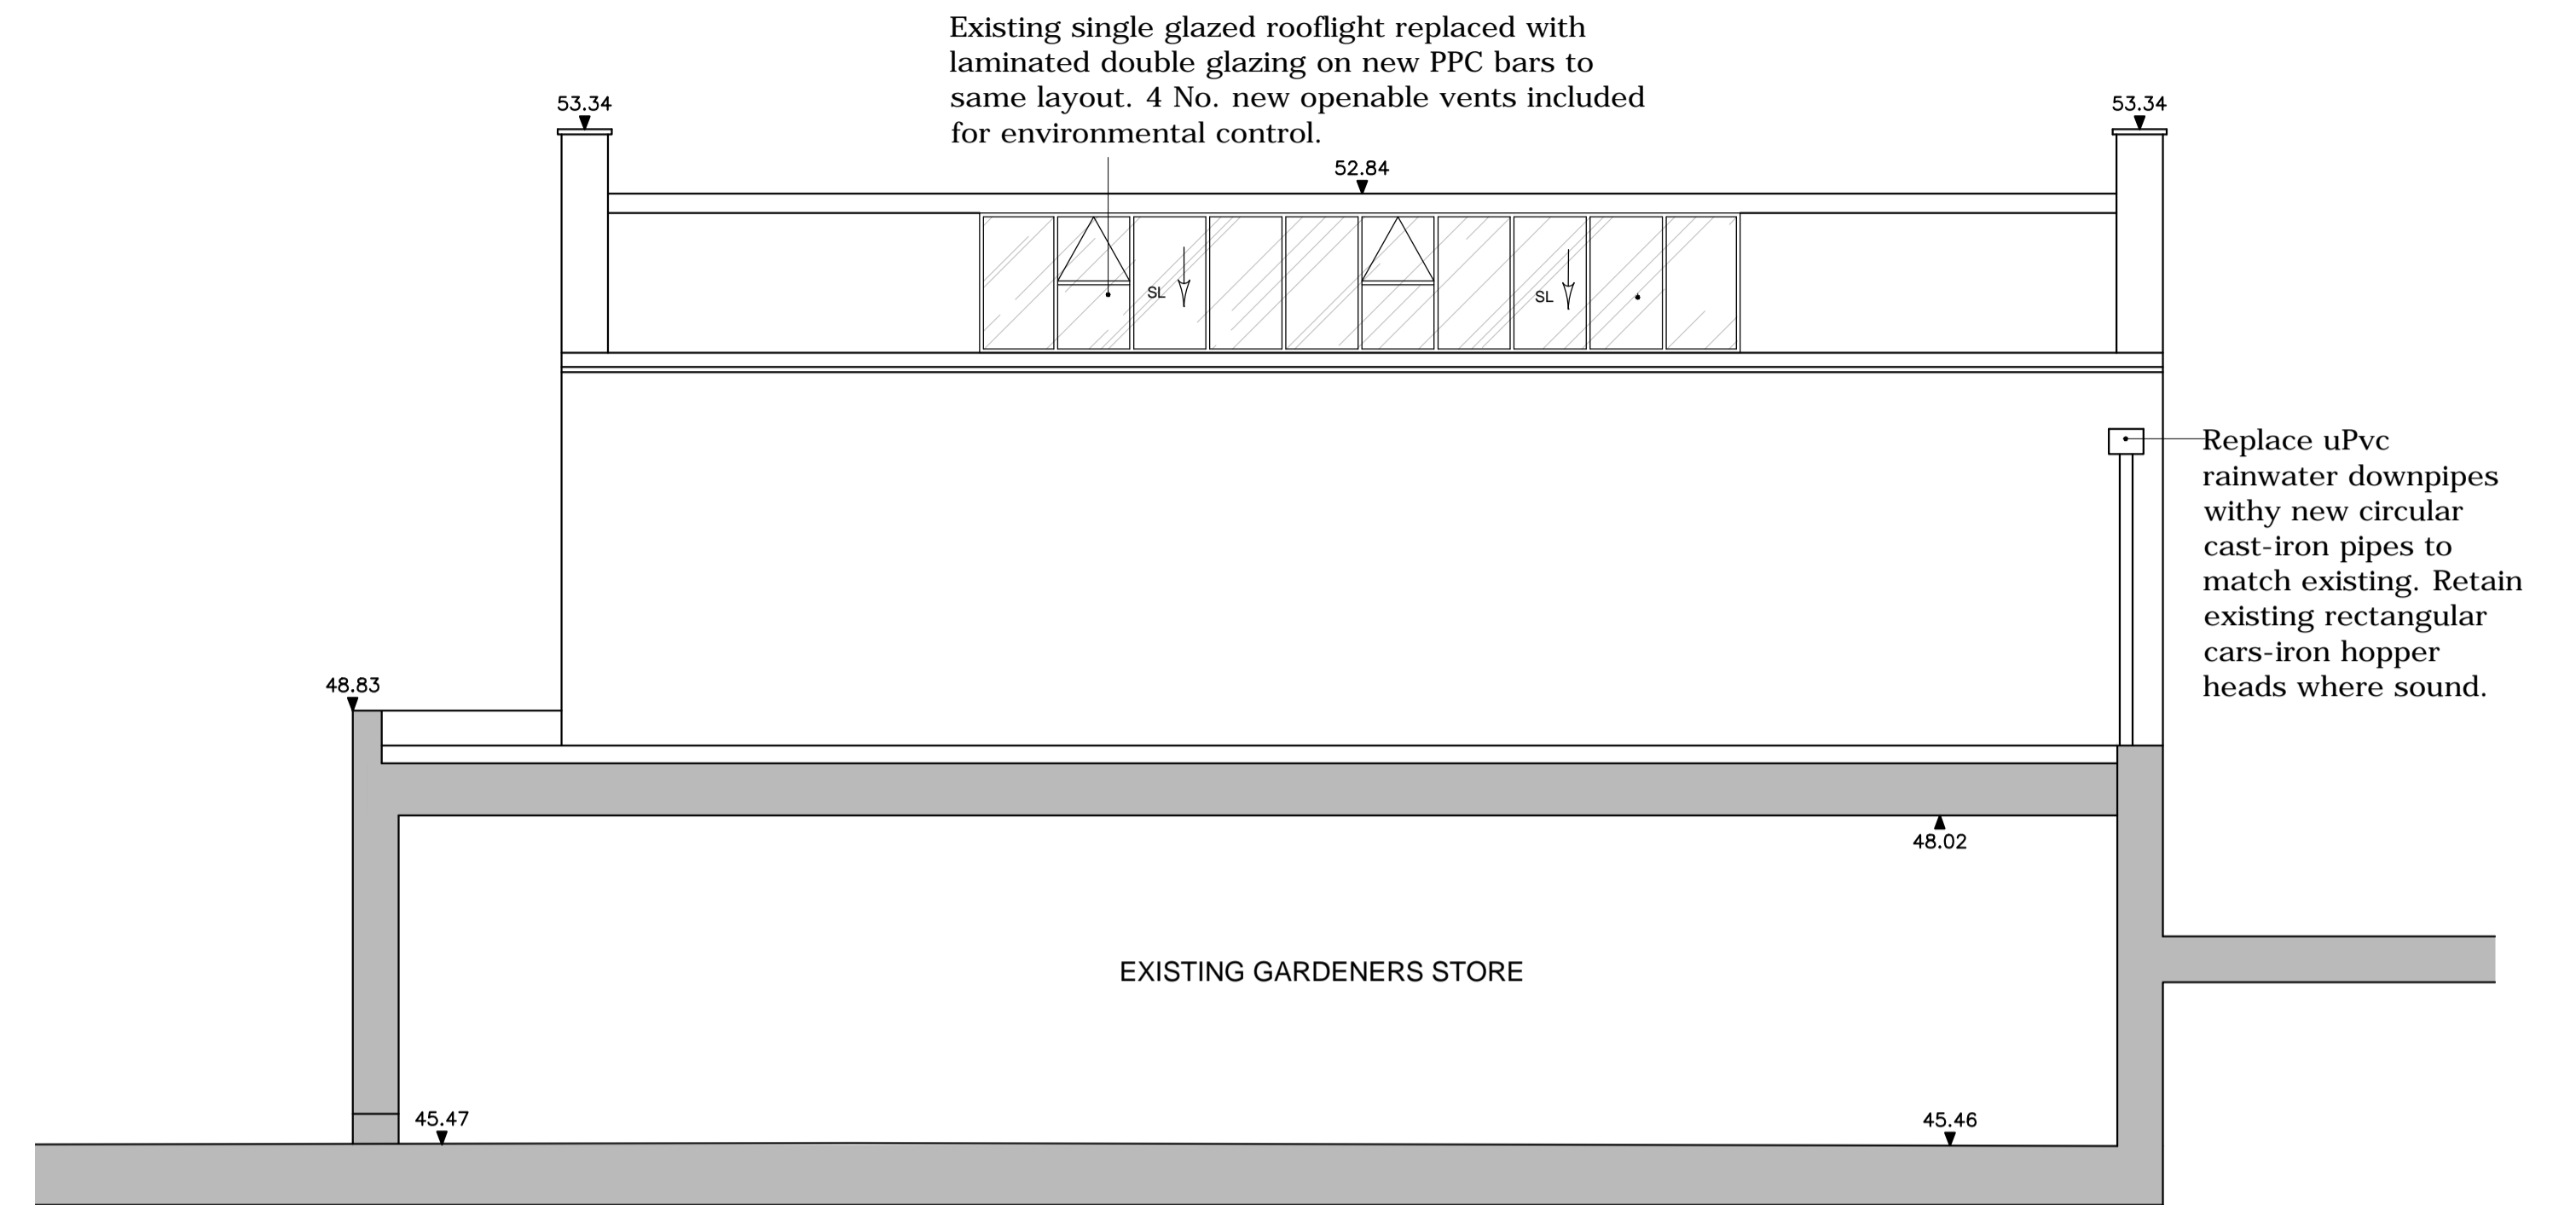


SOUTH ELEVATION

Brickwork to walls generally repointed, lead lined gutters replaced with new lead and Westmoreland slate roof recovered using existing slates, with replacement lead abutment flashings and ridge capping.

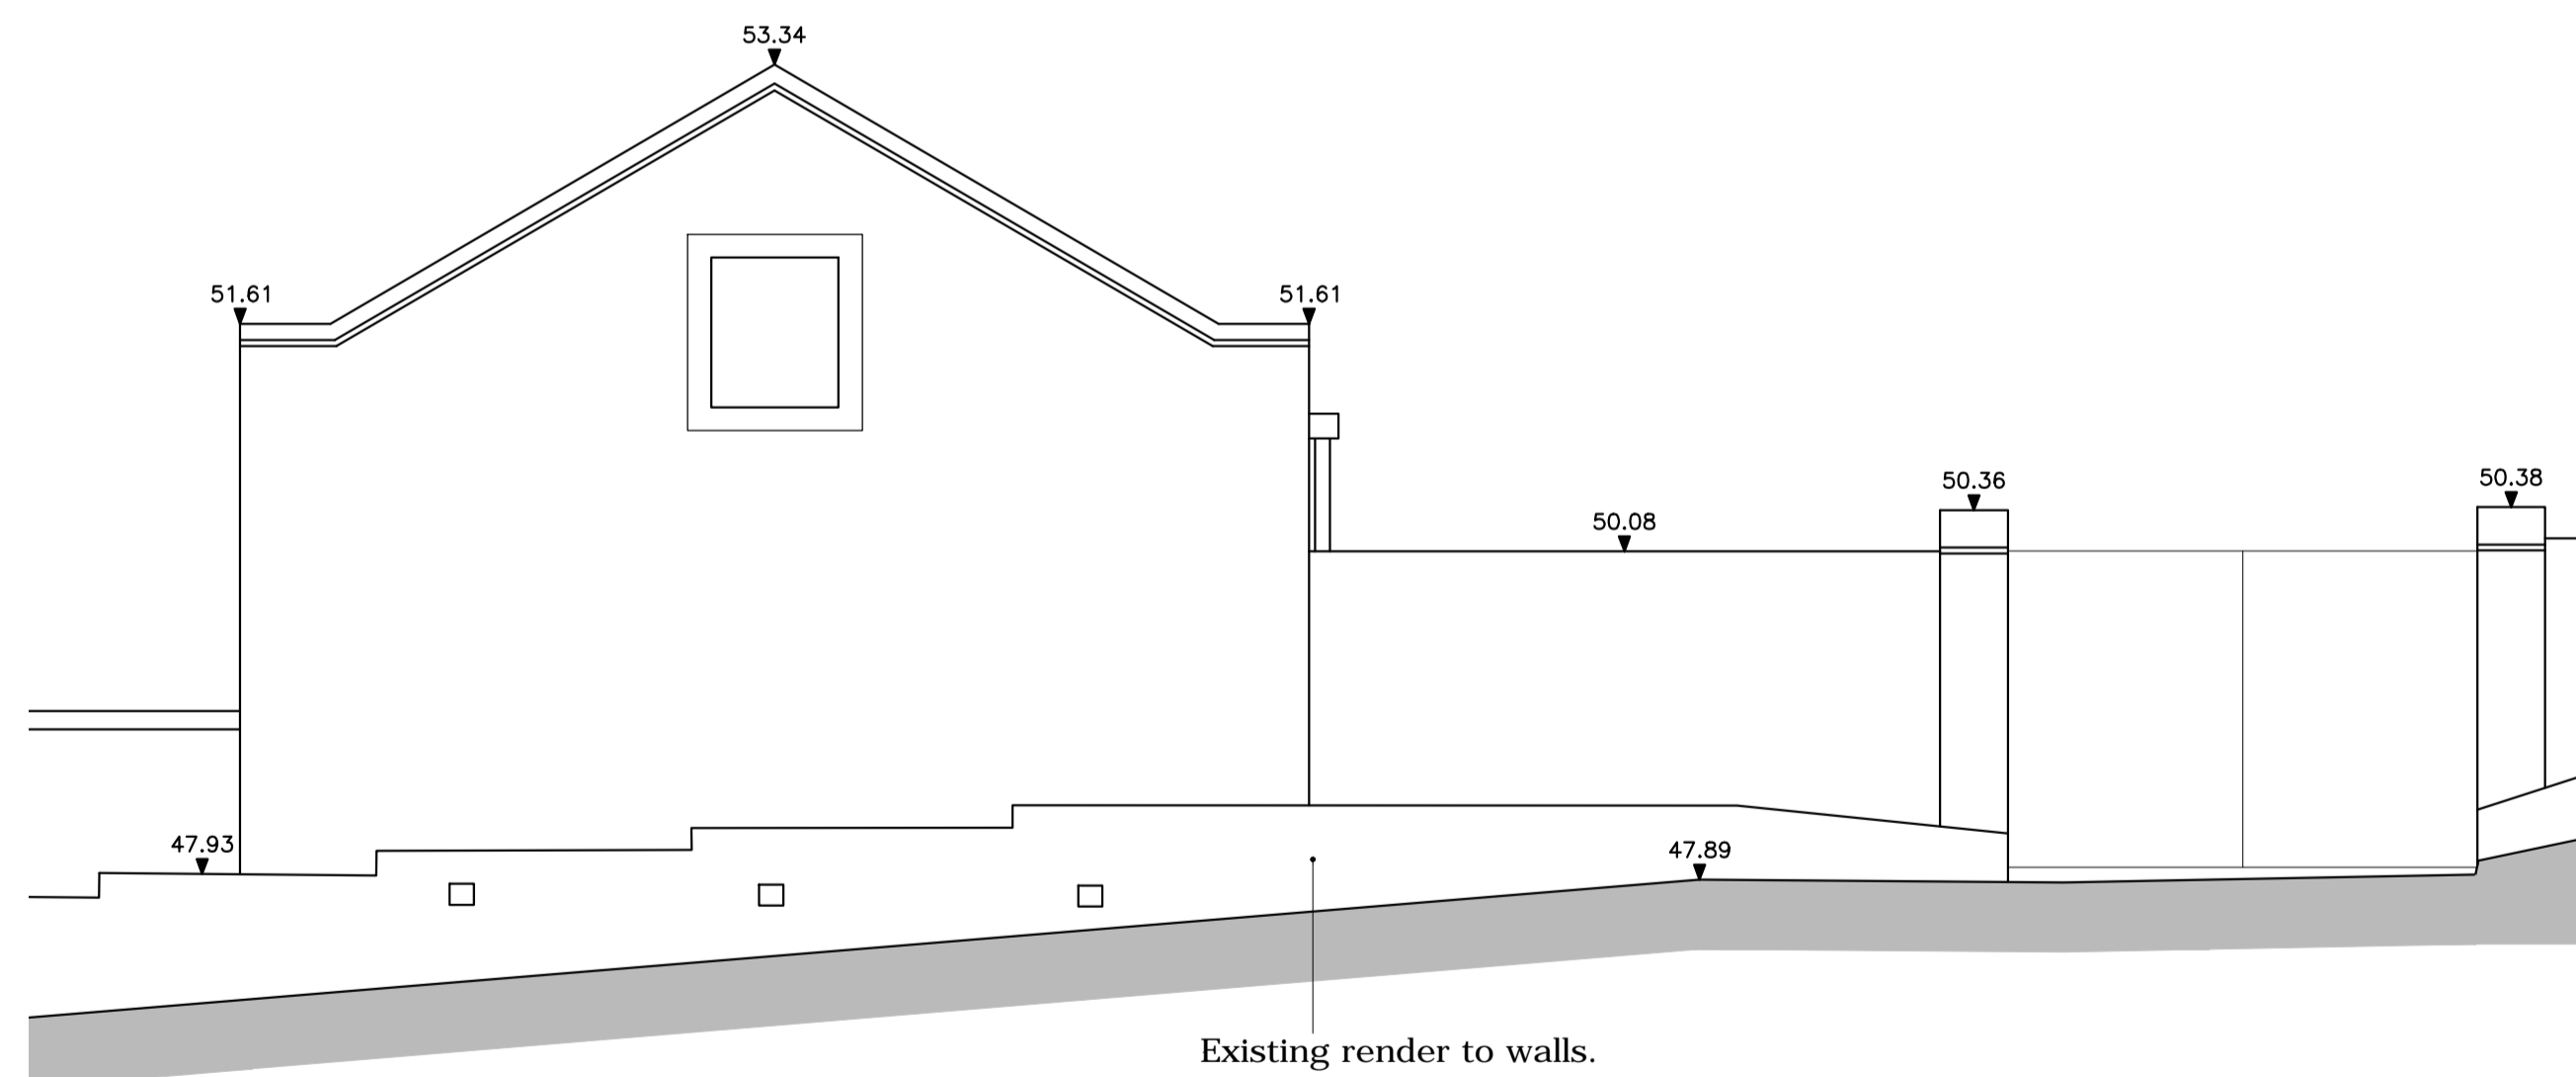


EAST ELEVATION

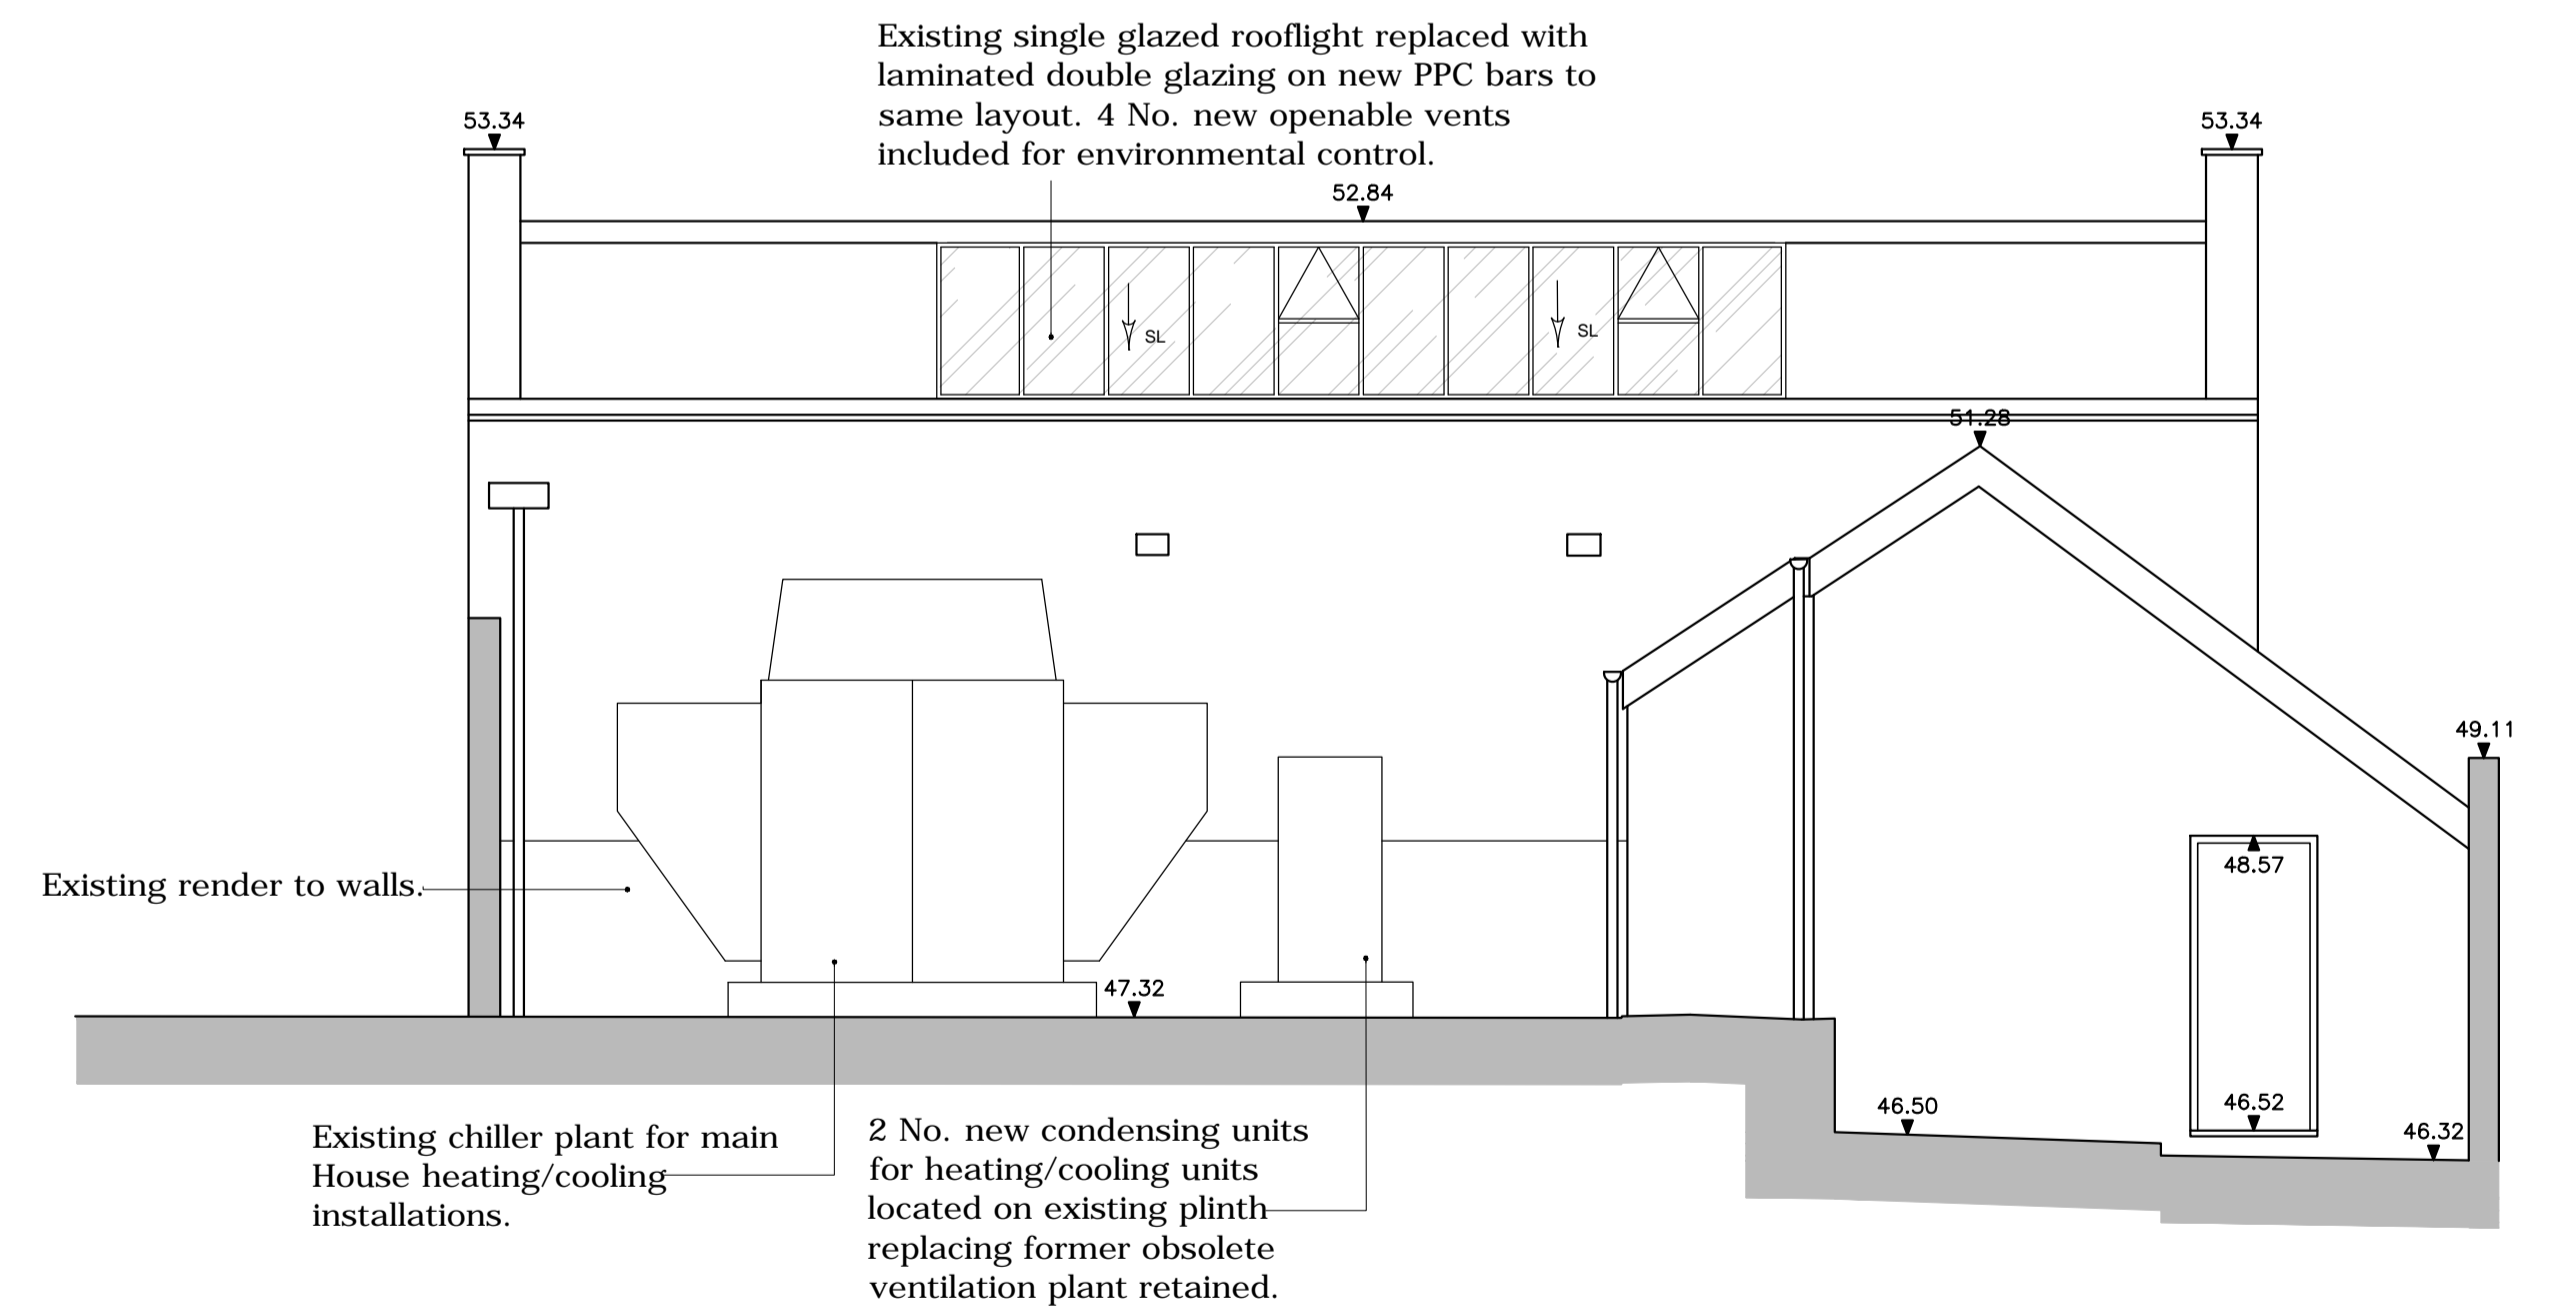

NORTH ELEVATION

KEY:

- TO BE REMOVED
- EXISTING WALLS
- AS BUILT / RETAINED

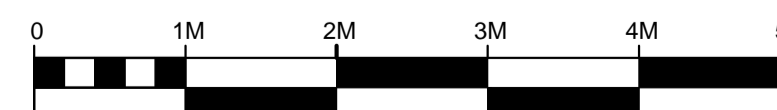

Rev	Date	Description	By

Client
HANLEY LIMITED

scott&twine
ARCHITECTS & INTERIOR DESIGNERS
The Old Power Station, Mortlake High Street
London SW14 8SN
T +44 (0) 20 3355 9699
www.scott-twine.co.uk

Issue
PLANNING

Preliminary / Planning / LBC / Tender / Construction / As Built
Project
Beechwood, London N6
Conversion of Former Squash Court

Title
Elevation
As Built

Date Set 2019	Scale 1:100@A3 - 1:50@A1
Drawn By GT	Checked By VS
Drawing Number 2230-06/10/04	Revision -