




WEST ELEVATION

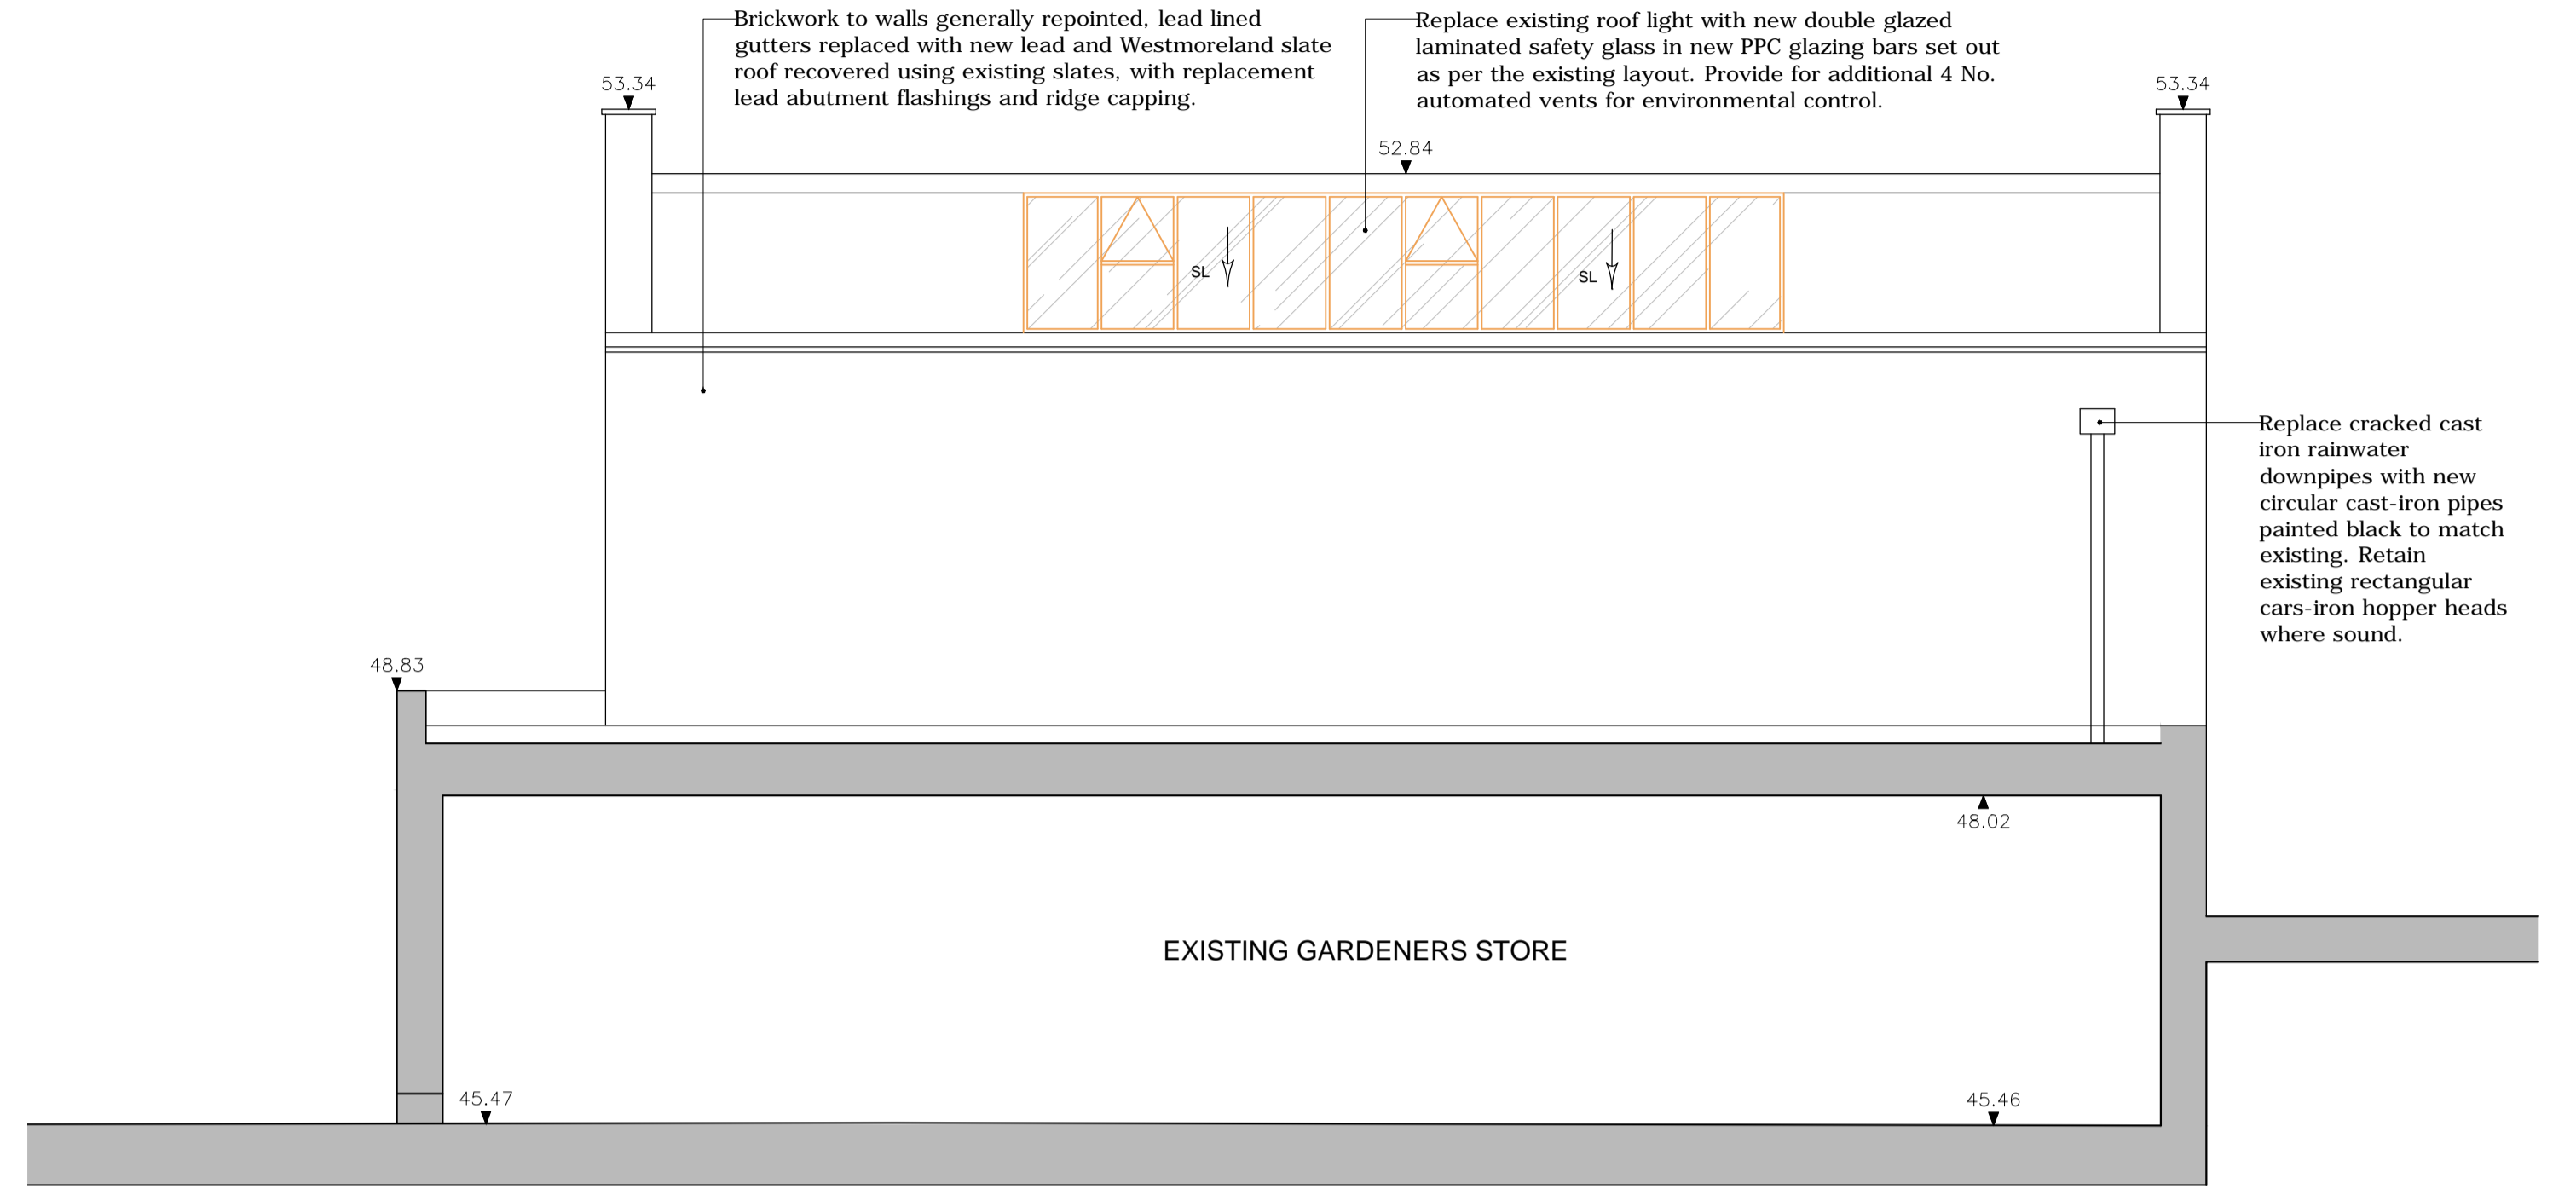

SOUTH ELEVATION

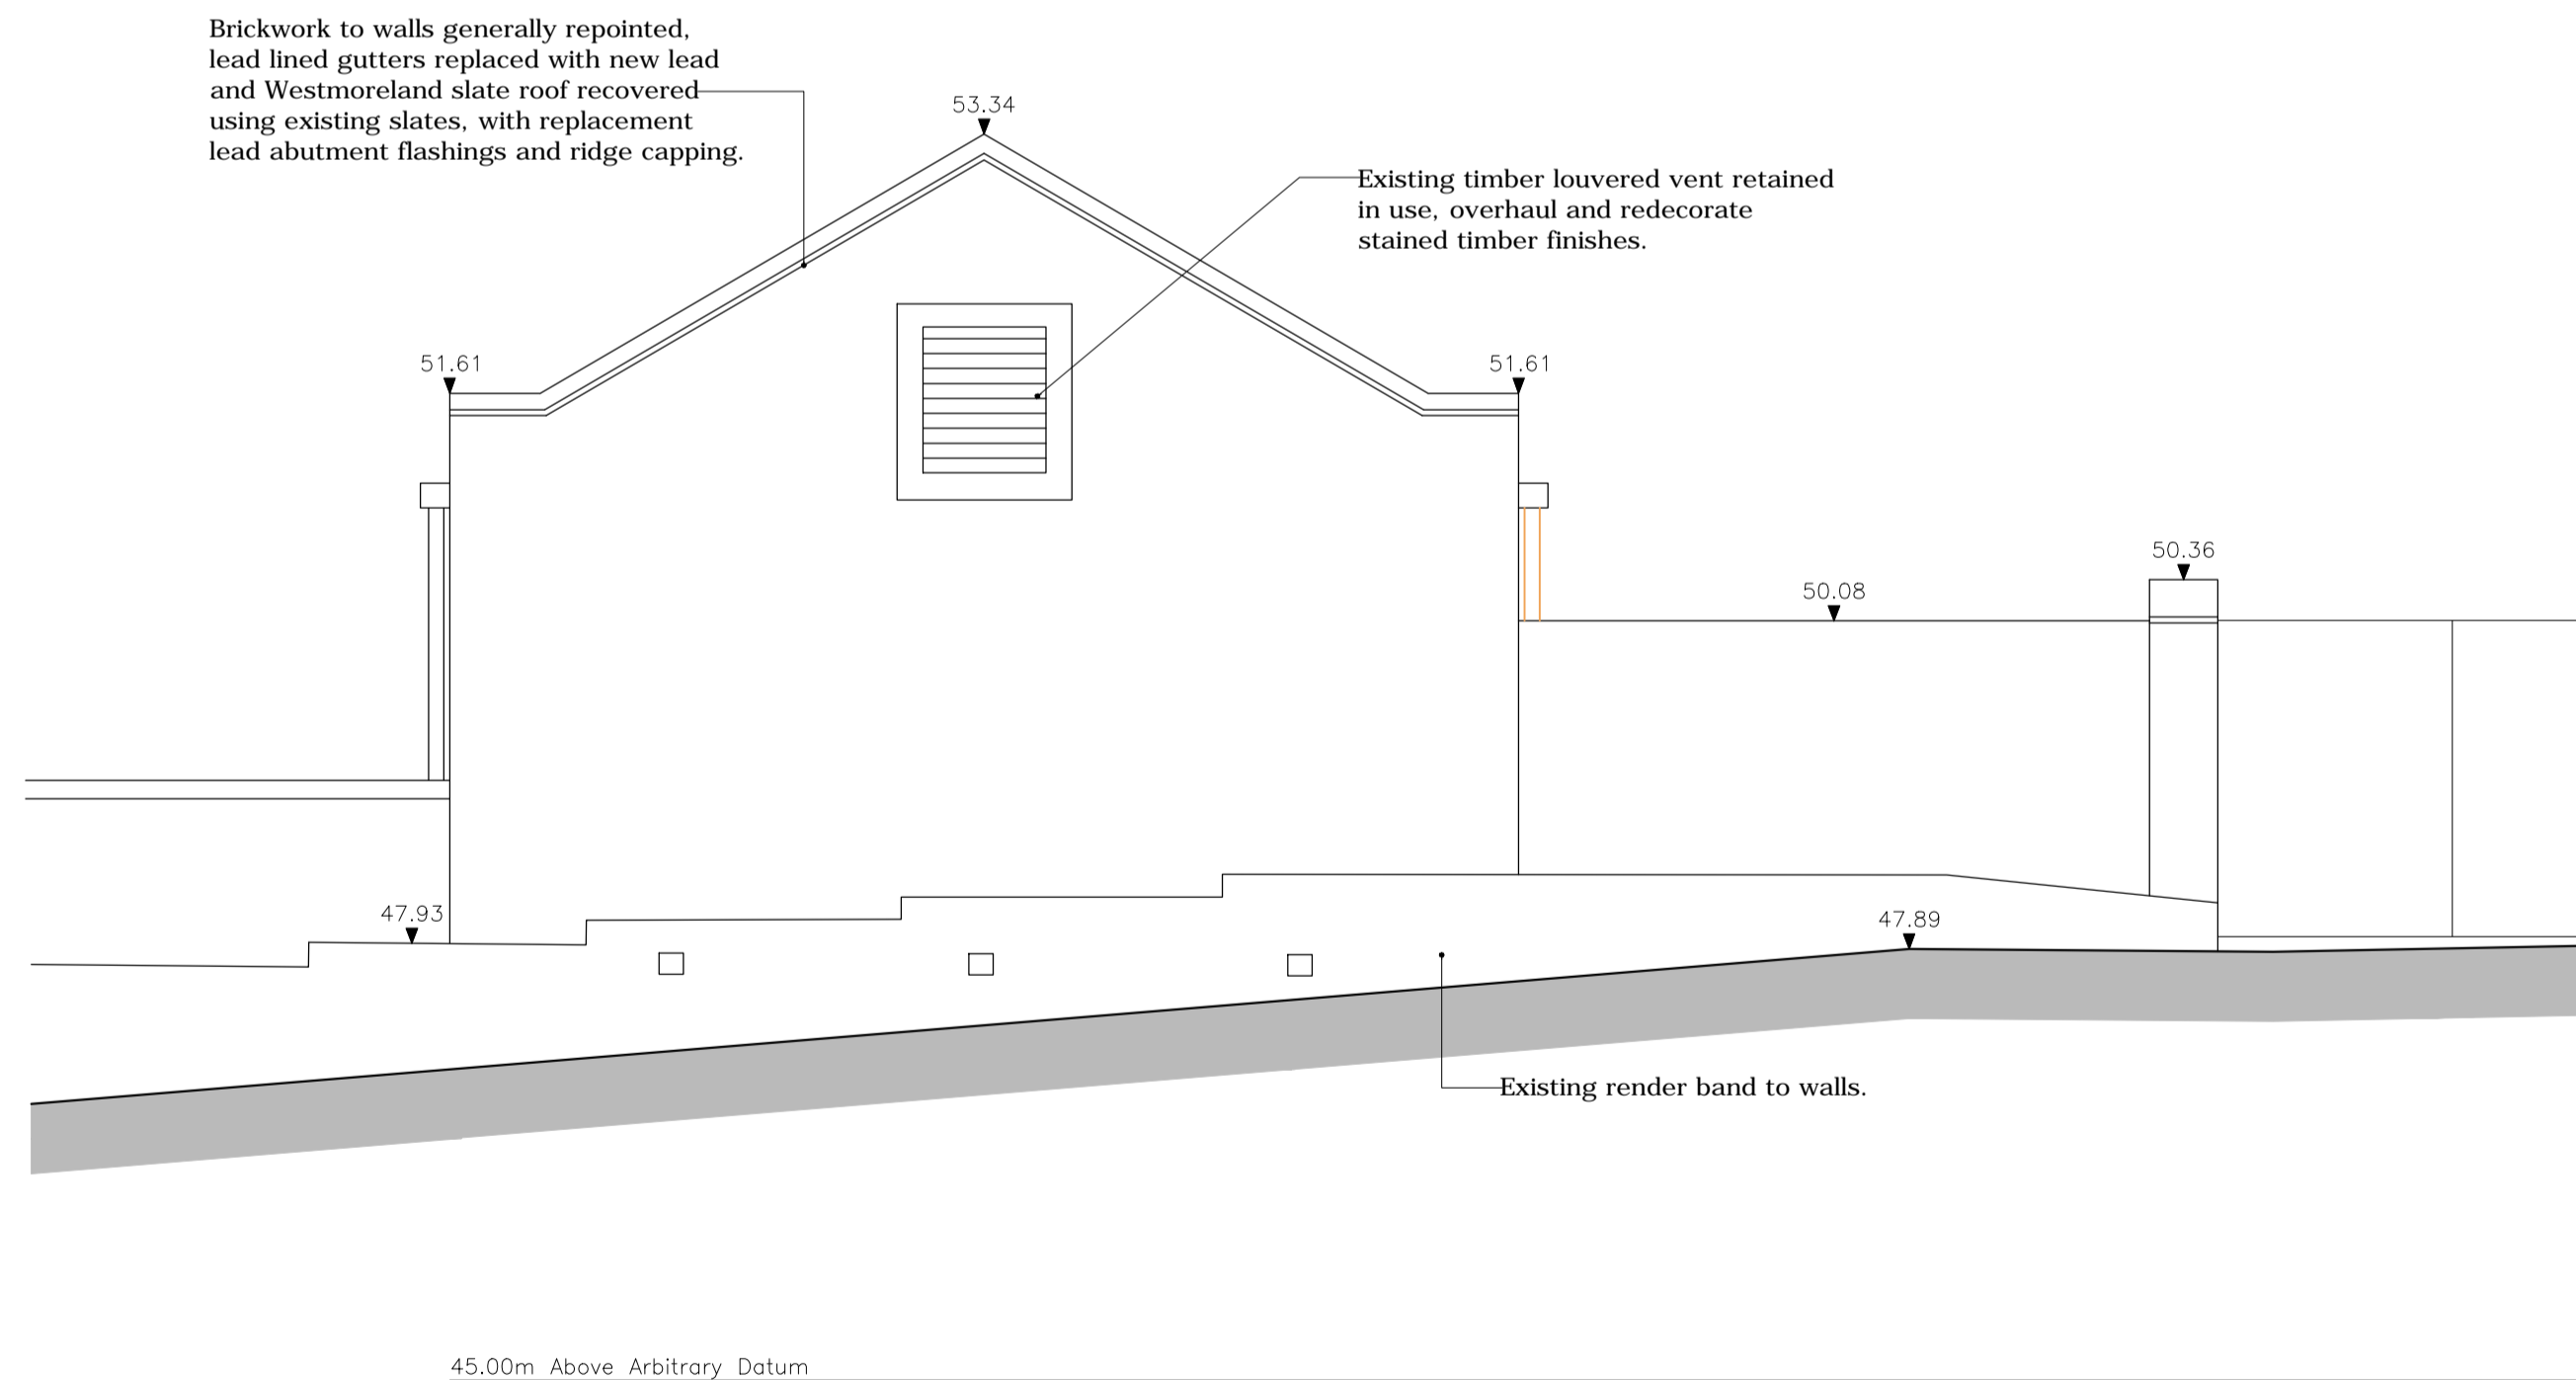


EAST ELEVATION

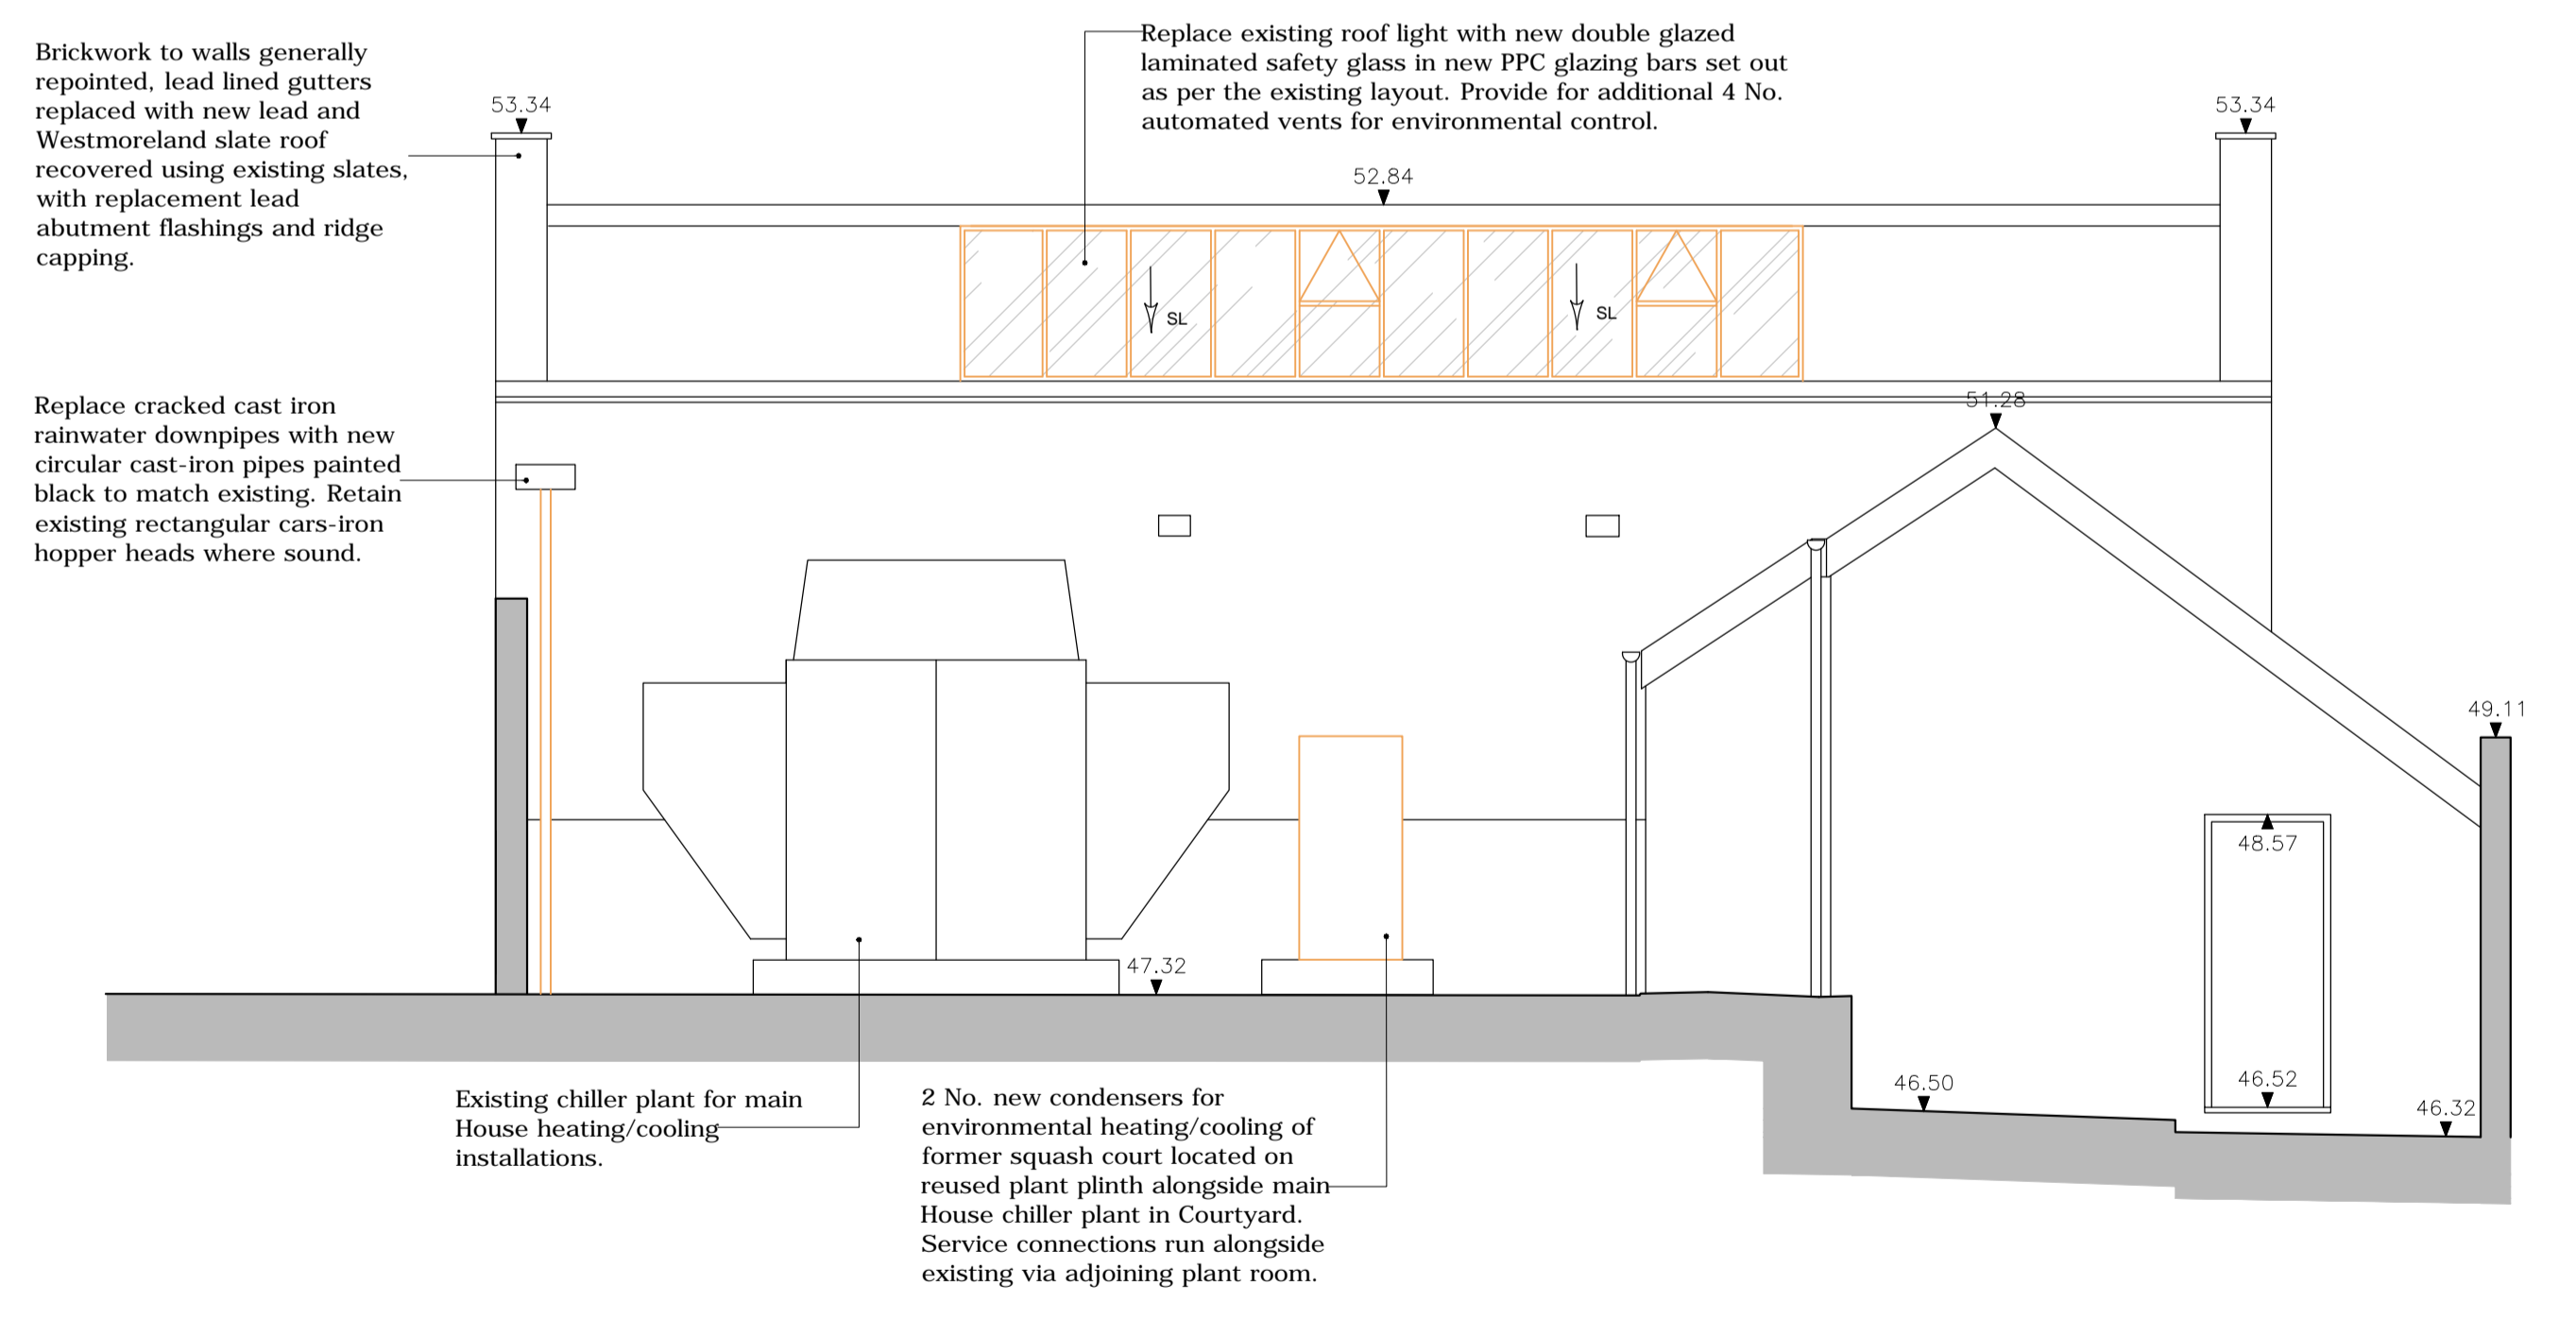

NORTH ELEVATION

	EXISTING
	RETROSPECTIVE WORKS
	PROPOSED WORKS

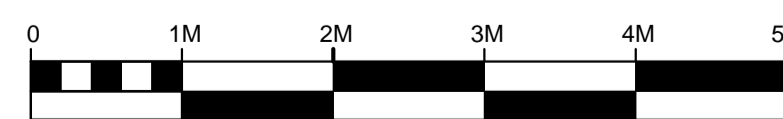

Rev	Date	Description	GT/VS	By
A	Sep 19	Amended Scheme		

Client  
HANLEY LIMITED

**scott & twine**  
ARCHITECTS & INTERIOR DESIGNERS  
The Old Power Station, Mortlake High Street  
London SW14 8SN  
T +44 (0) 20 3355 9699  
www.scott-twine.co.uk

Issue  
**PLANNING**  
Preliminary / Planning / LBC / Tender / Construction / As Built

Project  
Beechwood, London N6  
Conversion of Former Squash Court

Title Elevations As Proposed	
Date July 2017	Scale 1:100@A3 - 1:50@A1
Drawn By GT	Checked By VS
Drawing Number 2230-06/01/04	Revision A