






FRONT ELEVATION 1:100

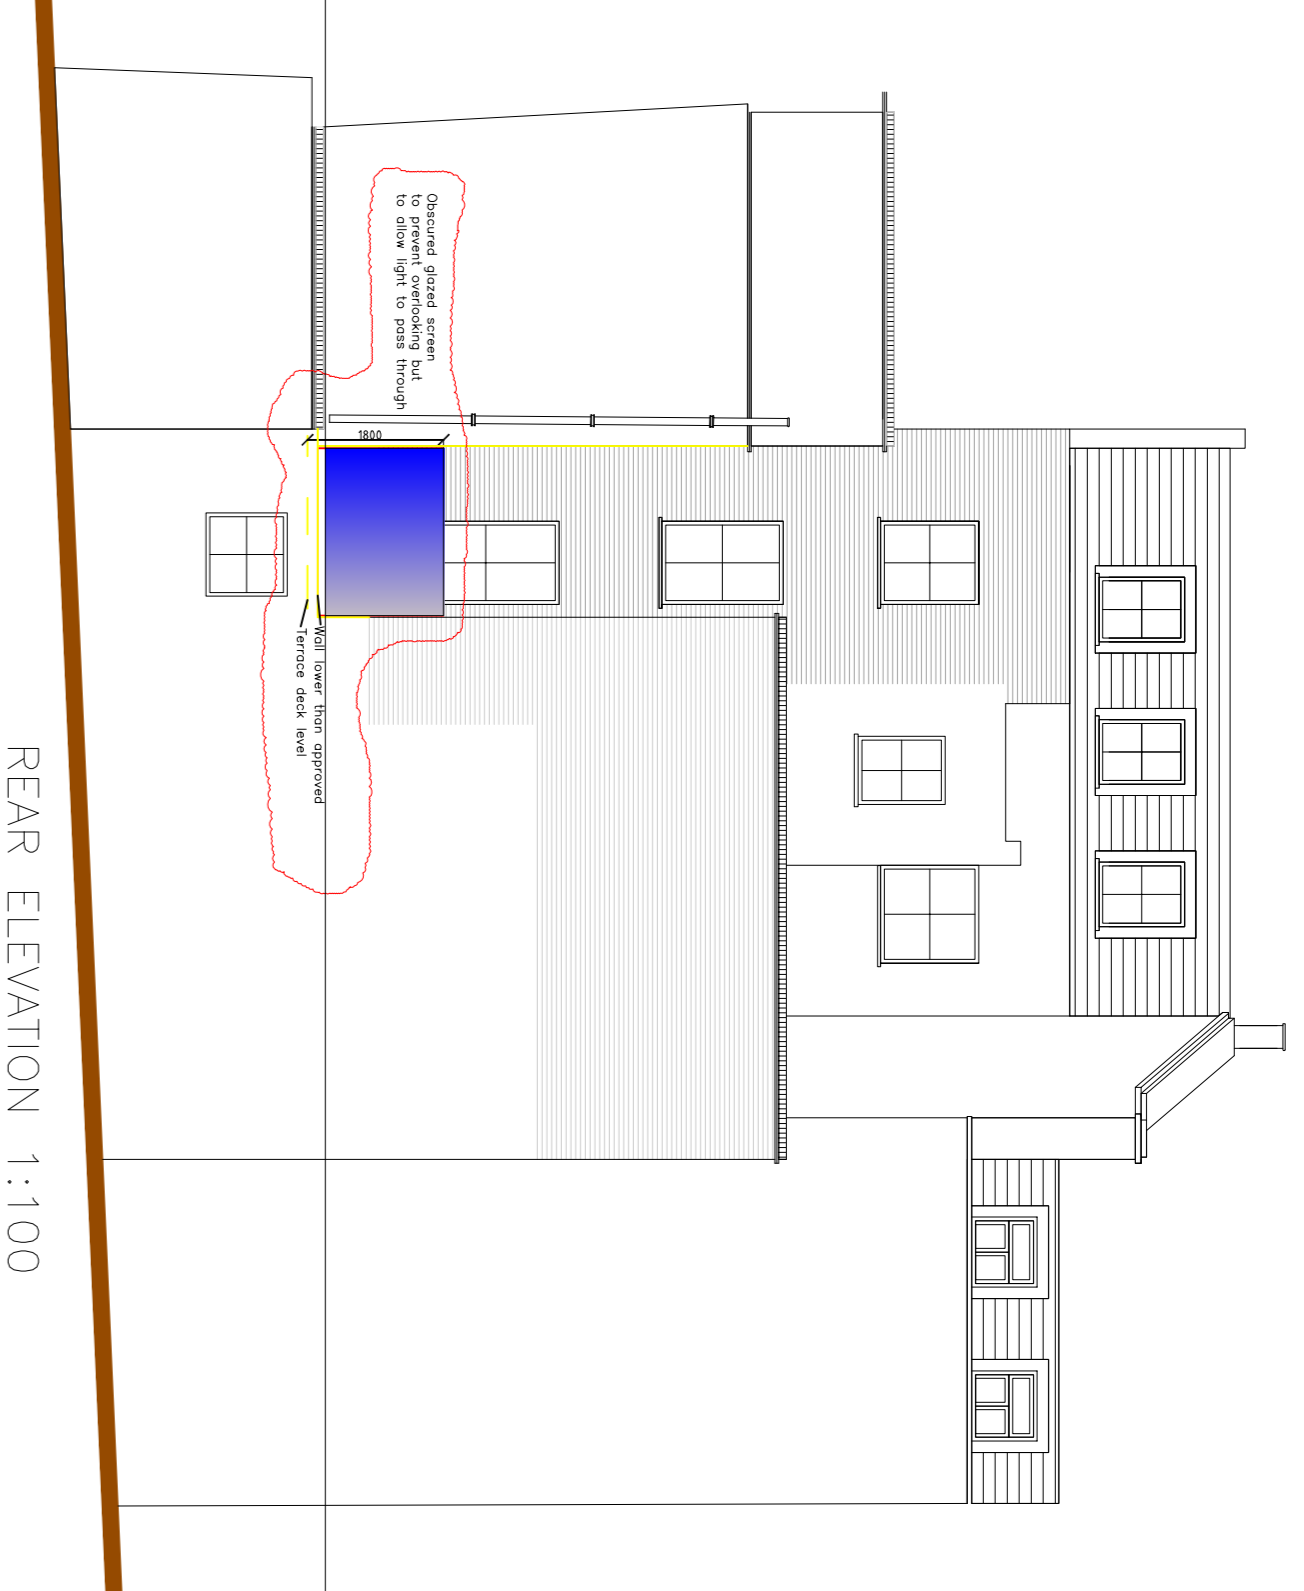


REAR ELEVATION 1:100

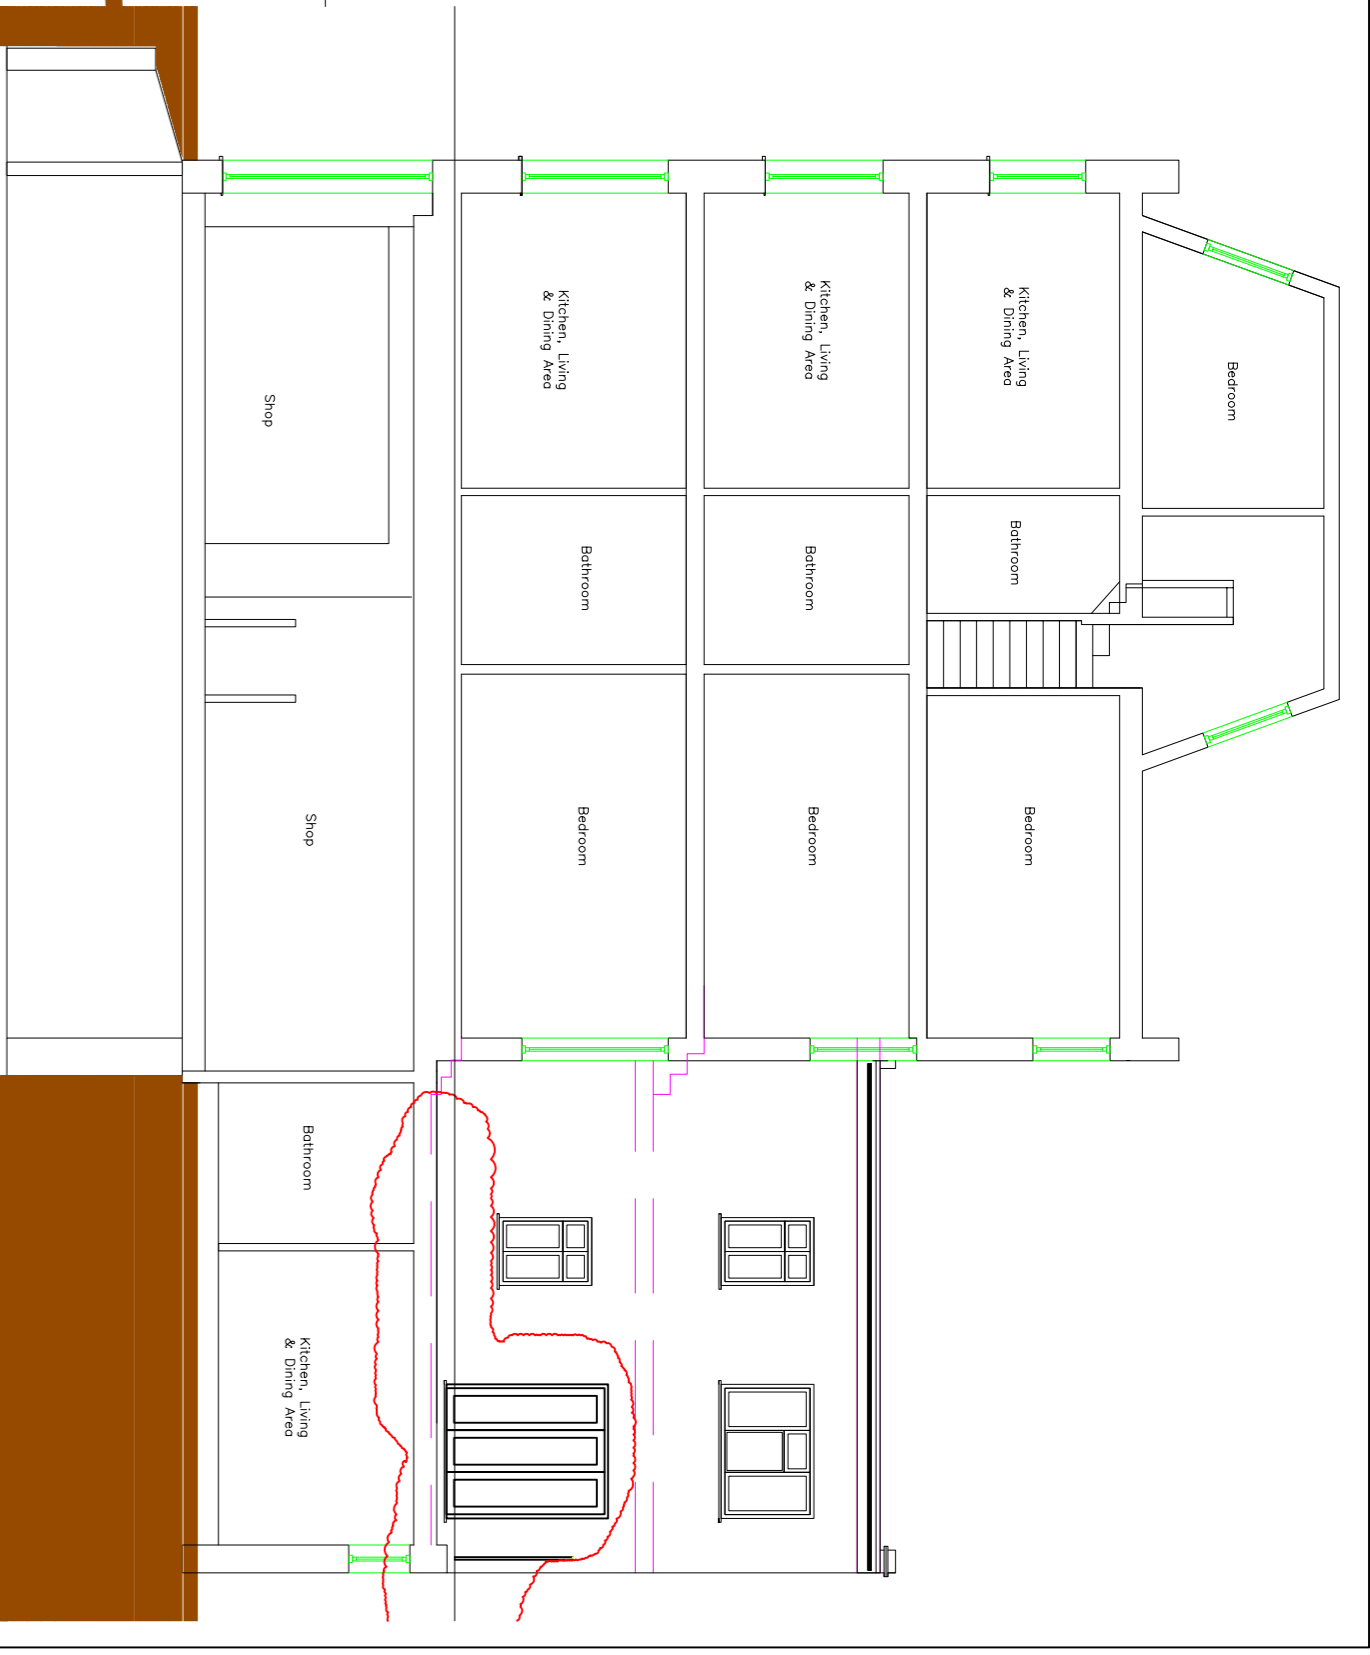


SECTION / SIDE ELEVATION 1:100

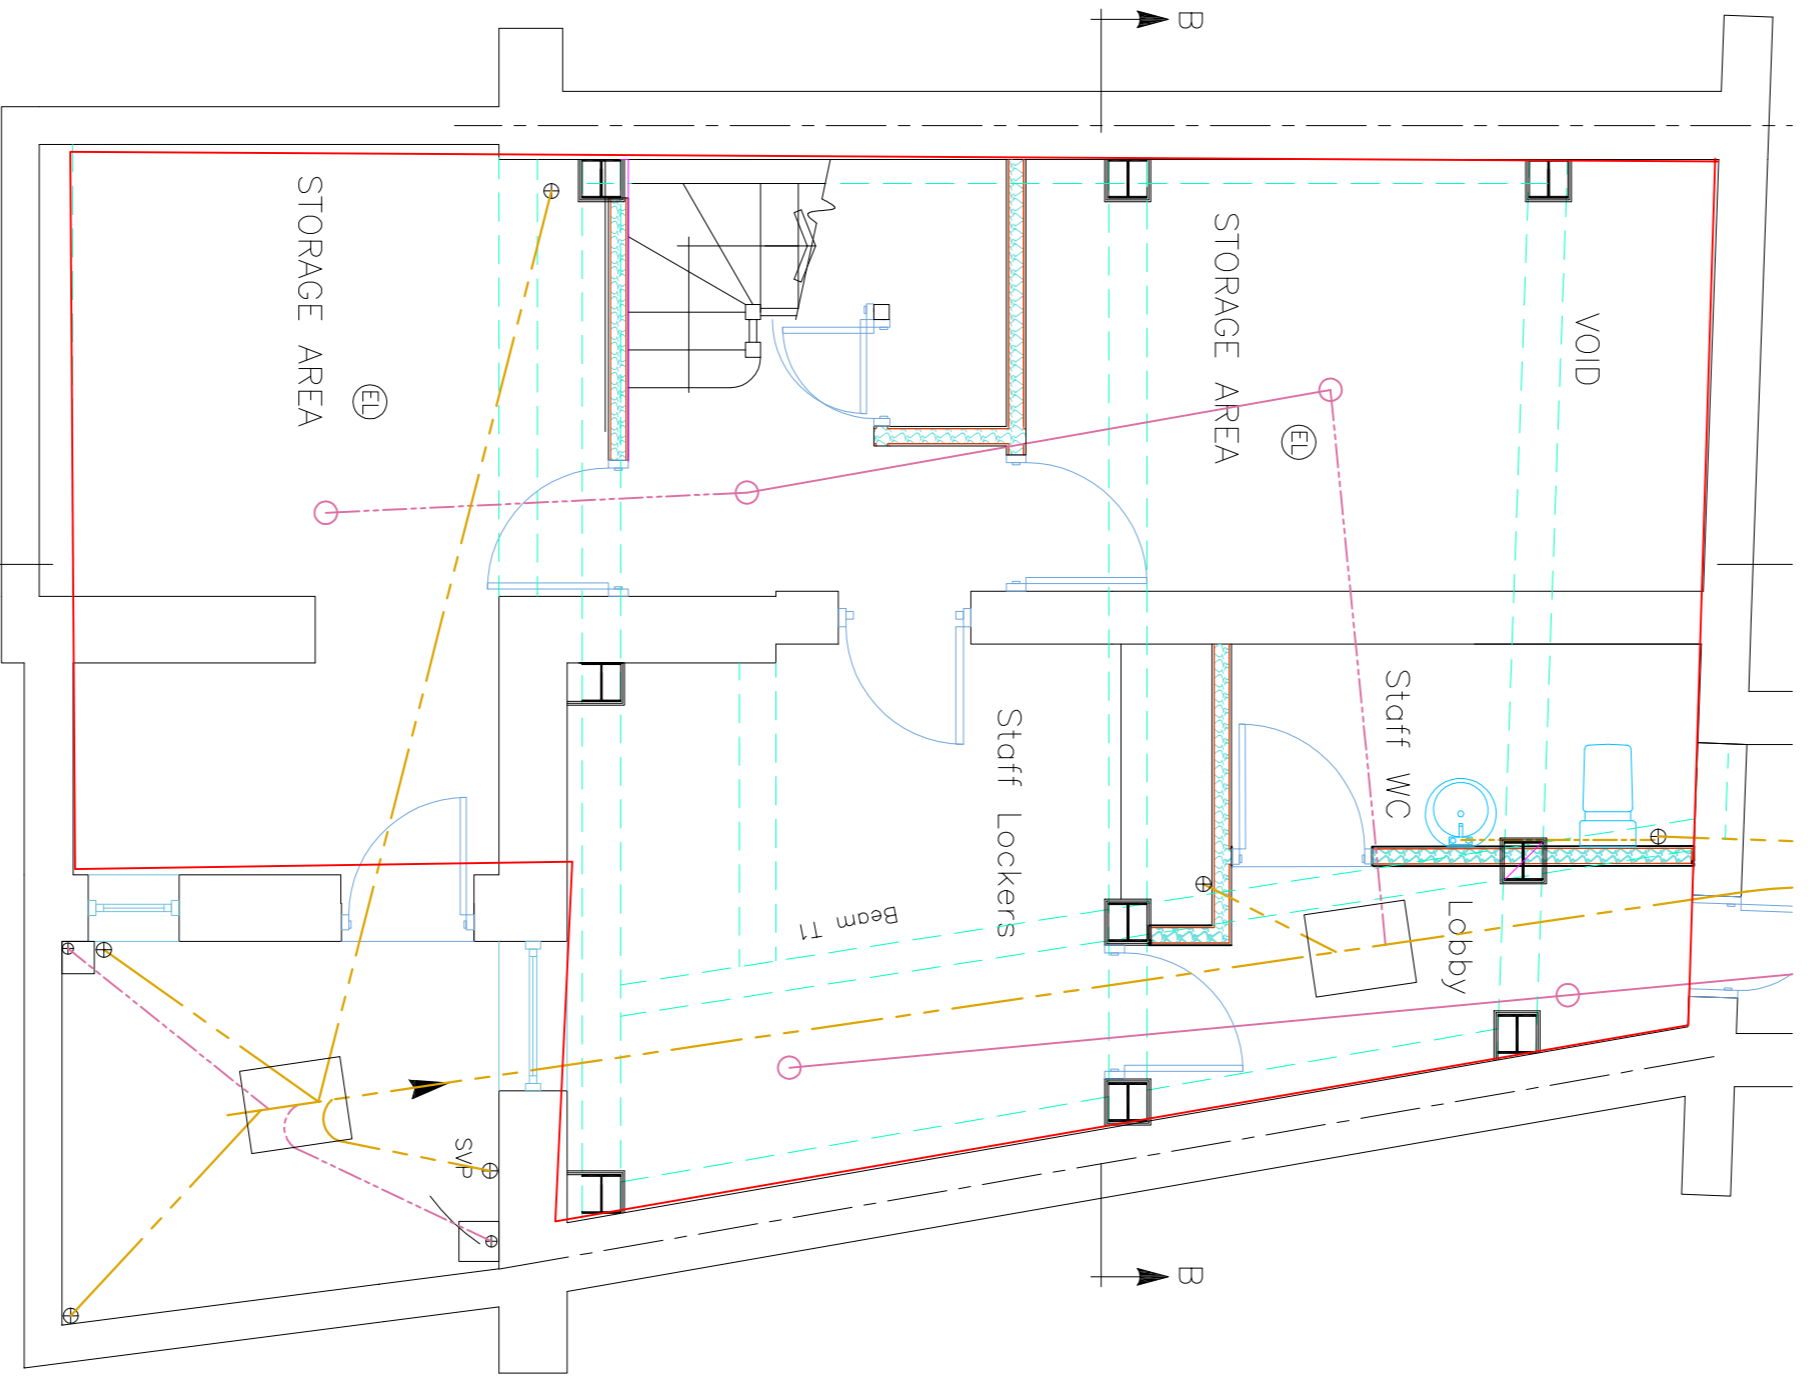

BASEMENT PLAN 1:50

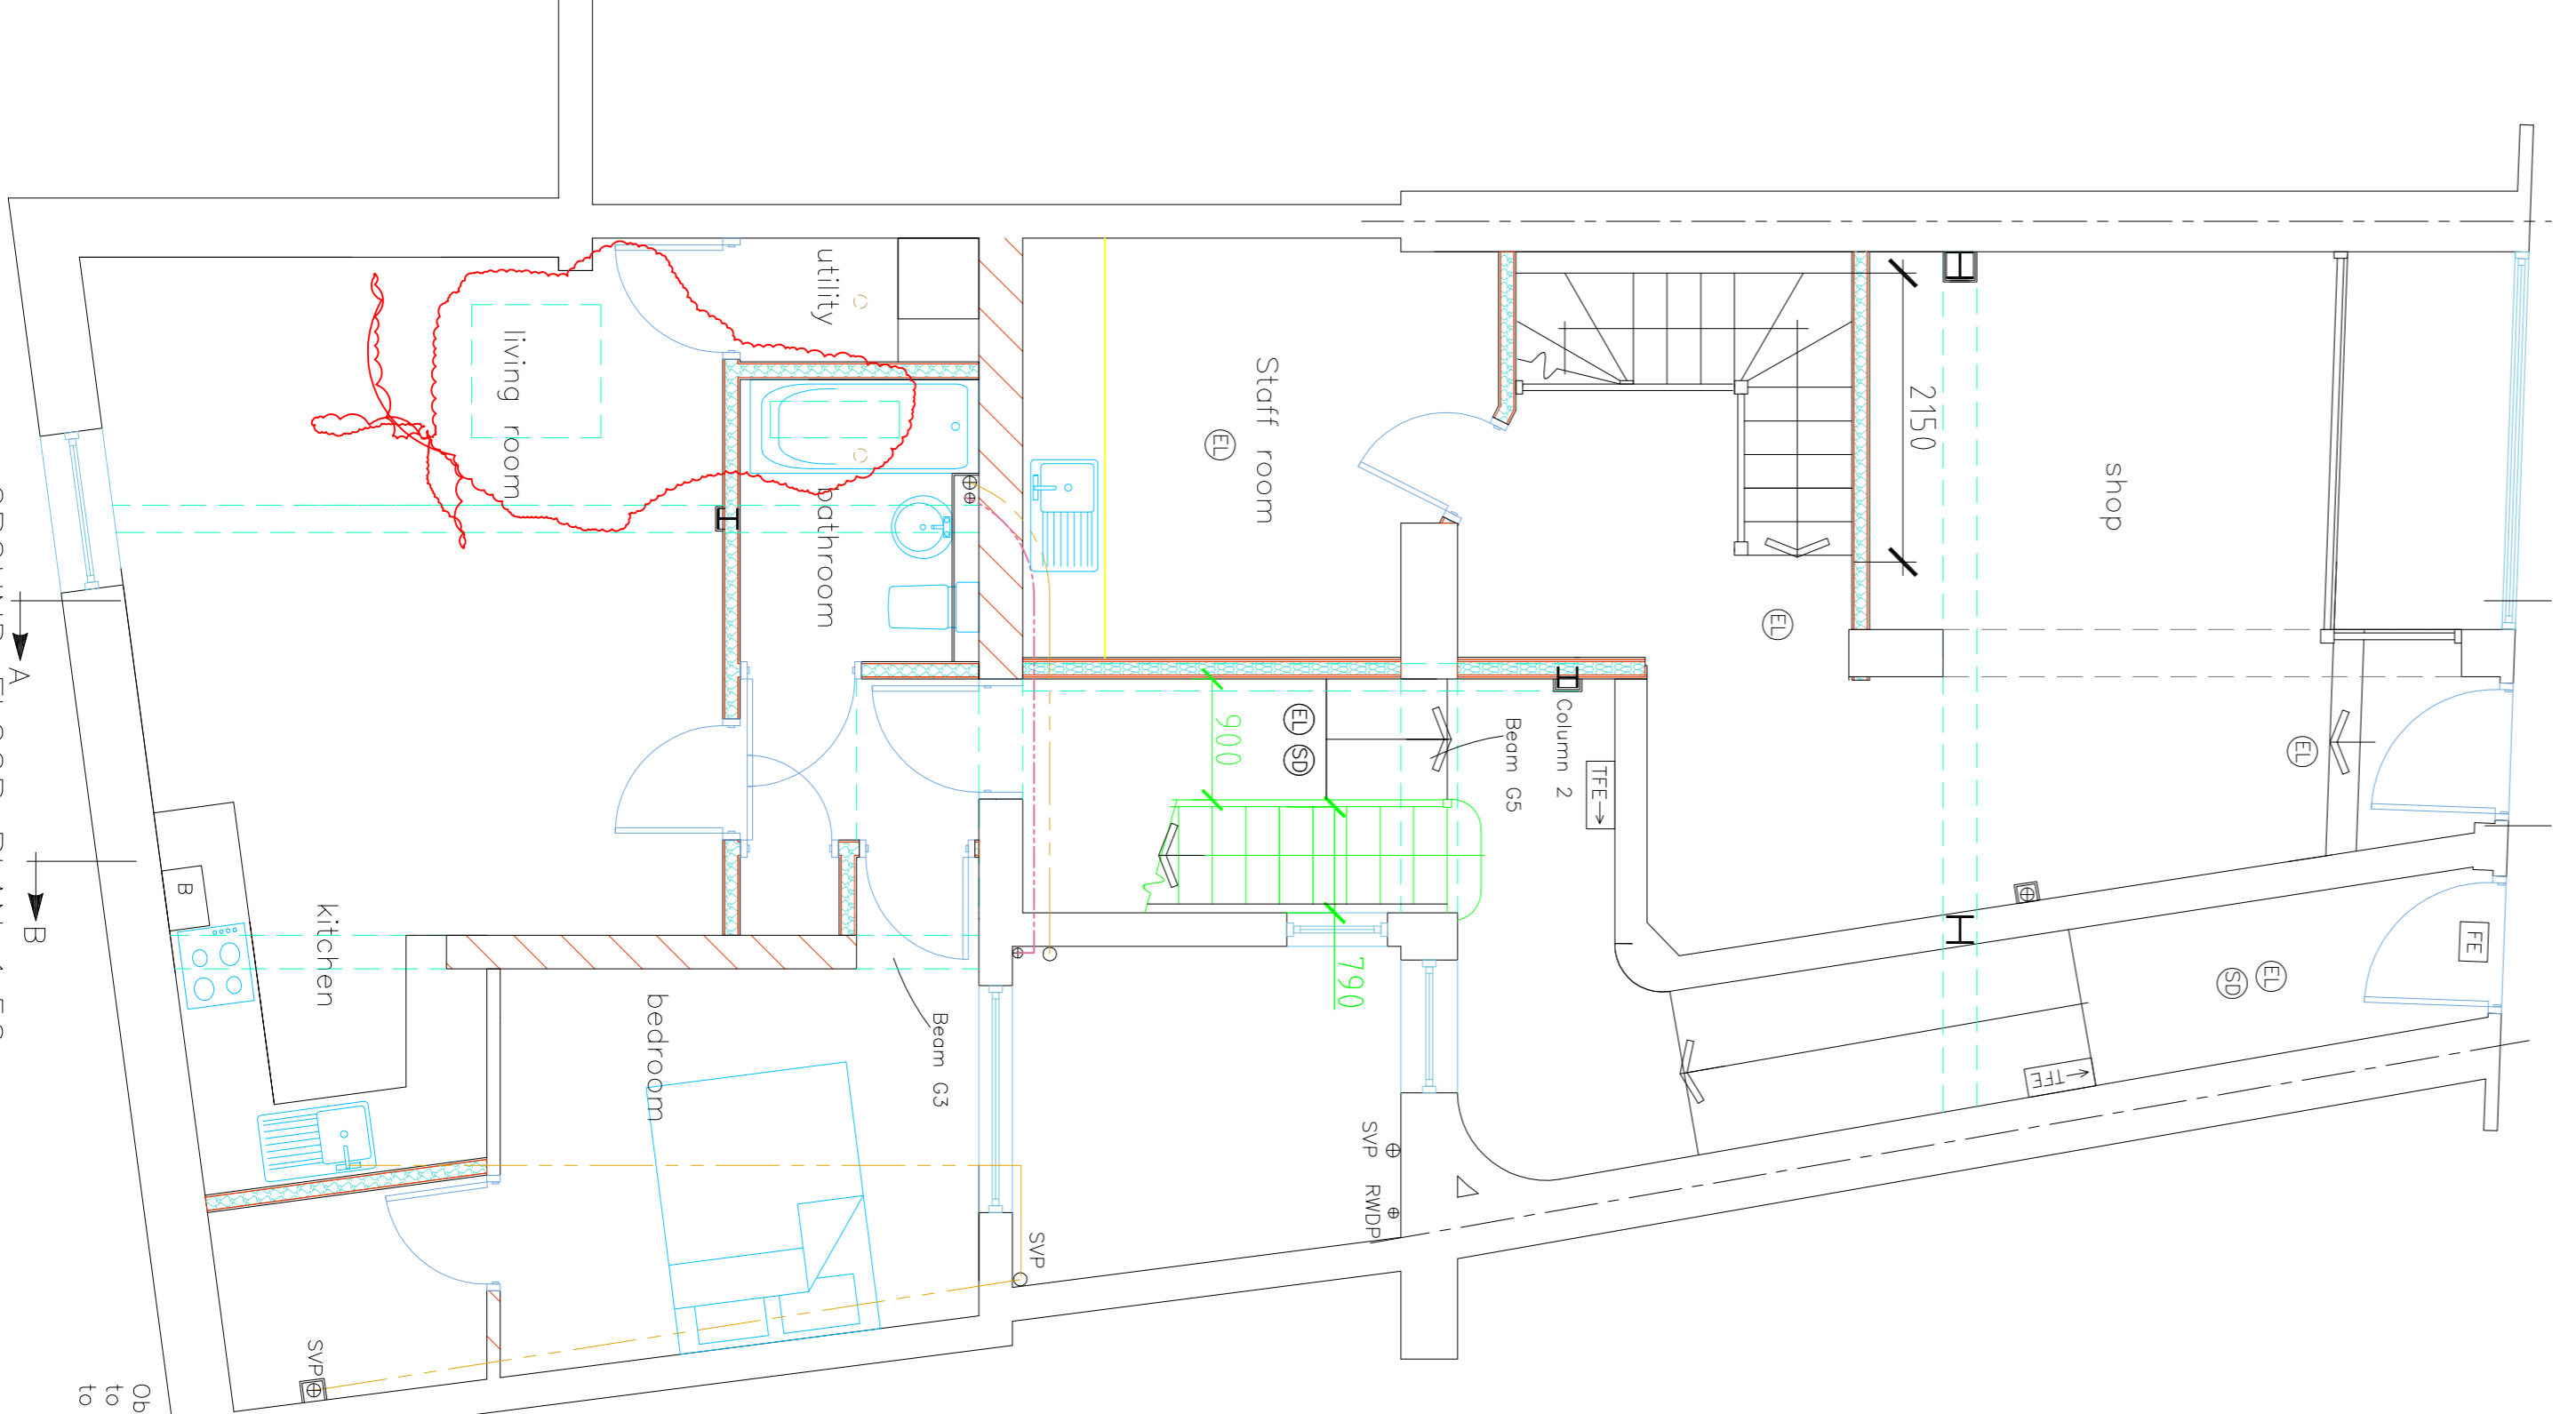

GROUND FLOOR PLAN 1:50

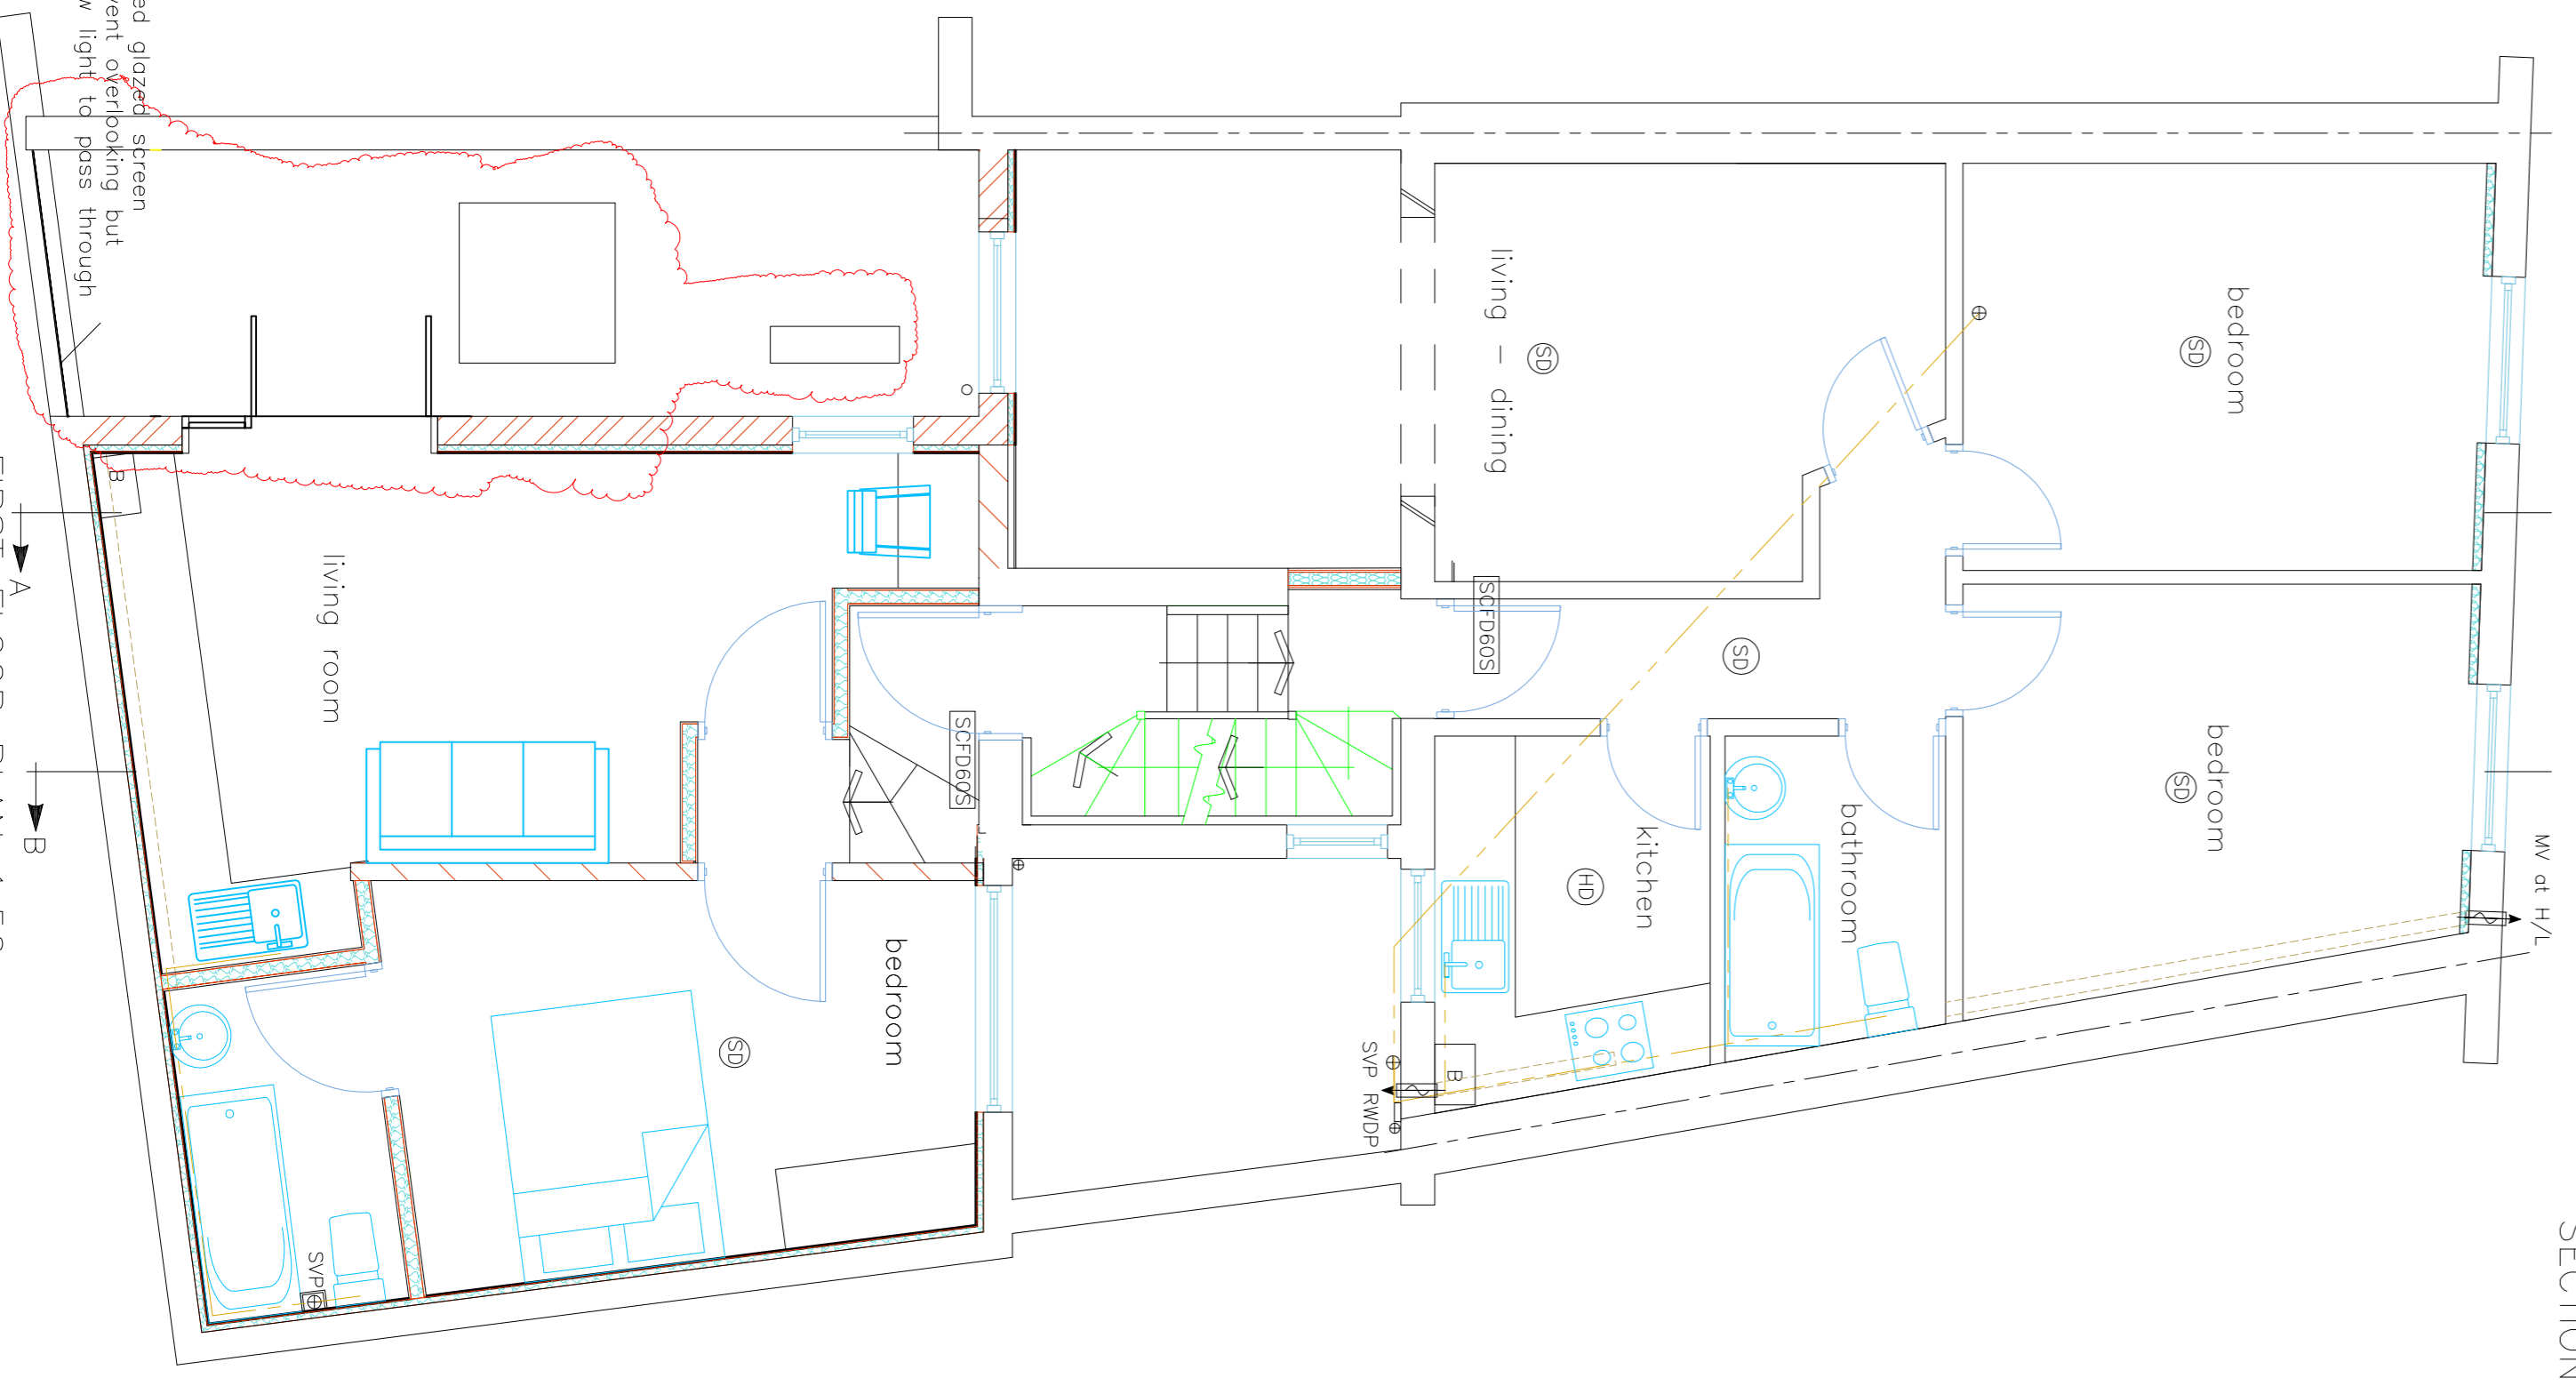

FIRST FLOOR PLAN 1:50

Notes: All dimensions must be checked on site and not scaled from this drawing.

© Copyright

Simon Hands and Associates
Chartered Surveyors & Architects
12 Redlip Road
Middlesbrough
TS6 9GN
email: enquiries@simonhands.co.uk

Client: **Fabrizio Indalcato**
Job Title: **Proposed Works at 129 Kings Cross Road London WC1X 9BJ**

Drawing Title: **AS CONSTRUCTED PLANS & ELEVATIONS**

Scale	1:50 1:100	Sheet Size	A1
Date	25/10/19	Drawn By	CEC
Job No	2019161	Rev	A