




**OS MAP**  
 SCALE: 1 : 1250 @ A1  
 1 : 2500 @ A3



**Block Plan**  
 SCALE: 1 : 200 @ A1  
 1 : 400 @ A3

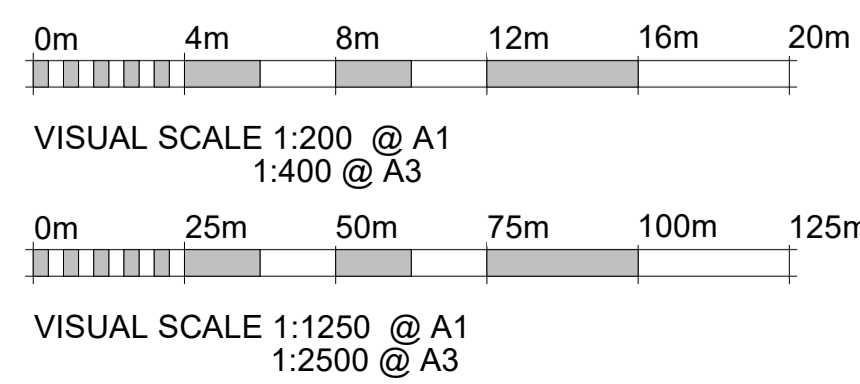

**Dimensions** Written dimensions to be taken in preferences to scaled dimensions. The Contractor is responsible for checking all dimensions before work starts.

**Local Authority** All work is to be carried out to the requirements, and to the satisfaction of the Local Authority. These drawings are for planning purposes only.




**RPR PLANNING**  
 Office 5, 37 Stanmore Hill  
 London, HA7 3DS.  
 Tel: [Redacted]  
 Mobile: 078 9661 7854  
 Web: www.rprplanning.co.uk  
 Email: info@rprplanning.co.uk

Rev	Date	Description	Made	Checked
-				

Drawing Status: **FOR APPROVAL**


Project	<b>3 ROSECROFT AVENUE</b>
Client	<b>GAURANG AMIN</b>

Drawing Title		<b>OSMAP &amp; BLOCK PLAN</b>	
Drawn/Design		Date	06/07/17
Scales:	AS SHOWN @ A1	Drawing No	<b>A100</b>
		Rev	-

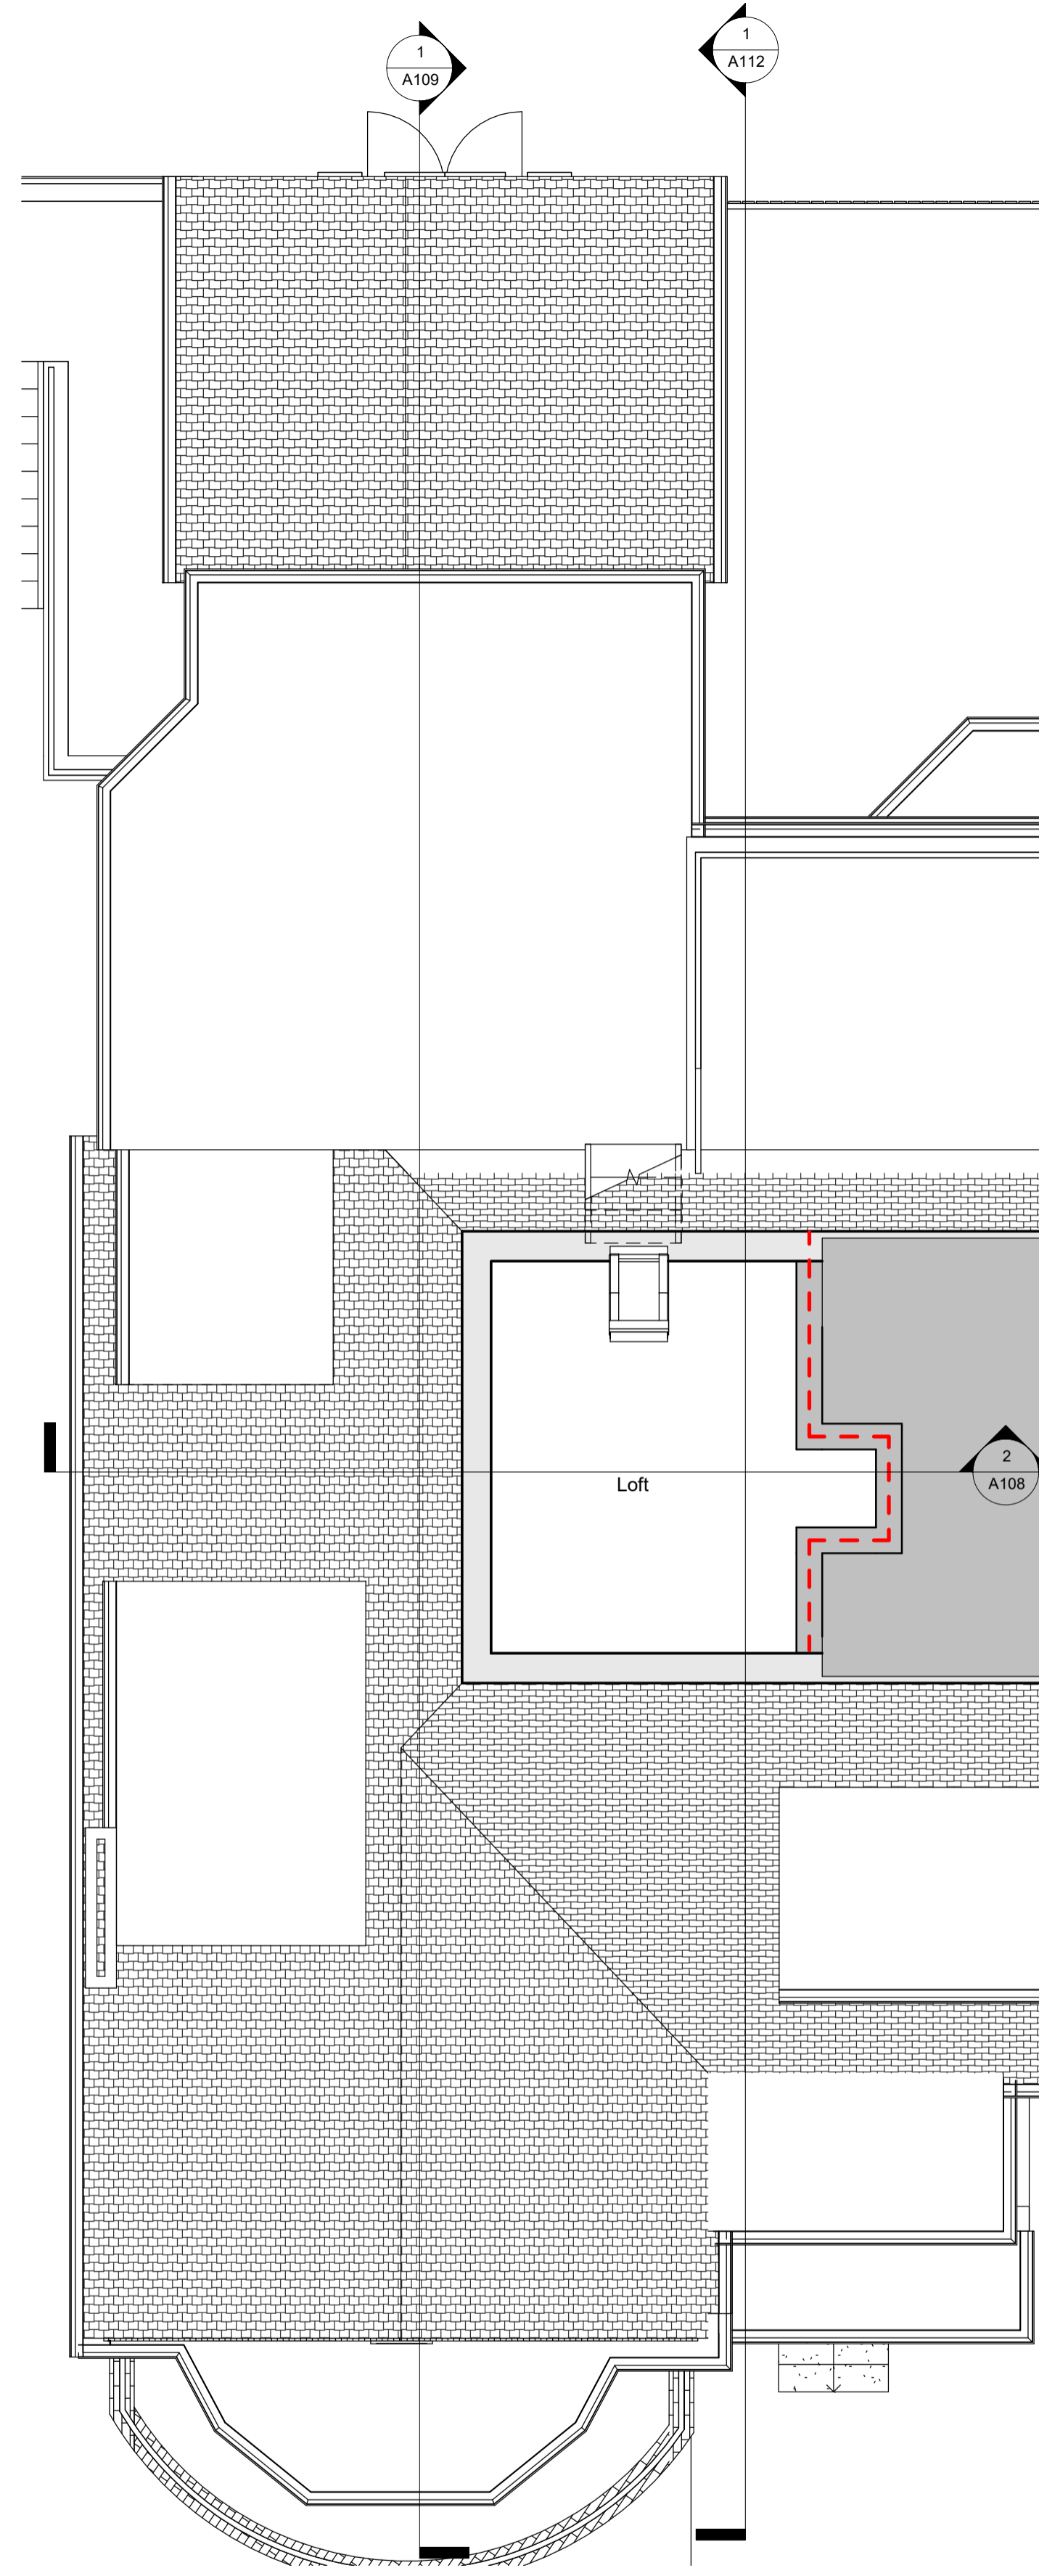


**PL - Existing Loft**

SCALE: 1:50 @ A1  
1:100 @ A3

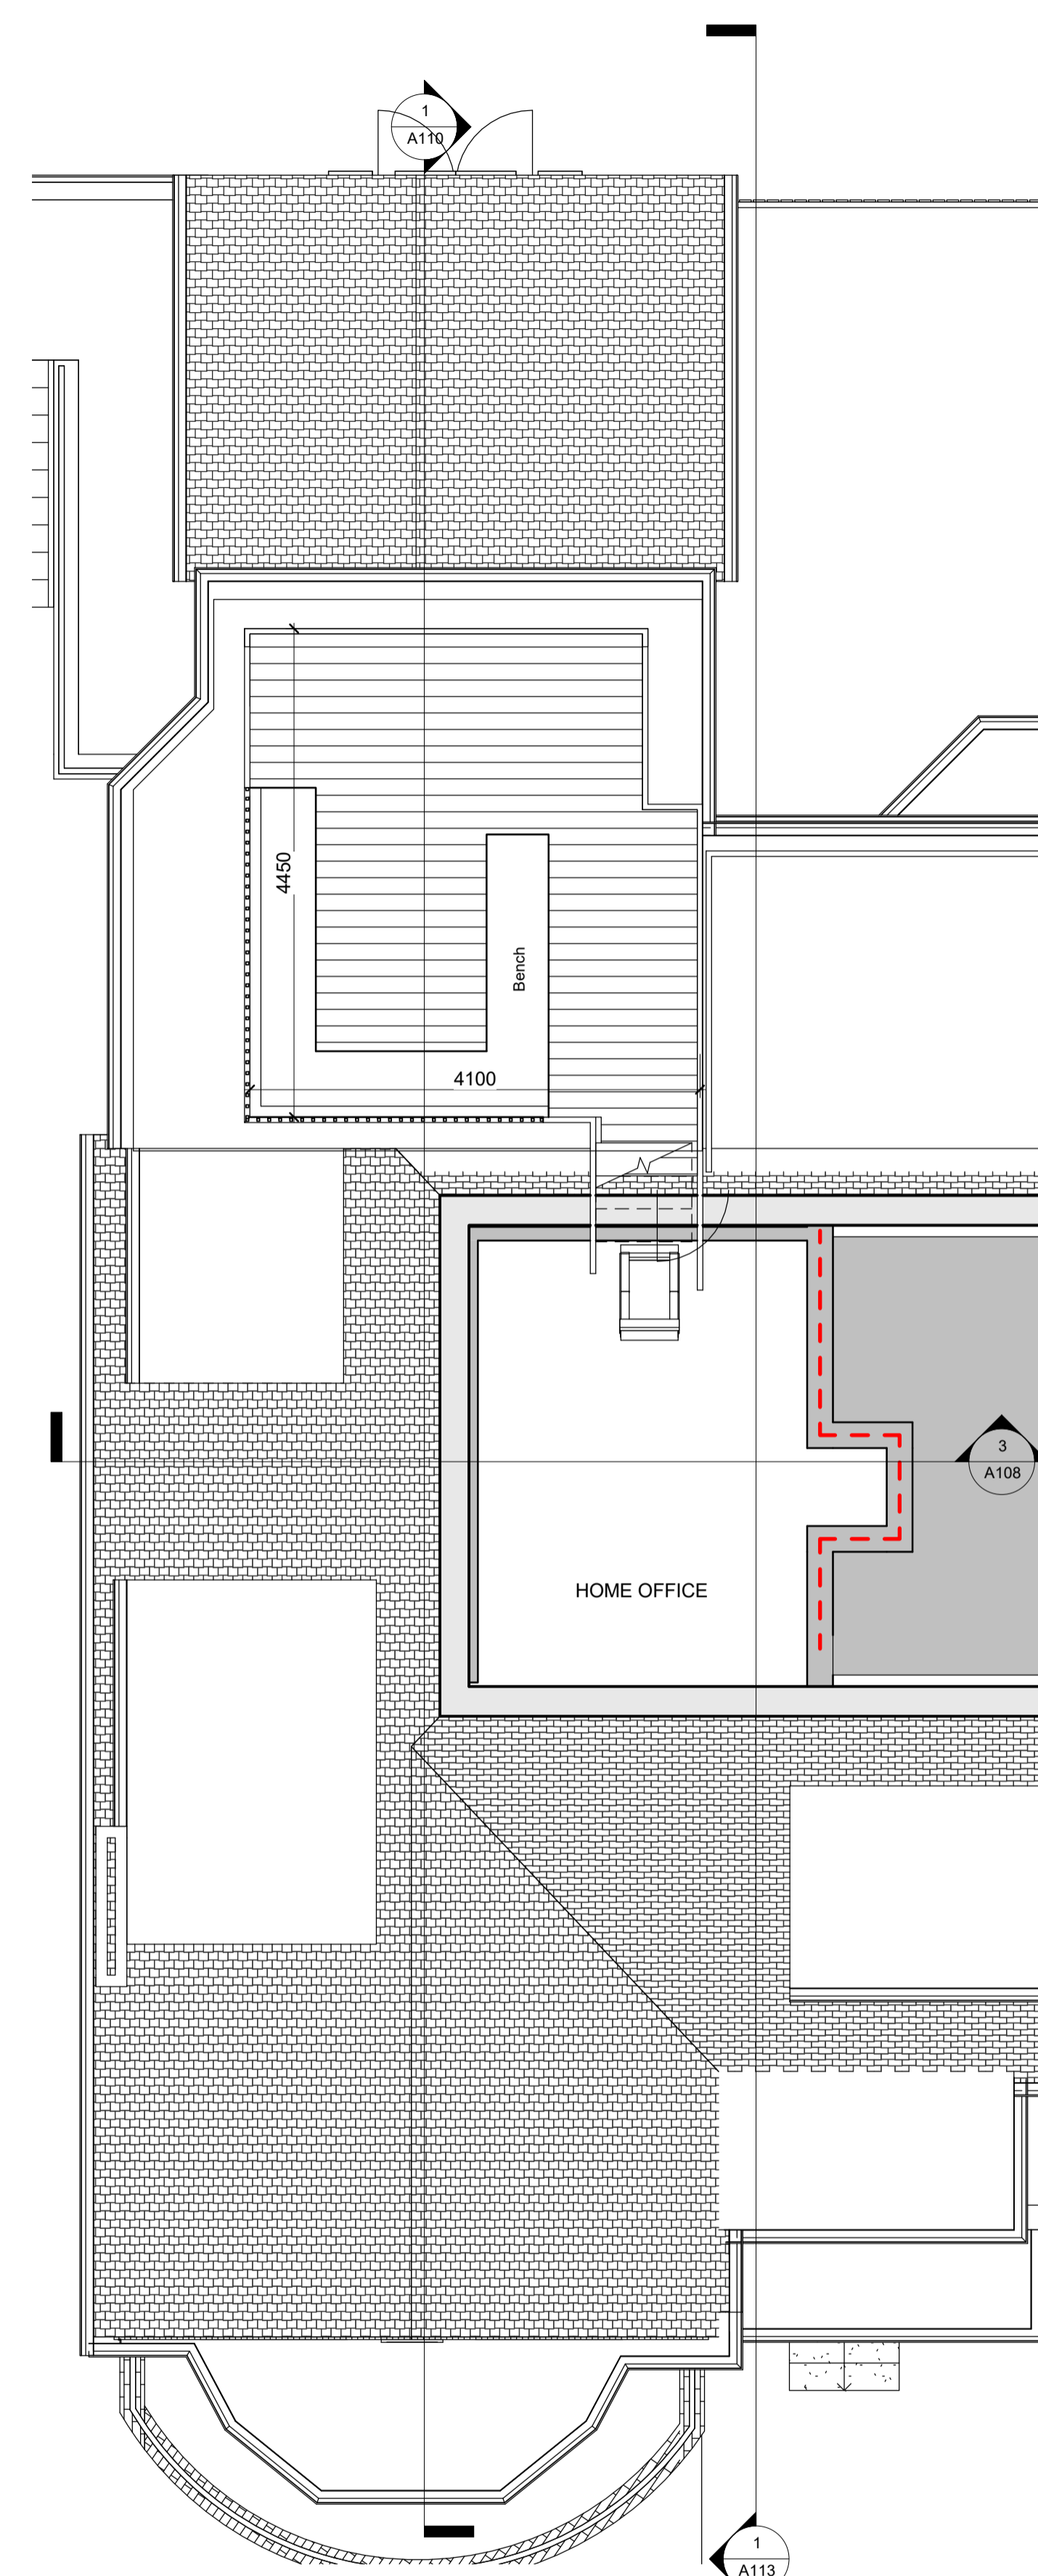


**PL - As-built - Loft**

SCALE: 1:50 @ A1  
1:100 @ A3

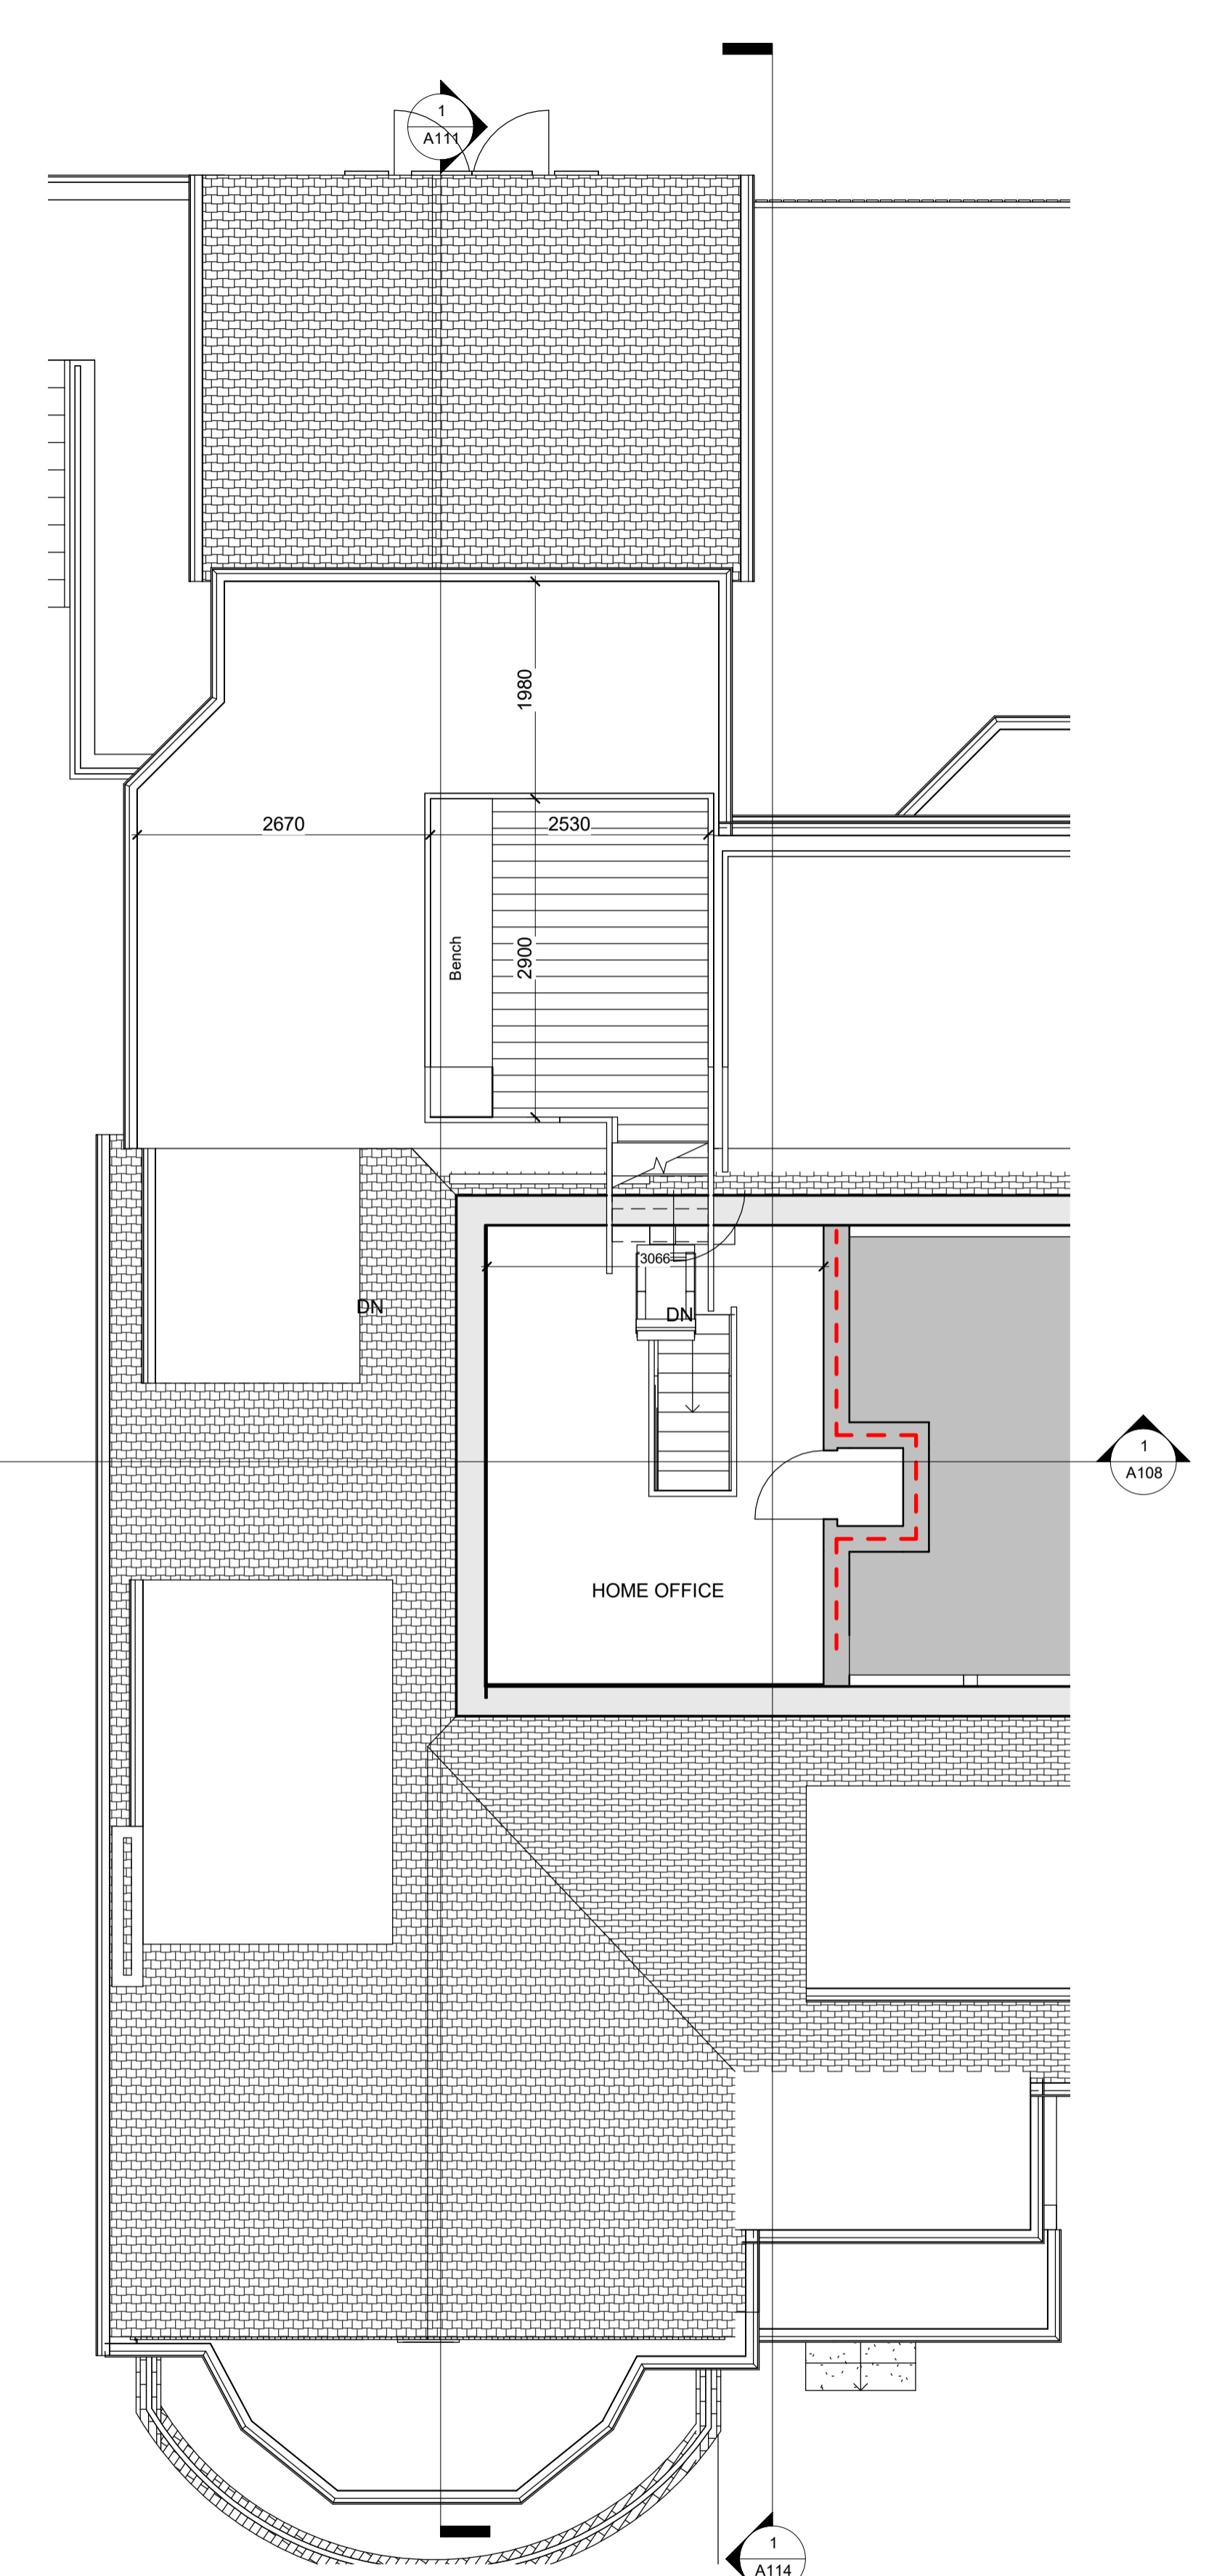

**PL - Proposed Loft**

SCALE: 1:50 @ A1  
1:100 @ A3

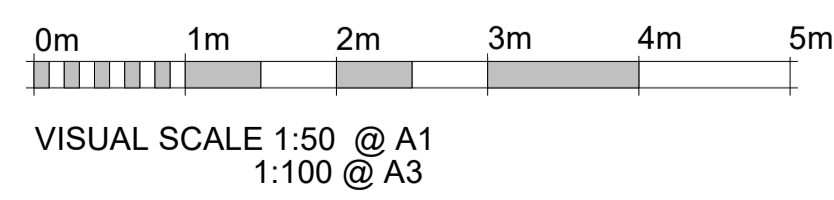

Dimensions

Written dimensions to be taken in preference to scaled dimensions. The Contractor is responsible for checking all dimensions before work starts.

Local Authority

All work is to be carried out to the requirements, and to the satisfaction of the Local Authority. These drawings are for planning purposes only.



**RPR PLANNING**  
Office 5, 37 Stanmore Hill  
London, HA7 3DS.  
Tel: Mobile: 078 9661 7854  
Web: www.rprplanning.co.uk  
Email: info@rprplanning.co.uk

Rev	Date	Description	Made	Checked
-	-	-	-	-


Drawing Status: **FOR APPROVAL**

Project  
**3 ROSECROFT AVENUE**

Client  
**GAURANG AMIN**



Drawing Title  
**PRE-EXISTING, AS-BUILT AND PROPOSED LOFT FLOOR AND ROOF PLANS**

Drawn/Design	Date
AS SHOWN @ A1	12/04/18
Drawing No	Rev
A101	-

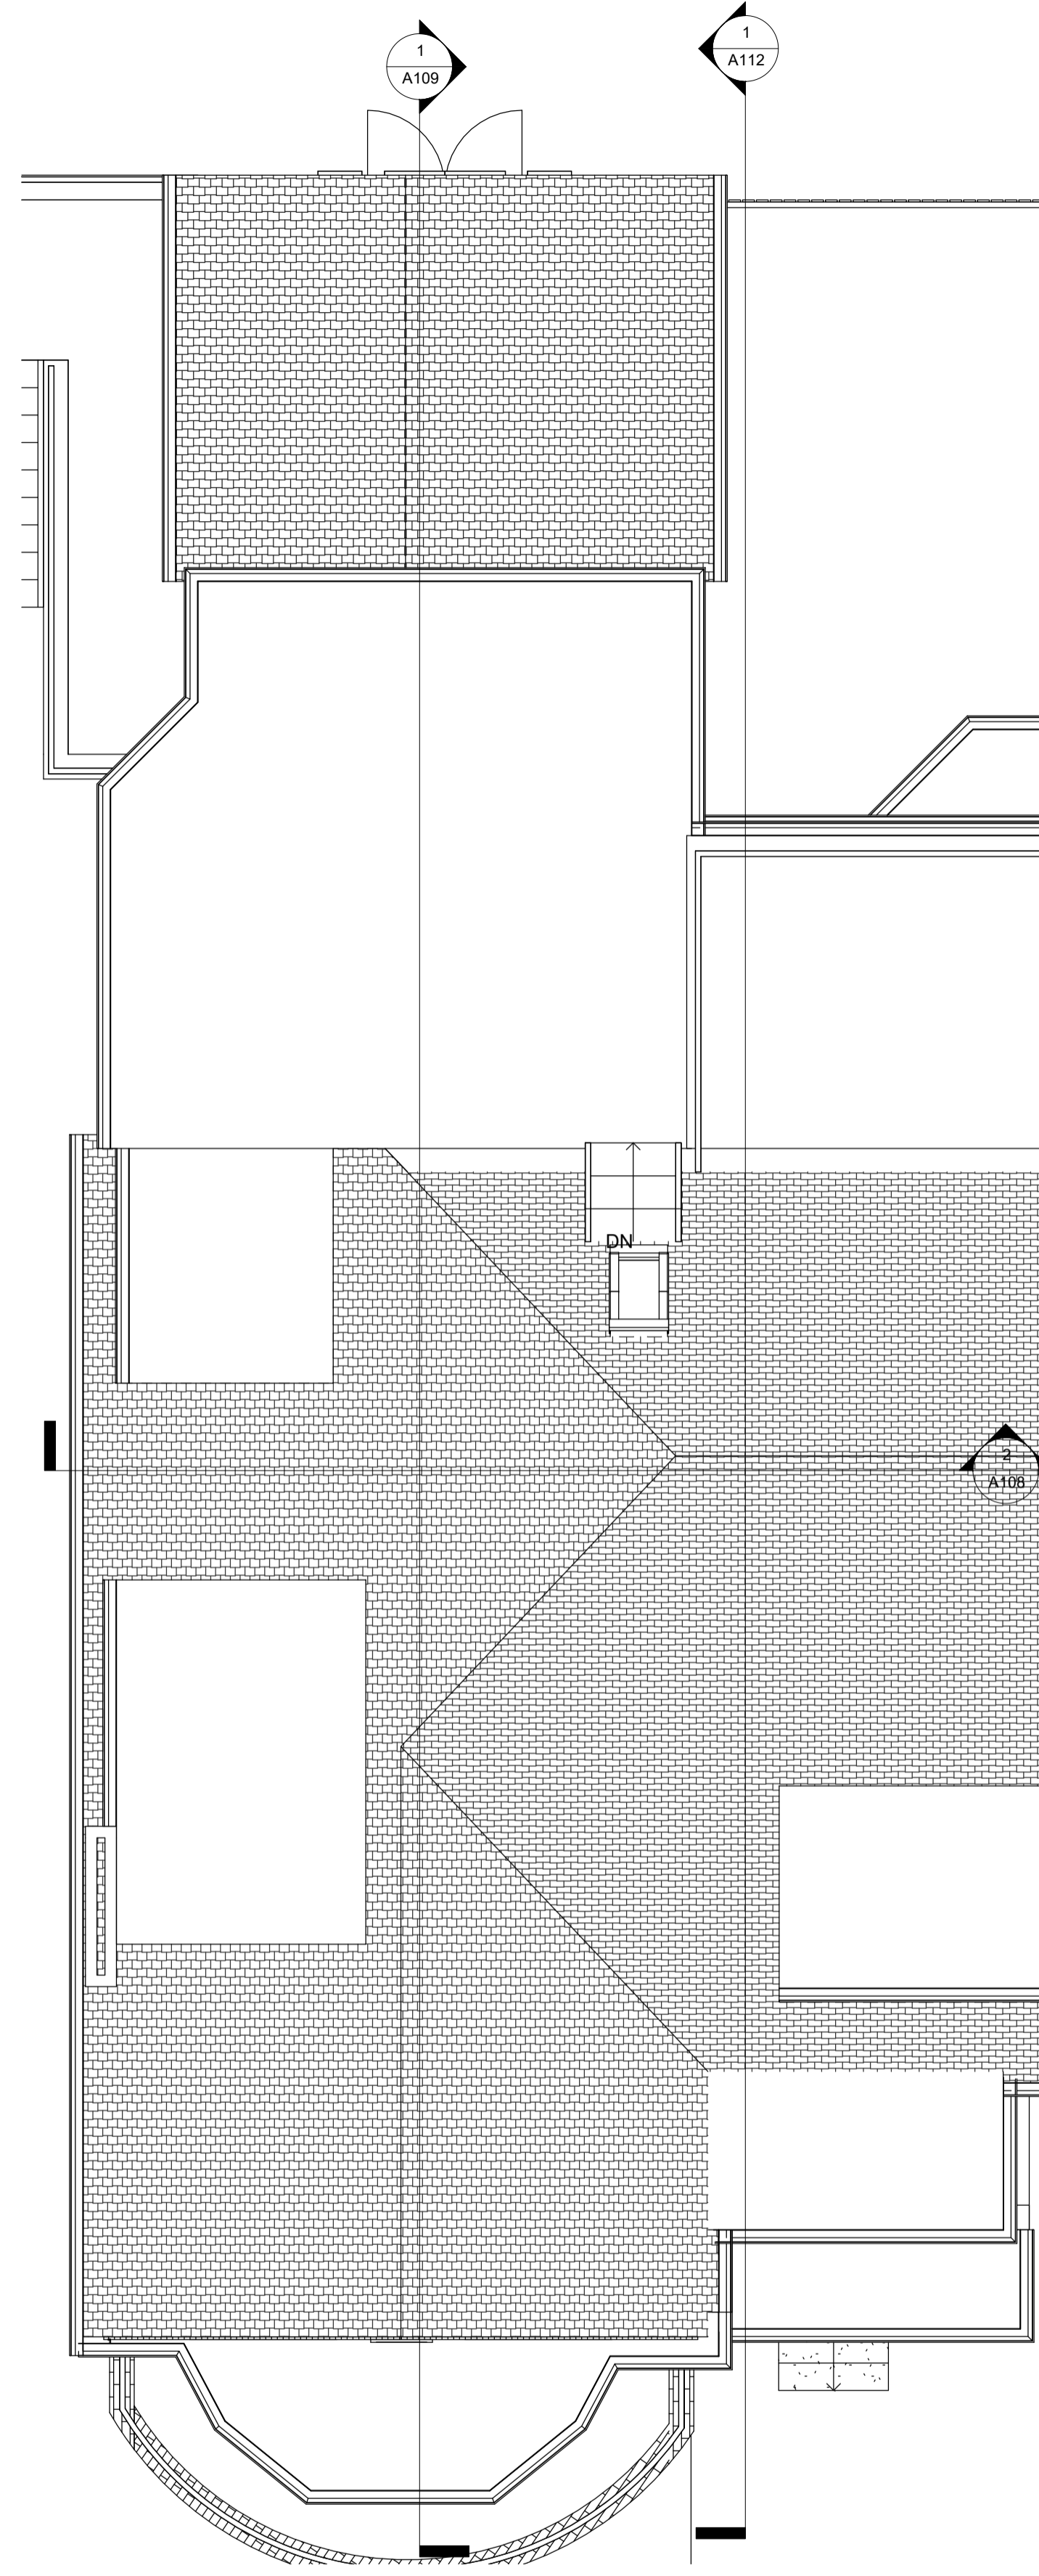


**PL - Existing Roof**

SCALE: 1 : 50 @ A1  
1 : 100 @ A3

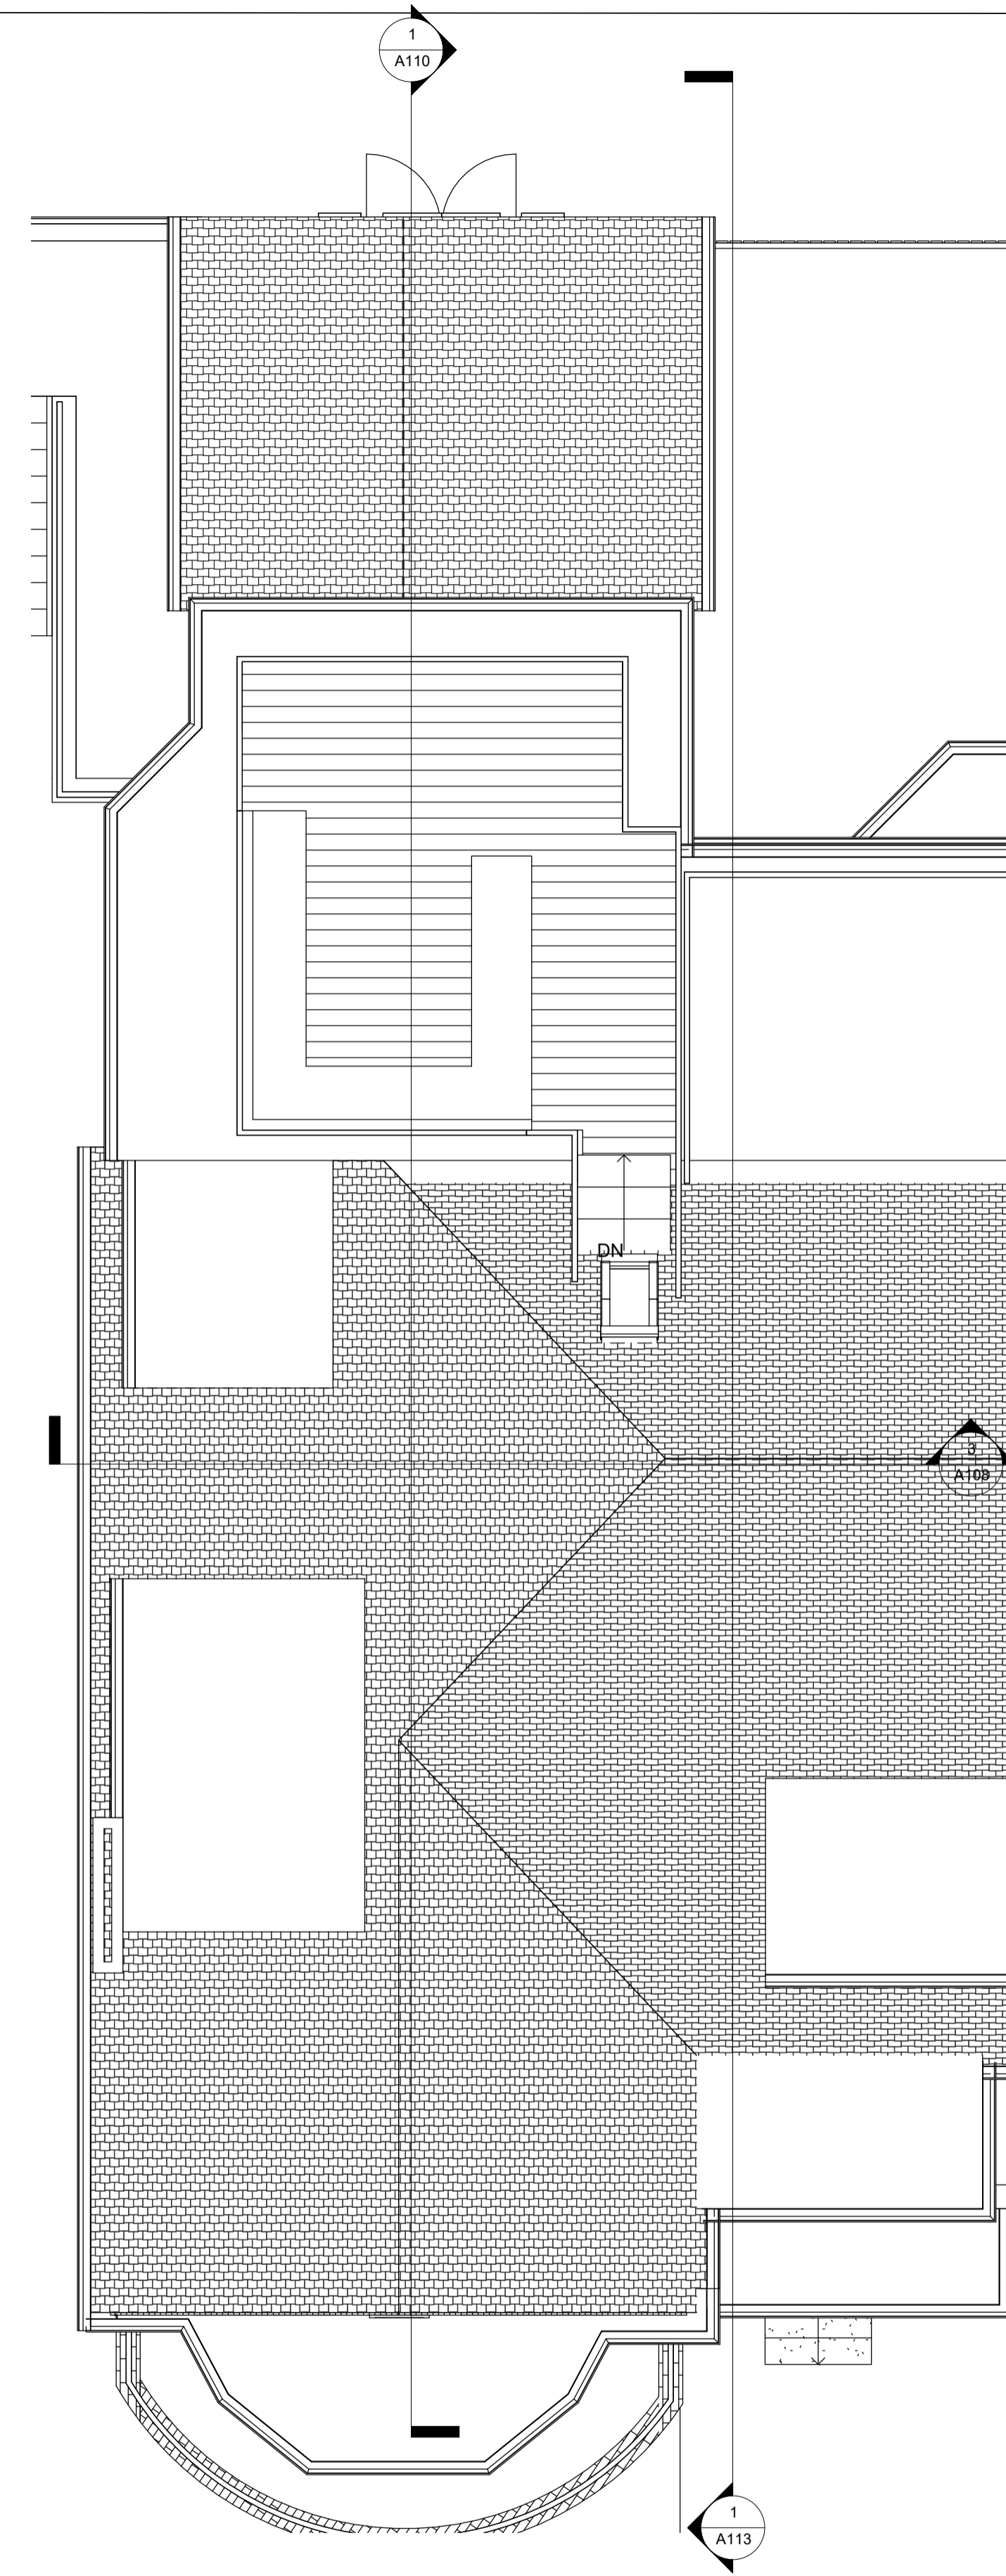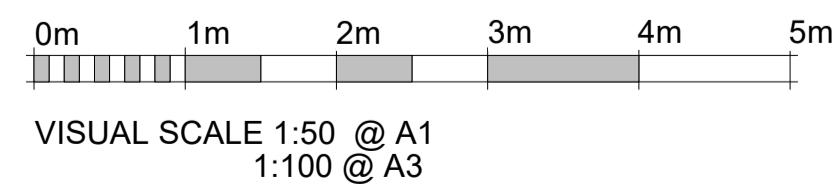

**PL - As-built - Roof**

SCALE: 1 : 50 @ A1  
1 : 100 @ A3

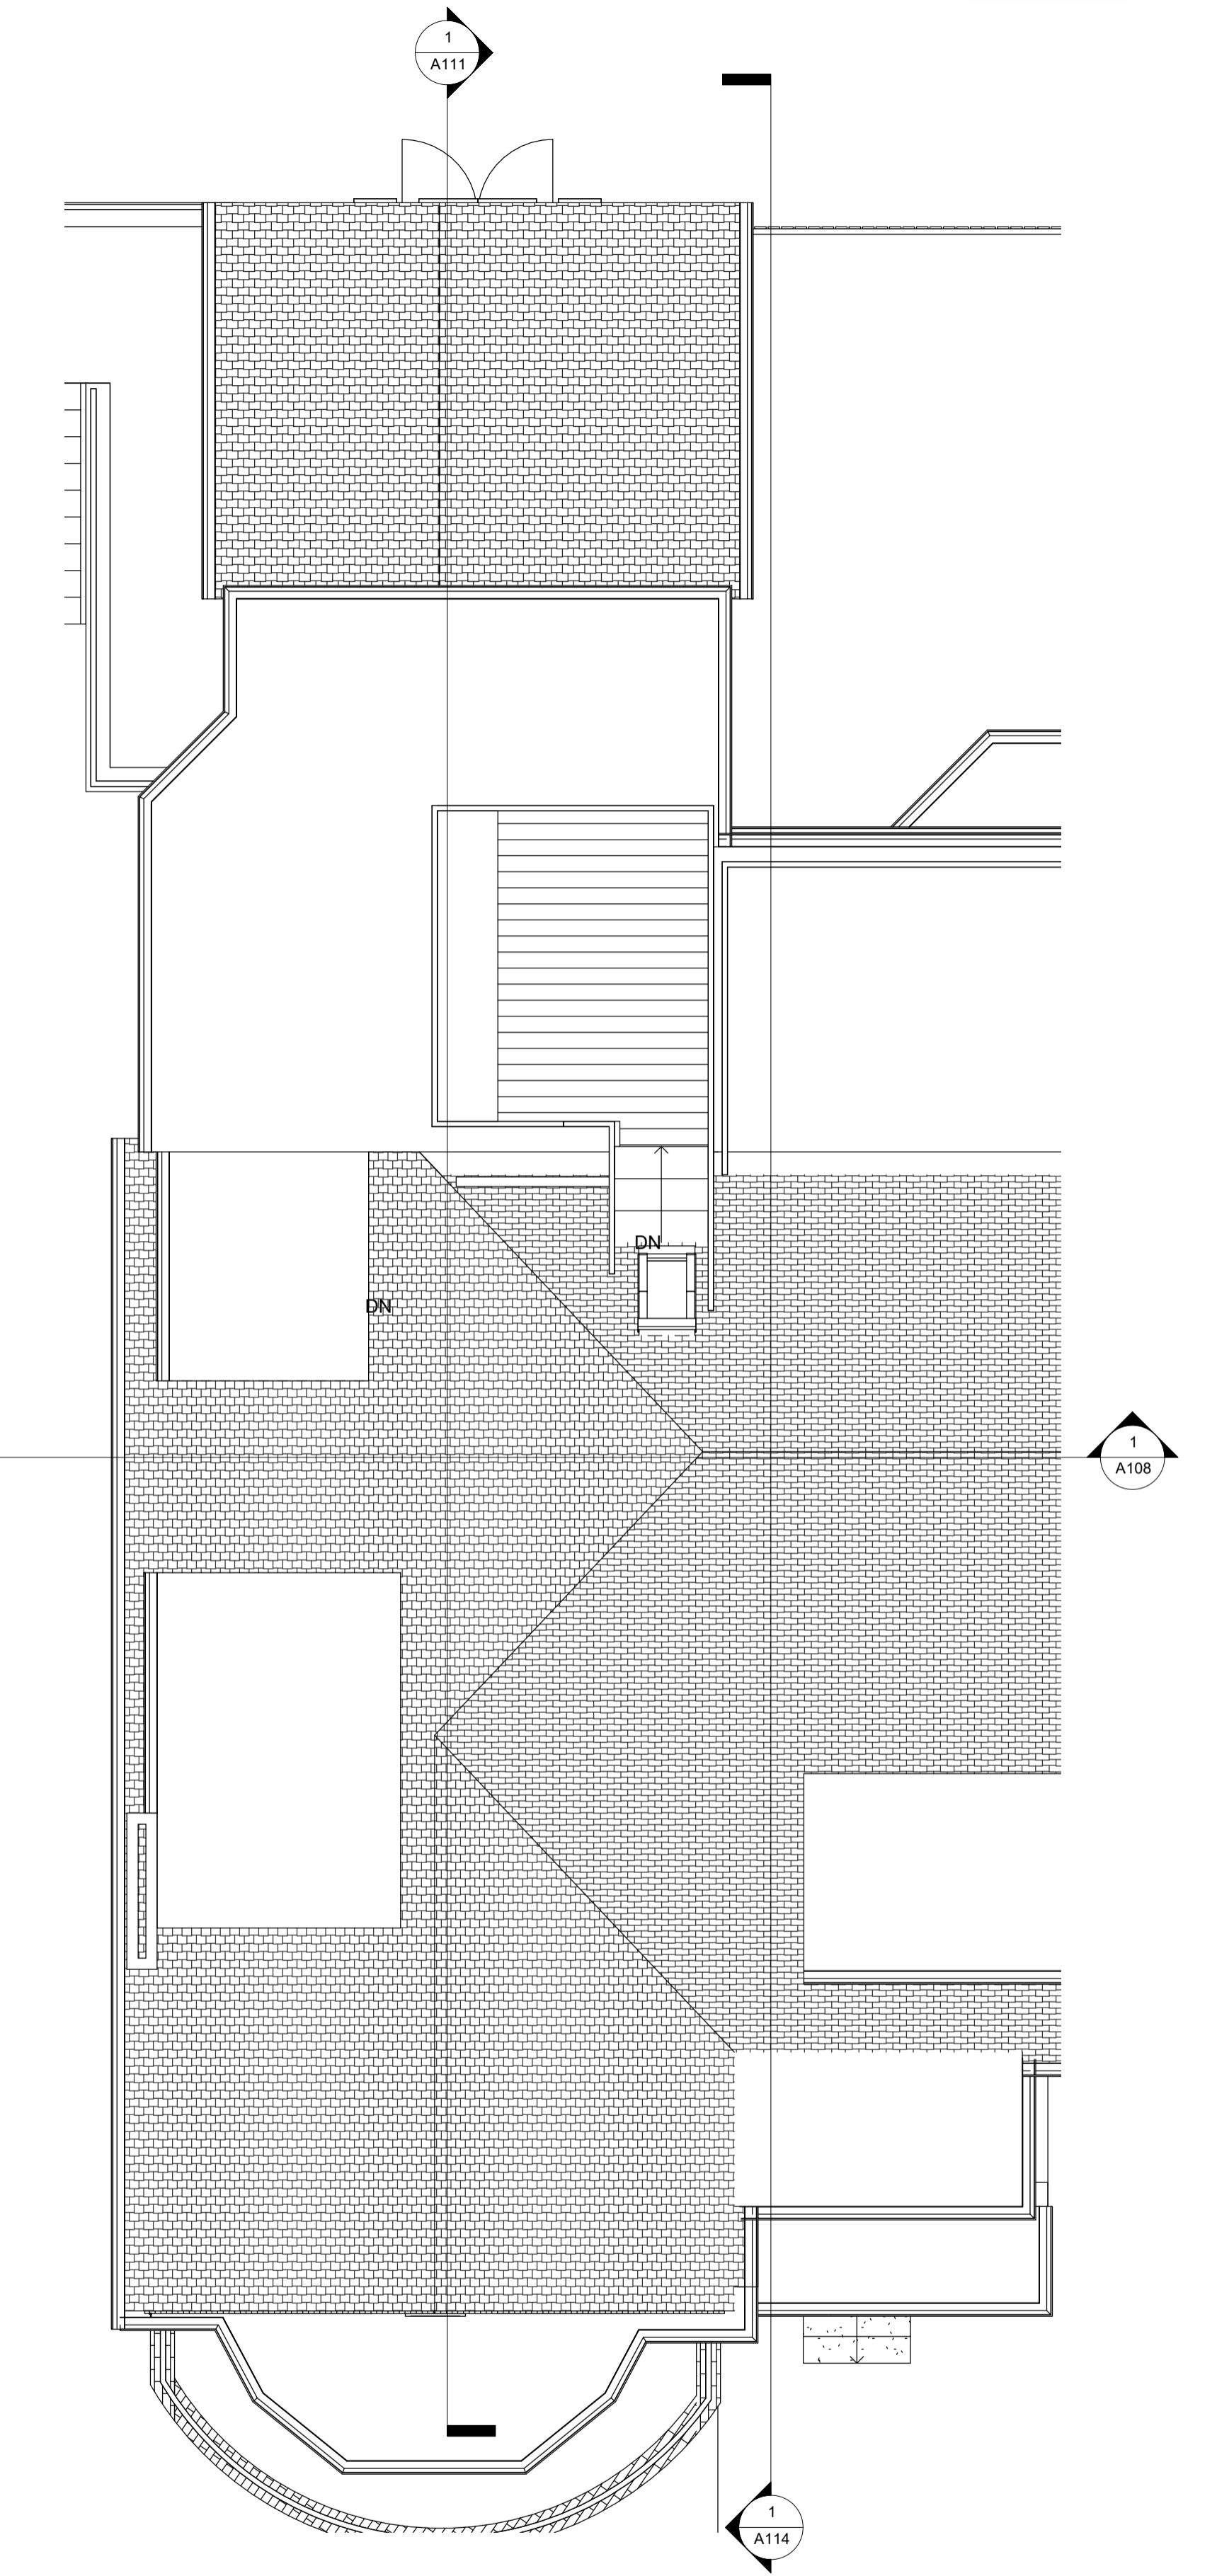

**PL - Proposed Roof**

SCALE: 1 : 50 @ A1  
1 : 100 @ A3

**Dimensions**  
Written dimensions to be taken in preference to scaled dimensions. The Contractor is responsible for checking all dimensions before work starts.

**Local Authority**  
All work is to be carried out to the requirements, and to the satisfaction of the Local Authority. These drawings are for planning purposes only.



**RPR PLANNING**  
Office 5, 37 Stanmore Hill  
London, HA7 3DS.  
Tel: 078 9661 7854  
Web: www.rprplanning.co.uk  
Email: info@rprplanning.co.uk

Rev	Date	Description	Made	Checked

Drawing Status: **FOR APPROVAL**

Project  
**3 ROSECROFT AVENUE**

Client  
**GAURANG AMIN**

Drawing Title  
**PRE-EXISTING, AS-BUILT AND PROPOSED ROOF PLANS**

Drawn/Design	Date
	12/06/18
Scales:	Rev
AS SHOWN @ A1	
Drawing No	
A102	



**Pre-Existing front elevation**

SCALE: 1:75 @ A1  
1:150 @ A3




**As-built - Front elevation**

SCALE: 1:75 @ A1  
1:150 @ A3



**Proposed Front elevation**

SCALE: 1:75 @ A1  
1:150 @ A3

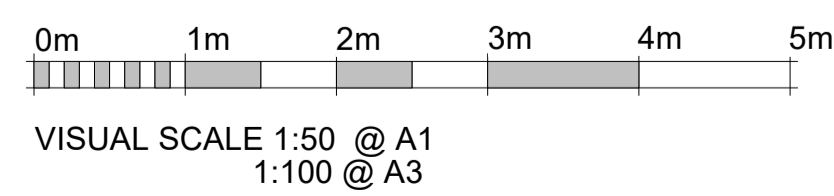

**Dimensions**

Written dimensions to be taken in preference to scaled dimensions. The Contractor is responsible for checking all dimensions before work starts.

**Local Authority**

All work is to be carried out to the requirements, and to the satisfaction of the Local Authority. These drawings are for planning purposes only.



**RPR PLANNING**  
Office 5, 37 Stanmore Hill  
London, HA7 3DS.  
Tel:  
Mobile: 078 9661 7854  
Web: www.rprplanning.co.uk  
Email: info@rprplanning.co.uk

Rev	Date	Description	Made	Checked
-				

Drawing Status: **FOR APPROVAL**

Project  
**3 ROSECROFT AVENUE**

Client  
**GAURANG AMIN**

Drawing Title  
**PRE-EXISTING, AS-BUILT AND PROPOSED FRONT ELEVATIONS**

Drawn/Design	Date
	12/04/18
Scales:	Rev
AS SHOWN @ A1	-
Drawing No	Rev
A103	-




**Pre-Existing rear elevation**  
 SCALE: 1 : 75 @ A1  
 1 : 150 @ A3



**As-built - rear elevation**  
 SCALE: 1 : 75 @ A1  
 1 : 150 @ A3



**Proposed rear elevation**  
 SCALE: 1 : 75 @ A1  
 1 : 150 @ A3

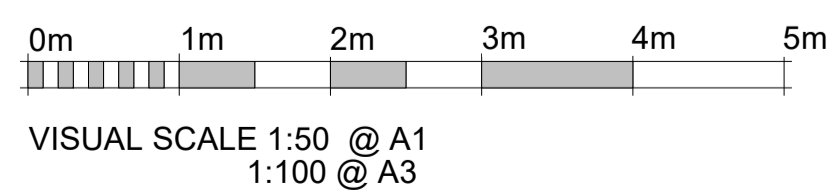

**Dimensions**

Written dimensions to be taken in preference to scaled dimensions. The Contractor is responsible for checking all dimensions before work starts.

**Local Authority**

All work is to be carried out to the requirements, and to the satisfaction of the Local Authority. These drawings are for planning purposes only.



**RPR PLANNING**  
 Office 5, 37 Stanmore Hill  
 London, HA7 3DS.  
 Tel:  
 Mobile: 078 9661 7854  
 Web: www.rprplanning.co.uk  
 Email: info@rprplanning.co.uk

Rev	Date	Description	Made	Checked
-				

Drawing Status: **FOR APPROVAL**

Project  
**3 ROSECROFT AVENUE**

Client  
**GAURANG AMIN**


Drawing Title  
**PRE-EXISTING, AS-BUILT AND PROPOSED REAR ELEVATIONS**

Drawn/Design	Date
Scales: AS SHOWN @ A1	12/04/18
Drawing No <b>A104</b>	Rev -



**Pre-Existing side elevation**

SCALE: 1 : 50 @ A1  
1 : 100 @ A3

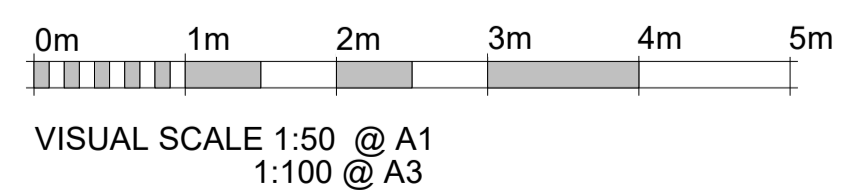

**Dimensions** Written dimensions to be taken in preferences to scaled dimensions. The Contractor is responsible for checking all dimensions before work starts.

**Local Authority** All work is to be carried out to the requirements, and to the satisfaction of the Local Authority. These drawings are for planning purposes only.



**RPR PLANNING**  
Office 5, 37 Stanmore Hill  
London, HA7 3DS.  
Tel: Mobile: 078 9661 7854  
Web: www.rprplanning.co.uk  
Email: info@rprplanning.co.uk

Rev	Date	Description	Made	Checked
-				

Drawing Status: **FOR APPROVAL**

Project  
**3 ROSECROFT AVENUE**


Client  
**GAURANG AMIN**

Drawing Title  
**PRE-EXISTING SIDE ELEVATION**

Drawn/Design	Date
AS SHOWN @ A1	12/06/18
Drawing No	Rev
A105	-



**As-built - side elevation**  
 SCALE: 1 : 50 @ A1  
 1 : 100 @ A3

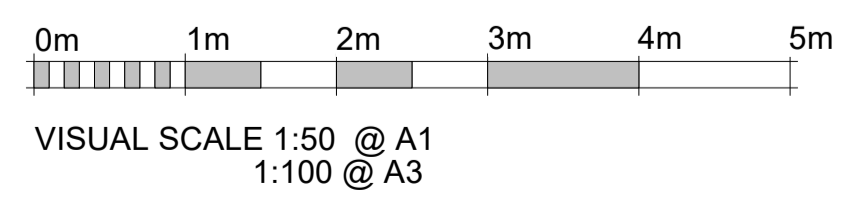

**Dimensions** Written dimensions to be taken in preferences to scaled dimensions. The Contractor is responsible for checking all dimensions before work starts.

**Local Authority** All work is to be carried out to the requirements, and to the satisfaction of the Local Authority. These drawings are for planning purposes only.



**RPR PLANNING**  
 Office 5, 37 Stanmore Hill  
 London, HA7 3DS.  
 Tel: 078 9661 7854  
 Web: www.rprplanning.co.uk  
 Email: info@rprplanning.co.uk

Rev	Date	Description	Made	Checked
Drawing Status: <b>FOR APPROVAL</b>				

Project  
**3 ROSECROFT AVENUE**

Client  
**GAURANG AMIN**


Drawing Title  
**AS-BUILT SIDE ELEVATION**

Drawn/Design	Date
Scales: AS SHOWN @ A1	11/13/19
Drawing No <b>A106</b>	Rev



**Proposed side elevation**

SCALE: 1 : 50 @ A1  
1 : 100 @ A3

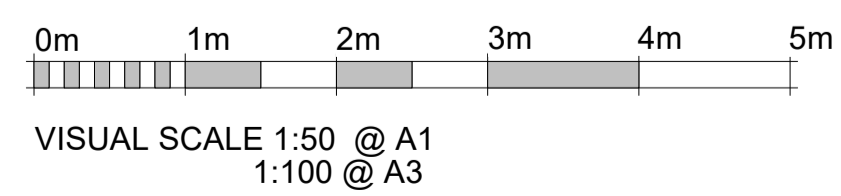

**Dimensions**  
Written dimensions to be taken in preferences to scaled dimensions. The Contractor is responsible for checking all dimensions before work starts.

**Local Authority**  
All work is to be carried out to the requirements, and to the satisfaction of the Local Authority. These drawings are for planning purposes only.



**RPR PLANNING**  
Office 5, 37 Stanmore Hill  
London, HA7 3DS.  
Tel: Mobile: 078 9661 7854  
Web: www.rprplanning.co.uk  
Email: info@rprplanning.co.uk

Rev	Date	Description	Made	Checked
-				

Drawing Status: **FOR APPROVAL**


Project  
**3 ROSECROFT AVENUE**

Client  
**GAURANG AMIN**

Drawing Title  
**PROPOSED SIDE ELEVATION**


Drawn/Design	Date
Scales: AS SHOWN @ A1	12/06/18
Drawing No <b>A107</b>	Rev -



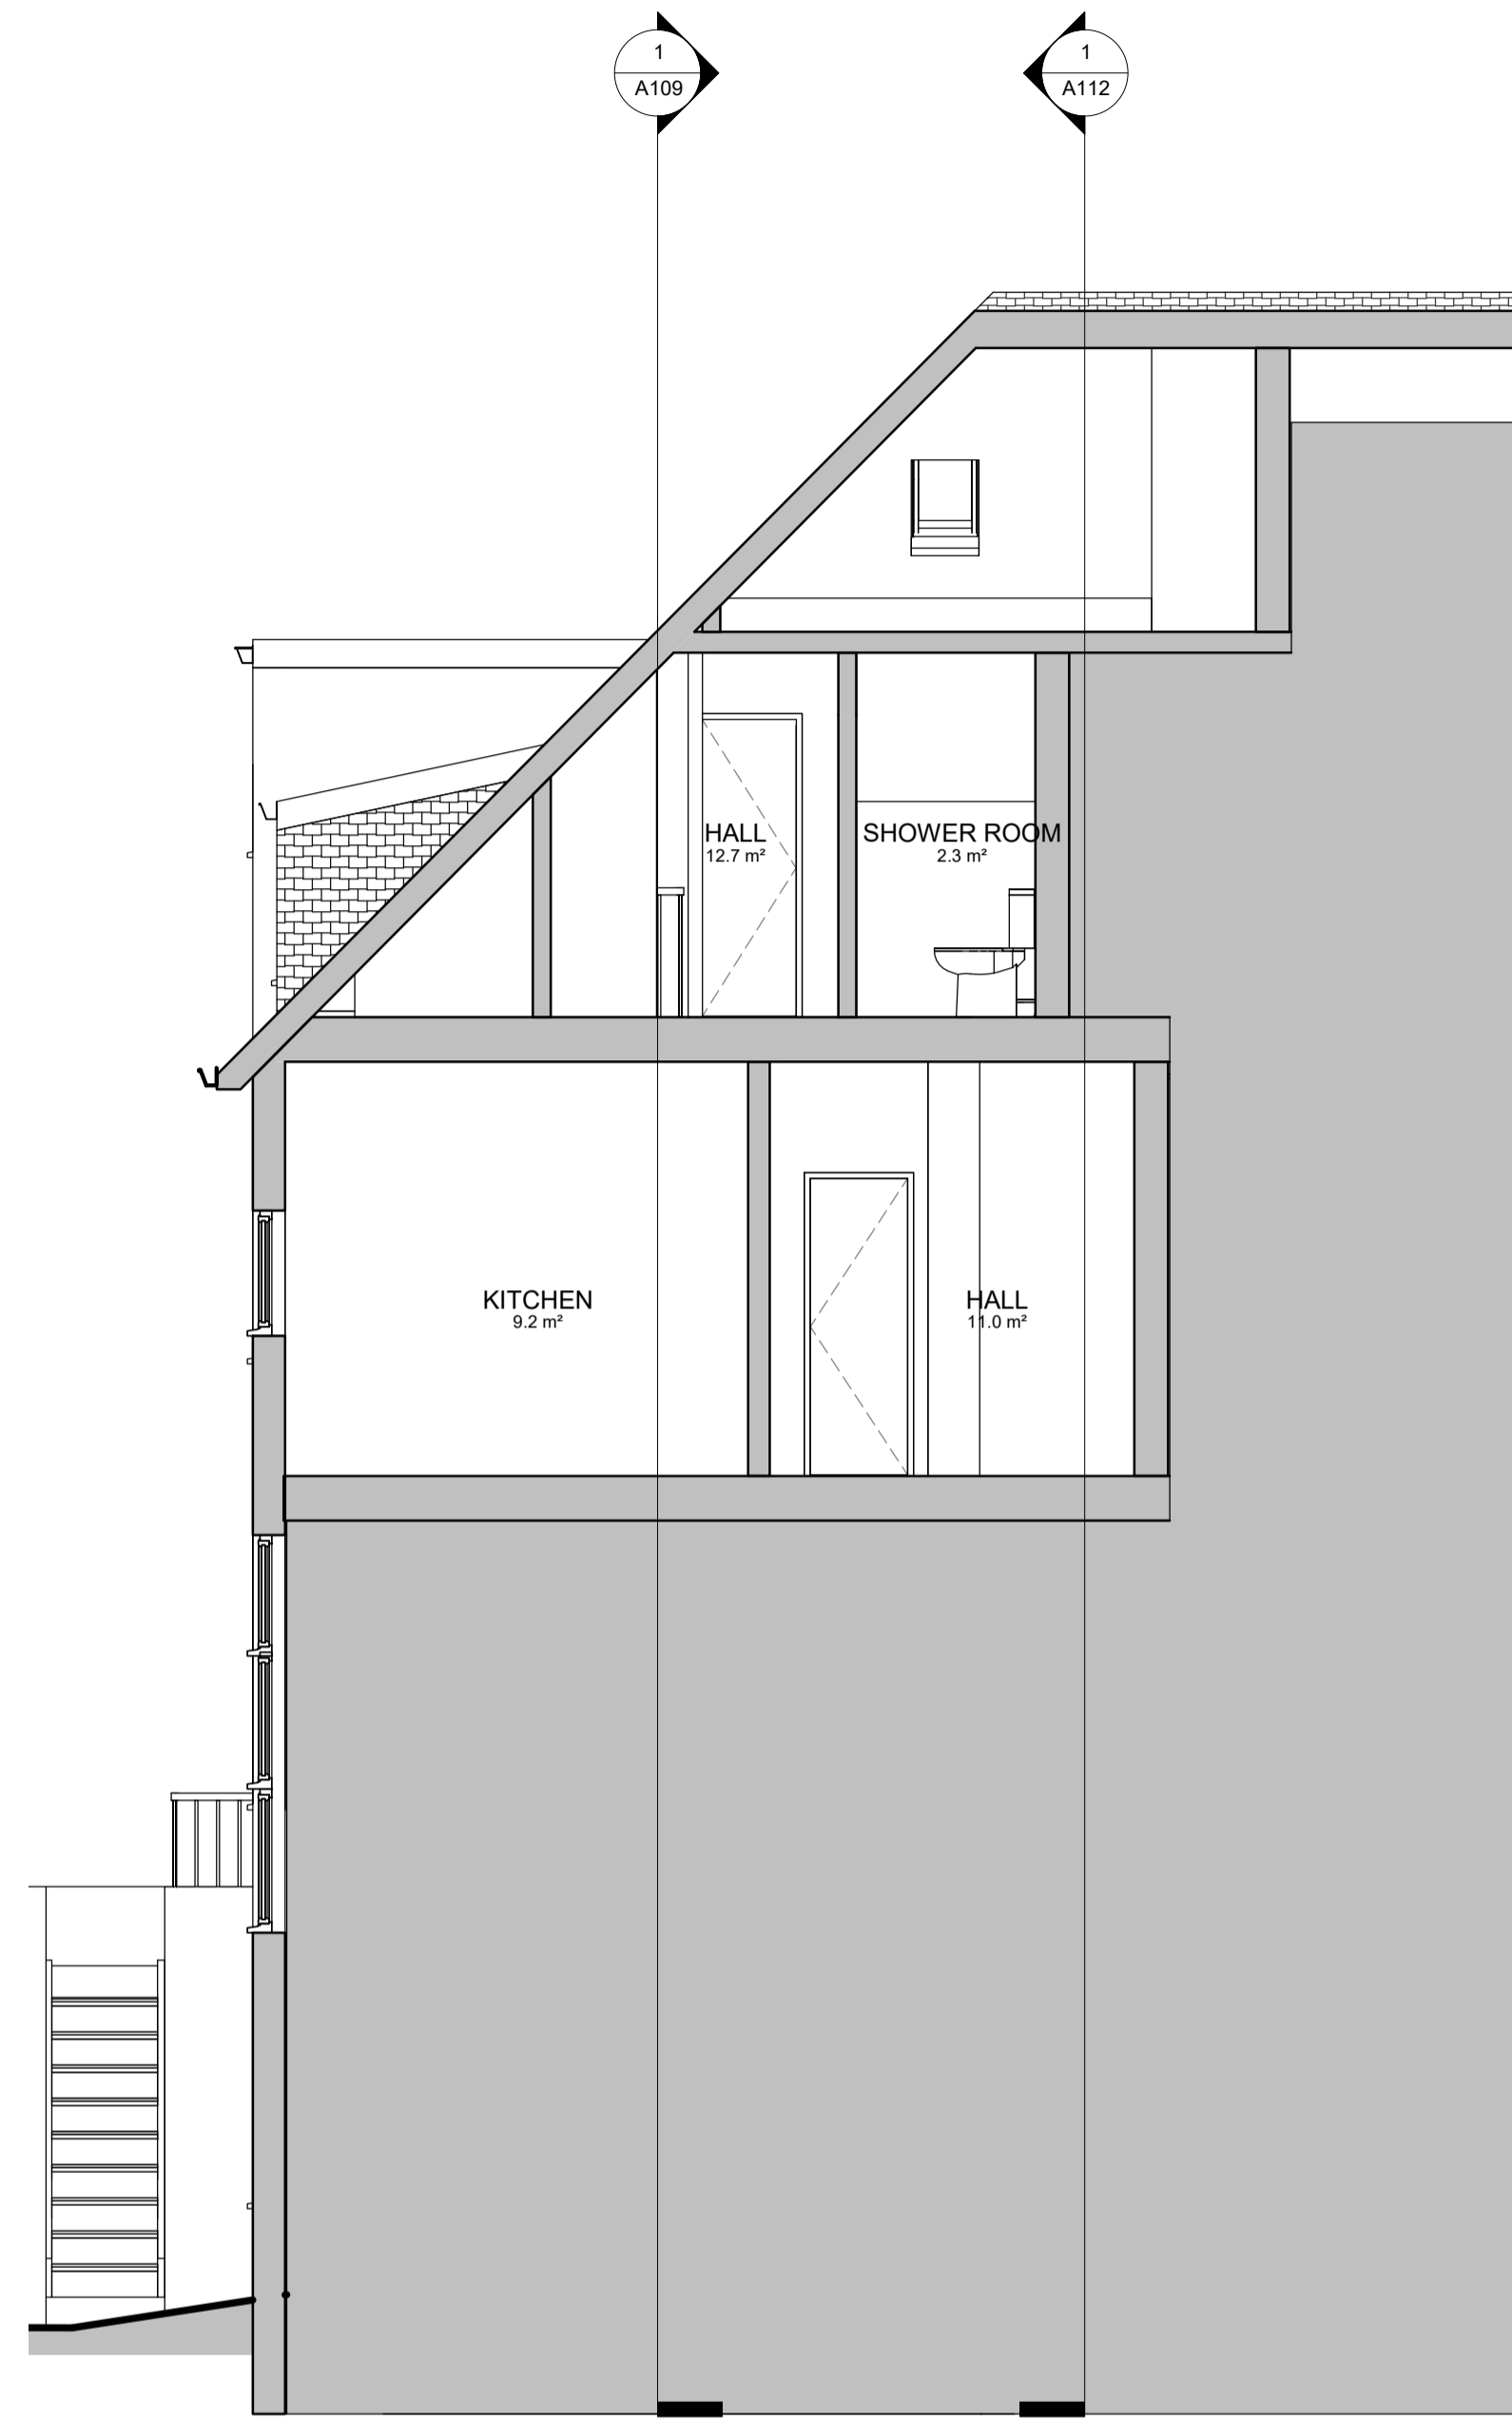


**Pre-Existing Section 2**

SCALE: 1 : 50 @ A1  
1 : 100 @ A3

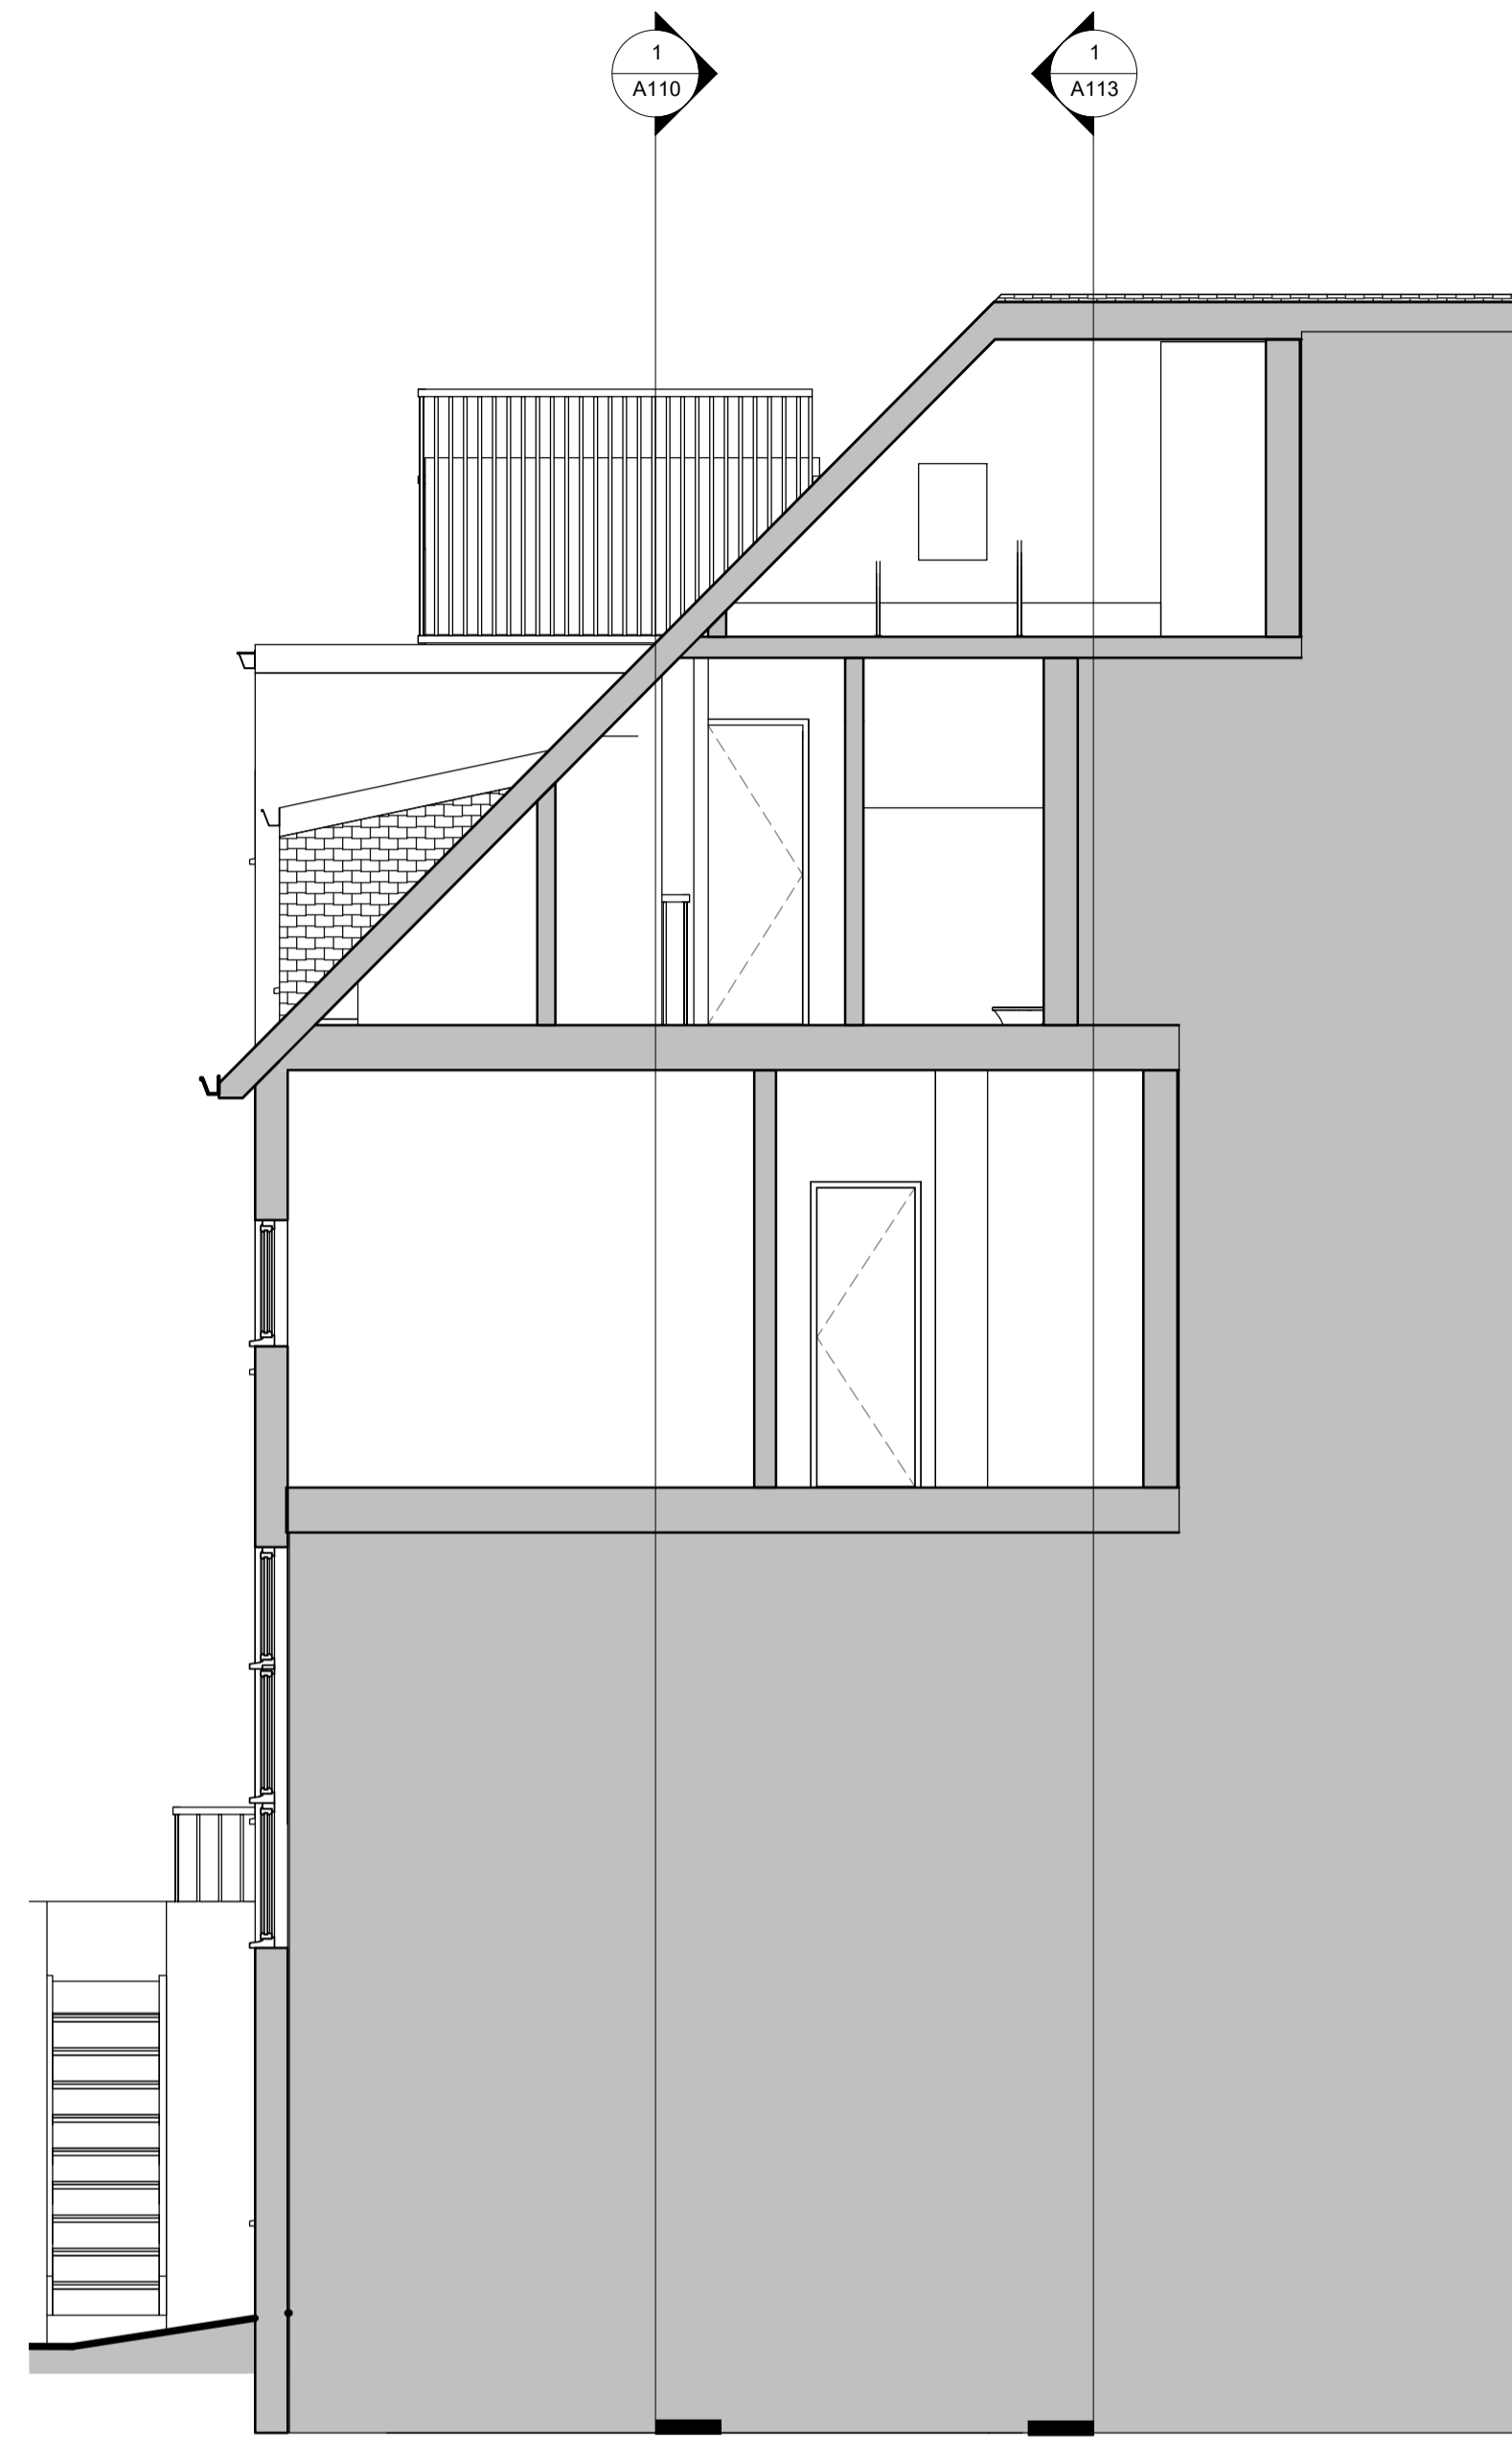


**As-built - Section 2**

SCALE: 1 : 50 @ A1  
1 : 100 @ A3

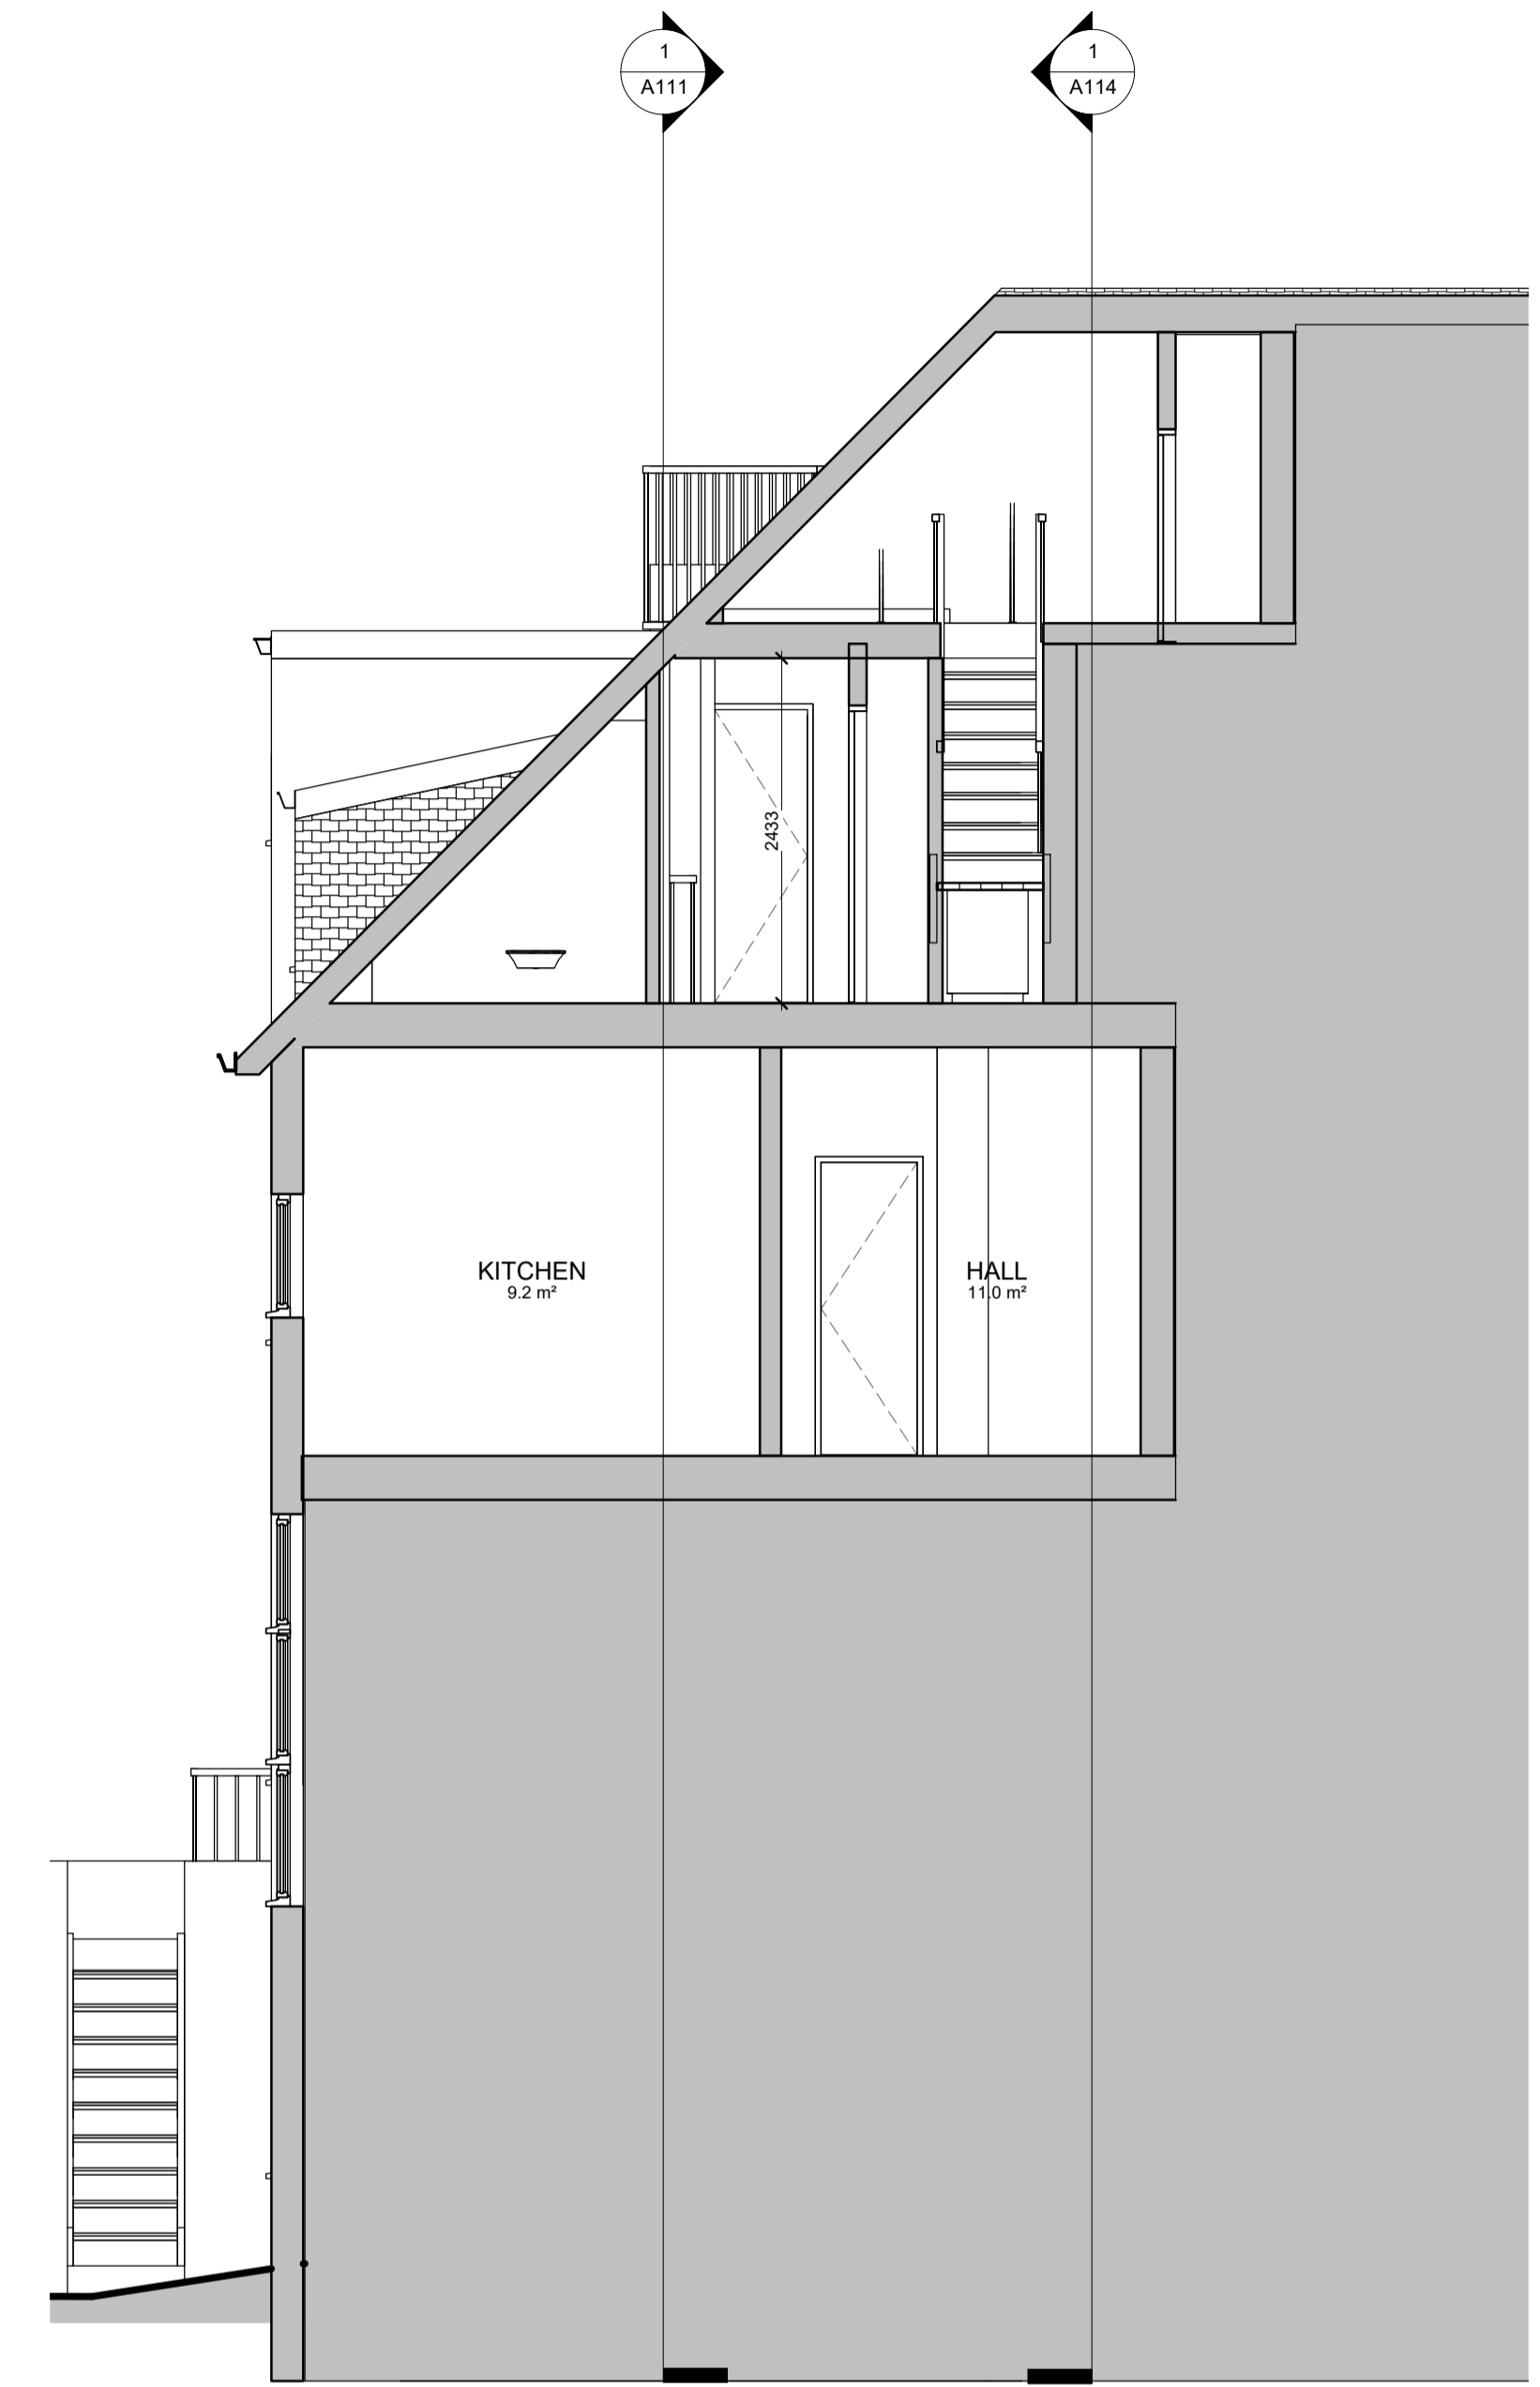

**Proposed Section 2**

SCALE: 1 : 50 @ A1  
1 : 100 @ A3

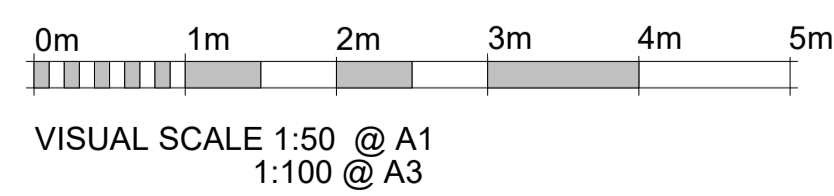

**Dimensions** Written dimensions to be taken in preference to scaled dimensions. The Contractor is responsible for checking all dimensions before work starts.

**Local Authority** All work is to be carried out to the requirements, and to the satisfaction of the Local Authority. These drawings are for planning purposes only.




**RPR PLANNING**  
Office 5, 37 Stanmore Hill  
London, HA7 3DS.  
Tel: 020 8996 1754  
Mobile: 078 9661 7854  
Web: www.rprplanning.co.uk  
Email: info@rprplanning.co.uk

Rev	Date	Description	Made	Checked
-				

Drawing Status: **FOR APPROVAL**


Project	<b>3 ROSECROFT AVENUE</b>		
Client	<b>GAURANG AMIN</b>		

Drawing Title			
<b>PRE-EXISTING, AS-BUILT AND PROPOSED SECTION 2</b>			
Drawn/Design		Date	12/06/18
Scales:	AS SHOWN @ A1	Drawing No	<b>A108</b>
Rev			-

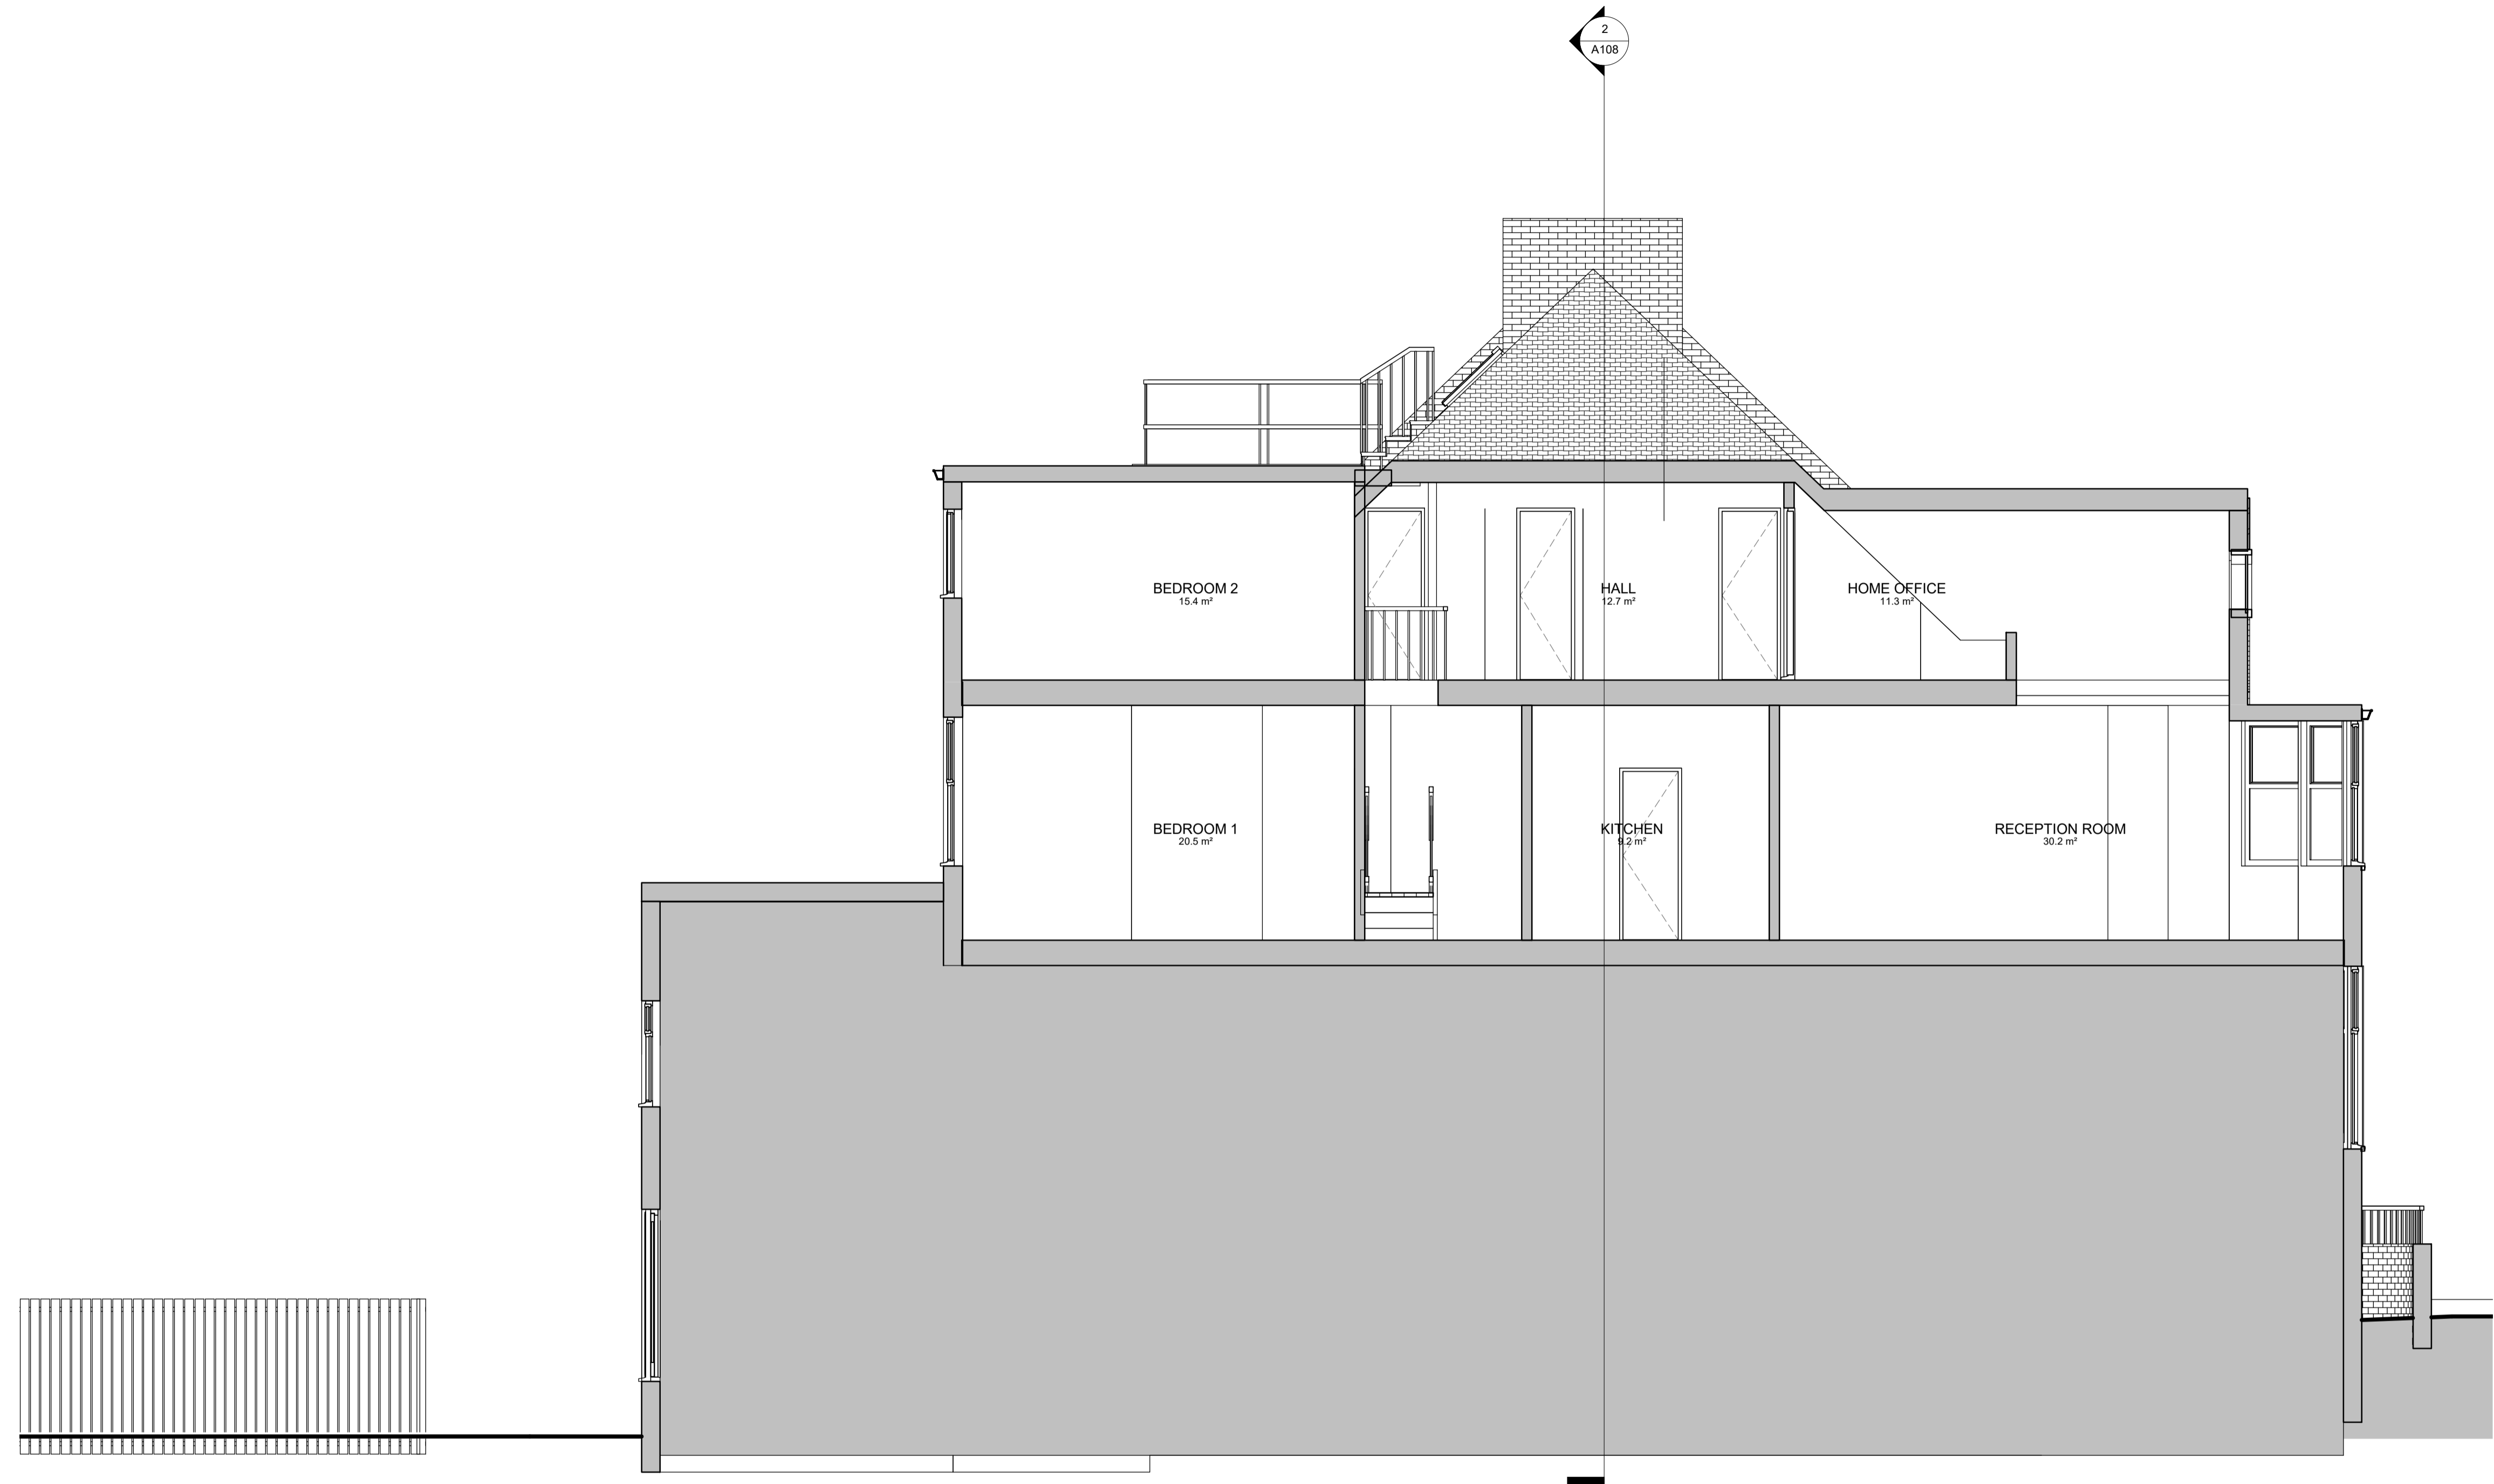


**Pre-Existing section 1**


SCALE: 1 : 50 @ A1  
1 : 100 @ A3

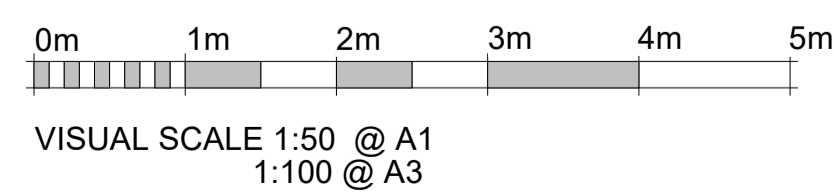

<p>Dimensions</p> <p>Written dimensions to be taken in preferences to scaled dimensions. The Contractor is responsible for checking all dimensions before work starts.</p>	 <p>RPR PLANNING Office 5, 37 Stanmore Hill London, HA7 3DS. Tel: 078 9661 7854 Web: www.rprplanning.co.uk Email: info@rprplanning.co.uk</p>	Project	3 ROSECROFT AVENUE		Drawing Title	PRE-EXISTING SECTION 1	
		Client	GAURANG AMIN		Drawn/Design	Date	12/06/18
Local Authority	All work is to be carried out to the requirements, and to the satisfaction of the Local Authority. These drawings are for planning purposes only.	Rev	Date	Description	Made	Checked	Rev
Drawing Status: <b>FOR APPROVAL</b>						Scales: AS SHOWN @ A1	
				Drawing No		A109	

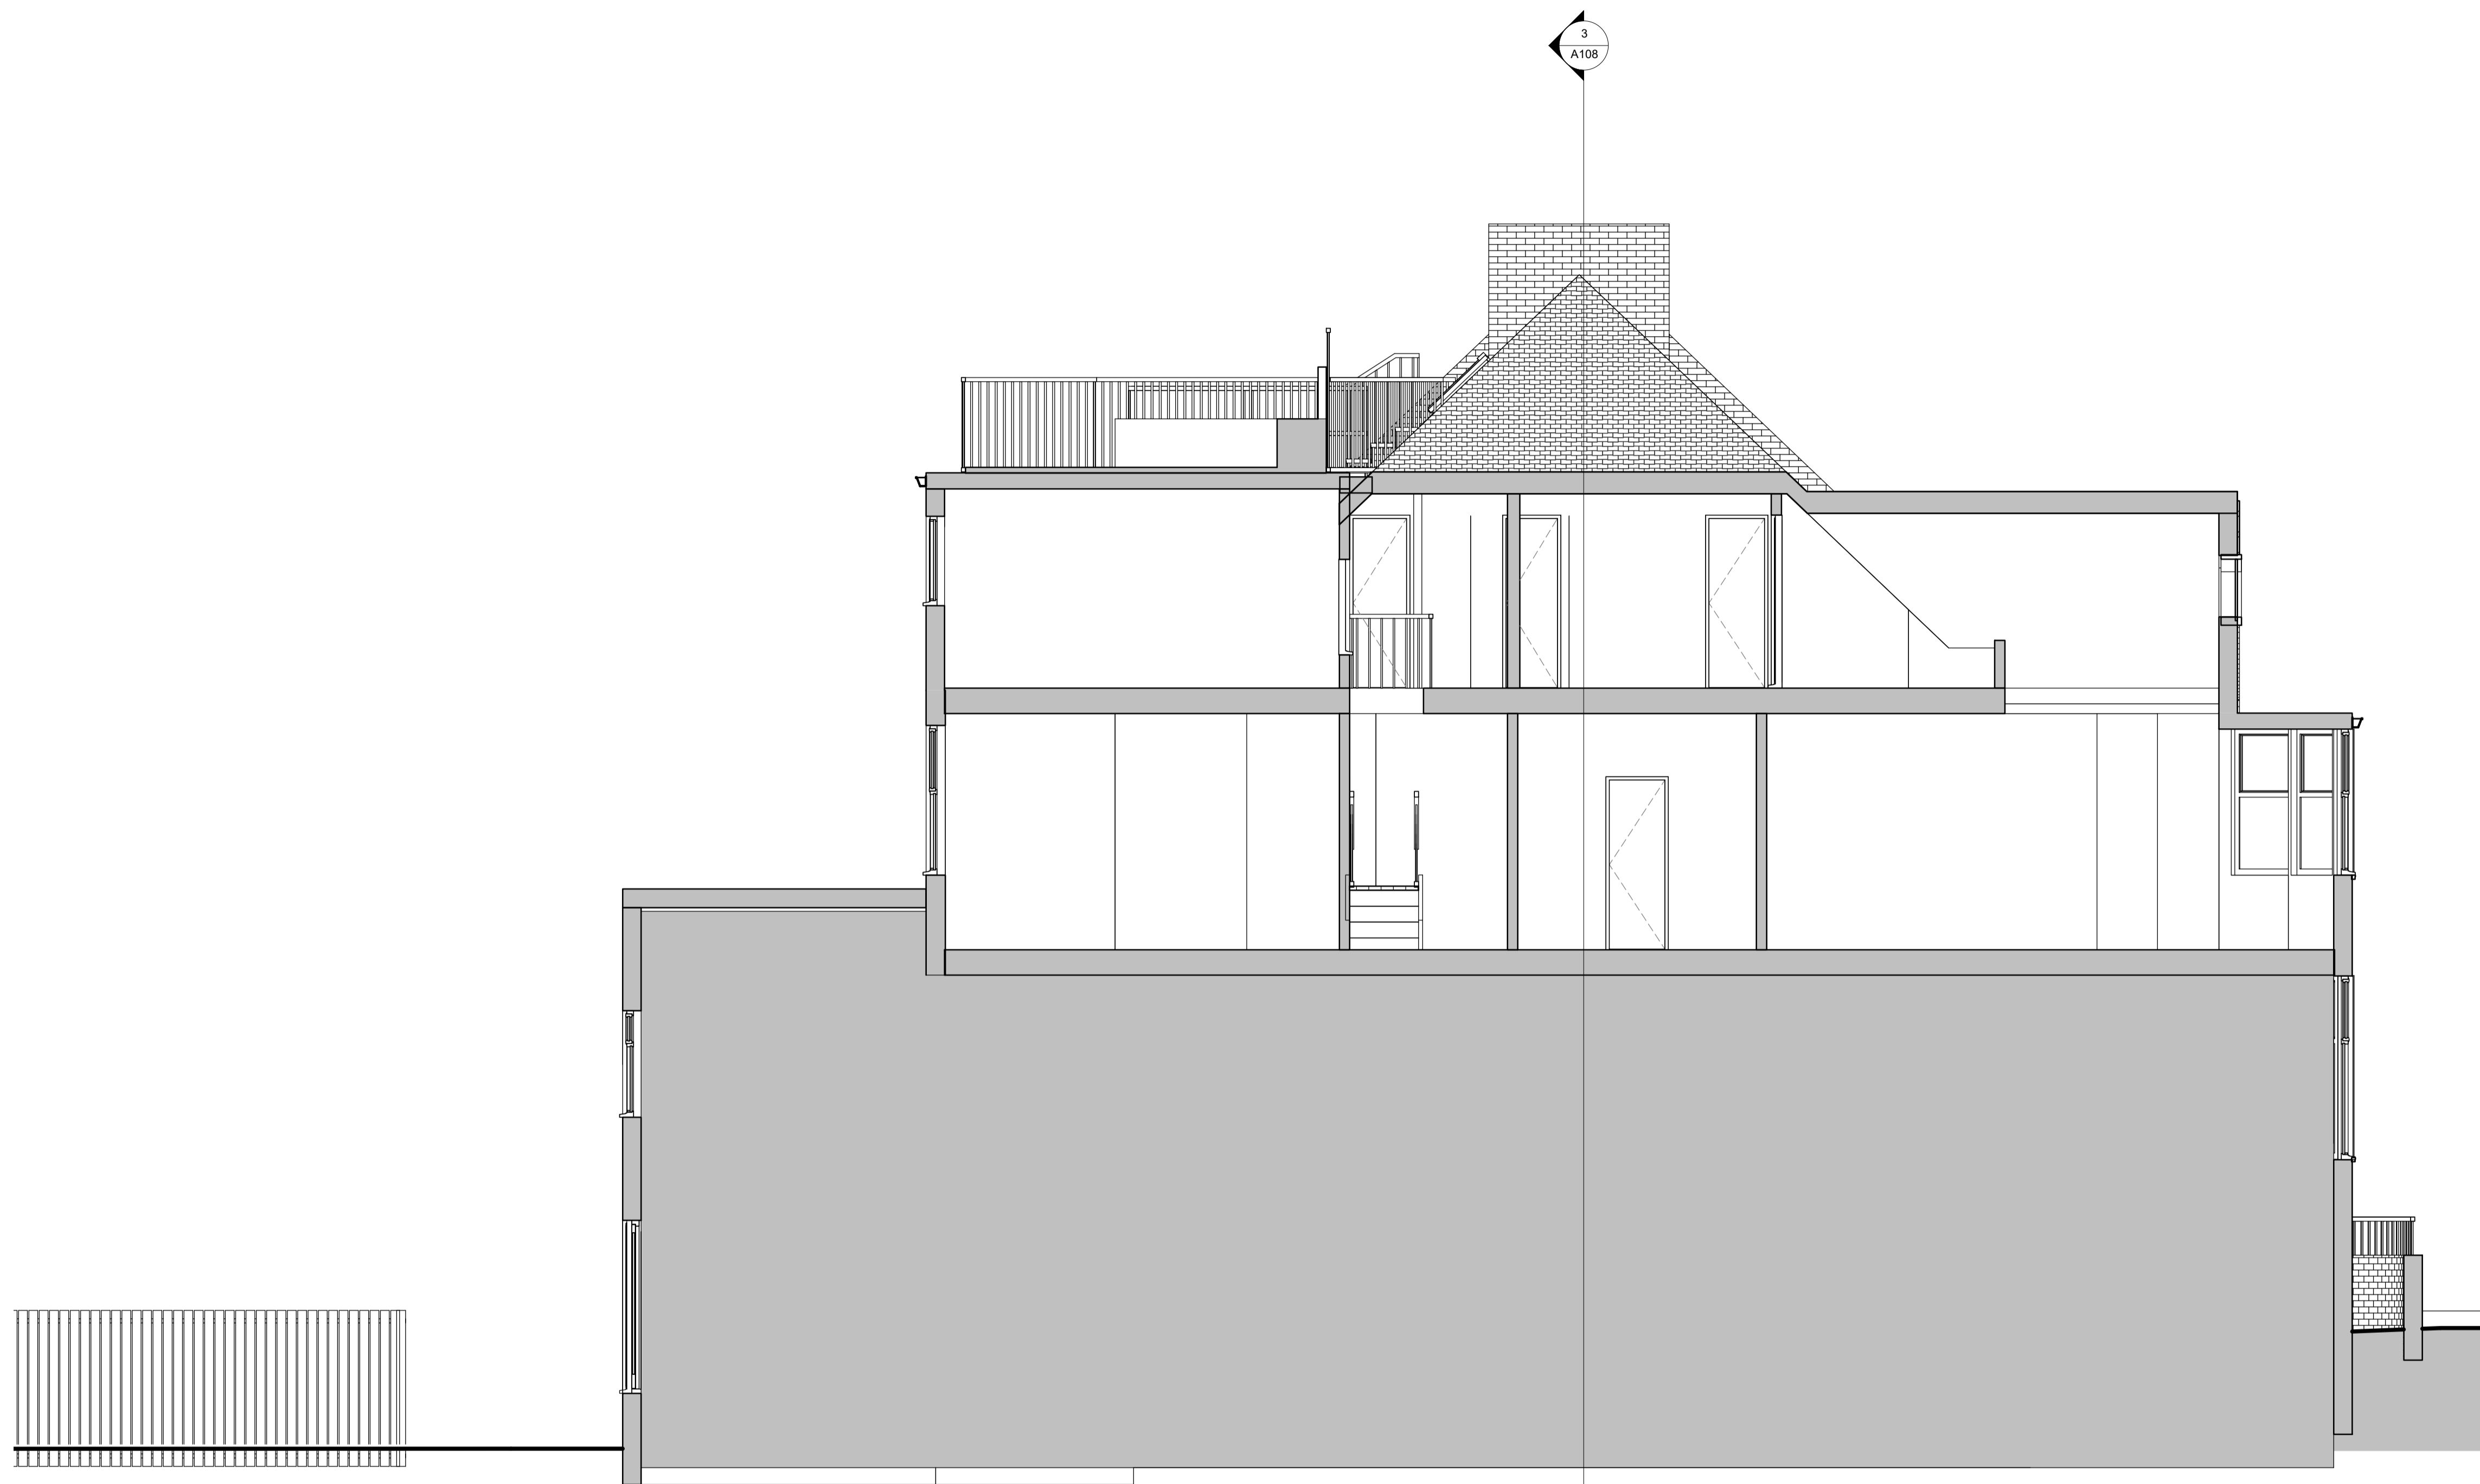

**As-built - section 1**  
 SCALE: 1 : 50 @ A1  
 1 : 100 @ A3

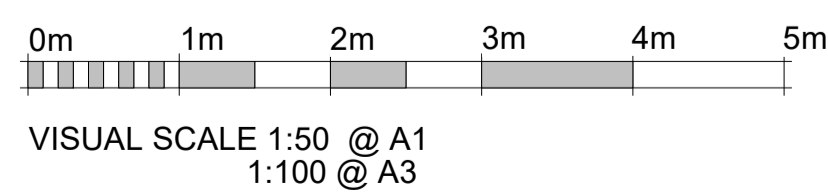

**Dimensions** Written dimensions to be taken in preference to scaled dimensions. The Contractor is responsible for checking all dimensions before work starts.

**Local Authority** All work is to be carried out to the requirements, and to the satisfaction of the Local Authority. These drawings are for planning purposes only.

**RPR Planning**  
 RPR PLANNING  
 Office 5, 37 Stanmore Hill  
 London, HA7 3DS.  
 Tel: 078 9661 7854  
 Web: www.rprplanning.co.uk  
 Email: info@rprplanning.co.uk


Rev	Date	Description	Made	Checked
Drawing Status: <b>FOR APPROVAL</b>				

Project  
**3 ROSECROFT AVENUE**


Client  
**GAURANG AMIN**

Drawing Title  
**AS-BUILT SECTION 1**


Drawn/Design	Date
AS SHOWN @ A1	11/13/19
Drawing No	Rev
<b>A110</b>	

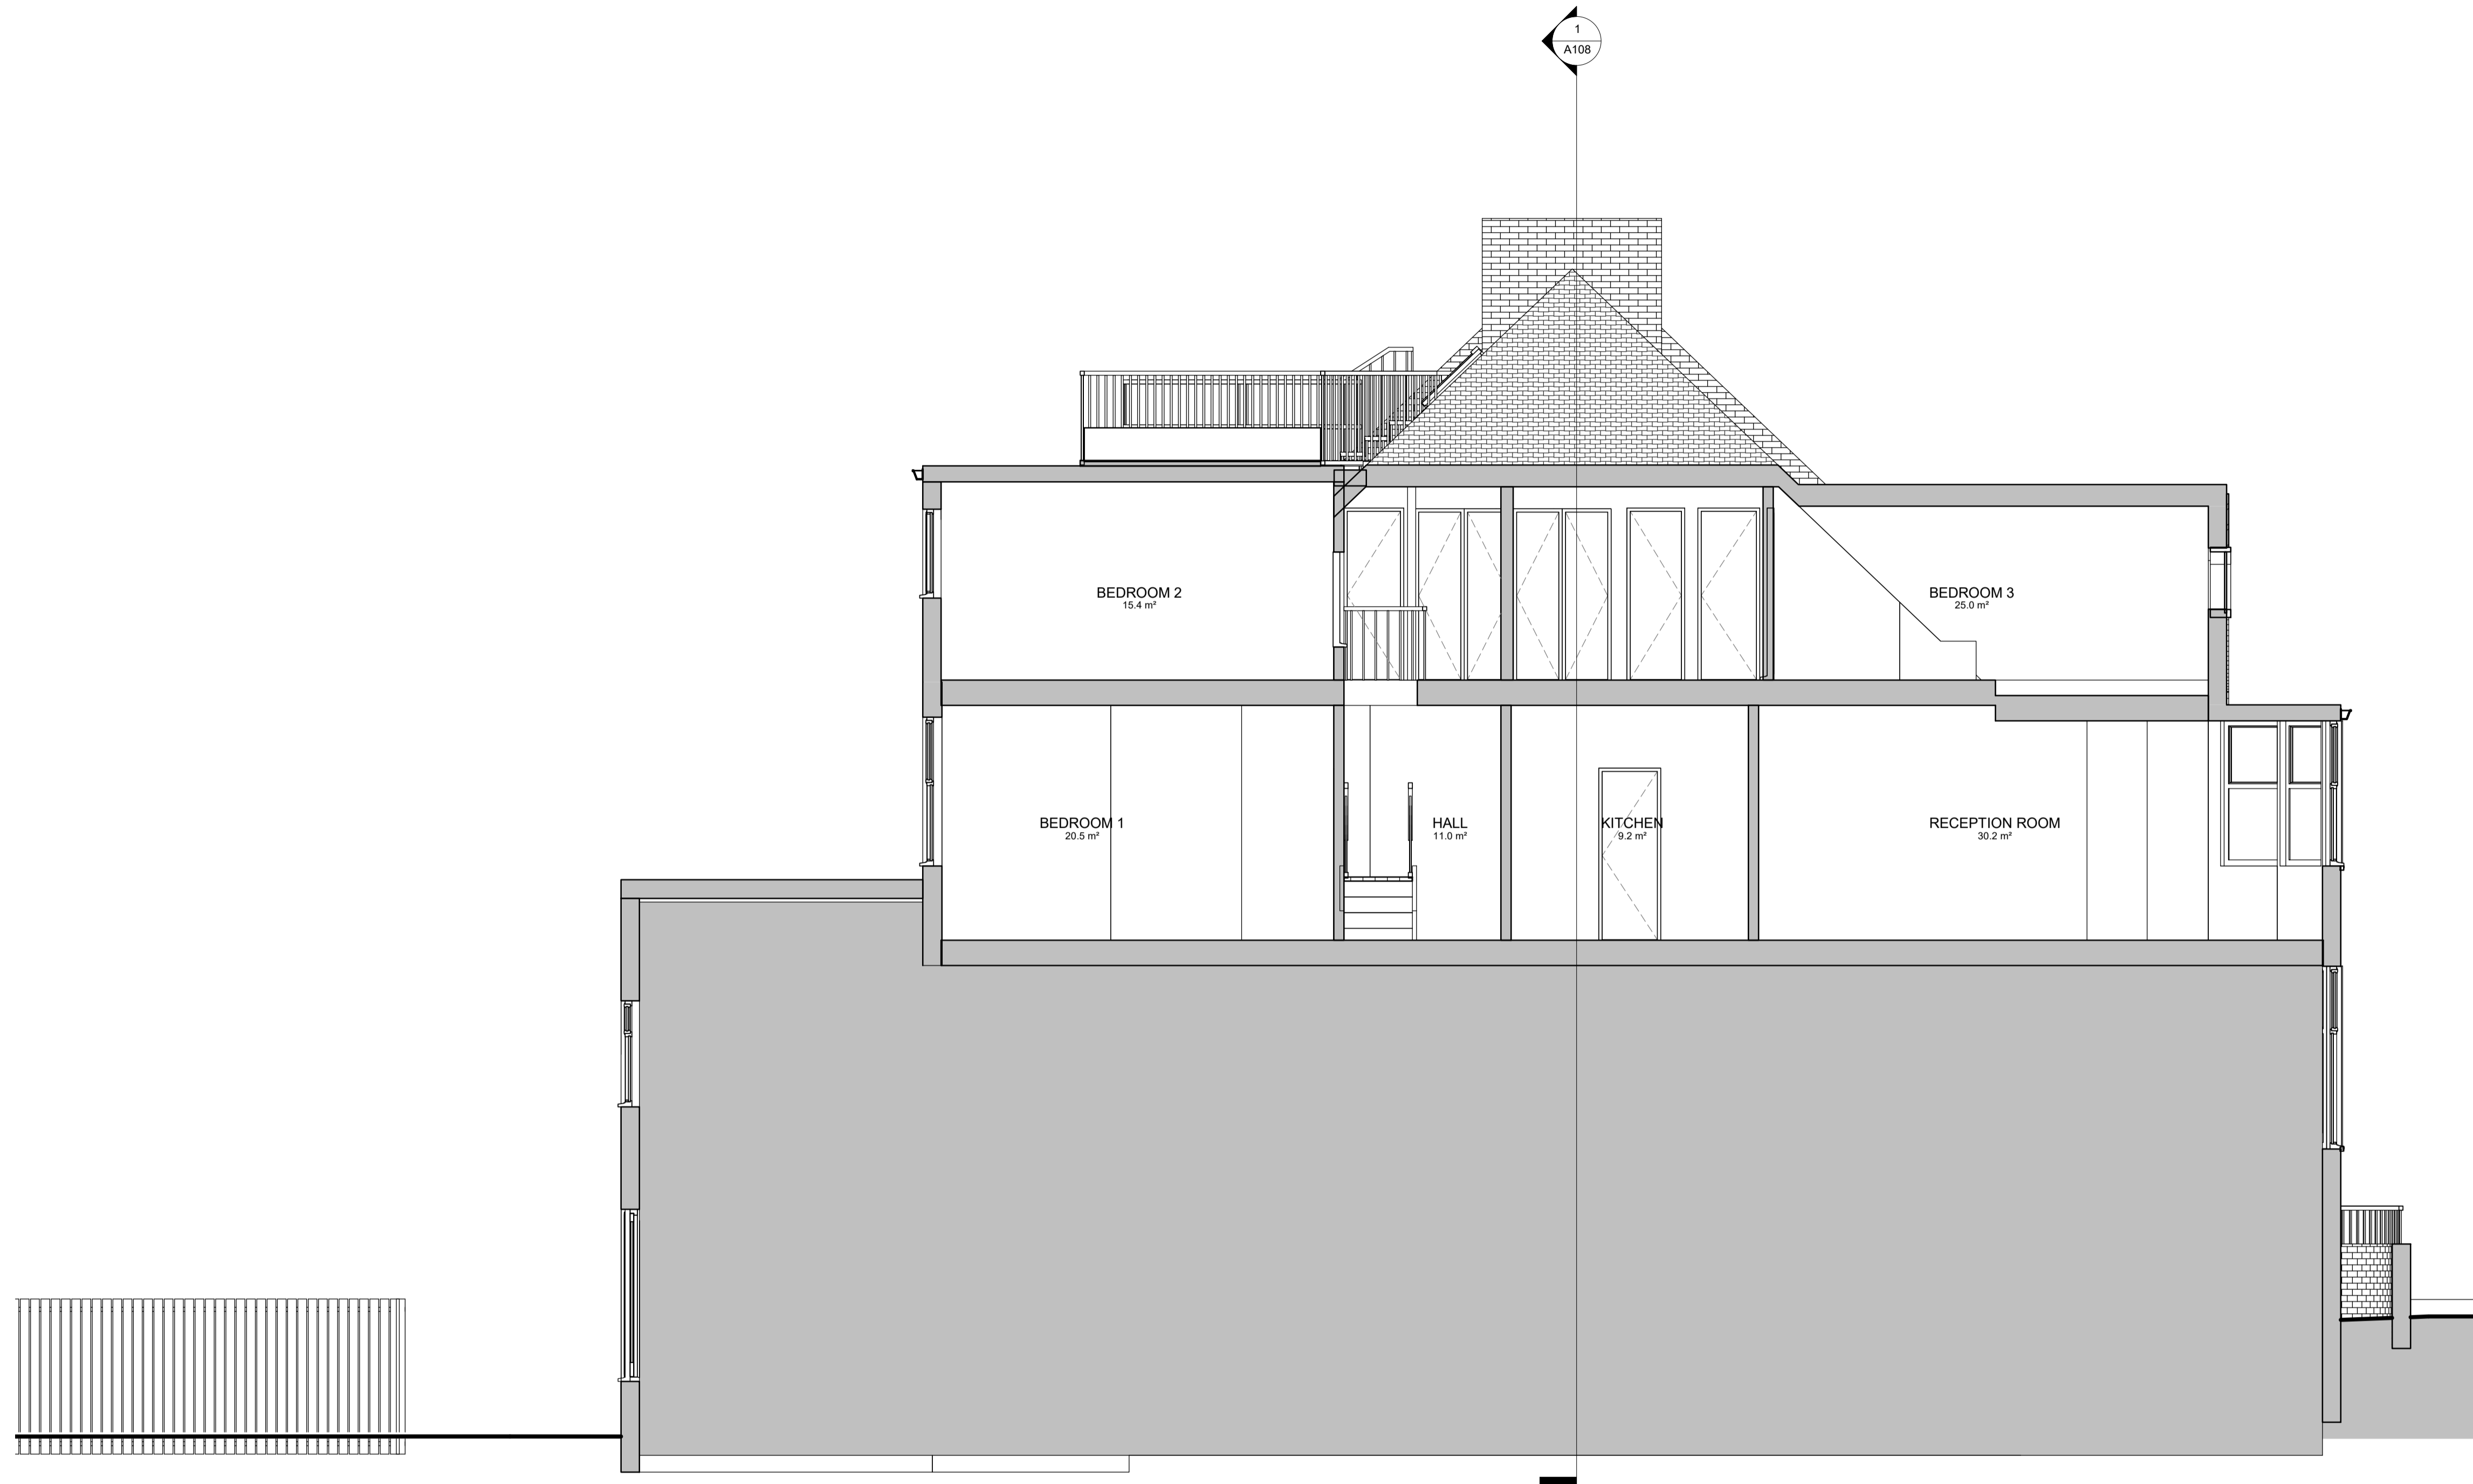


**Proposed section 1**  
 SCALE: 1 : 50 @ A1  
 1 : 100 @ A3

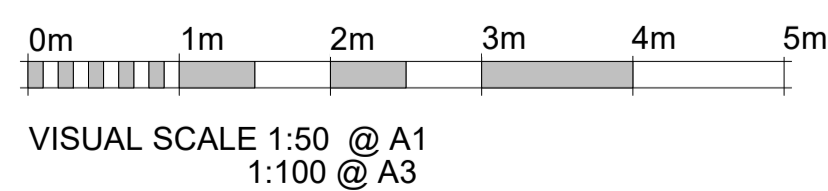

Dimensions Written dimensions to be taken in preferences to scaled dimensions. The Contractor is responsible for checking all dimensions before work starts.	 RPR PLANNING Office 5, 37 Stanmore Hill London, HA7 3DS. Tel: 078 9661 7854 Web: www.rprplanning.co.uk Email: info@rprplanning.co.uk	Project	3 ROSECROFT AVENUE		Drawing Title	PROPOSED SECTION 1	
		Client	GAURANG AMIN		Drawn/Design	Date	12/06/18
Local Authority	All work is to be carried out to the requirements, and to the satisfaction of the Local Authority. These drawings are for planning purposes only.	Rev	Date	Description	Made	Checked	Rev
Drawing Status: <b>FOR APPROVAL</b>				AS SHOWN @ A1	Drawing No	A111	-

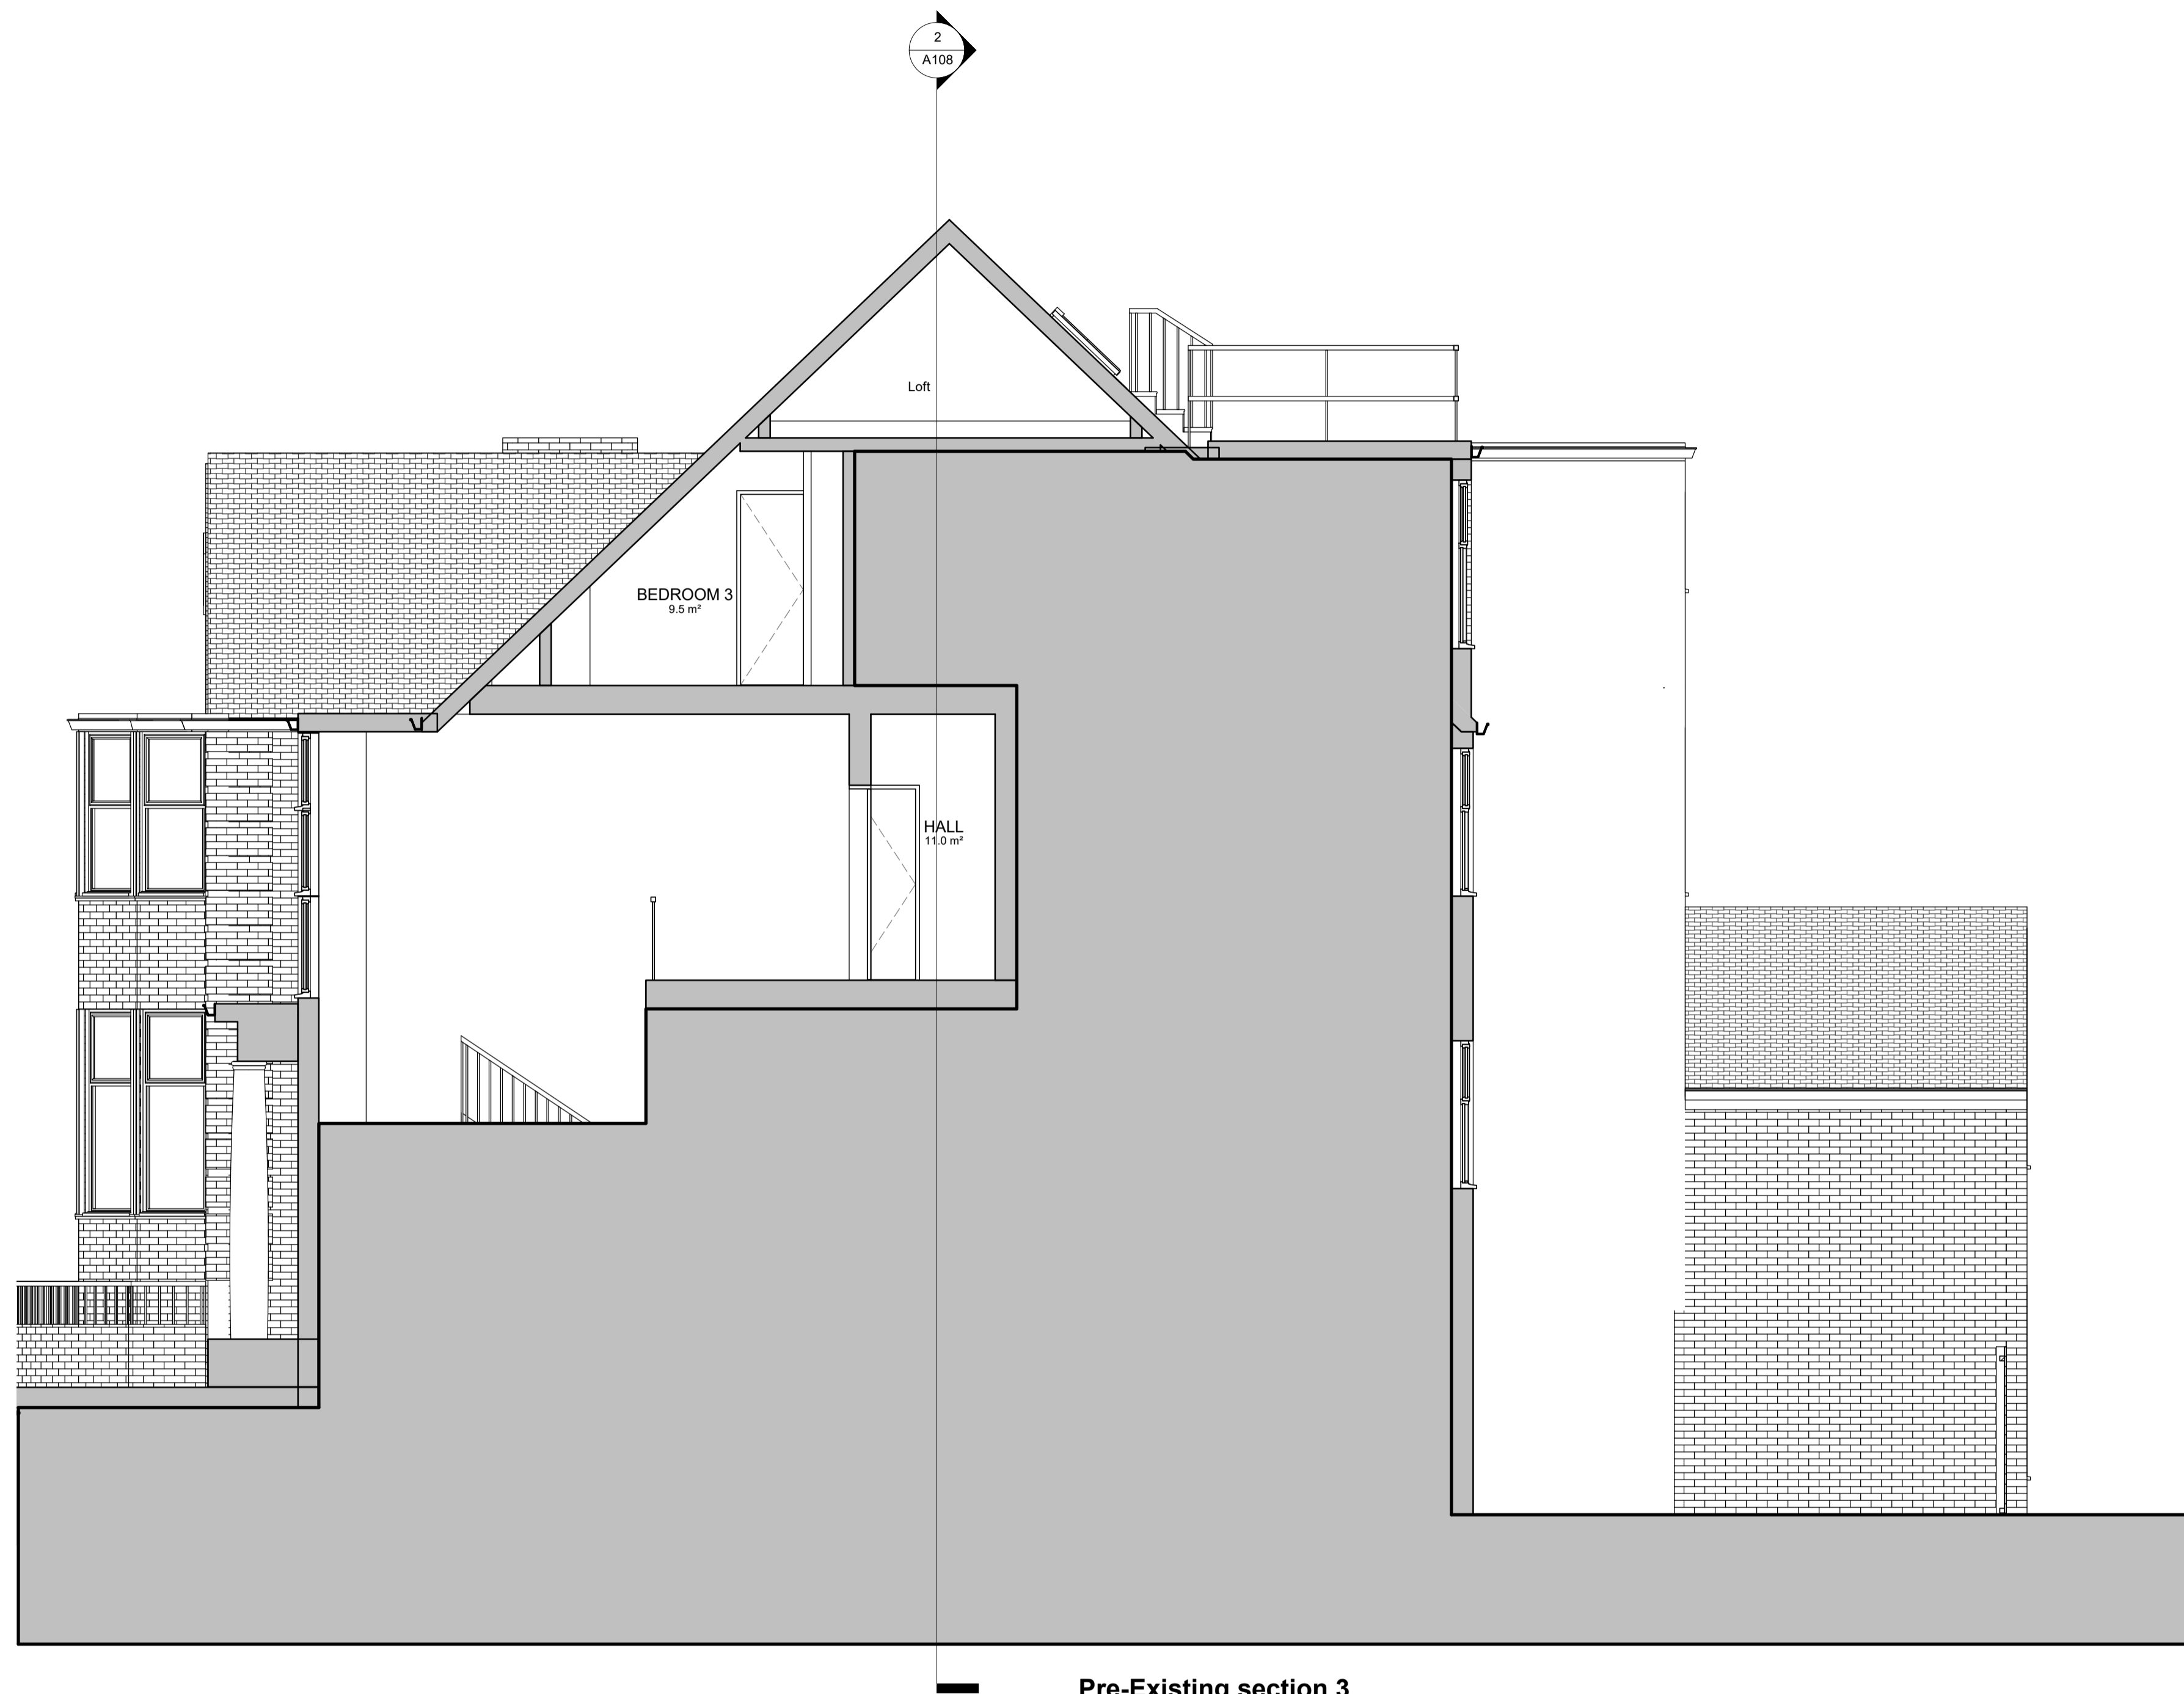

**Pre-Existing section 3**  
 SCALE: 1 : 50 @ A1  
 1 : 100 @ A3

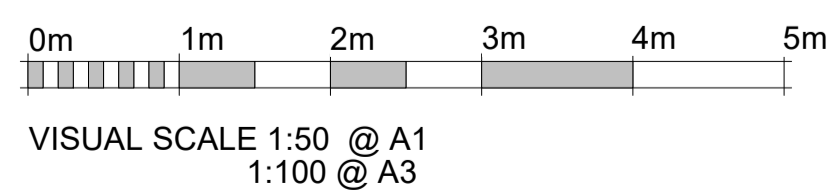

**Dimensions** Written dimensions to be taken in preferences to scaled dimensions. The Contractor is responsible for checking all dimensions before work starts.

**Local Authority** All work is to be carried out to the requirements, and to the satisfaction of the Local Authority. These drawings are for planning purposes only.

**RPR Planning**  
 RPR PLANNING  
 Office 5, 37 Stanmore Hill  
 London, HA7 3DS.  
 Tel: 078 9661 7854  
 Web: www.rprplanning.co.uk  
 Email: info@rprplanning.co.uk


Rev	Date	Description	Made	Checked
-				

Drawing Status: **FOR APPROVAL**

Project  
**3 ROSECROFT AVENUE**


Client  
**GAURANG AMIN**

Drawing Title <b>PRE-EXISTING SECTION 3</b>	
Drawn/Design	Date 12/14/18
Scales: AS SHOWN @ A1	Rev -
Drawing No <b>A112</b>	

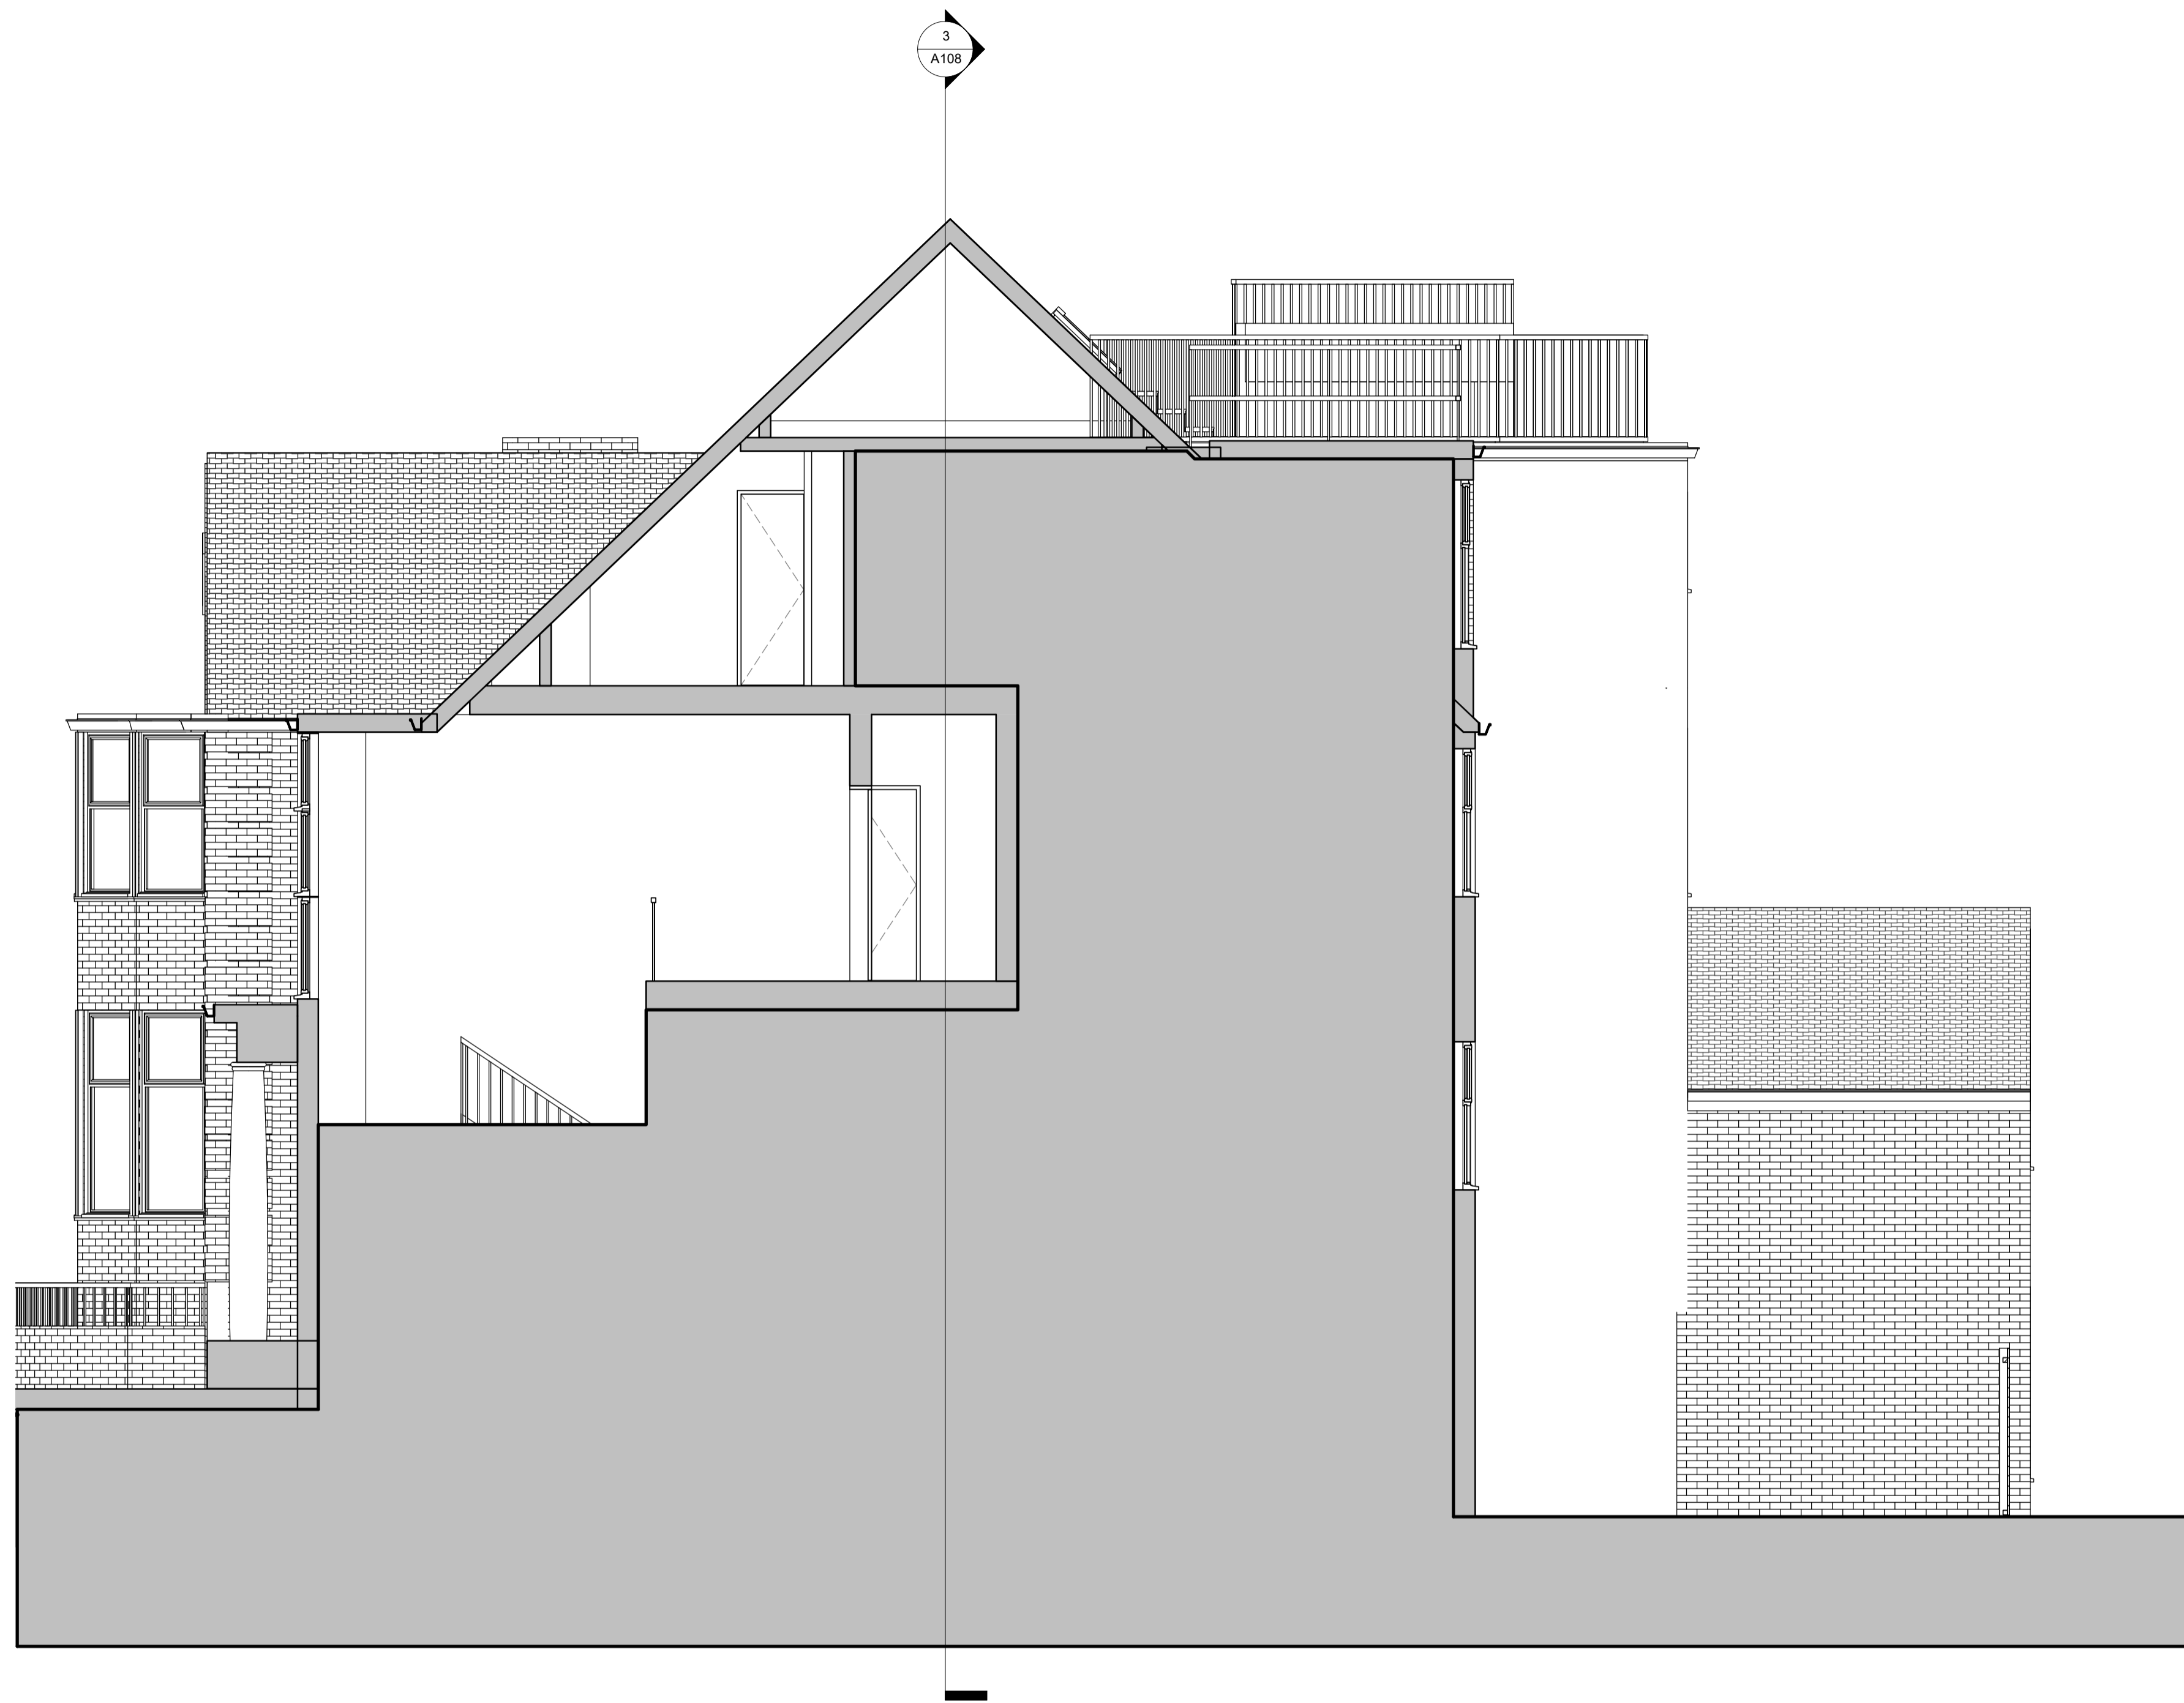


**As-built - section 3**


SCALE: 1 : 50 @ A1  
1 : 100 @ A3

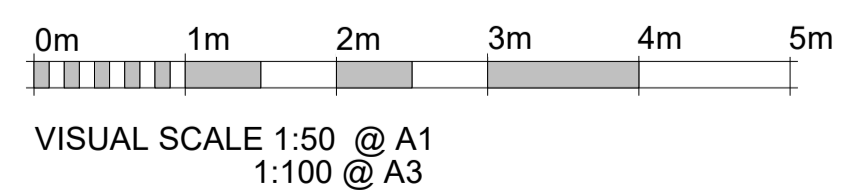

<p>Dimensions</p> <p>Written dimensions to be taken in preferences to scaled dimensions. The Contractor is responsible for checking all dimensions before work starts.</p>	 <p><b>RPR PLANNING</b> Office 5, 37 Stanmore Hill London, HA7 3DS. Tel: Mobile: 078 9661 7854 Web: www.rprplanning.co.uk Email: info@rprplanning.co.uk</p>	Project	3 ROSECROFT AVENUE		Drawing Title	AS-BUILT SECTION 3								
		Local Authority	All work is to be carried out to the requirements, and to the satisfaction of the Local Authority. These drawings are for planning purposes only.	Client	GAURANG AMIN	Drawn/Design	Date	11/13/19						
<p>Rev</p> <table border="1"> <thead> <tr> <th>Rev</th> <th>Date</th> <th>Description</th> <th>Made</th> <th>Checked</th> </tr> </thead> <tbody> <tr> <td> </td> <td> </td> <td> </td> <td> </td> <td> </td> </tr> </tbody> </table> <p>Drawing Status: <b>FOR APPROVAL</b></p>		Rev	Date	Description	Made	Checked						<p>Scales:</p> <p>AS SHOWN @ A1</p>	<p>Drawing No</p> <p>A113</p>	<p>Rev</p>
Rev	Date	Description	Made	Checked										

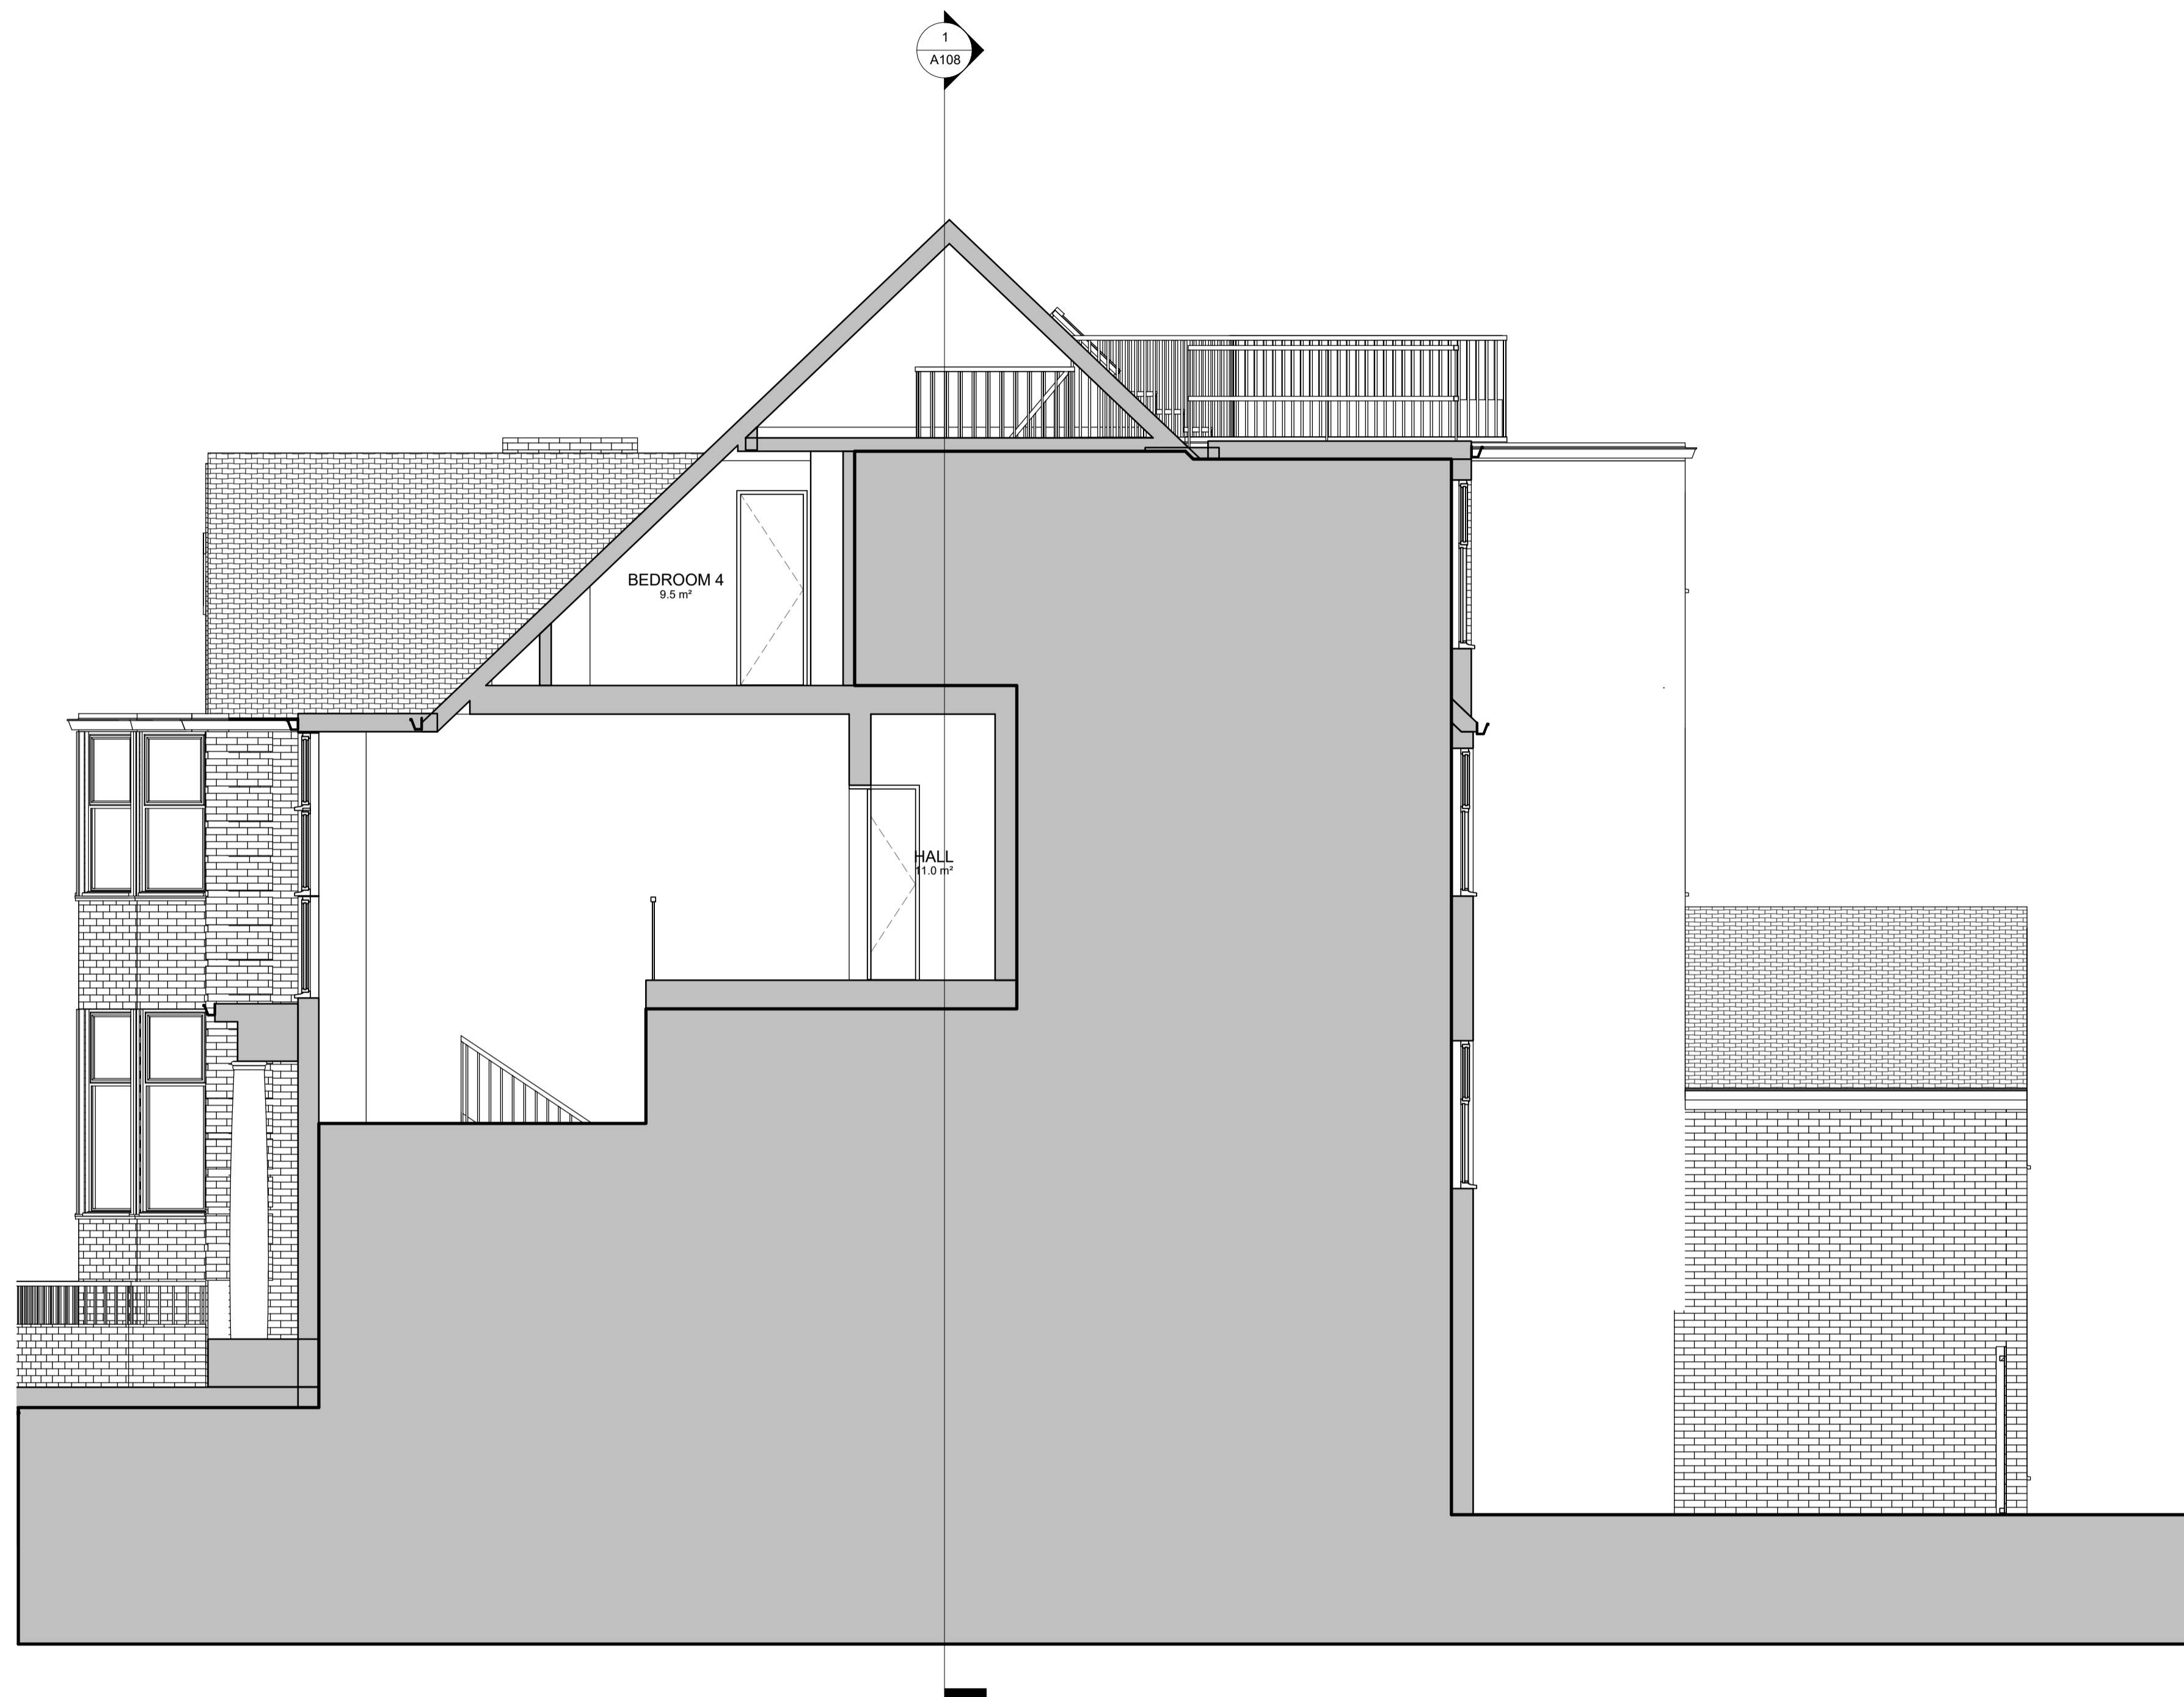

**Proposed section 3**  
 SCALE: 1 : 50 @ A1  
 1 : 100 @ A3

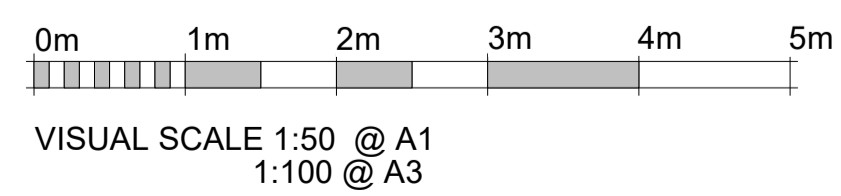

**Dimensions** Written dimensions to be taken in preference to scaled dimensions. The Contractor is responsible for checking all dimensions before work starts.

**Local Authority** All work is to be carried out to the requirements, and to the satisfaction of the Local Authority. These drawings are for planning purposes only.

**RPR Planning**  
 RPR PLANNING  
 Office 5, 37 Stanmore Hill  
 London, HA7 3DS.  
 Tel: Mobile: 078 9661 7854  
 Web: www.rprplanning.co.uk  
 Email: info@rprplanning.co.uk

Rev	Date	Description	Made	Checked
-				

Drawing Status: **FOR APPROVAL**

Project	<b>3 ROSECROFT AVENUE</b>
Client	<b>GAURANG AMIN</b>

Drawing Title		<b>PROPOSED SECTION 3</b>	
Drawn/Design		Date	12/14/18
Scales:	AS SHOWN @ A1	Drawing No	<b>A114</b>
		Rev	-