

Notes


These drawings are strictly copyright and are not to be used, printed or copied in any form unless expressly permitted by ASB Architects. Any scale indicated on the drawing is only correct provided the drawing is printed at the original "Sheet Size" field. This is typically A1 or A3, printed without reduction, @ 100%

This drawing may include information shown in colour as indicated by the "Printing" field. If the drawing is received incorrectly please refer to the sender or Architects.

Do not scale from these drawings. Refer to figured dimensions only and, where these are missing or cannot be inferred from the given dimensions, refer to the Architect for instruction.

Inform the Architect as soon as possible of any discrepancies found on site.

This drawing is to be read in conjunction with the structural engineers' drawings, all other layout and detail drawings together with the Schedule of Works and Specification.

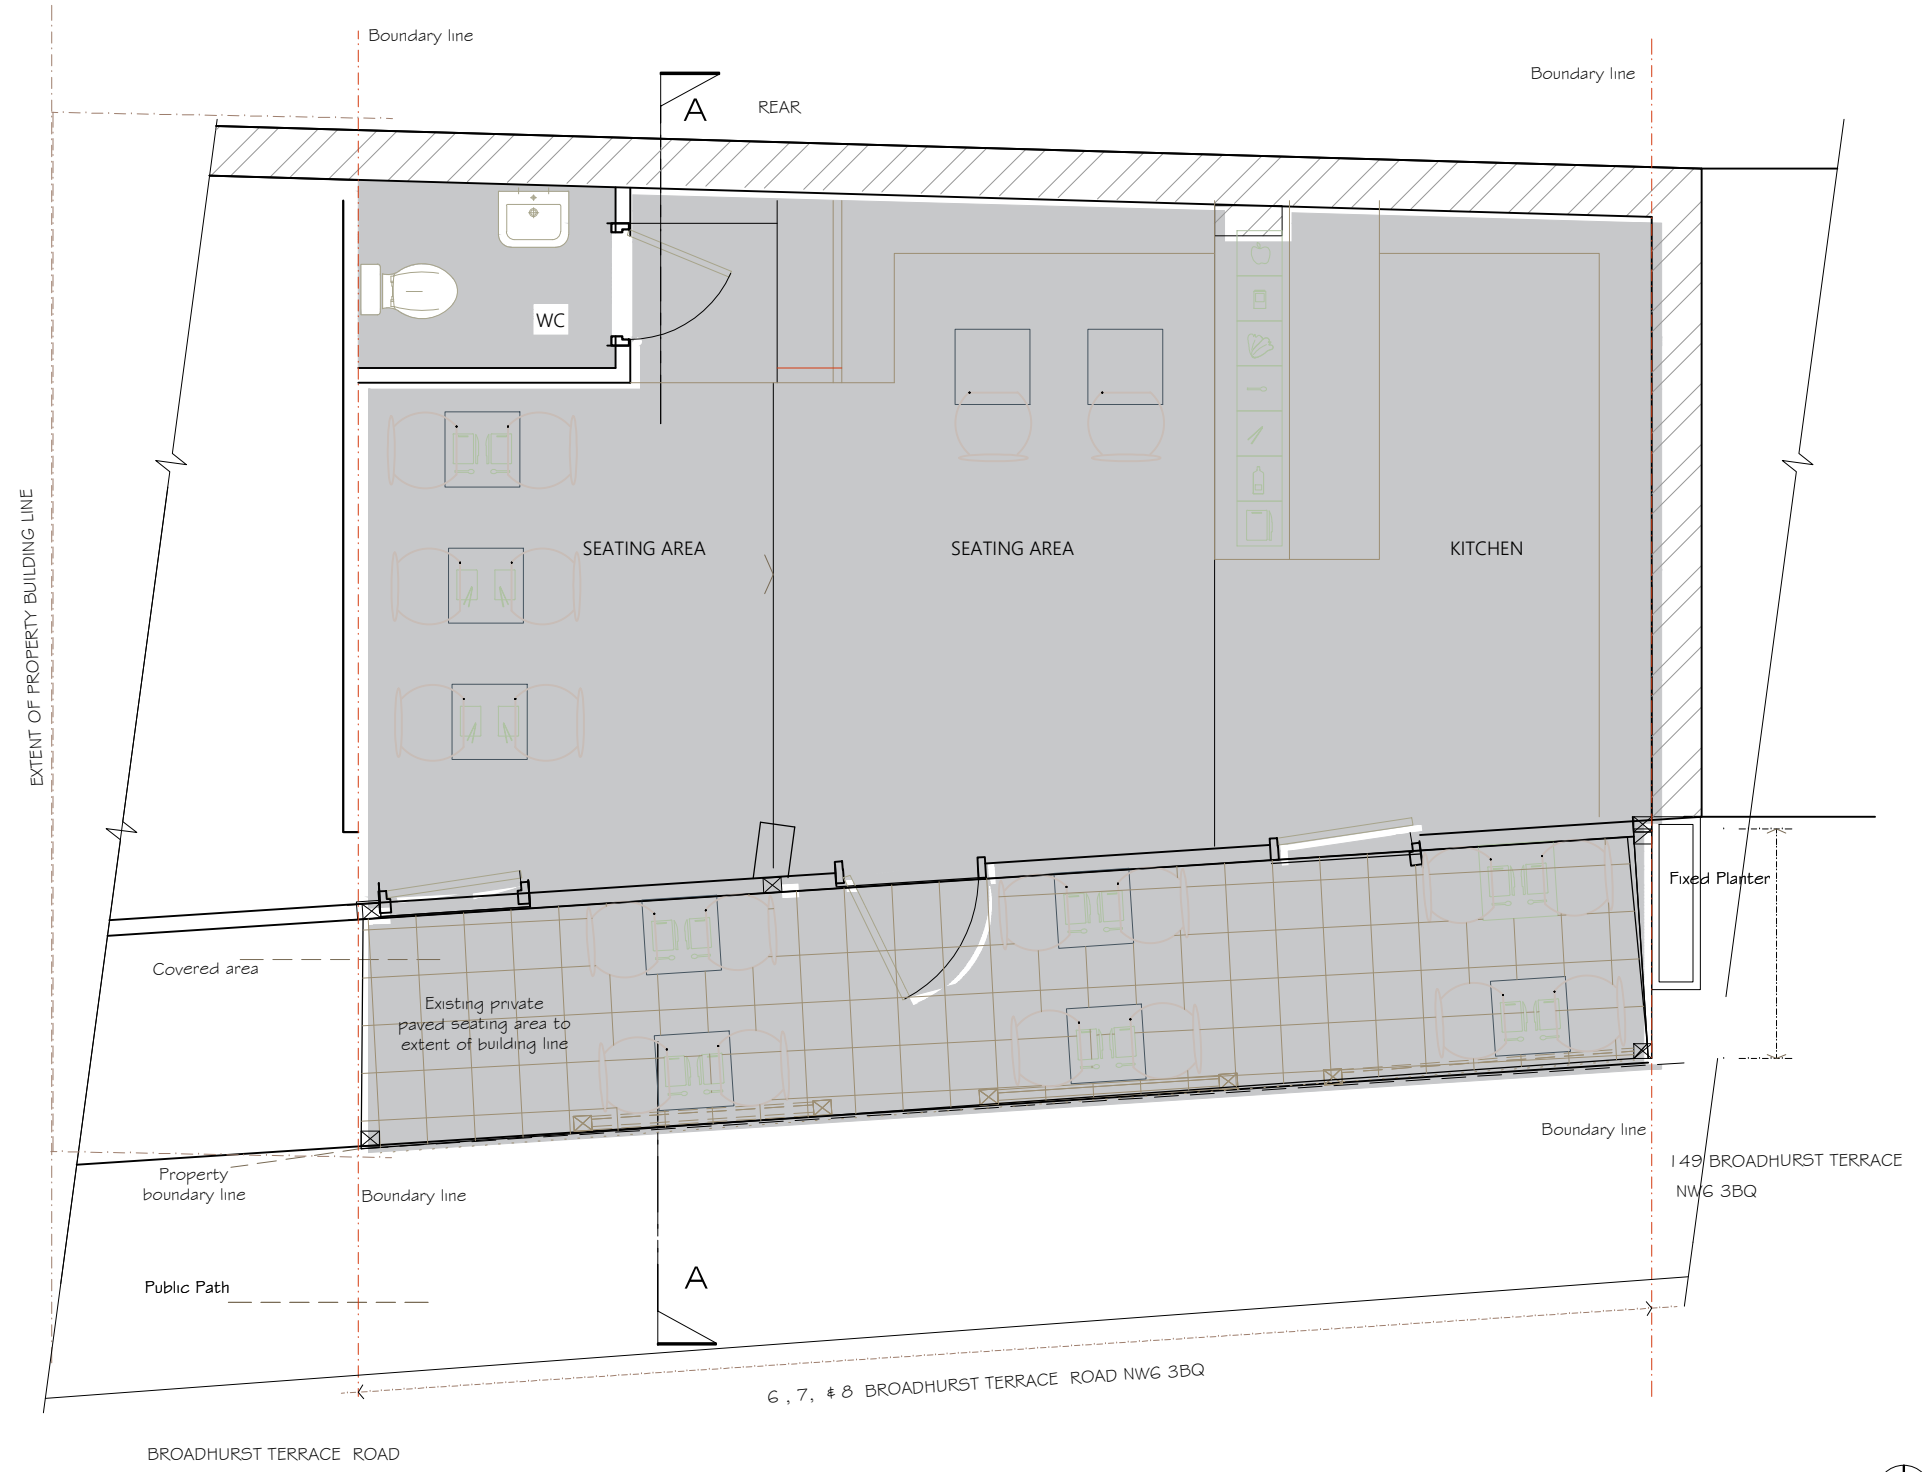

REVISION
A - 18 APRIL 2019 INFORMATION ADDED
B - 7 JUNE 2019 INFORMATION ADDED

Rev.	Date	Notes

ASB ARCHITECTS

215 West End Lane West Hampstead
London NW6 1XJ T: 020 7431 5221 F:
02074315114 E: amos@asbarchitects.com

Project **ERECTION OF ENCLOSURE AT
6-8 BROADWHEEL PARADE NW6 3BQ**

Drawing **AS BUILT GROUND FLOOR LAYOUT**

Dwg status	-	Date ©	APRIL 2019
Project Ref	402/A1/A	Printing	-
SCALE	1:50	Sheet size	A3

Drg No	07	Rev.	B
--------	----	------	---

GROUND FLOOR PLAN
EXISTING FLOOR PLAN

