




Existing swing gates replaced with sliding gates to match existing

Existing swing gates replaced with sliding gates to match existing

2 Frognal Way

60 Frognal

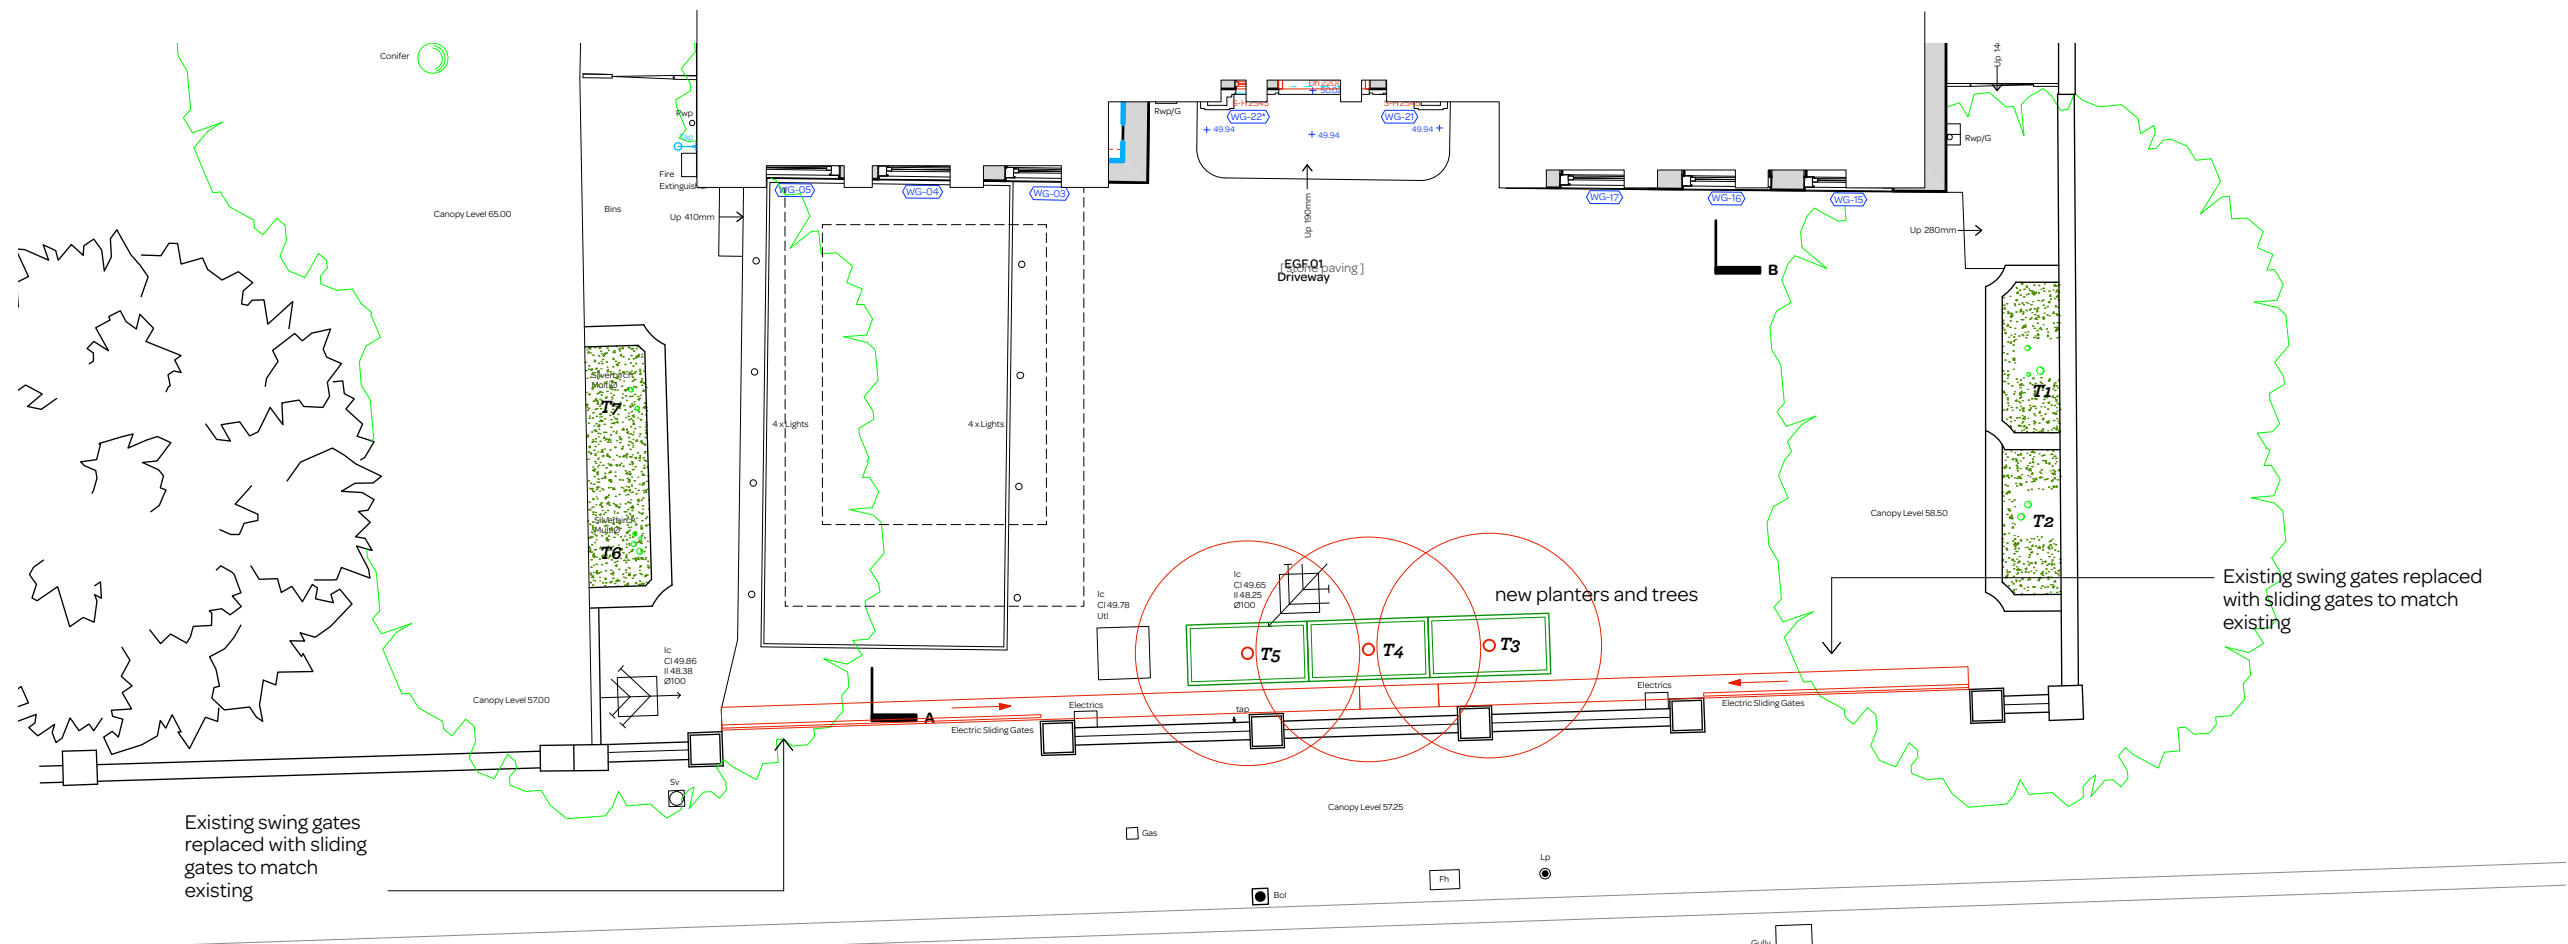

Existing swing gates replaced with sliding gates to match existing

Existing swing gates replaced with sliding gates to match existing

notes:

- General notes:**
1. Do not scale drawings. Dimensions govern.
  2. All dimensions are in millimeters unless noted otherwise.
  3. All dimensions shall be verified on site before proceeding with the work.
  4. Square Feet Architects shall be notified in writing of any discrepancies.

**Party Wall Act 1996:**  
 Note: If the project progresses onto site without the involvement of Square Feet Architects the Client must seek advice prior to commencement of the planned works as detailed on the drawings to establish whether the works fall within the scope of the Act which required adjoining property owners to be served with a statutory notice.

**C.D.M. Regulations 2015:**  
 These drawings have been produced for the purpose of applying for Planning and Building Regulations only. If the project progresses on to site without the involvement of Square Feet Architects, the client and contractor must ensure that they fulfil the duties in respect of the construction (Design and Management) Regulations 1994. If advice is required please do not hesitate to contact Square Feet Architects.

**KEY**

black lines	existing
green lines	to be demolished
red lines	proposed

# PLANNING

revision:

A	04/12/19	Tree refs added, and new trees and gates



A : 95 Bell St, London NW1 6TL  
 T : 0207 431 4500  
 E : studio@squarefeetarchitects.co.uk  
 W : www.squarefeetarchitects.co.uk

drawing title:  
**PROPOSED ELEVATIONS-GATE**

client:  
 Mr & Mrs Mouskos

project:  
**62 Frognal NW3 6XG**

date: Dec2019	scale:
------------------	--------

drawing number: <b>1815_L_122</b>	revision: A
--------------------------------------	----------------