



LOWER BASEMENT

REVISIONS	Rev.	Date	By
A: Flue ducting location amended	08.01.14	SN	
B: Lockers removed from cycle store 1.50m wide access corridor provided Headroom dimension indicated	12.02.14	CT	
C - Rearrangement warehouse space by adding additional basement in lower level. - New larger lifts to accommodate cycles to basement level.	15.08.15	SP	
- Rearrangement of Cycle Store, Plant and Laundry.			
D: General plan amendments.	21.06.16	FP	
E: Electric risers	09.08.16	FP	
F: Revision Stair 1			
F: Slab level decreased by 600mm Sheet plan perimeter updated Stair 7 added as per Fire Strategy requirement	17.11.17	FP	
G: Warehouse area increased by 200 sqm. Cycle Store relocated.	18.02.08	MG	
H - Addition of Gym - Removed Cycle Storage	18.09.07	WK	
J - Plan amended to match approved planning reference 2017 / 6786 / P	04.02.19	MAA	
K: Plan amended to show cycle store at middle basement level and reflect the current as-built	18.11.19	CT	

PLANNING APPLICATION

ALL DIMENSIONS TO BE CHECKED ON SITE
WORK TO FIGURED DIMENSIONS ONLY
REPORT DISCREPANCIES TO THE ARCHITECT
AT ONCE BEFORE PROCEEDING

Contemporary Design Solutions



46 Great Marlborough Street
London
W1F 7JW
Telephone: 020 7494 9003 Fax: 020 7494 4944

Client

HALLMARK PROPERTY GROUP

Project Title

**B&WAREHOUSE & STUDENT ACCOMMODATION
65-69 HOLMES ROAD**


Drawing Title

**PROPOSED LOWER BASEMENT
PLAN**

Scale 1: 100 @ A0 NTS @ A3 Date FEB 2019

Drawn MAA Checked CT

Drawing No. 131050 A(GA)P080 Rev. K

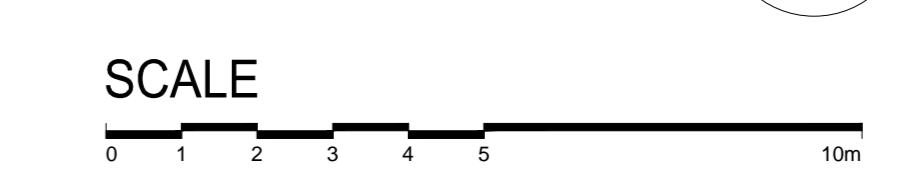

REVISIONS		
Rev.	Date	By
A	18.11.19	CT

A: Plan amended to show cycle store at middle basement level and enlarged mezzanine social and breakout area



MEZZANINE LEVEL

PLANNING APPLICATION

ALL DIMENSIONS TO BE CHECKED ON SITE
 WORK TO FIGURED DIMENSIONS ONLY
 REPORT DISCREPANCIES TO THE ARCHITECT
 AT ONCE BEFORE PROCEEDING

Contemporary Design Solutions



46 Great Marlborough Street
 London
 W1F 7JW
 Telephone: 020 7494 9000 Fax: 020 7494 4944

Client
HALLMARK PROPERTY GROUP

Project Title
**B&WAREHOUSE & STUDENT ACCOMMODATION
 65-69 HOLMES ROAD**

Drawing Title
**PROPOSED MEZZANINE LEVEL
 PLAN**

Scale 1: 100 @ A0 NTS @ A3 Date FEB 2019
 Drawn MAA Checked CT
 Drawing No. Rev.

131050 A(GA)P085 A

CAD plot date: 19 Nov 2019 - 05:08pm

