




Internal Room Elevation
Scale: 1:10

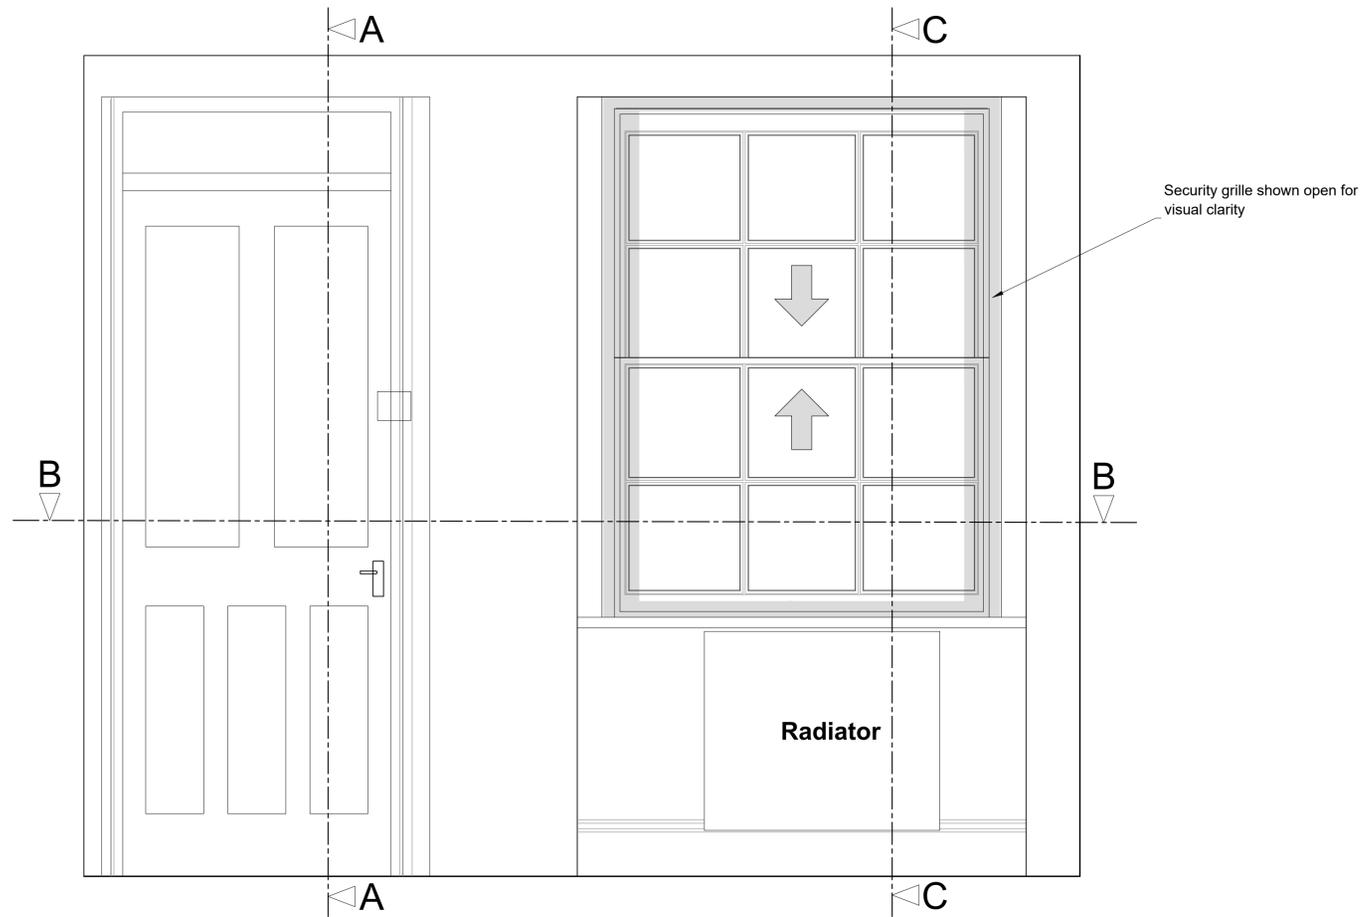

Section A-A & C-C through External Wall
Scale: 1:10

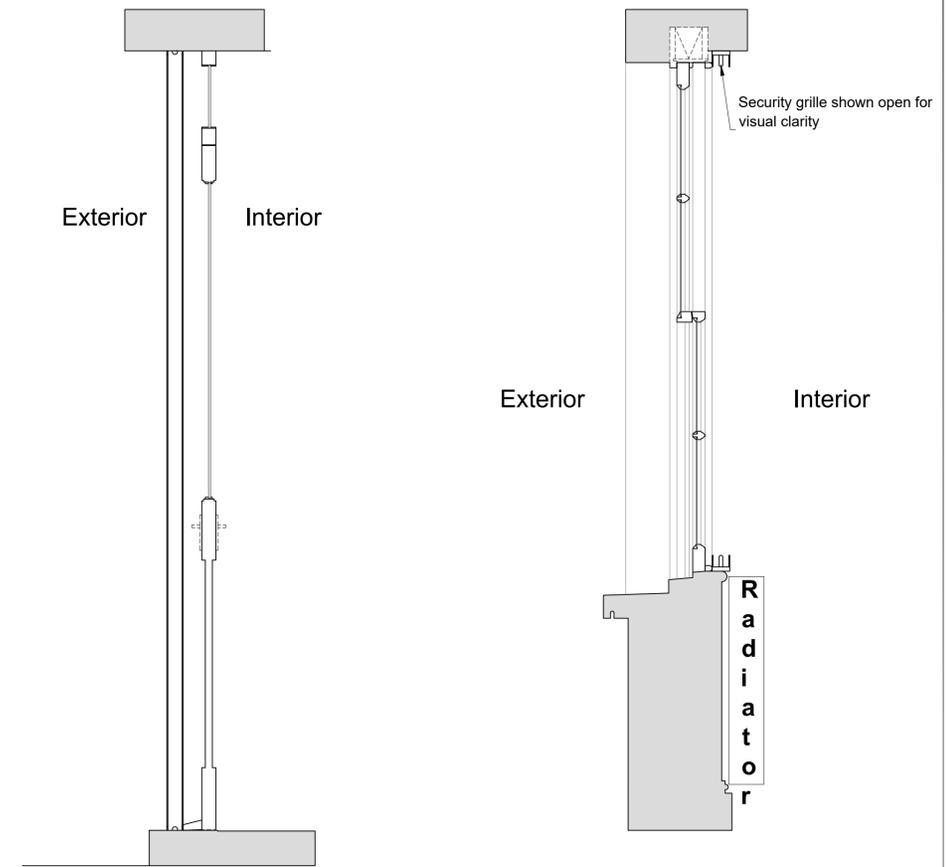

Plan Section B-B
Scale: 1:10

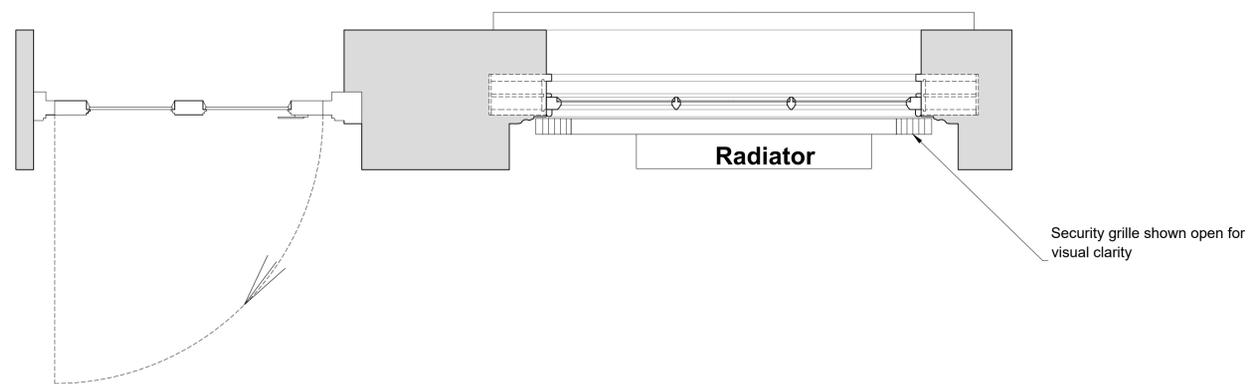

Revision	Date	Assessment
1.0	13-12-2019	Issued for listed building consent application

Do not reproduce this drawing without written permission
All dimensions are in millimetres unless stated otherwise

Drawing Not For Construction

HS2

High Speed (HS2) Limited
1st-3rd Floor
The Tower
1 Eversholt Street
London NW1 2DN

COSTAIN SKANSKA

Costain Skanska Joint Venture
9th Floor
The Tower
1 Eversholt Street
London NW1 2DN

Site Address:
70 Delancey Street, London NW1


Drawing Title:
Basement - Bedroom: EXISTING Front Window Joinery Details -
Sheet 1 of 3

Drawn by: AP & PB
Checked by: OB
Presentation Scale: as shown @ A1

Date: 27-05-2019
Drawing No: WPI P066B NI - 70 DeS-EX-BS-J-01
Revision: 1.0


Internal Room Elevation with Secondary Glazing Installed

Scale: 1:10

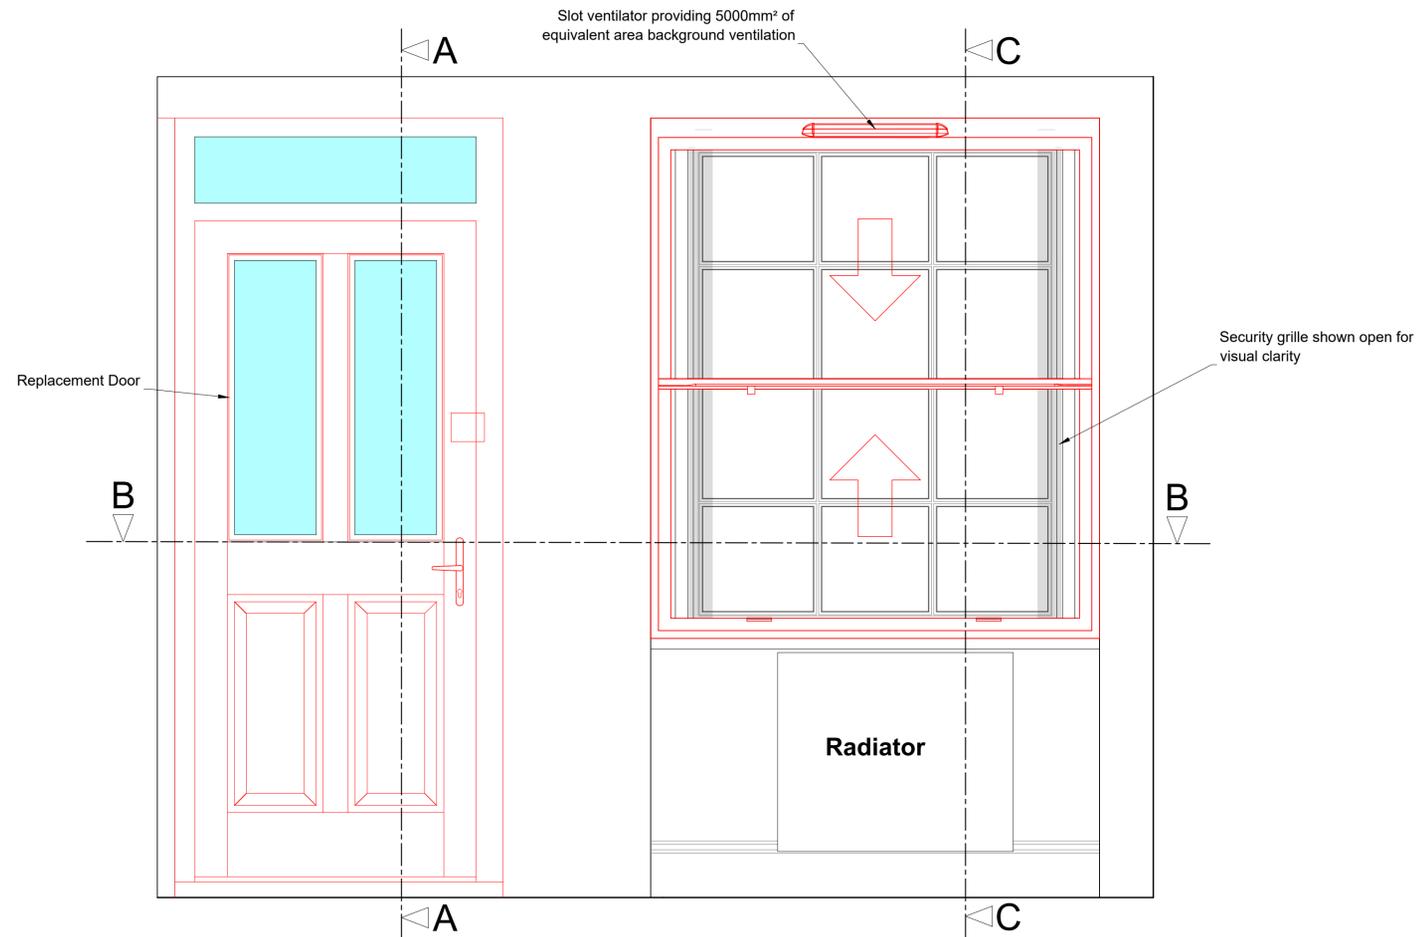


Section A-A & C-C through External Wall with Secondary Glazing Installed

Scale: 1:10

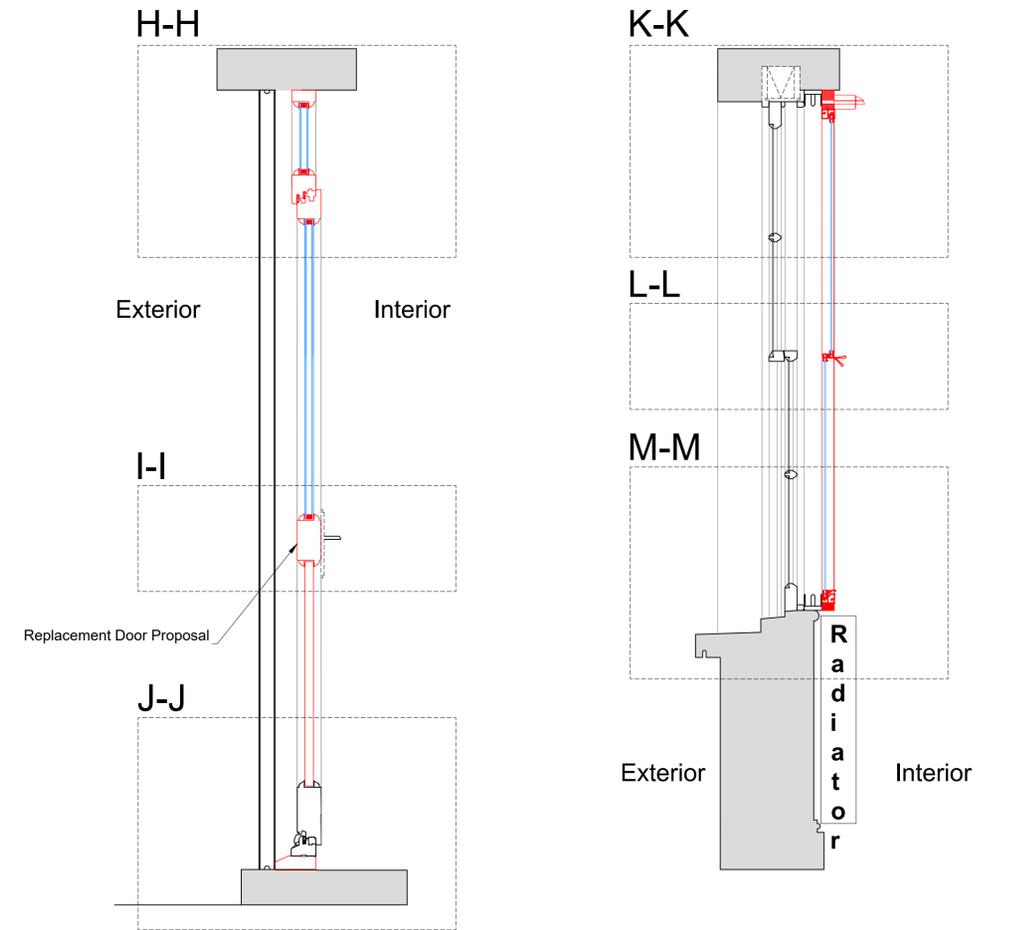

Plan Section B-B with Secondary Glazing Installed

Scale: 1:10

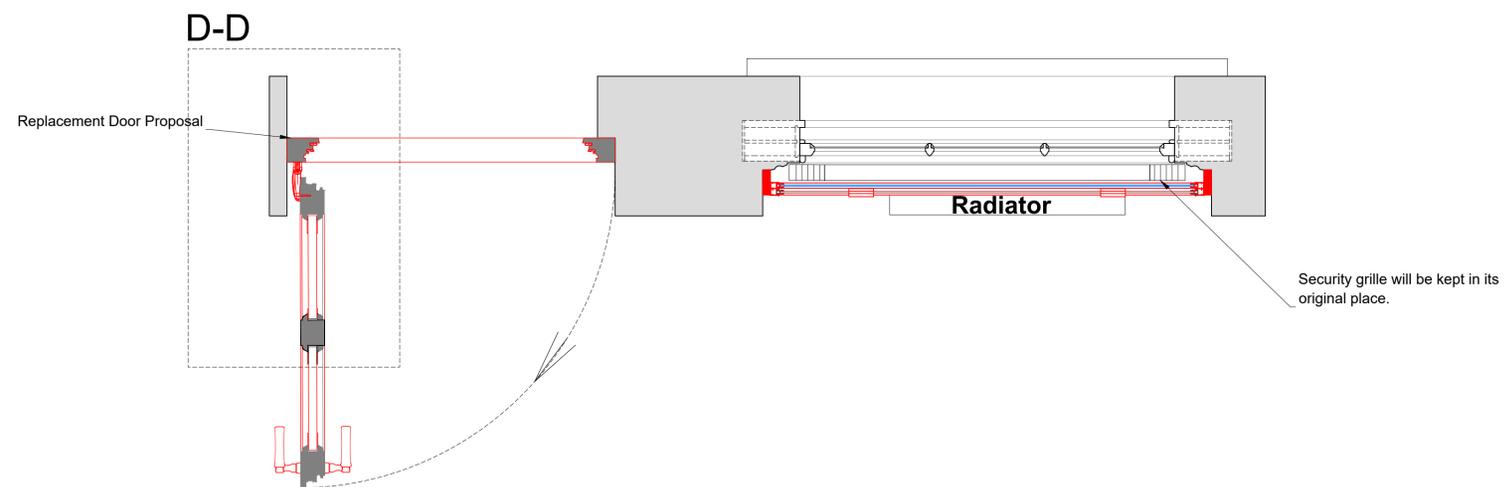

SECONDARY GLAZING SHOWN IN RED FOR VISUAL CLARITY ONLY

Revision	Date	Amendment
1.0	13-12-2019	Issued for listed building consent application

Do not reproduce this drawing without written permission
All dimensions are in millimetres unless stated otherwise

Drawing Not For Construction

HS2

High Speed (HS2) Limited
1st-3rd Floor
The Podium
1 Eversholt Street
London NW1 2DN

COSTAIN SKANSKA

Costain Skanska Joint Venture
9th Floor
The Tower
1 Eversholt Street
London NW1 2DN


Site Address:
70 Delancey Street, London NW1

Drawing Title:
Basement - Bedroom: PROPOSED Secondary Glazing Details - Sheet 2 of 3


Drawn by: AP & PB
Checked by: OB
Presentation Scale: as shown @ A1

Date: 27-05-2019
Drawing No: WPI P066B NI - 70 DeS-PR-BS-J-01.1
Revision: 1.0


Section D-D
Scale: 1:5 on A1

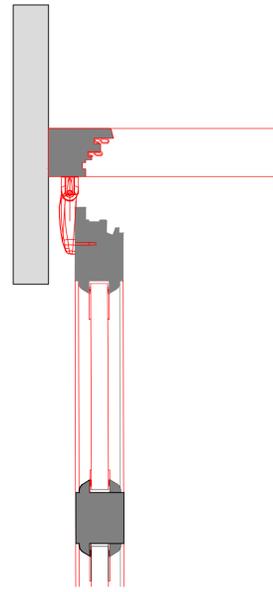


Section E-E
Scale: 1:5 on A1

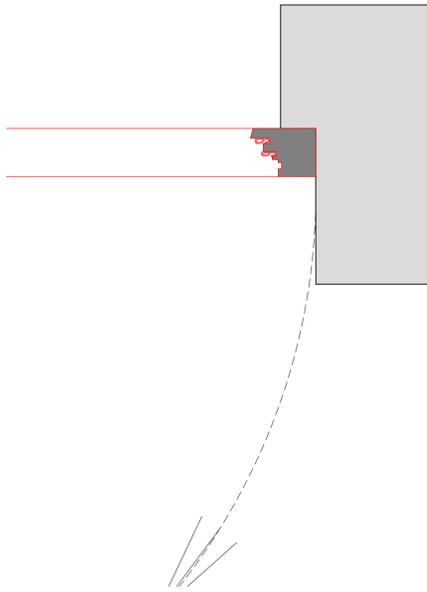


Section H-H
Scale: 1:5 on A1

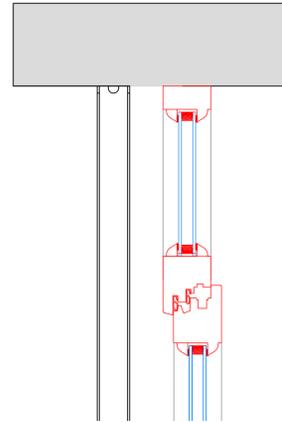


Section K-K
Scale: 1:5 on A1

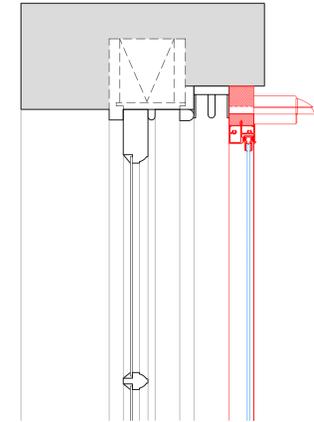


Section I-I
Scale: 1:5 on A1

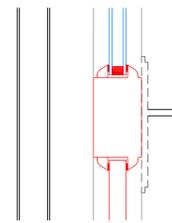


Section L-L
Scale: 1:5 on A1

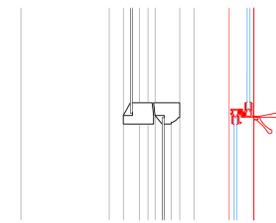


Section F-F
Scale: 1:5 on A1

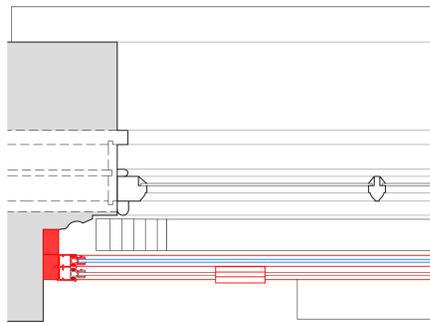


Section G-G
Scale: 1:5 on A1

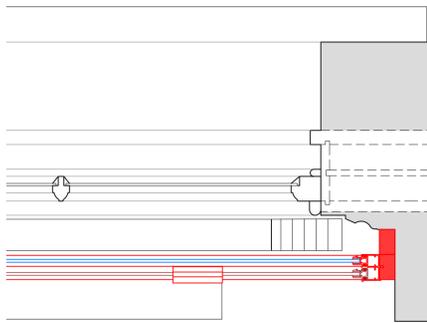

Section J-J
Scale: 1:5 on A1

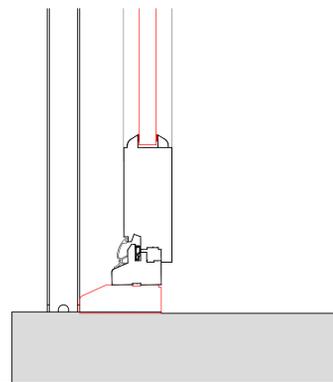

Section M-M
Scale: 1:5 on A1

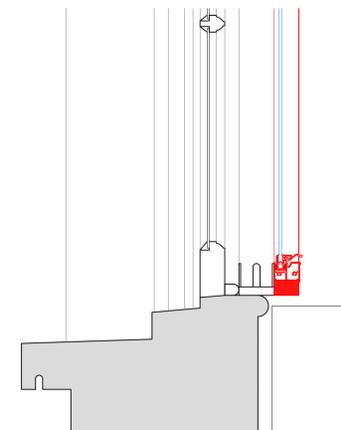

SECONDARY GLAZING SHOWN IN RED FOR VISUAL CLARITY ONLY

Revision	Date	Amendment
1.0	13-12-2019	Issued for listed building consent application

Do not reproduce this drawing without written permission
All dimensions are in millimetres unless stated otherwise

Drawing Not For Construction

HS2

High Speed (HS2) Limited
1st-3rd Floor
The Podium
1 Eversholt Street
London NW1 2DN

COSTAIN SKANSKA

Costain Skanska Joint Venture
9th Floor
The Tower
1 Eversholt Street
London NW1 2DN

Site Address:
70 Delancey Street, London NW1


Drawing Title:
Basement - Bedroom: PROPOSED Secondary Glazing Details -
Sheet 3 of 3

Drawn by: AP & PB
Checked by: PB
Presentation Scale: 1:5 @ A1

Date: 27-05-2019
Drawing No: WPI P066B NI - 70 DeS-PR-BS-J-01.2
Revision: 1.0


Internal Room Elevation

Scale: 1:10

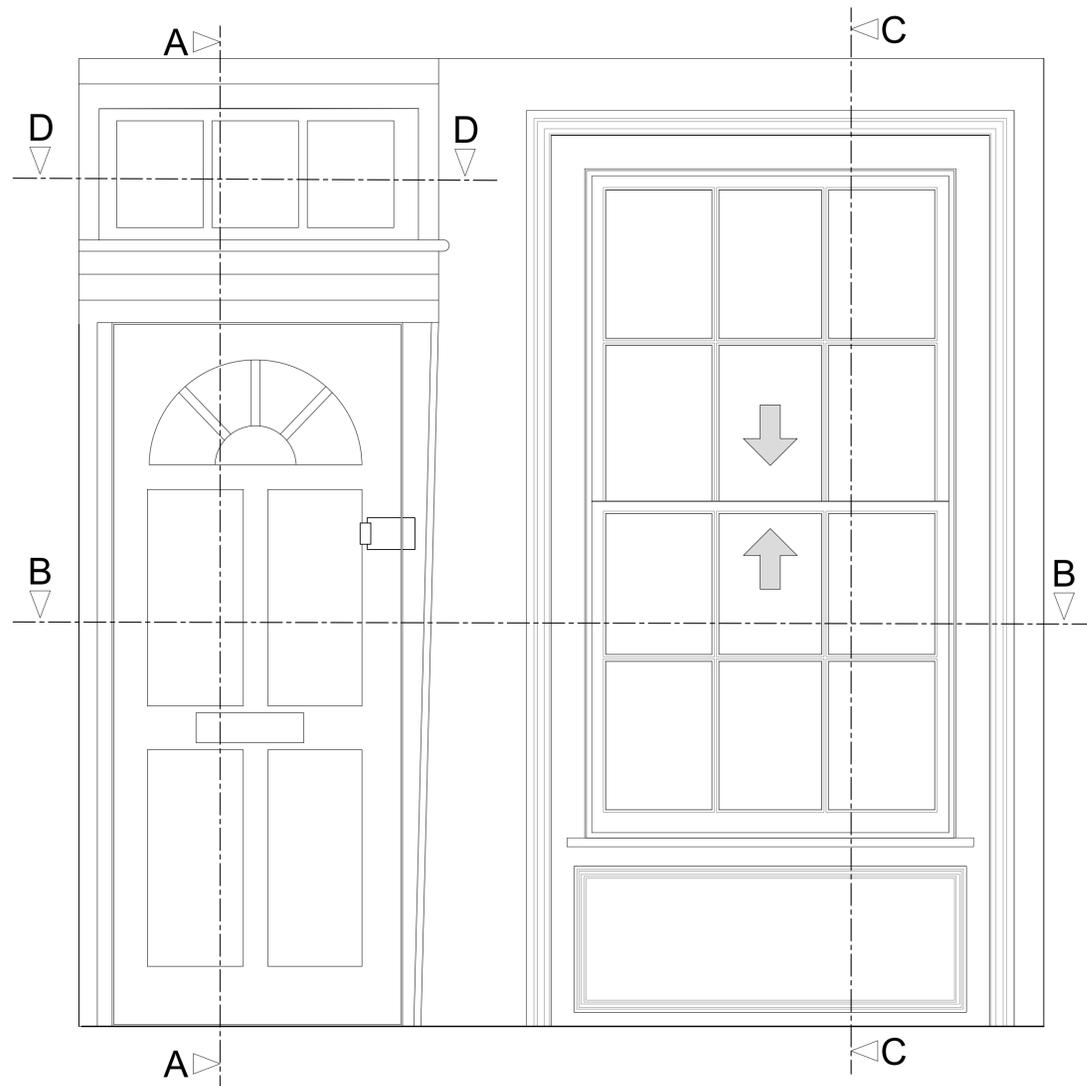


Section A-A through External Wall

Scale: 1:10

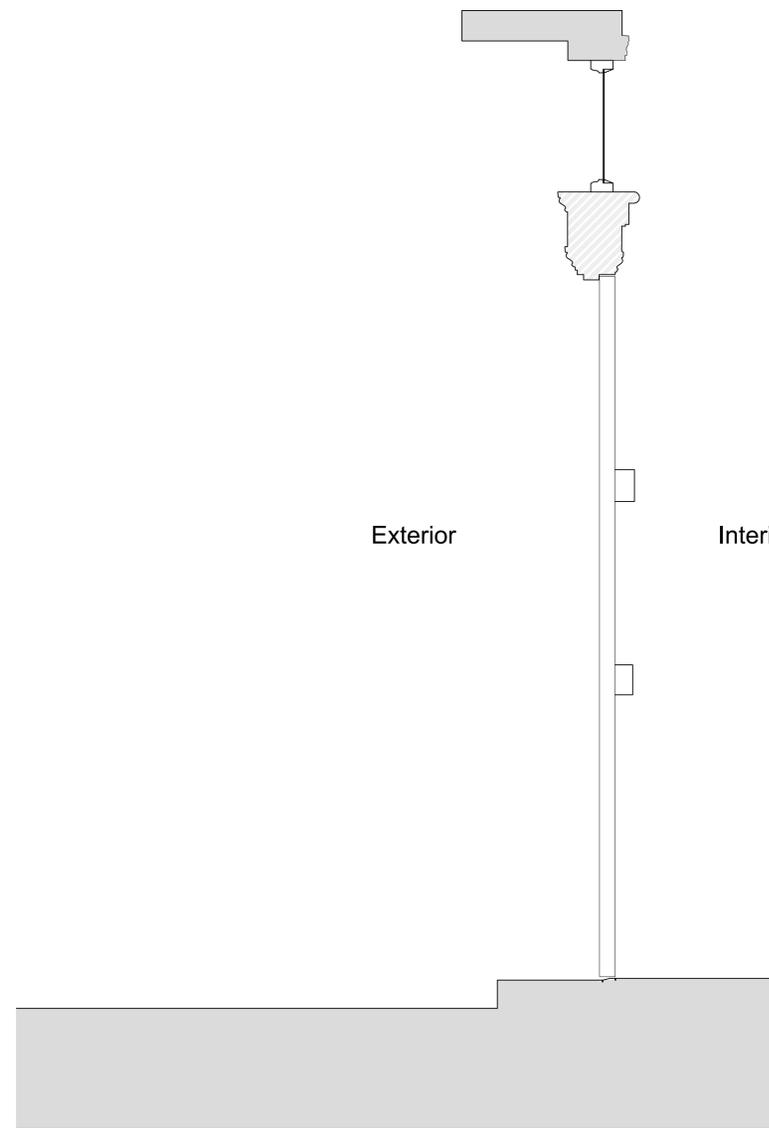


Section C-C through External Wall

Scale: 1:10

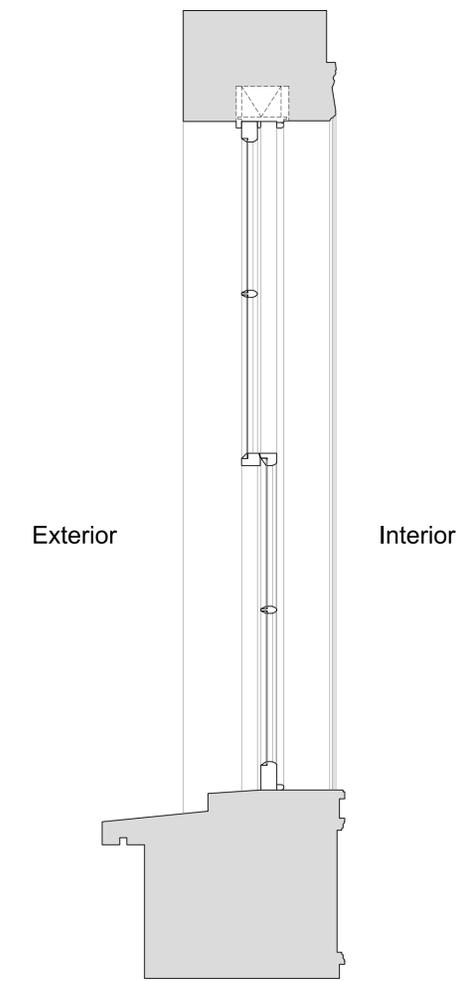


Plan Section B-B

Scale: 1:10

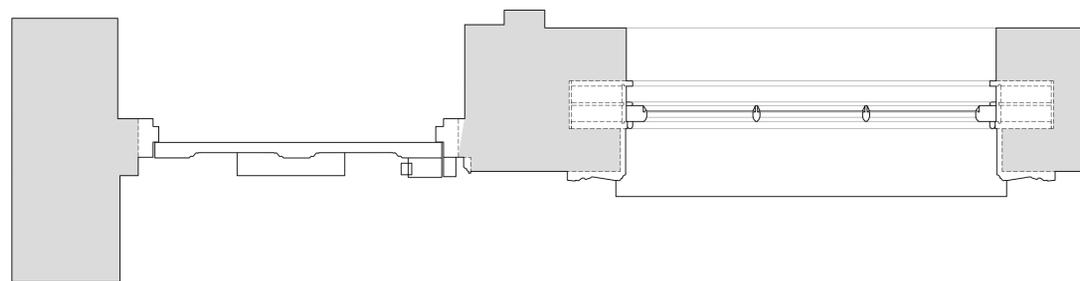

Plan Section D-D

Scale: 1:10

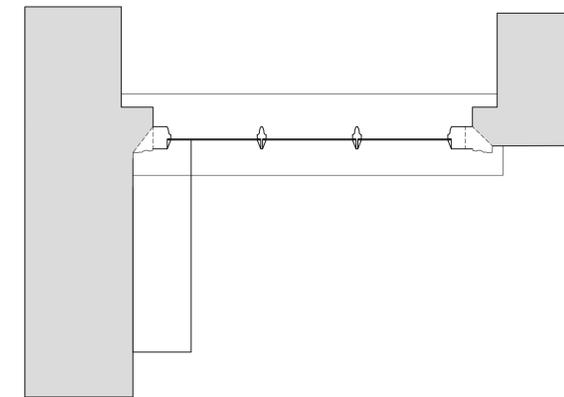

Revision	Date	Amendment
1.0	13-12-2019	Issued for listed building consent application

Do not reproduce this drawing without written permission
All dimensions are in millimetres unless stated otherwise

Drawing Not For Construction

HS2

High Speed (HS2) Limited
1st-3rd Floor
The Podium
1 Eversholt Street
London NW1 2DN


COSTAIN SKANSKA

Costain Skanska Joint Venture
9th Floor
The Tower
1 Eversholt Street
London NW1 2DN

Site Address: 70 Delancey Street, London NW1			
Drawing Title: Ground Floor - Sitting Room: EXISTING Front Window Joinery Details - Sheet 1 of 3			
Drawn by: AP & PB	Checked by: PB	Reviewed by: OB	Presentation Scale: as shown @ A1
Date: 27-05-2019	Drawing No.:	WPI P066B NI - 70 DeS-EX-GF-J-02	Revision: 1.0


Internal Room Elevation with Secondary Glazing Installed

Scale: 1:10

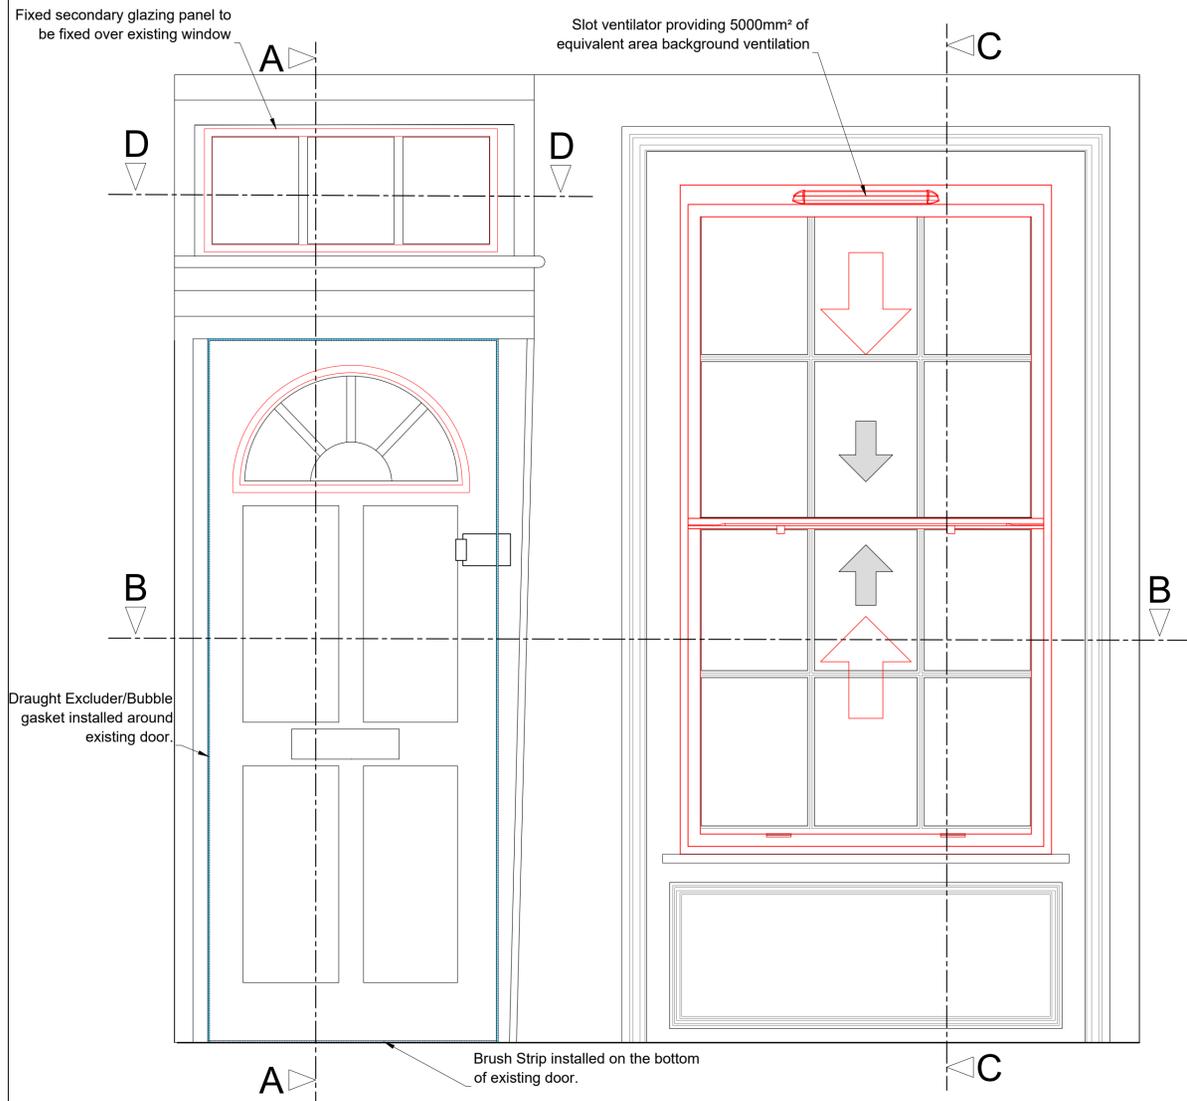


Section A-A & C-C through External Wall with Secondary Glazing Installed

Scale: 1:10

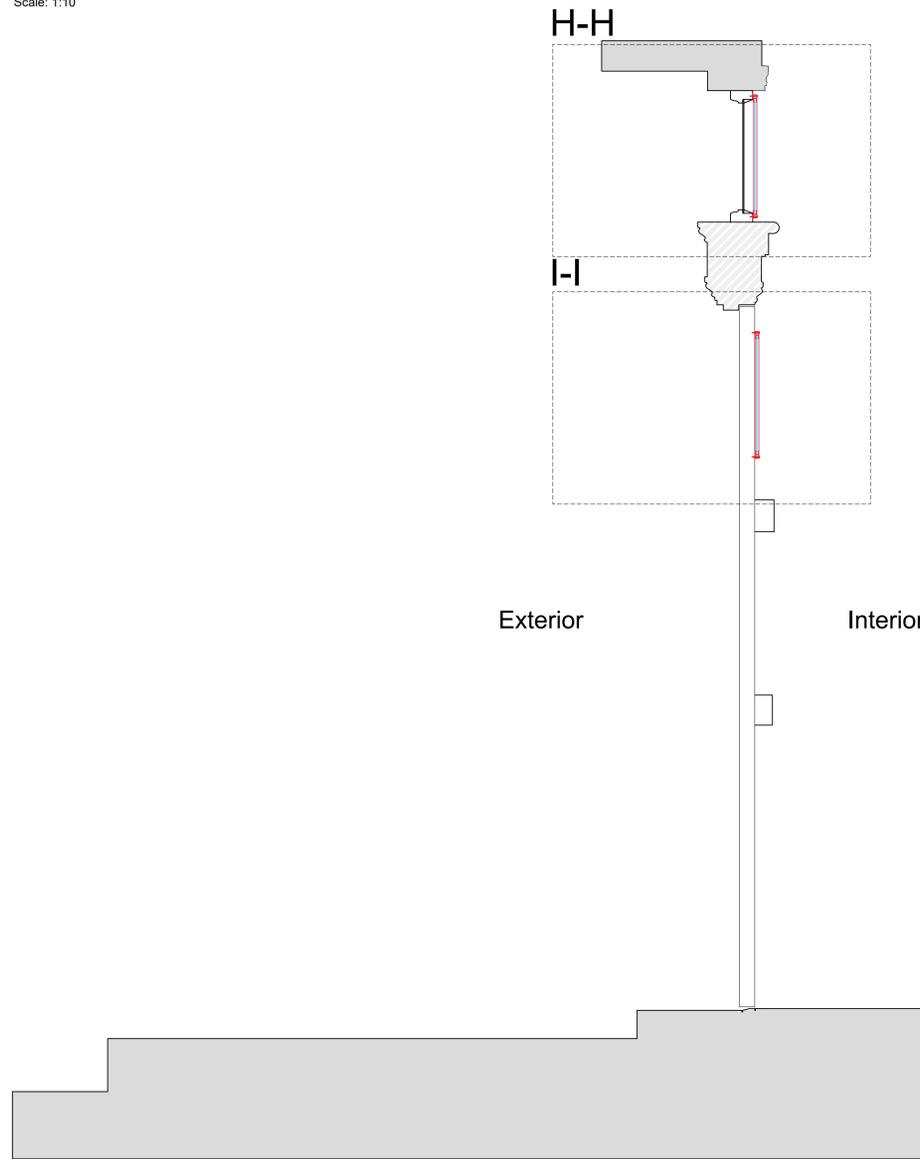


Section A-A & C-C through External Wall with Secondary Glazing Installed

Scale: 1:10

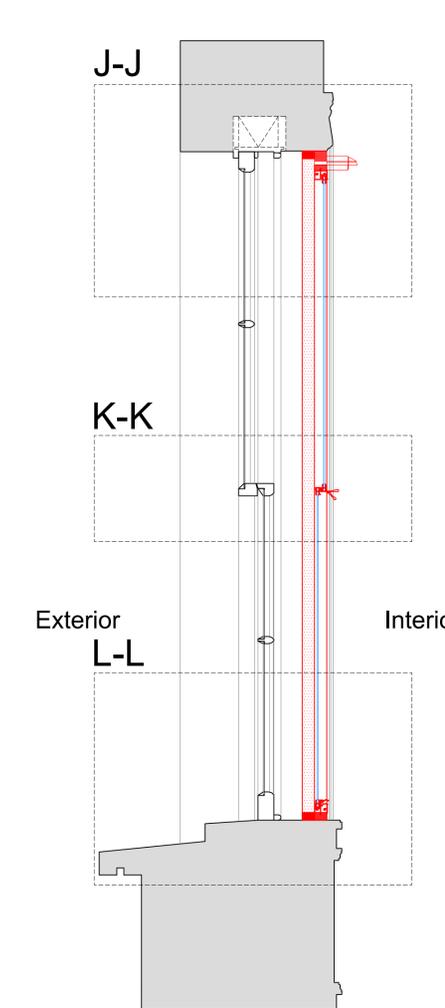


Plan Section B-B with Secondary Glazing Installed

Scale: 1:10

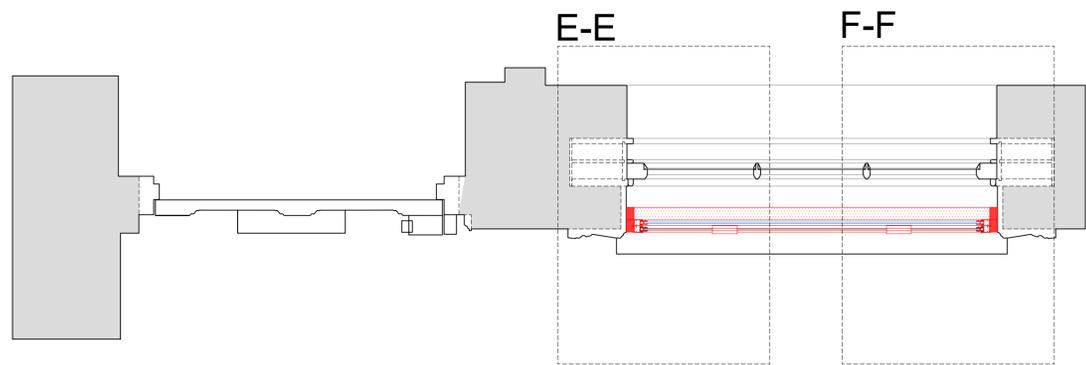

Plan Section D-D with Secondary Glazing Installed

Scale: 1:10

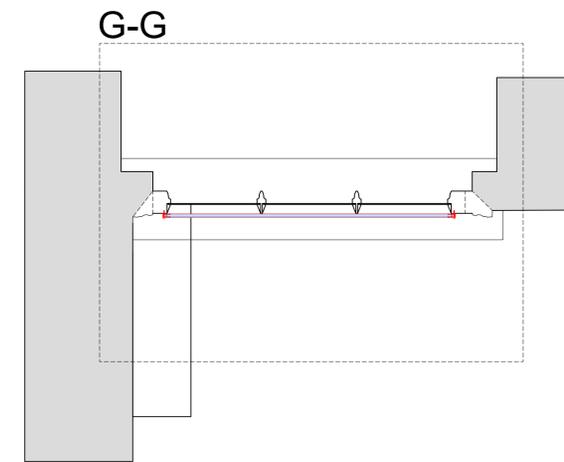

SECONDARY GLAZING SHOWN IN RED FOR VISUAL CLARITY ONLY

Revision	Date	Amendment
1.0	13-12-2019	Issued for listed building consent application

Do not reproduce this drawing without written permission
All dimensions are in millimetres unless stated otherwise

Drawing Not For Construction


HS2
High Speed (HS2) Limited
1st-3rd Floor
The Tower
1 Eversholt Street
London NW1 2DN

COSTAIN SKANSKA
Costain Skanska Joint Venture
9th Floor
The Tower
1 Eversholt Street
London NW1 2DN

Site Address: 70 Delancey Street, London NW1			
Drawing Title: Ground Floor - Sitting Room: PROPOSED Secondary Glazing Details - Sheet 2 of 3			
Approved by: AP & PB	Drawn by: PB	Checked by: OB	Presentation Scale: as shown @ A1
Date: 27-05-2019	Drawing No: WPI P066B NI - 70 DeS-PR-GF-J-02.1	Revision: 1.0	


Section E-E

Scale: 1:5 on A1

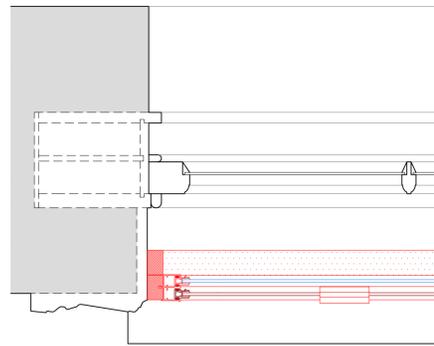


Section F-F

Scale: 1:5 on A1

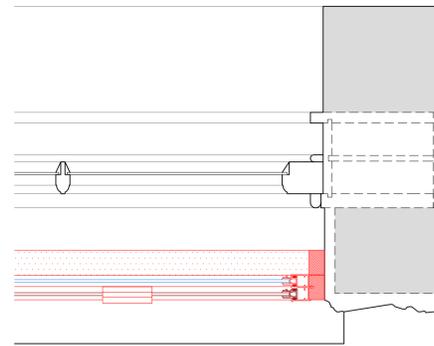


Section H-H

Scale: 1:5 on A1

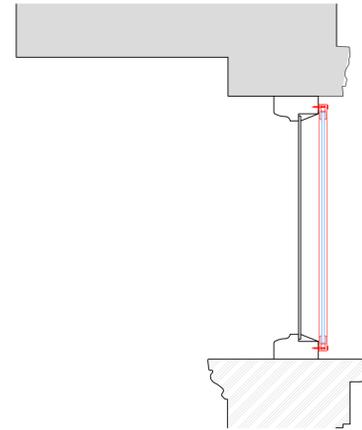


Section I-I

Scale: 1:5 on A1

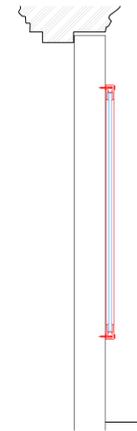


Section J-J

Scale: 1:5 on A1

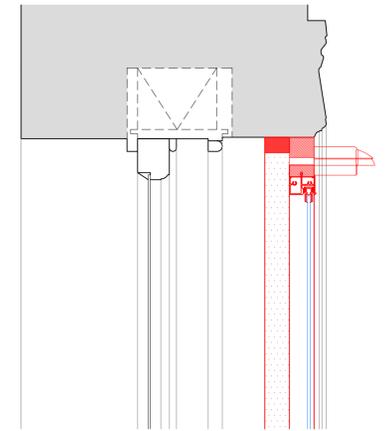


Section K-K

Scale: 1:5 on A1

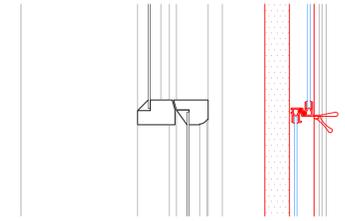


Section L-L

Scale: 1:5 on A1

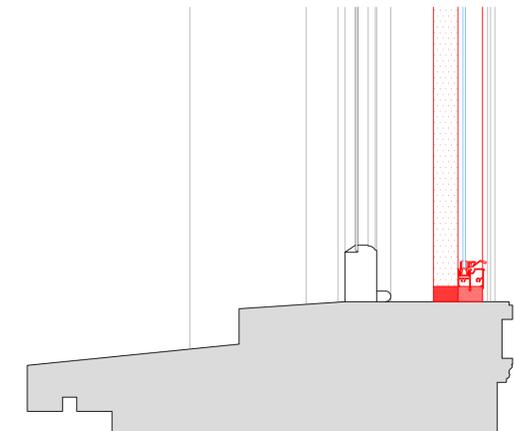

Section G-G

Scale: 1:5 on A1

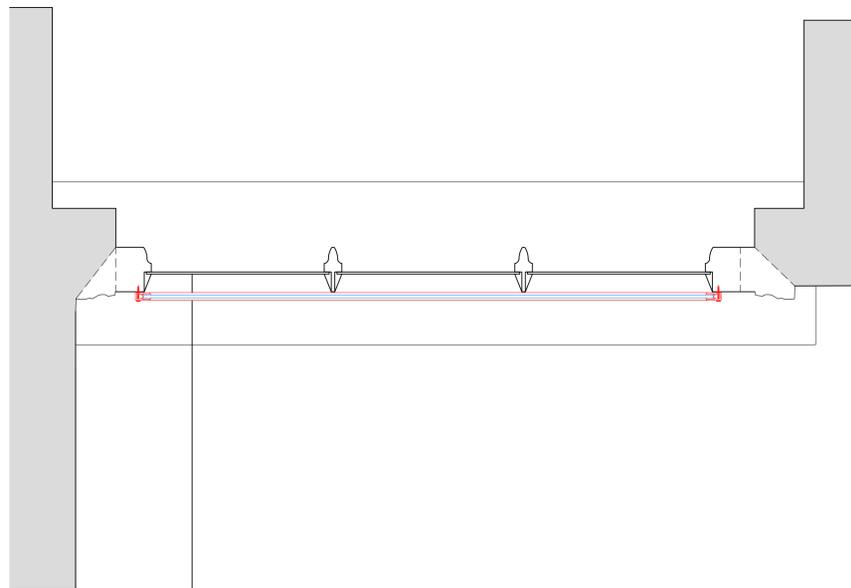

SECONDARY GLAZING SHOWN IN RED FOR VISUAL CLARITY ONLY

Revision	Date	Amendment
1.0	13-12-2019	Issued for listed building consent application

Do not reproduce this drawing without written permission
All dimensions are in millimetres unless stated otherwise

Drawing Not For Construction

HS2


High Speed (HS2) Limited
1st-3rd Floor
The Podium
1 Eversholt Street
London NW1 2DN

COSTAIN SKANSKA


Costain Skanska Joint Venture
9th Floor
The Tower
1 Eversholt Street
London NW1 2DN

Site Address: 70 Delancey Street, London NW1			
Drawing Title: Ground Floor - Sitting Room: PROPOSED Secondary Glazing Details - Sheet 3 of 3			
Submitted by: AP & PB	Drawn by: PB	Checked by: OB	Presentation Scale: 1:5 @ A1
Date: 27-05-2019	Drawing No.:	WPI P066B NI - 70 DeS-PR-GF-J-02.2	Revision: 1.0

Internal Room Elevation
Scale: 1:10

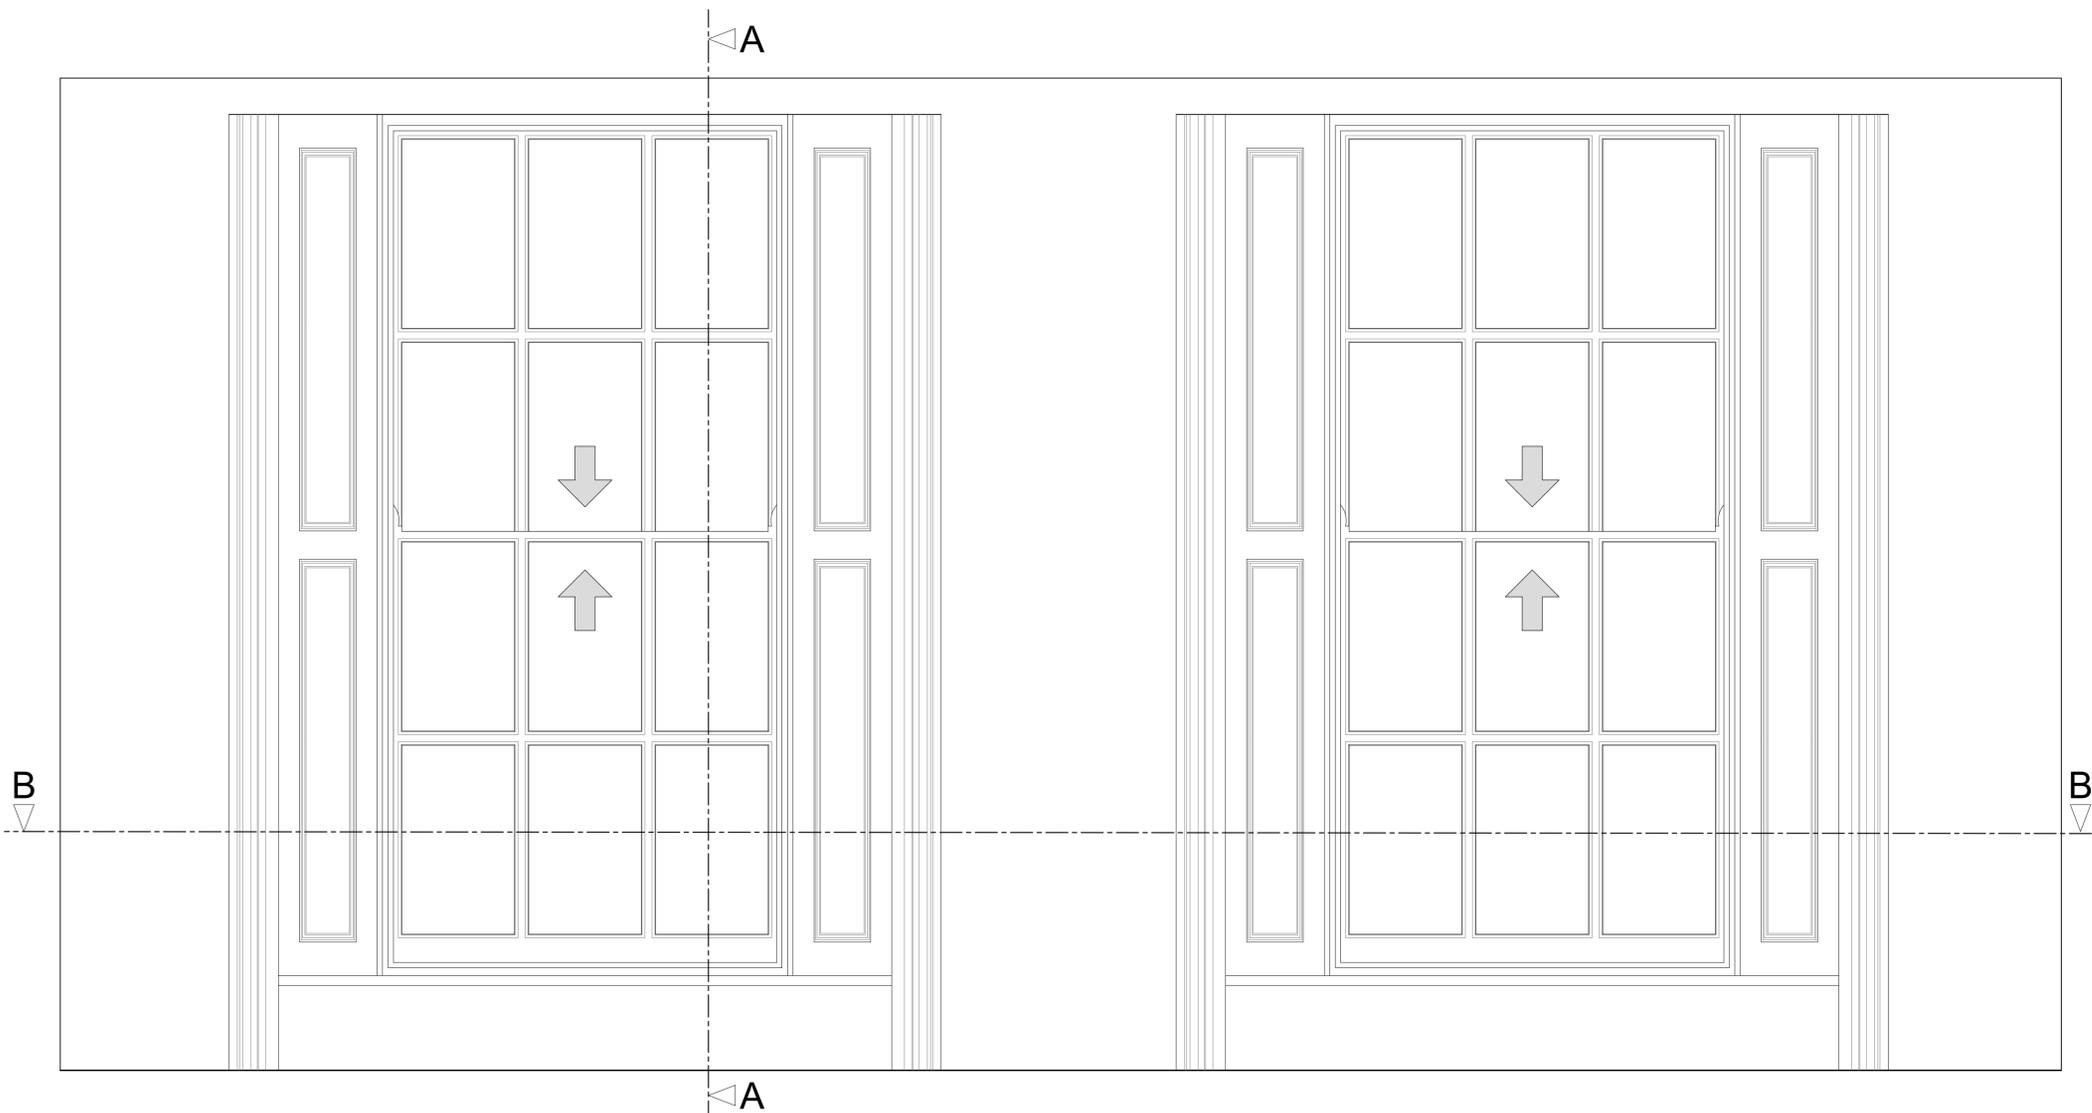

Section A-A through External Wall
Scale: 1:10

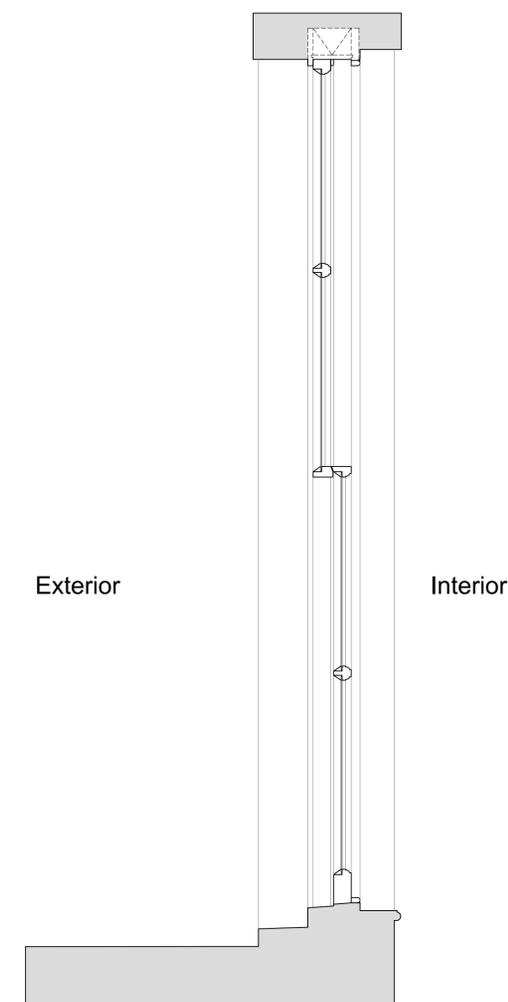

Plan Section B-B
Scale: 1:10



Revision	Date	Amendment
1.0	13-12-2019	Issued for listed building consent application

Do not reproduce this drawing without written permission
All dimensions are in millimetres unless stated otherwise


Drawing Not For Construction

HS2
High Speed (HS2) Limited
1st-3rd Floor
The Podium
1 Eversholt Street
London NW1 2DN


COSTAIN SKANSKA
Costain Skanska Joint Venture
9th Floor
The Tower
1 Eversholt Street
London NW1 2DN

Site Address: 70 Delancey Street, London NW1			
Drawing Title: First Floor - Bedroom: EXISTING Front Window Joinery Details - Sheet 1 of 3			
Drawn by: AP & PB	Checked by: AP	Reviewed by: OB	Presentation Scale: as shown @ A1
Date: 27-05-2019	Drawing No: WPI P066B NI - 70 DeS-EX-FF-J-03	Revision: 1.0	


Internal Room Elevation with Secondary Glazing Installed
Scale: 1:10

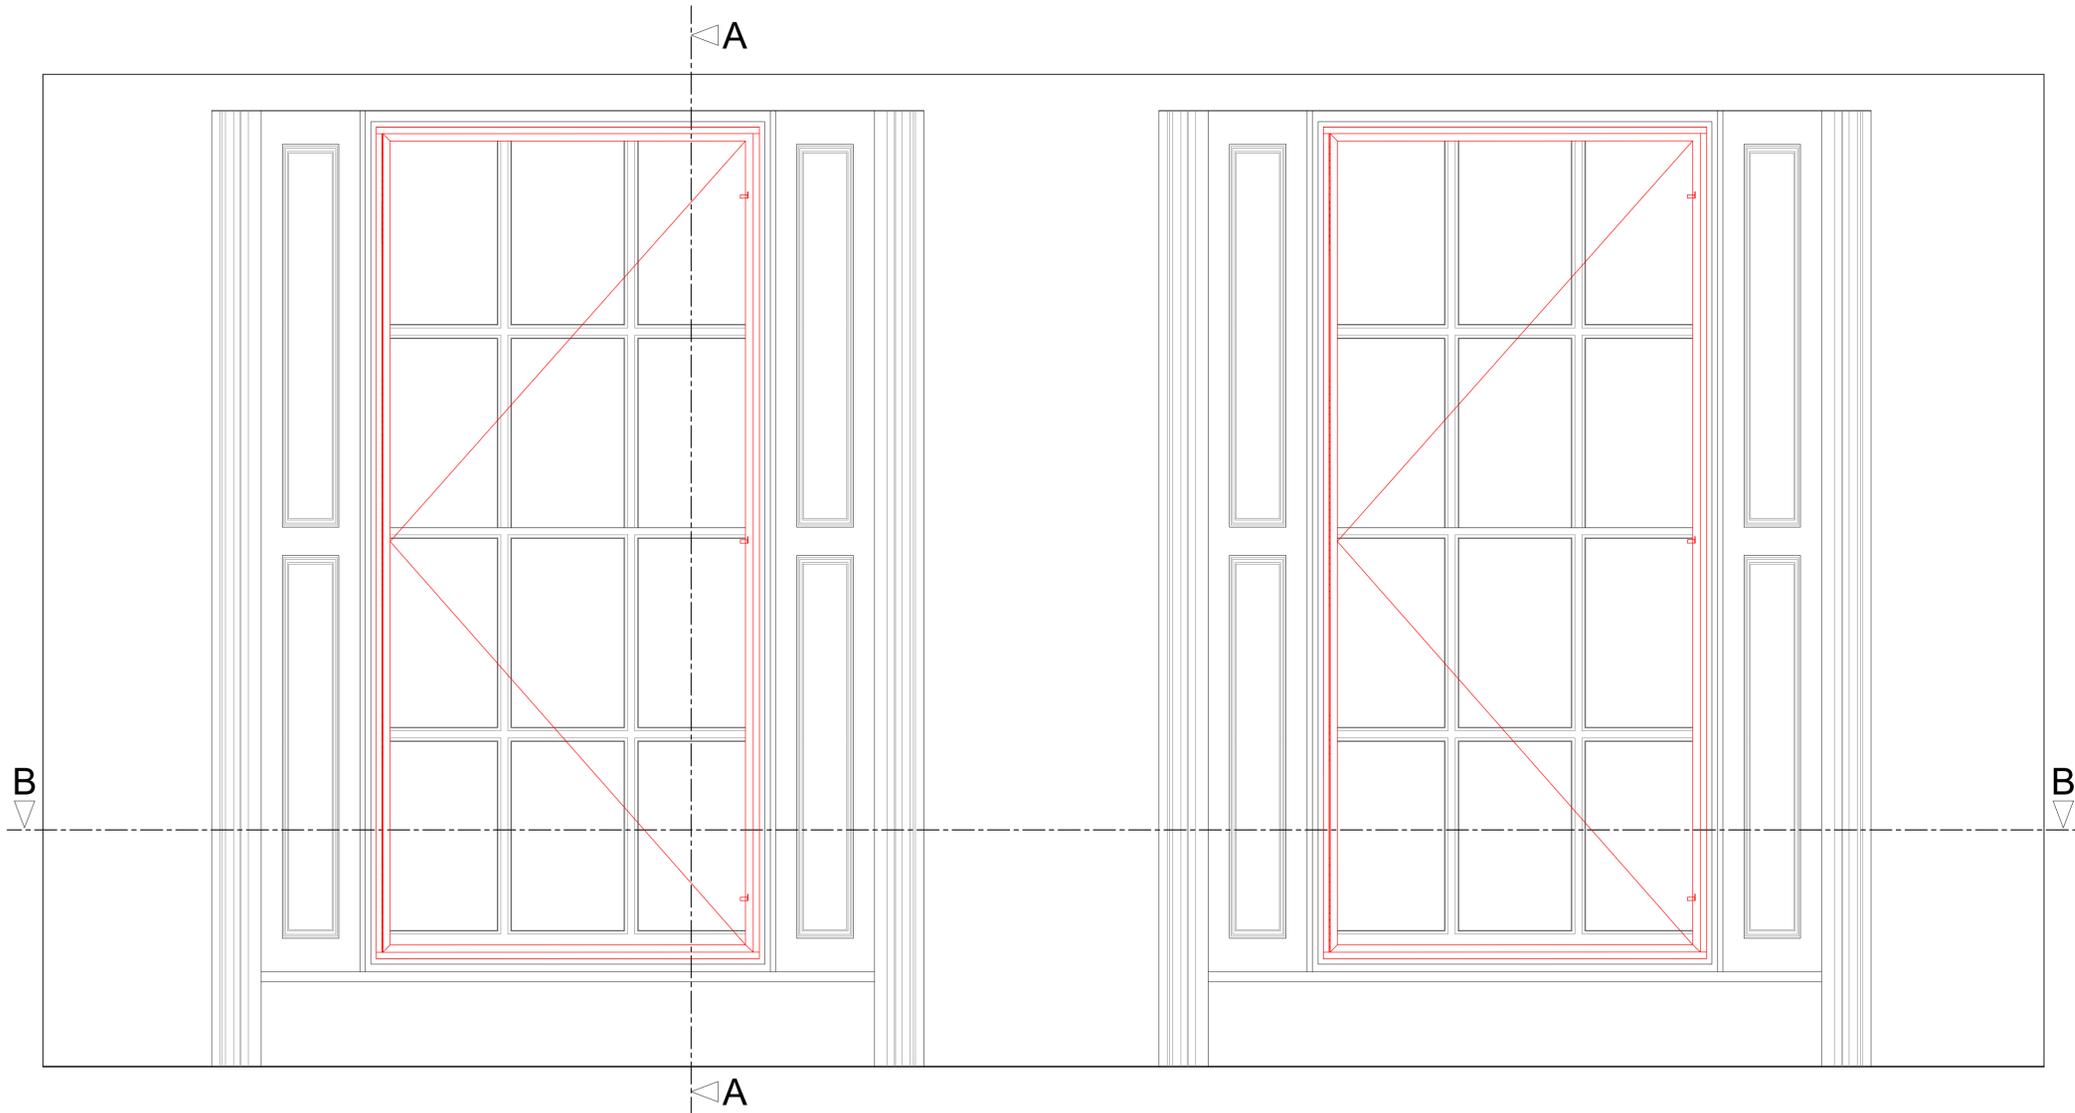

Section A-A through External Wall with Secondary Glazing Installed
Scale: 1:10

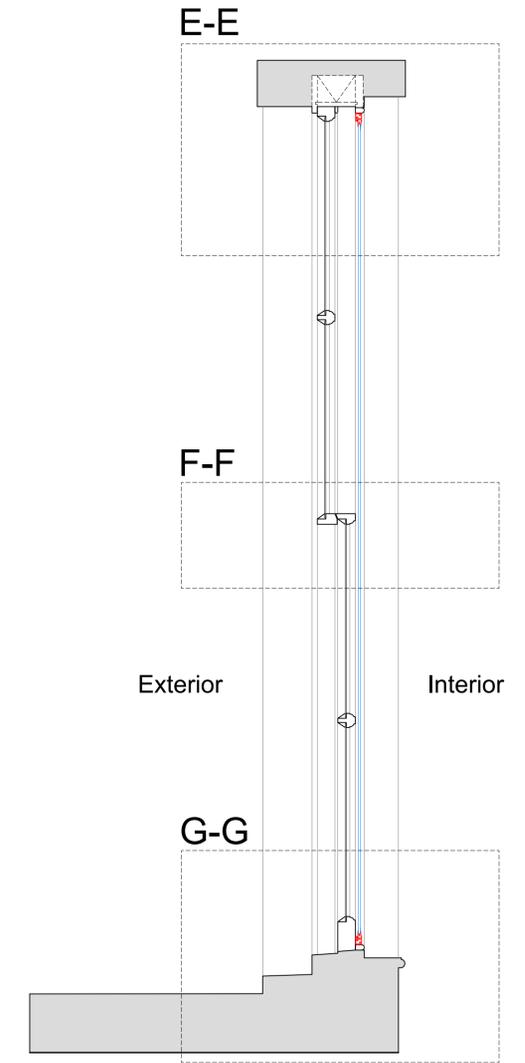

Plan Section B-B with Secondary Glazing Installed
Scale: 1:10

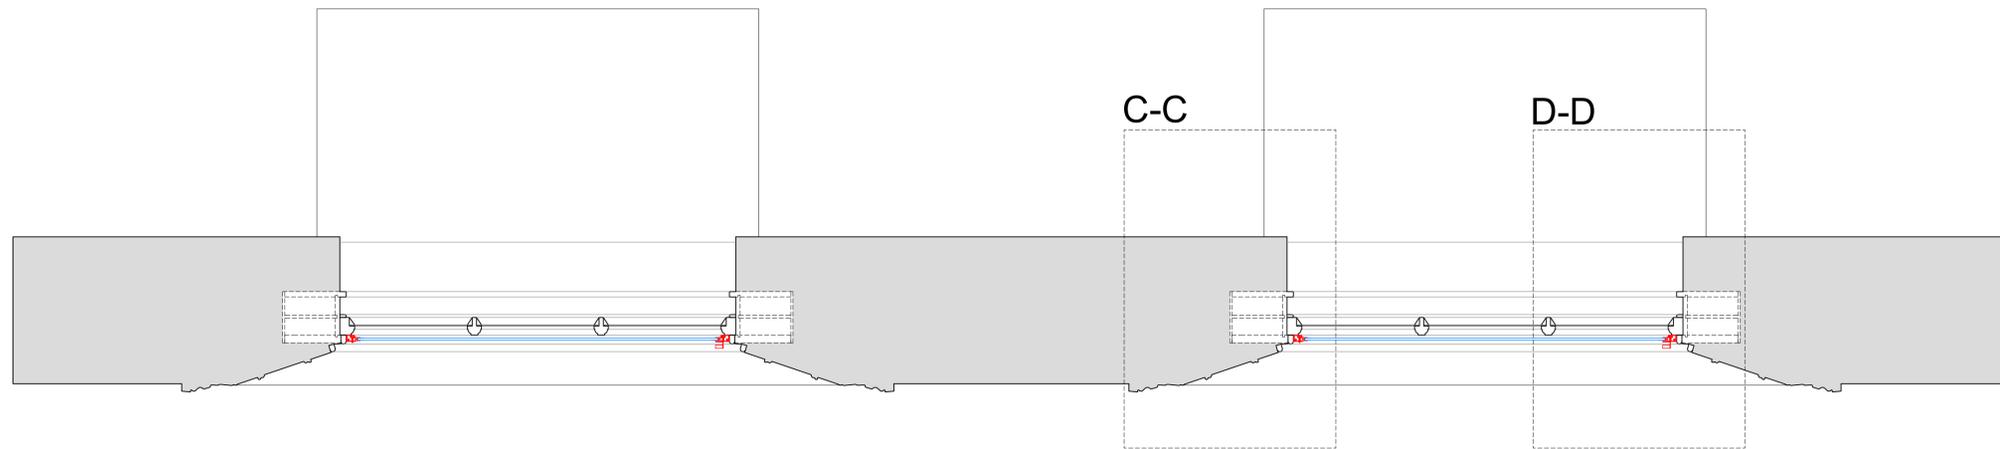

SECONDARY GLAZING SHOWN IN RED FOR VISUAL CLARITY ONLY

Slim Line Solution

Revision	Date	Amendment
1.0	13-12-2019	Issued for listed building consent application

Do not reproduce this drawing without written permission
All dimensions are in millimetres unless stated otherwise

Drawing Not For Construction

HS2


High Speed (HS2) Limited
1st-3rd Floor
The Tower
1 Eversholt Street
London NW1 2DN

COSTAIN SKANSKA


Costain Skanska Joint Venture
9th Floor
The Tower
1 Eversholt Street
London NW1 2DN

Site Address: 70 Delancey Street, London NW1			
Drawing Title: First Floor - Bedroom: PROPOSED Secondary Glazing Details - Sheet 2 of 3			
Drawn by: AP & PB	Drawn by: AP	Checked by: OB	Presentation Scale: as shown @ A1
Date: 27-05-2019	Drawing No: WPI P066B NI - 70 DeS-PR-FF-J-03.1	Revision: 1.0	


Section C-C
Scale: 1:5 on A1

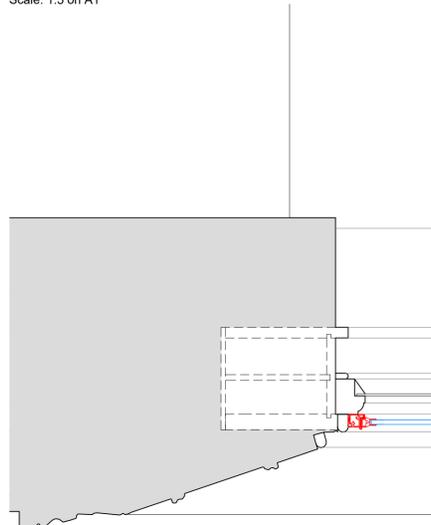


Section D-D
Scale: 1:5 on A1

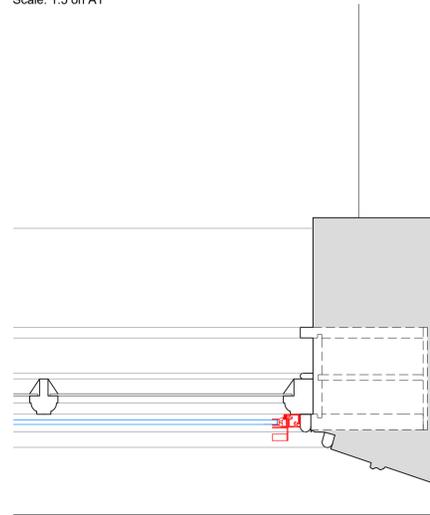


Section E-E
Scale: 1:5 on A1

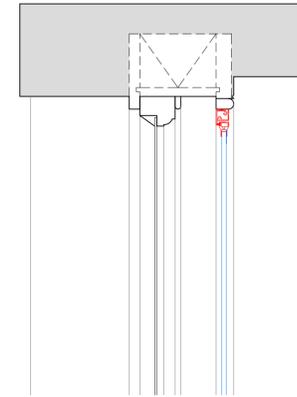

Section F-F
Scale: 1:5 on A1

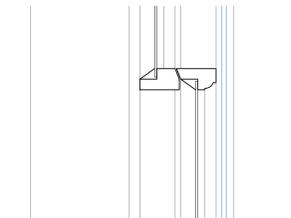

Section G-G
Scale: 1:5 on A1

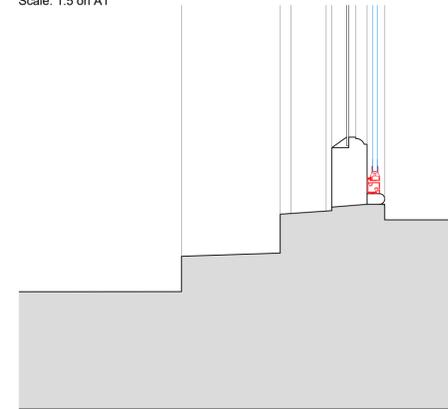

SECONDARY GLAZING SHOWN IN RED FOR VISUAL CLARITY ONLY

Revision	Date	Assessment
1.0	13-12-2019	Issued for listed building consent application

Do not reproduce this drawing without written permission
All dimensions are in millimetres unless stated otherwise

Drawing Not For Construction

HS2

High Speed (HS2) Limited
1st-3rd Floor
The Podium
1 Eversholt Street
London NW1 2DN

COSTAIN SKANSKA

Costain Skanska Joint Venture
9th Floor
The Tower
1 Eversholt Street
London NW1 2DN


Site Address:
70 Delancey Street, London NW1

Drawing Title:
First Floor - Bedroom: PROPOSED Secondary Glazing Details -
Sheet 3 of 3


Drawn by: AP & PB Drawn by: AP Checked by: OB Presentation Scale: 1:5 @ A1

Date: 27-05-2019 Drawing No: WPI P066B NI - 70 DeS-PR-FF-J-03.2 Revision: 1.0

Internal Room Elevation
Scale: 1:10

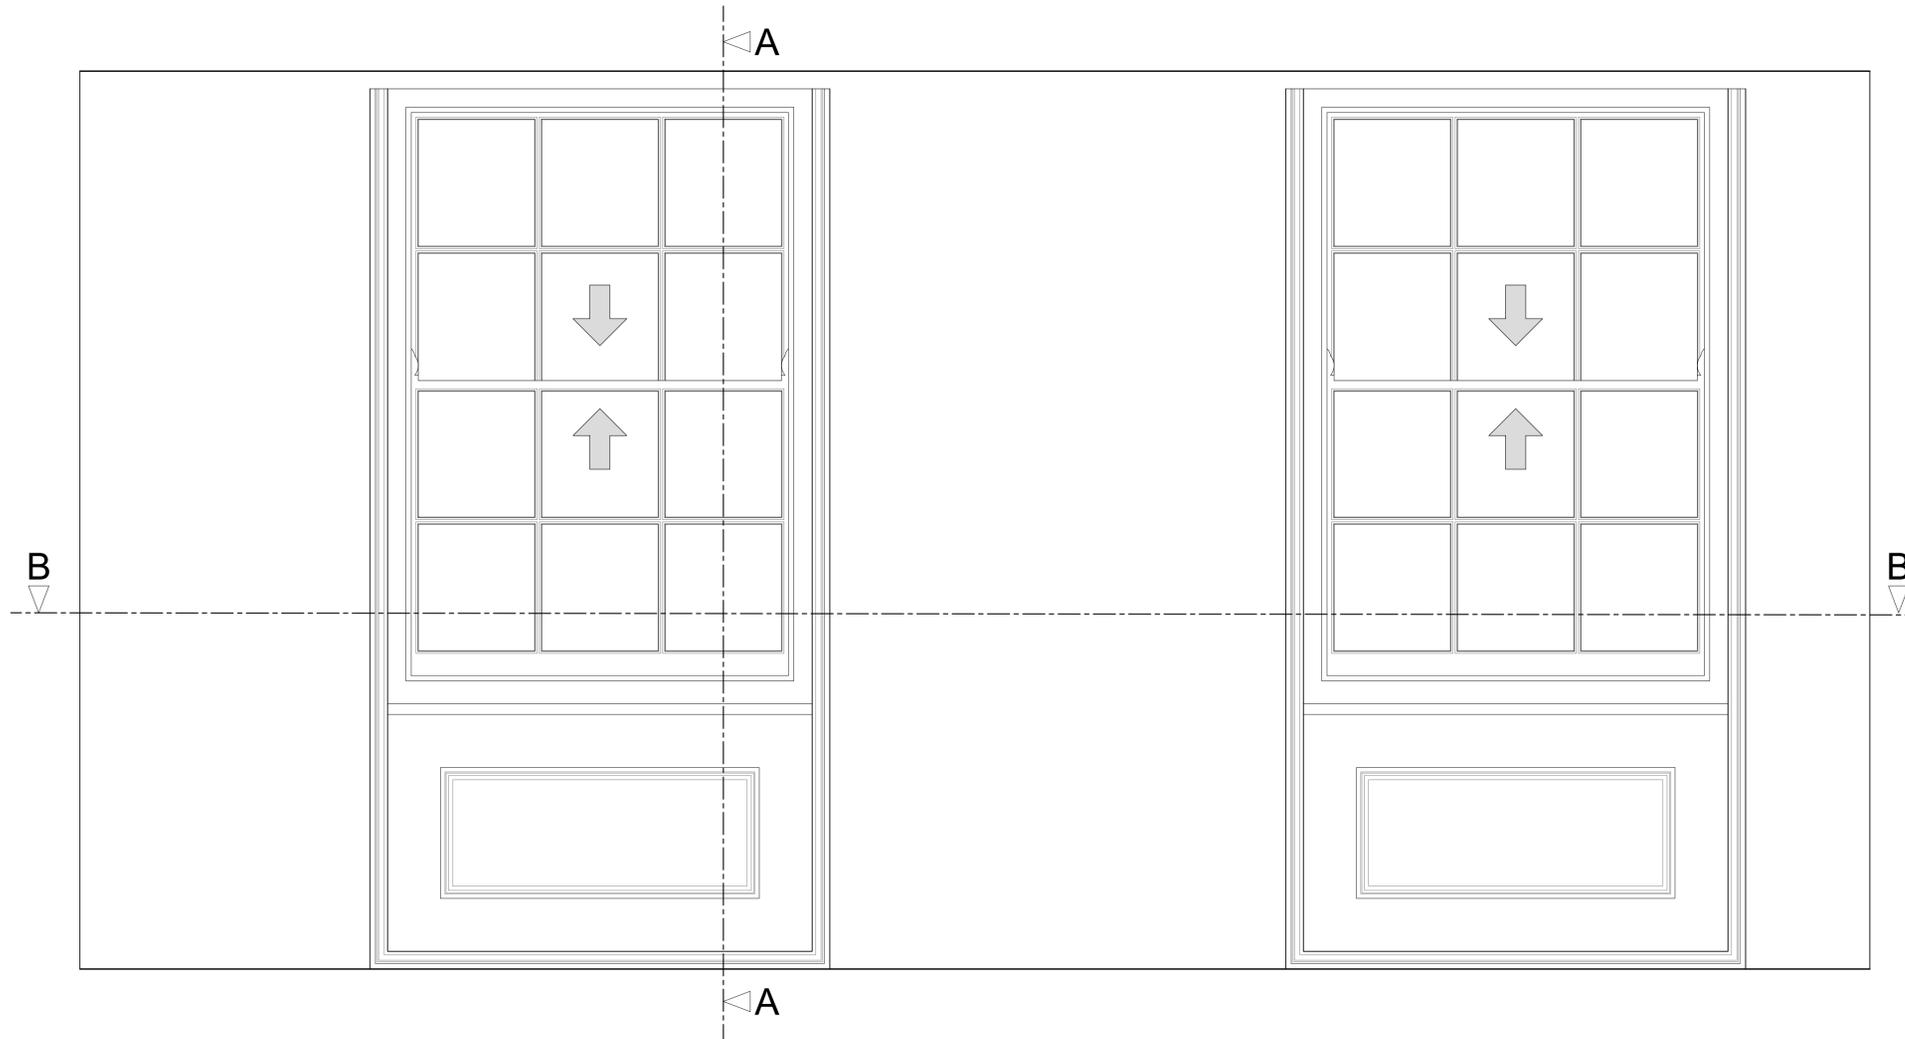

Section A-A through External Wall
Scale: 1:10

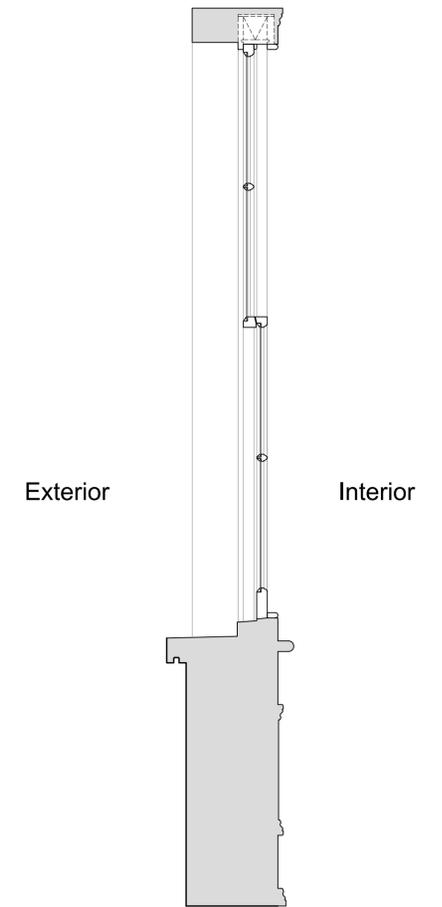

Plan Section B-B
Scale: 1:10



Revision	Date	Amendment
1.0	13-12-2019	Issued for listed building consent application

Do not reproduce this drawing without written permission
All dimensions are in millimetres unless stated otherwise

Drawing Not For Construction

HS2

High Speed (HS2) Limited
1st-3rd Floor
The Podium
1 Eversholt Street
London NW1 2DN

COSTAIN SKANSKA

Costain Skanska Joint Venture
9th Floor
The Tower
1 Eversholt Street
London NW1 2DN


Site Address:
70 Delancey Street, London NW1

Drawing Title:
Second Floor - Bedroom: EXISTING Front Window Joinery Details -
Sheet 1 of 3


Drawn by: AP & PB Drawn by: AP Checked by: OB Presentation Scale: as shown @ A1

Date: 27-05-2019 Drawing No: WPI P066B NI - 70 DeS-EX-SF-J-04 Revision: 1.0


Internal Room Elevation with Secondary Glazing Installed
Scale: 1:10

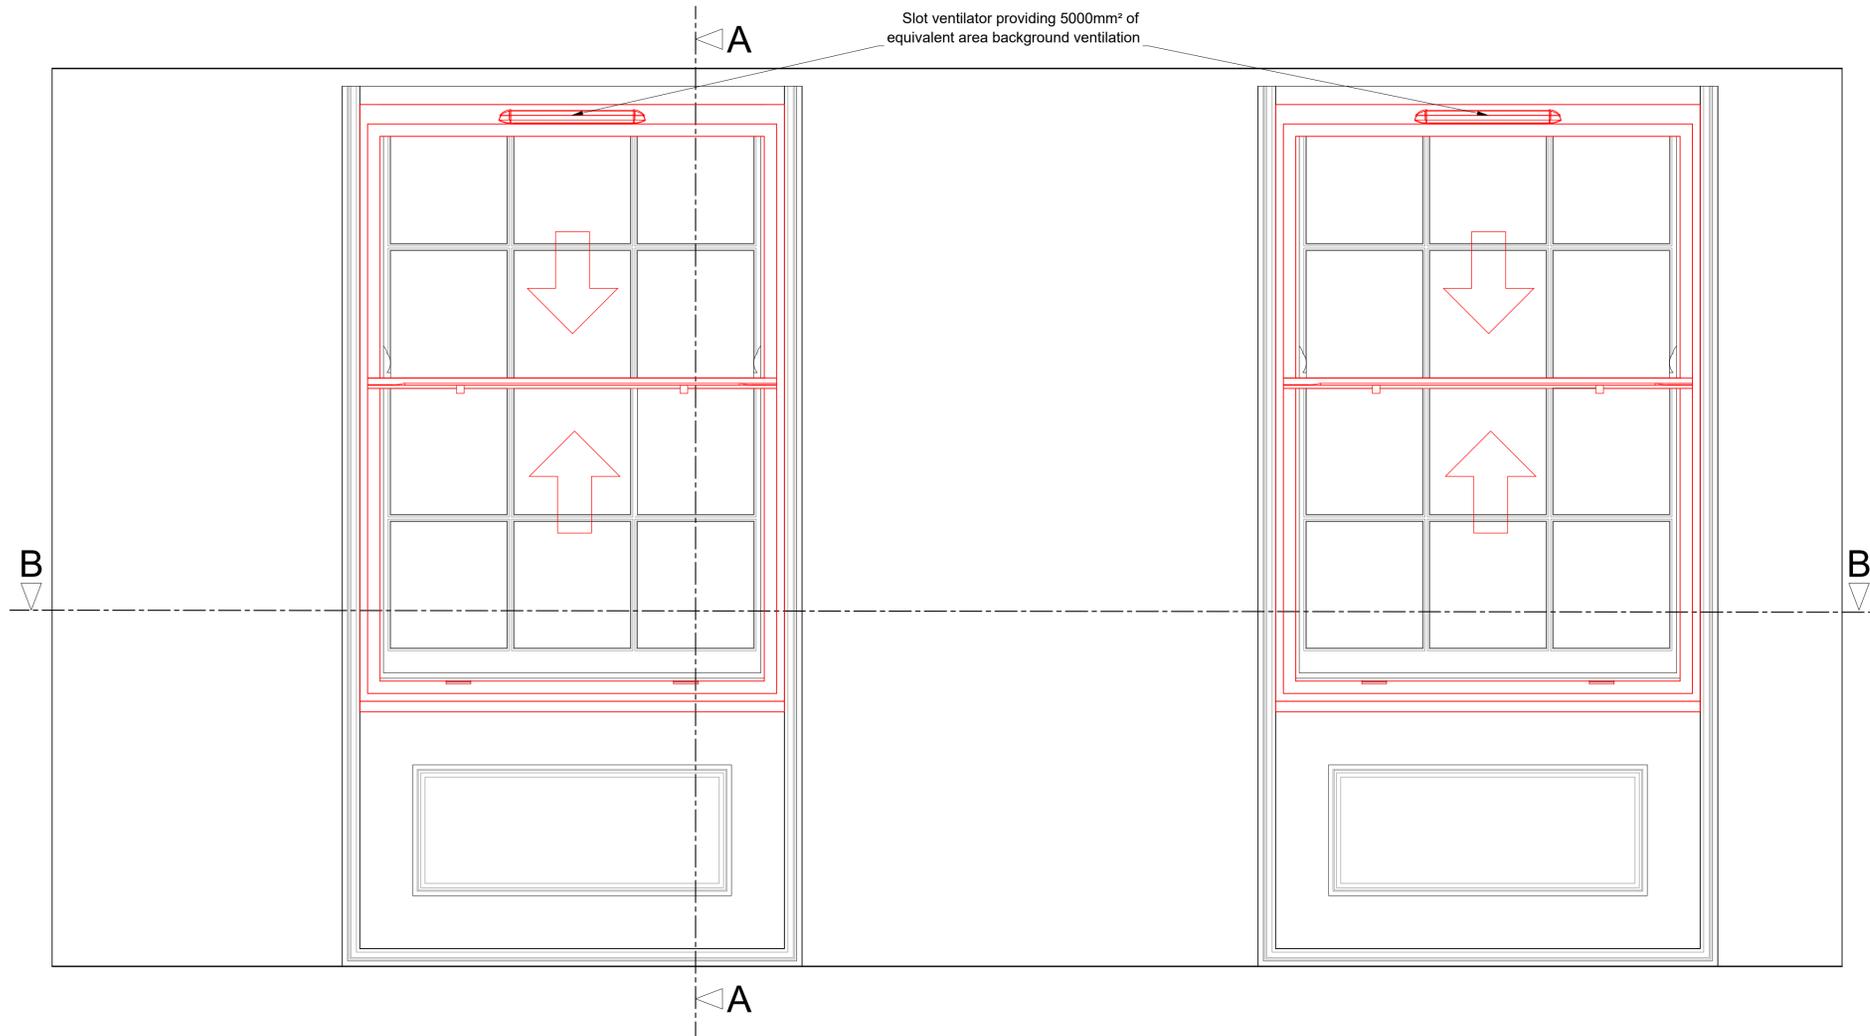

Section A-A through External Wall with Secondary Glazing Installed
Scale: 1:10

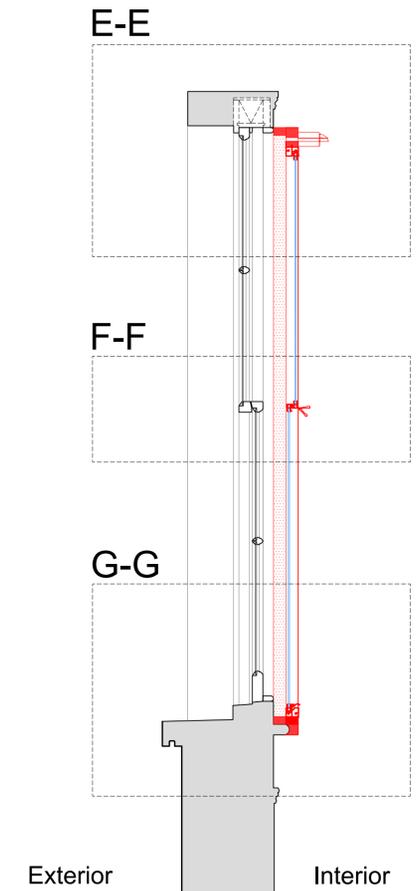

Plan Section B-B with Secondary Glazing Installed
Scale: 1:10

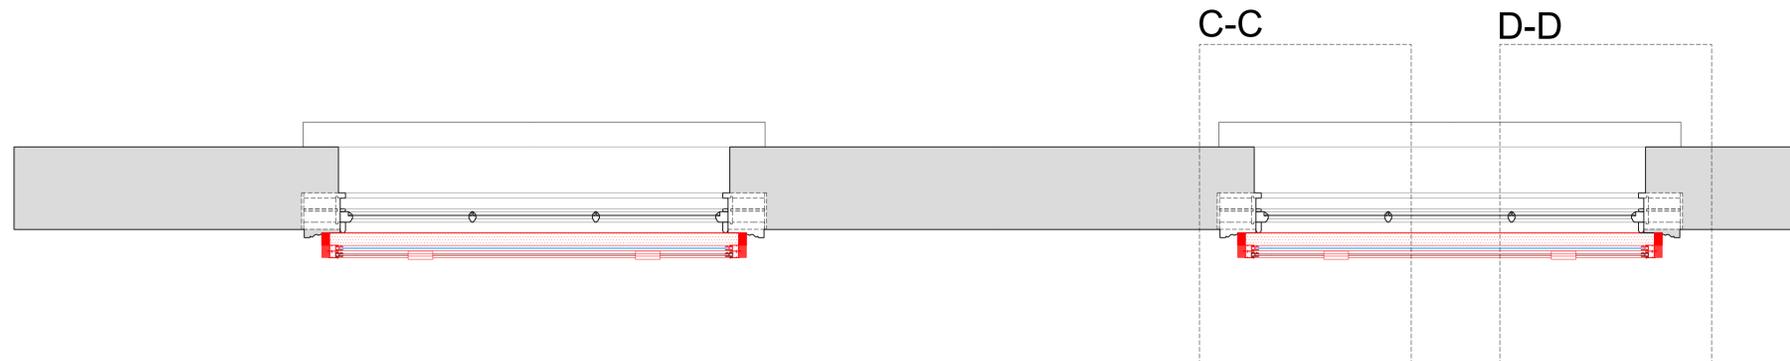

SECONDARY GLAZING SHOWN IN RED FOR VISUAL CLARITY ONLY

Revision	Date	Amendment
1.0	13-12-2019	Issued for listed building consent application

Do not reproduce this drawing without written permission
All dimensions are in millimetres unless stated otherwise

Drawing Not For Construction

HS2


High Speed (HS2) Limited
1st-3rd Floor
The Podium
1 Eversholt Street
London NW1 2DN

COSTAIN SKANSKA


Costain Skanska Joint Venture
9th Floor
The Tower
1 Eversholt Street
London NW1 2DN

Site Address: 70 Delancey Street, London NW1			
Drawing Title: Second Floor - Bedroom: PROPOSED Secondary Glazing Details - Sheet 2 of 3			
Drawn by: AP & PB	Drawn by: AP	Checked by: OB	Presentation Scale: as shown @ A1
Date: 27-05-2019	Drawing No: WPI P066B NI - 70 DeS-PR-SF-J-04.1	Revision: 1.0	


Section C-C
Scale: 1:5 on A1

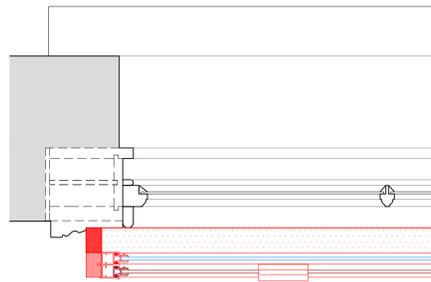


Section D-D
Scale: 1:5 on A1

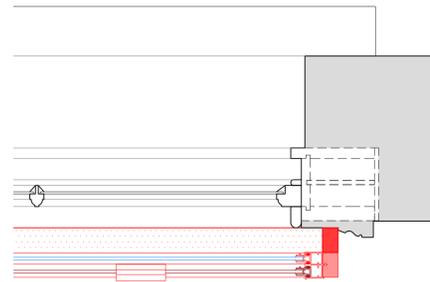


Section E-E
Scale: 1:5 on A1

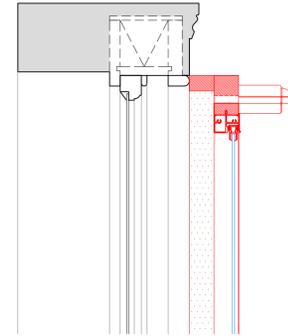

Section F-F
Scale: 1:5 on A1

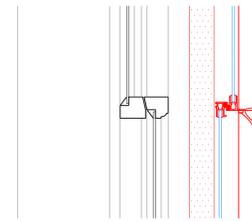

Section G-G
Scale: 1:5 on A1

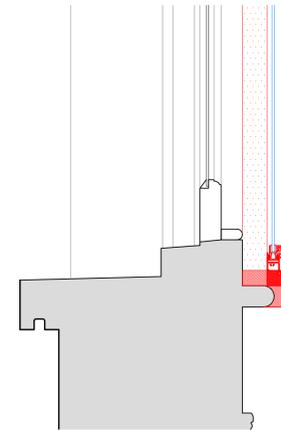

SECONDARY GLAZING SHOWN IN RED FOR VISUAL CLARITY ONLY

Revision	Date	Assessment
1.0	13-12-2019	Issued for listed building consent application

Do not reproduce this drawing without written permission
All dimensions are in millimetres unless stated otherwise

Drawing Not For Construction

HS2


High Speed (HS2) Limited
1st-3rd Floor
The Podium
1 Eversholt Street
London NW1 2DN

COSTAIN SKANSKA


Costain Skanska Joint Venture
9th Floor
The Tower
1 Eversholt Street
London NW1 2DN

Site Address: 70 Delancey Street, London NW1			
Drawing Title: Second Floor - Bedroom: PROPOSED Secondary Glazing Details - Sheet 3 of 3			
Drawn by: AP & PB	Drawn by: AP	Checked by: OB	Presentation Scale: 1:5 @ A1
Date: 27-05-2019	Drawing No: WPI P066B NI - 70 DeS-PR-SF-J-04.2	Revision: 1.0	

Internal Room Elevation
Scale: 1:10

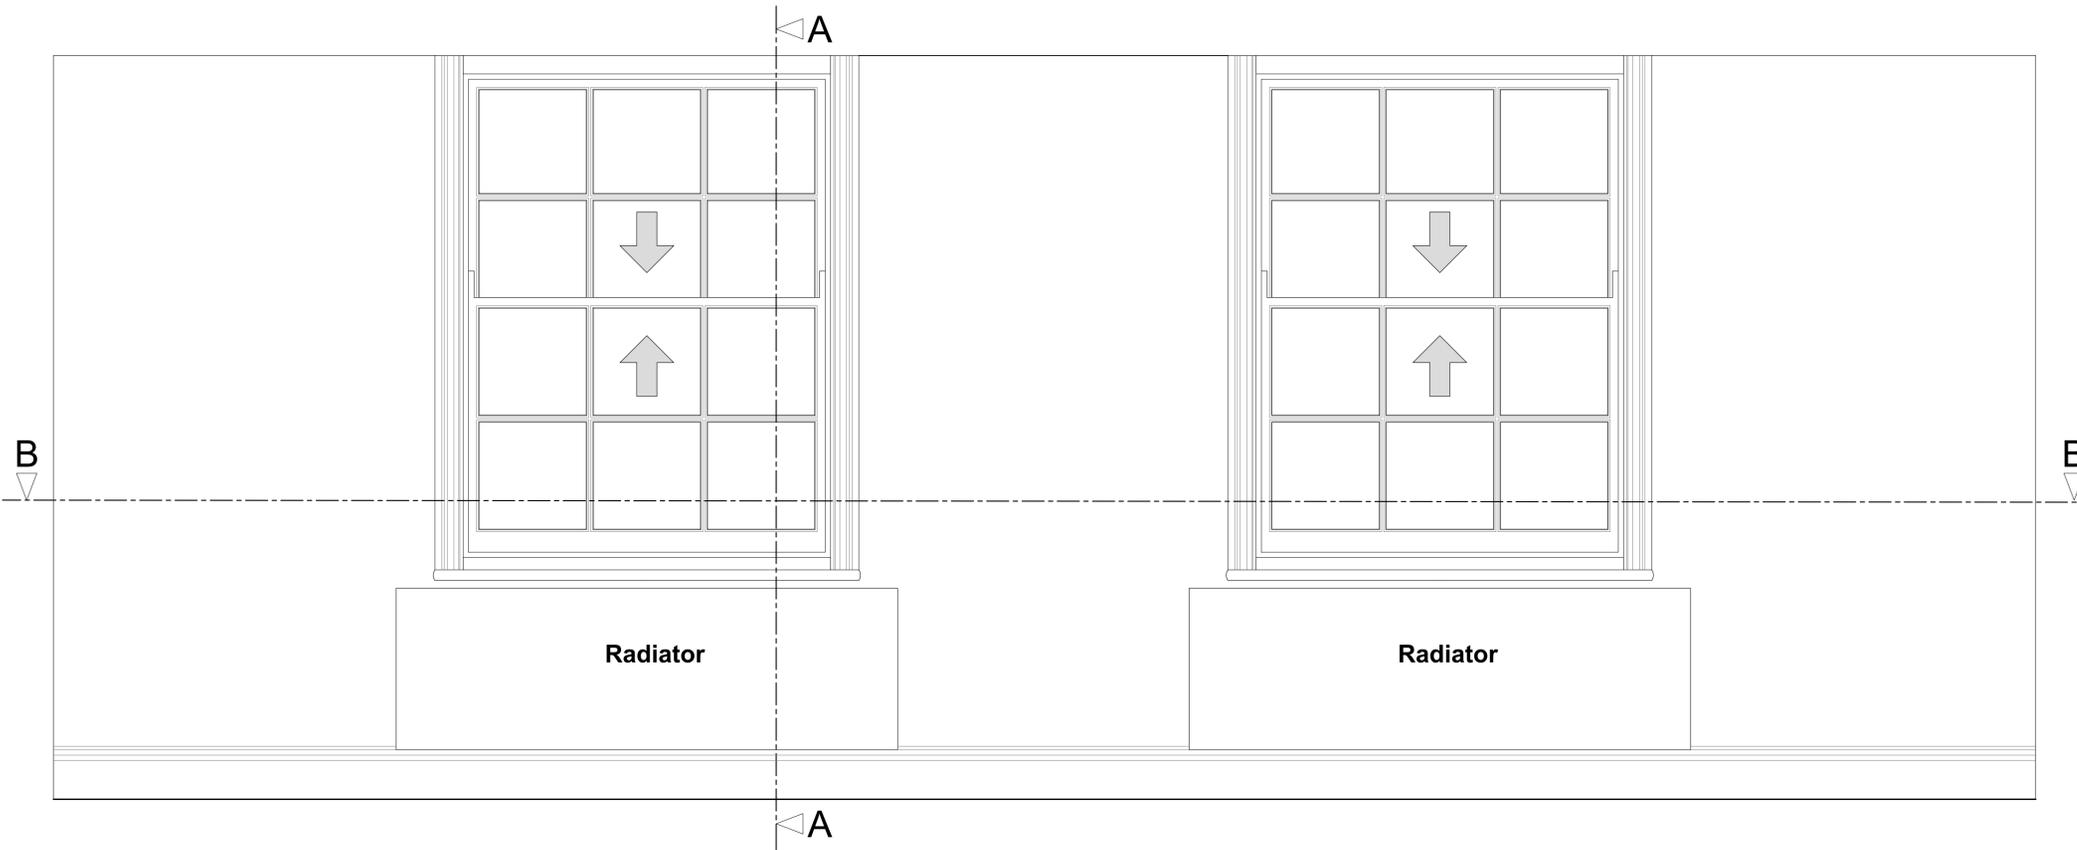

Section A-A through External Wall
Scale: 1:10

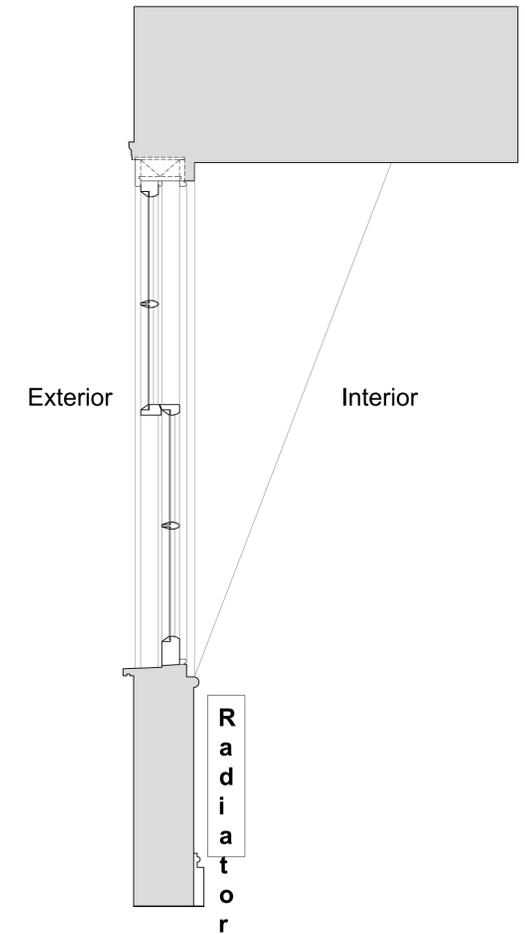

Plan Section B-B
Scale: 1:10



Revision	Date	Amendment
1.0	13-12-2019	Issued for listed building consent application

Do not reproduce this drawing without written permission
All dimensions are in millimetres unless stated otherwise

Drawing Not For Construction

HS2

High Speed (HS2) Limited
1st-3rd Floor
The Podium
1 Eversholt Street
London NW1 2DN


COSTAIN SKANSKA

Costain Skanska Joint Venture
9th Floor
The Tower
1 Eversholt Street
London NW1 2DN

Site Address: 70 Delancey Street, London NW1			
Drawing Title: Third Floor - Bedroom: EXISTING Front Window Joinery Details - Sheet 1 of 3			
Submitted by: AP & PB	Drawn by: AP	Checked by: OB	Presentation Scale: as shown @ A1
Date: 27-05-2019	Drawing No: WPI P066B NI - 70 DeS-EX-TF-J-05	Revision: 1.0	


Internal Room Elevation with Secondary Glazing Installed

Scale: 1:10

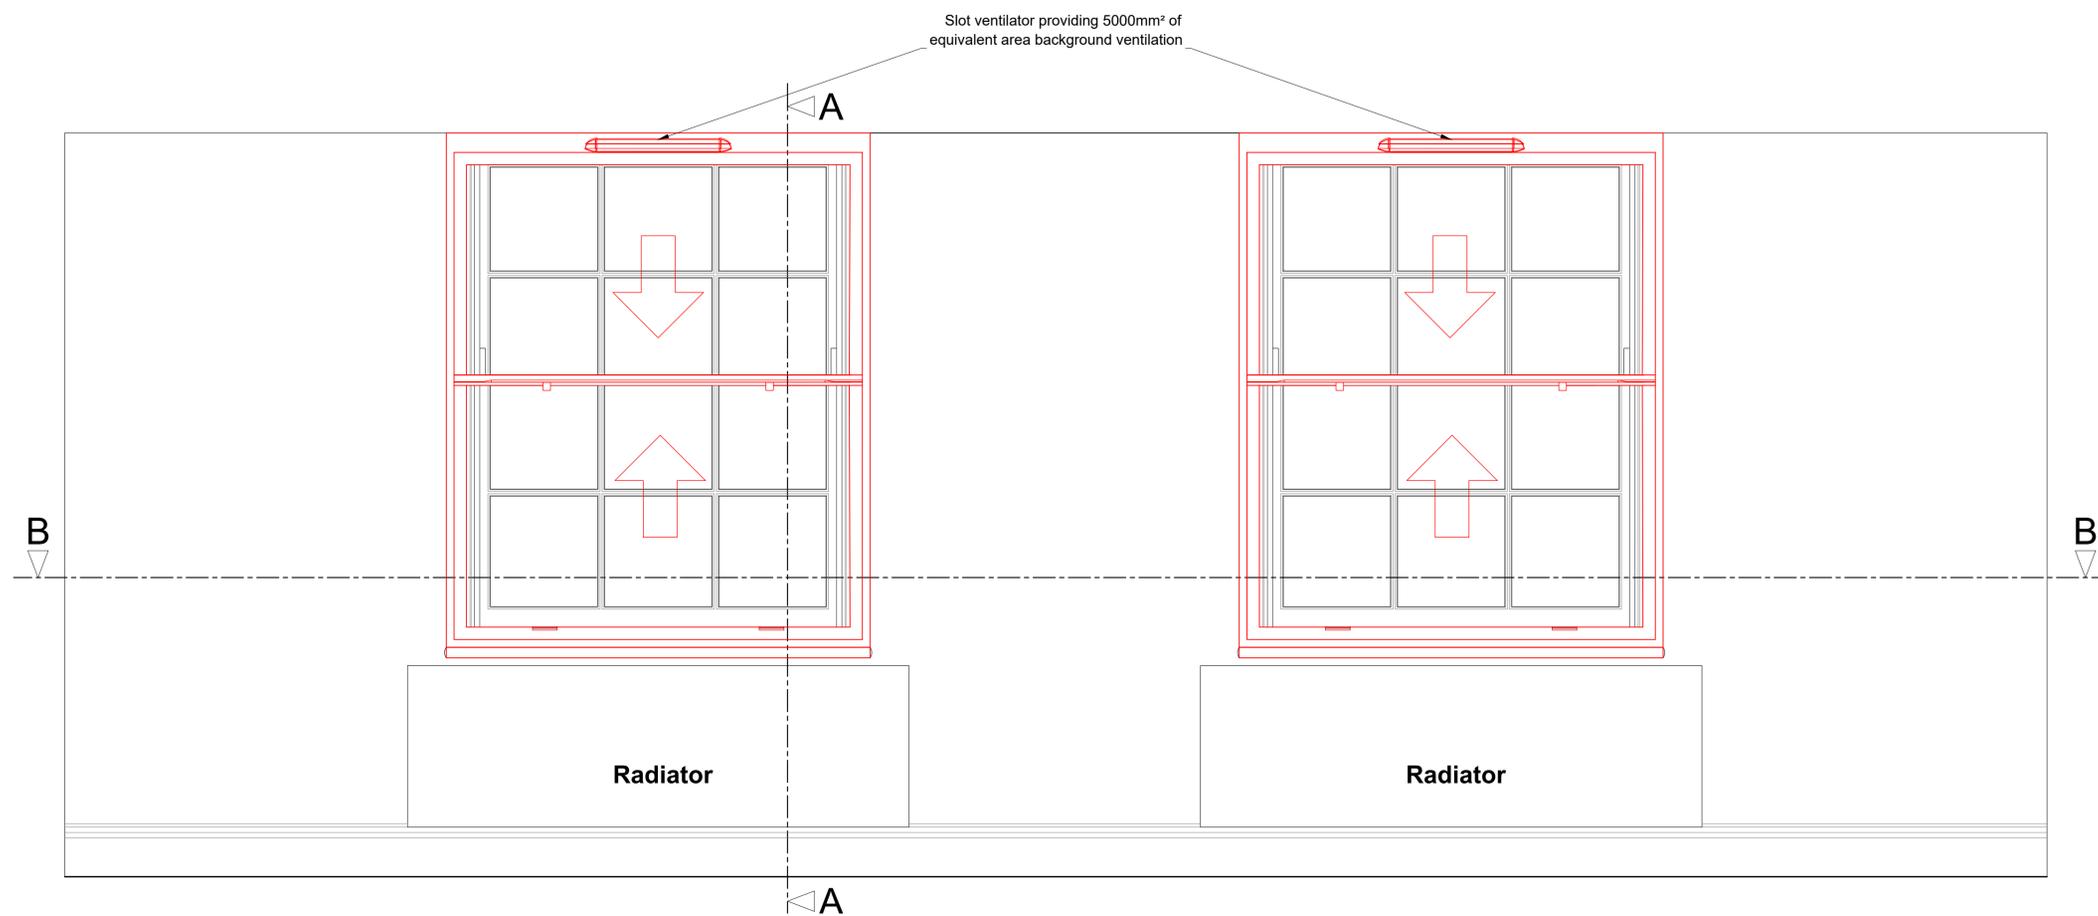


Section A-A through External Wall with Secondary Glazing Installed

Scale: 1:10

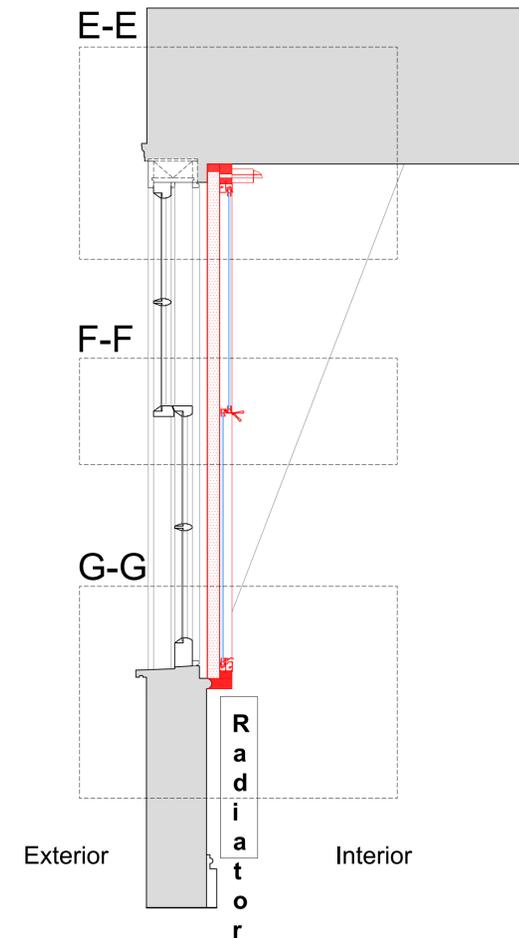

Plan Section B-B with Secondary Glazing Installed

Scale: 1:10

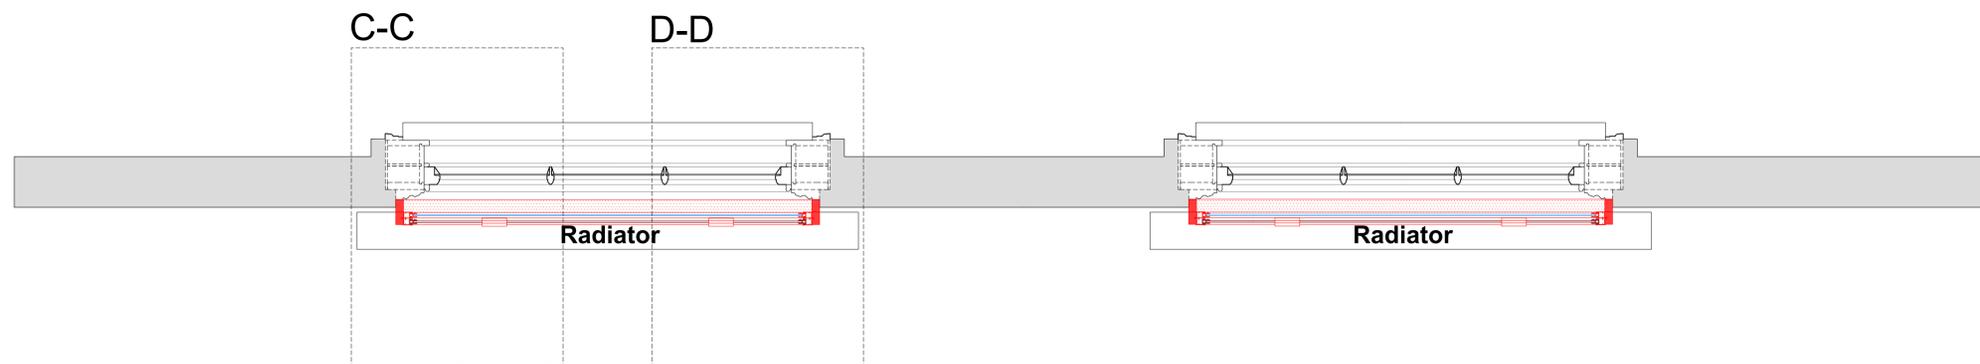

SECONDARY GLAZING SHOWN IN RED FOR VISUAL CLARITY ONLY

Revision	Date	Amendment
1.0	13-12-2019	Issued for listed building consent application

Do not reproduce this drawing without written permission
All dimensions are in millimetres unless stated otherwise

Drawing Not For Construction

HS2

High Speed (HS2) Limited
1st-3rd Floor
The Tower
1 Eversholt Street
London NW1 2DN

COSTAIN SKANSKA

Costain Skanska Joint Venture
9th Floor
The Tower
1 Eversholt Street
London NW1 2DN


Site Address:
70 Delancey Street, London NW1

Drawing Title:
Third Floor - Bedroom: PROPOSED Secondary Glazing Details -
Sheet 2 of 3


Drawn by: AP & PB Drawn by: AP Checked by: OB Presentation Scale: as shown @ A1

Date: 27-05-2019 Drawing No: WPI P066B NI - 70 DeS-PR-TF-J-05.1 Revision: 1.0


Section C-C
Scale: 1:5 on A1

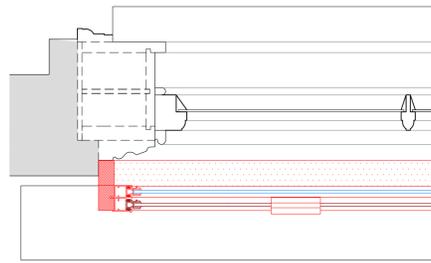


Section D-D
Scale: 1:5 on A1

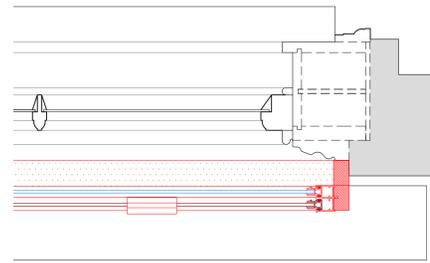


Section E-E
Scale: 1:5 on A1

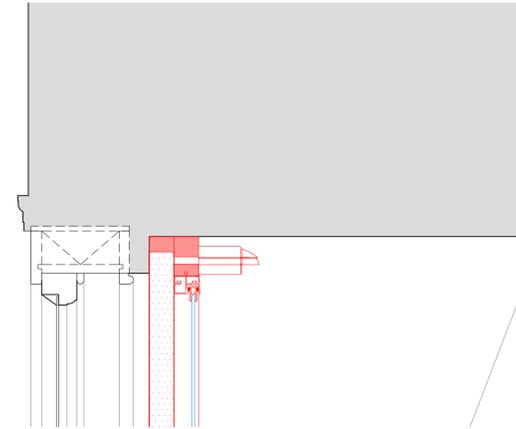

Section F-F
Scale: 1:5 on A1

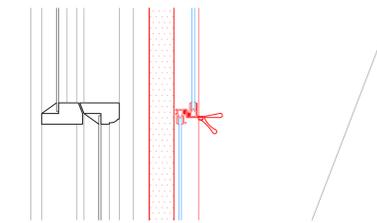

Section F-F
Scale: 1:5 on A1

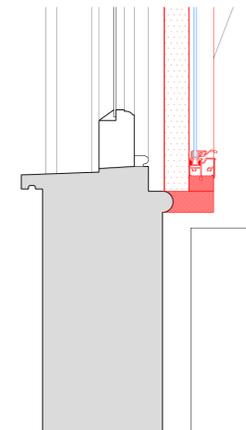

SECONDARY GLAZING SHOWN IN RED FOR VISUAL CLARITY ONLY

Revision	Date	Assessment
1.0	13-12-2019	Issued for listed building consent application

Do not reproduce this drawing without written permission
All dimensions are in millimetres unless stated otherwise

Drawing Not For Construction

HS2

High Speed (HS2) Limited
1st-3rd Floor
The Podium
1 Eversholt Street
London NW1 2DN

COSTAIN SKANSKA

Costain Skanska Joint Venture
9th Floor
The Tower
1 Eversholt Street
London NW1 2DN

Site Address: 70 Delancey Street, London NW1			
Drawing Title: Third Floor - Bedroom: PROPOSED Secondary Glazing Details - Sheet 3 of 3			
Submitted by: AP & PB	Drawn by: AP	Checked by: OB	Presentation Scale: 1:5 @ A1
Date: 27-05-2019	Drawing No: WPI P066B NI - 70 DeS-PR-BS-J-01.2	Revision: 1.0	