



1 SOUTH ELEVATION TO BELSIZE ROAD
1:100 139 Base drawing planning March 2018




2 EAST ELEVATION TO COLERIDGE GARDENS
1:100 139 Base drawing planning March 2018

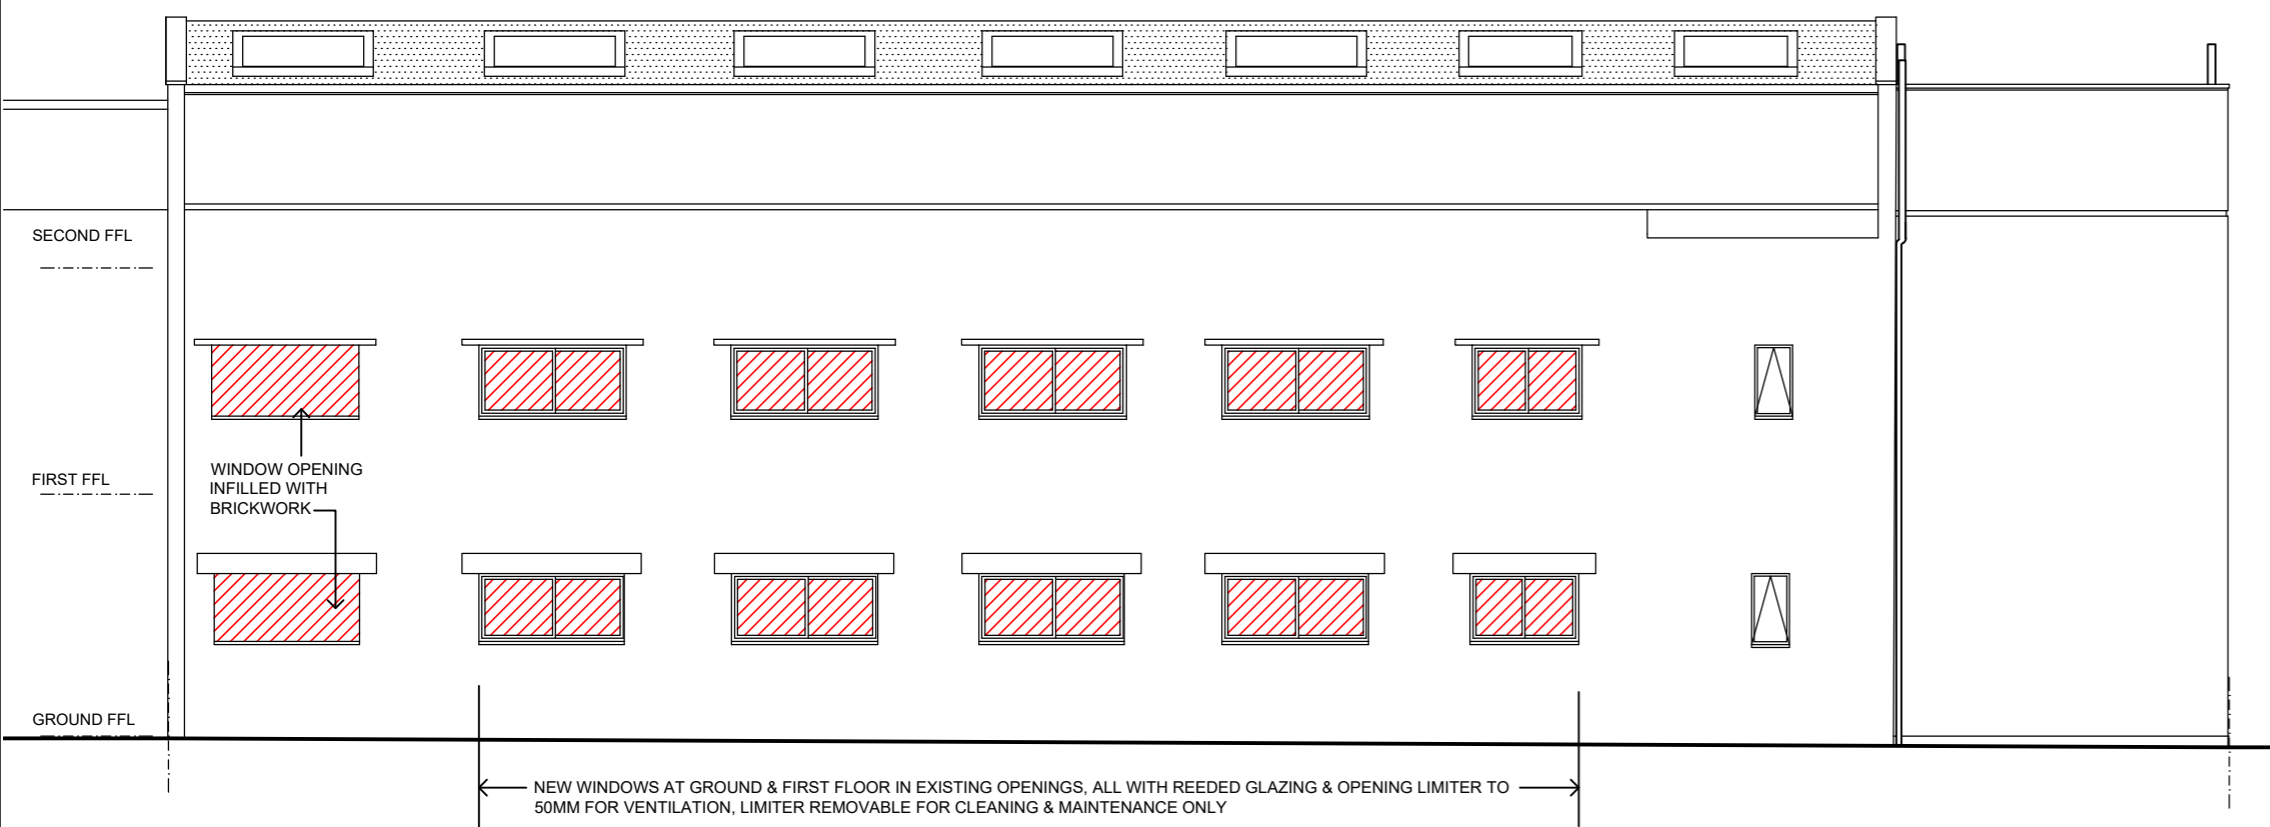

3 NORTH ELEVATION TO GOLDHURST TERRACE
1:100 139 Base drawing planning March 2018

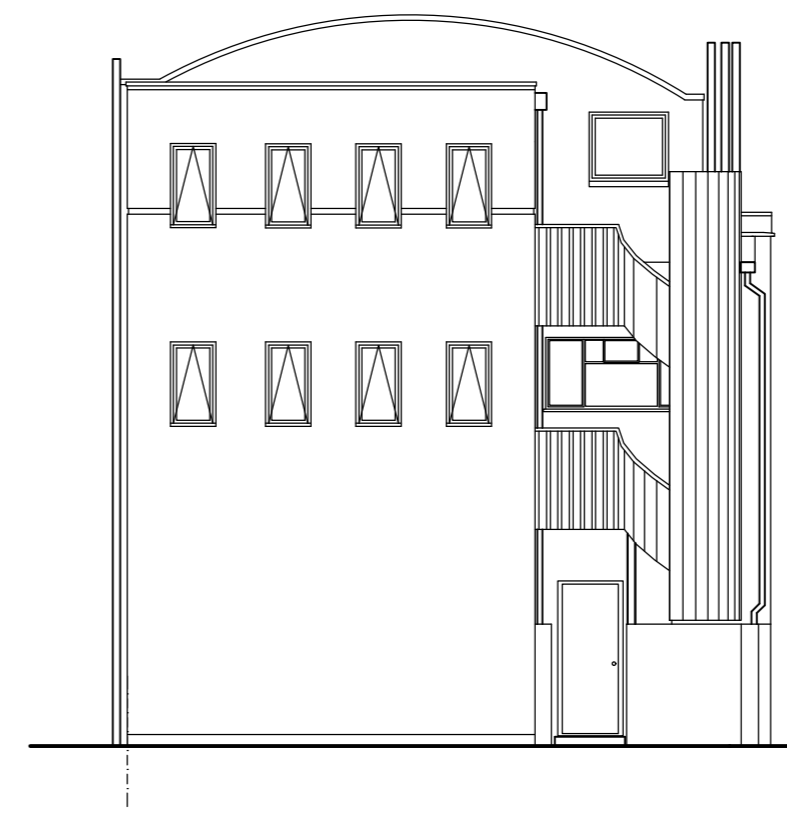

4 WEST ELEVATION
1:100 139 Base drawing planning March 2018

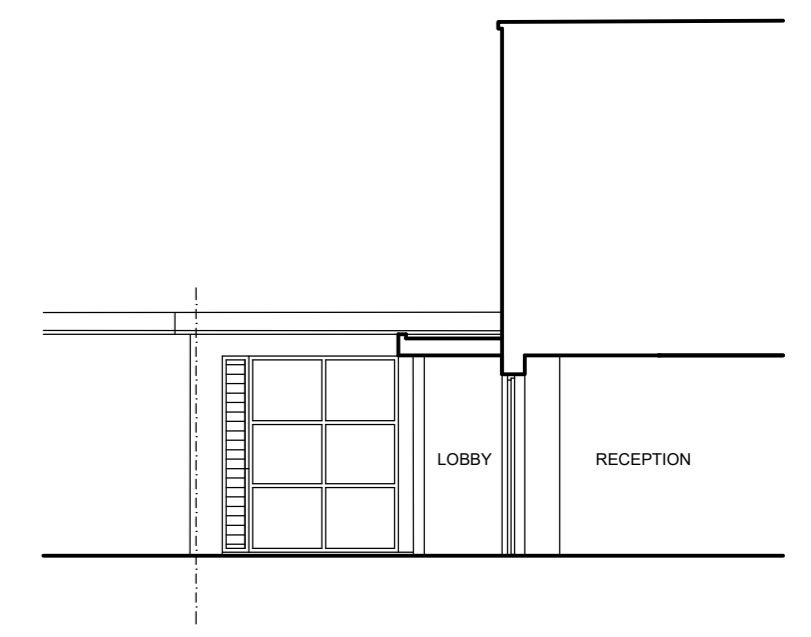

5 N. ELEV FROM COLERIDGE GDNS
1:100 139 Base drawing planning March 2018

RETROSPECTIVE APPLICATION FOR NORTH/SOUTH WINDOWS 2020

Rev A 17.02.20 Planning application submission
1st issue 12.02.20 Client issue

NOTES
THERE ARE SOME DISCREPANCIES BETWEEN THE SITE AS SURVEYED AND THE OS PLAN SUPPLIED BY STREETWISE MAPS. NO PART OF THE PROPOSED WORKS WILL EXTEND BEYOND THE EXISTING BUILDING LINES FORMING THE BOUNDARIES.

PROPOSED ELEVATIONS - as constructed

DATE: FEBRUARY 2020
SCALE: 1:100 @ A2
DRAWING NO: 212 PL 01A
do not scale. check all dimension on site

4-5 COLERIDGE GARDENS
LONDON NW6
CLIENT: REGAL OFFICES LLP
pedder & scampton ARCHITECTS
UNITED HOUSE NORTH ROAD LONDON N7 9DP PHONE 020 7607 4156