



REVISIONS

Rev.	Date	By
A.	07/10/19	LV
B.	14/10/19	LV

A. As built floor layout.
B. A/C condensers added in patios.

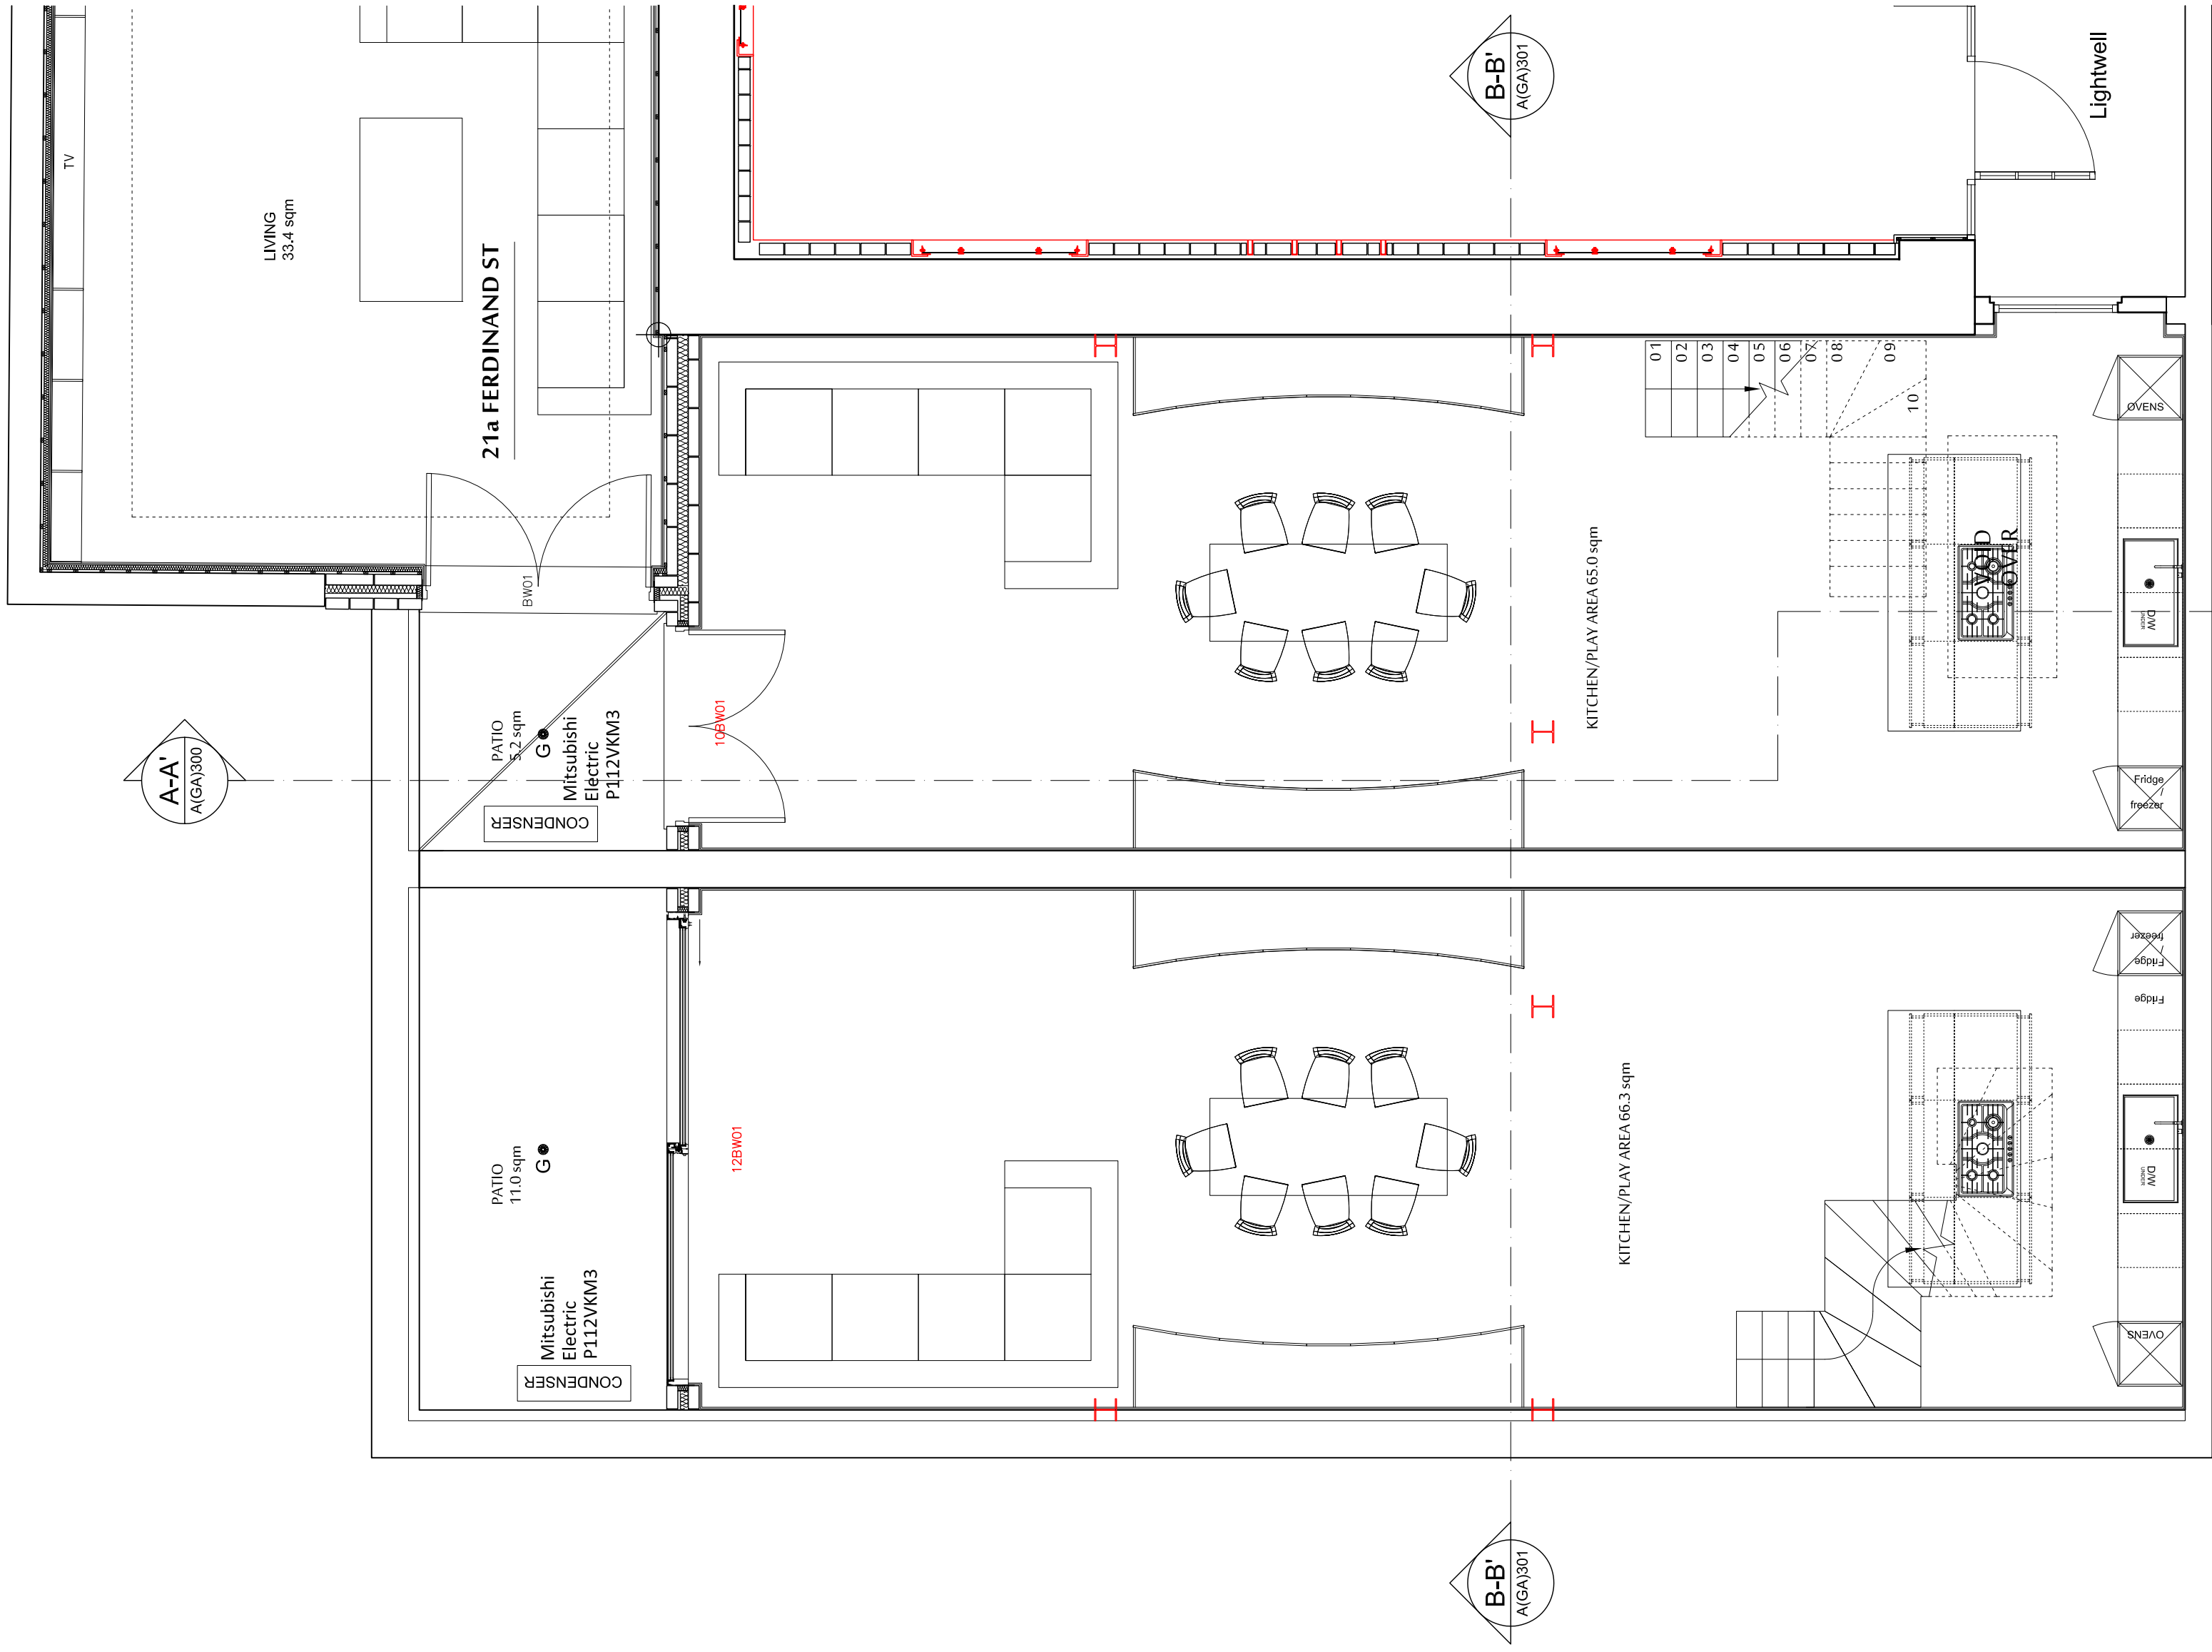

BASEMENT FLOOR

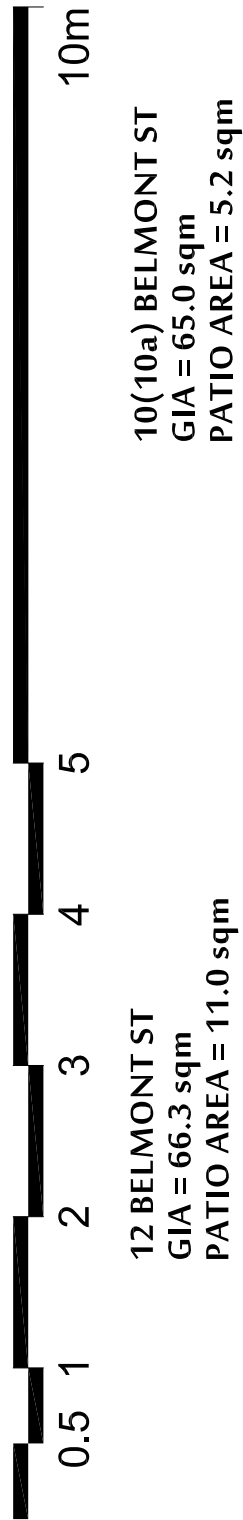

Scale: 1:50@A1, 1:100@A3
Drawn: SN
Drawing No.: 160910-A(GA)130
Checked: DL
Date: SEPTEMBER 2016
Rev.: B