



Proposed Floor Plan (demolitions removed)

Scale: 1:50

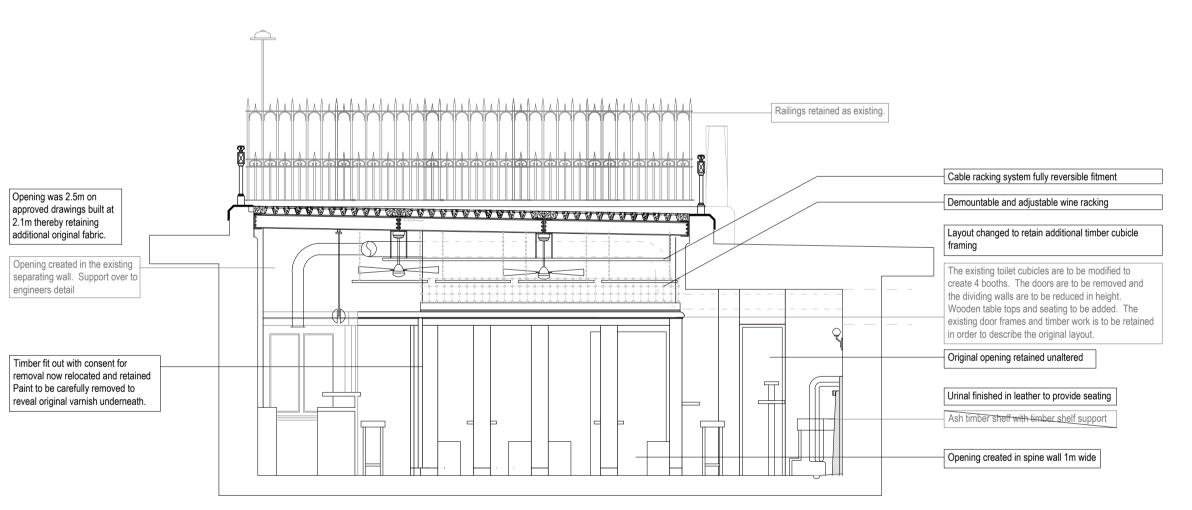

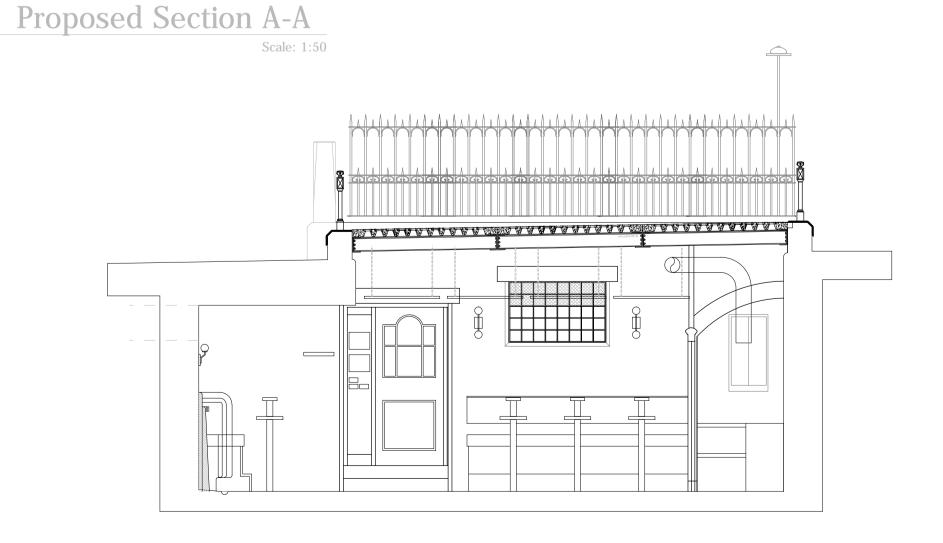

5 Proposed Section B-B



Dexter Building Design Ltd Unit 5 Victoria Grove Bristol, BS3 4AN Tel: E: Enquiries@dexterdesigns.co.uk www.Dexterdesigns.co.uk

Proposed conversion of former Public Conveniences to Restaurant (A1, A3)

PRELIMINARY NOT FOR CONSTRUCTION

Project No.	73
Cad File	1346_V02.08.dw

Revision no.

 Project No.
 737

 Cad File
 1346\_V02.08.dwg

 Drawn
 JD

 Checked
 JD

 Date
 03/11/2020

 Scale
 As shown

 Title/No.

Record drawings
Plans Elevations
and Sections.