

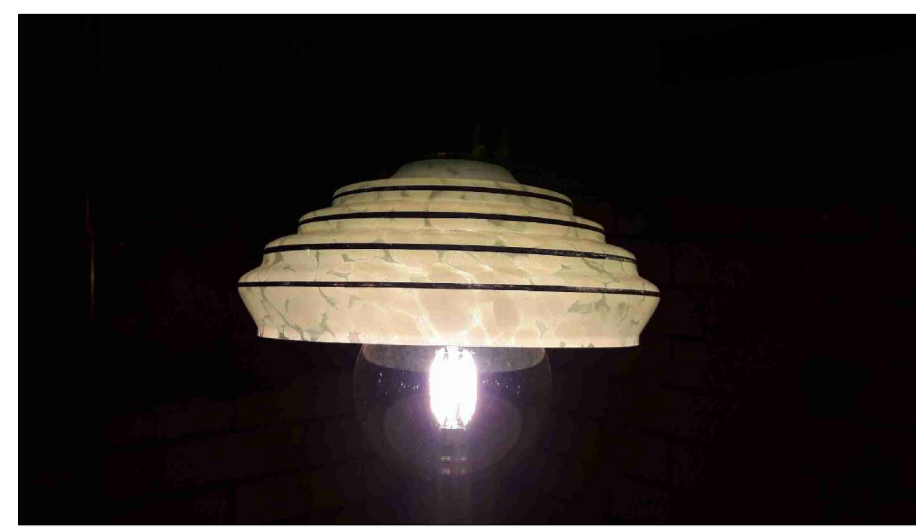
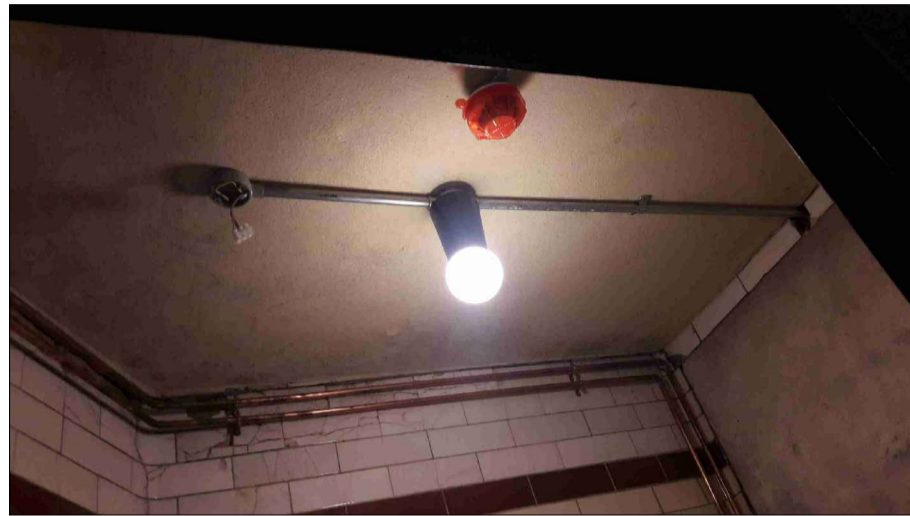


Lighting above Urinal seating and bench table

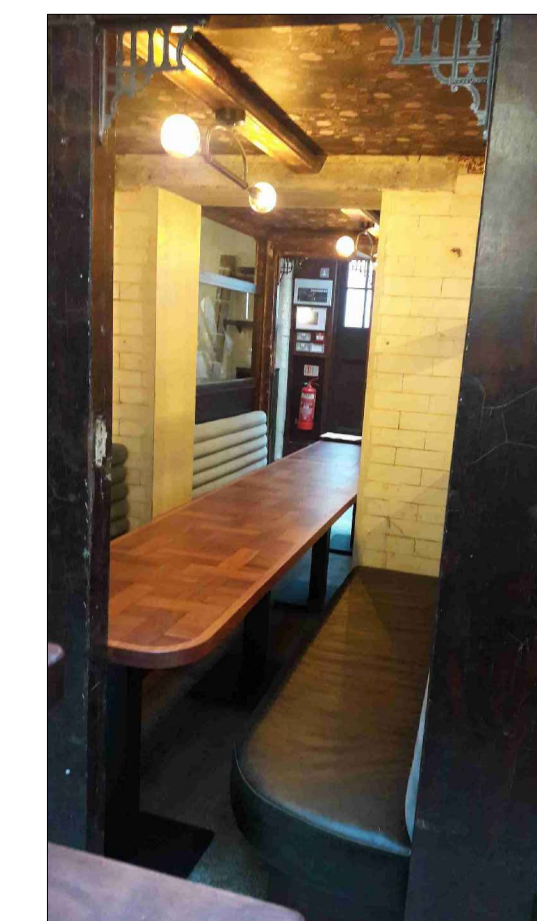



Typical booth lighting

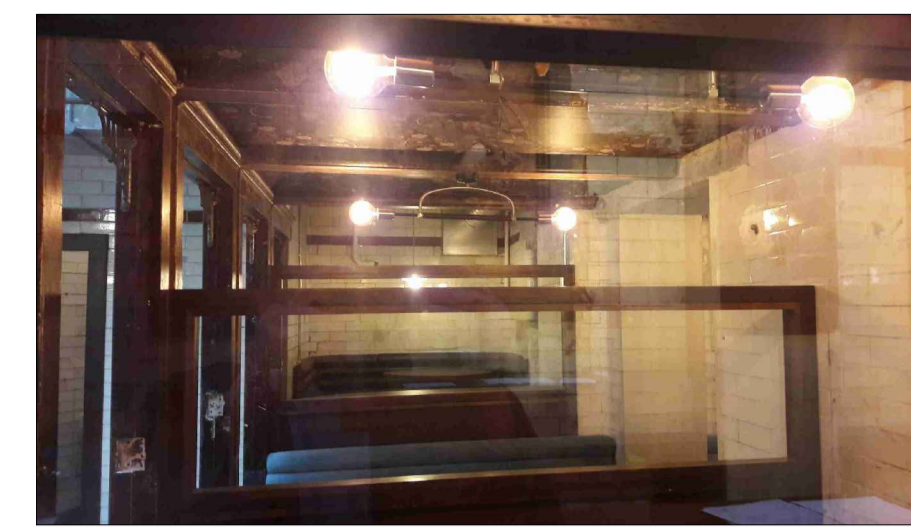

Lighting WC




Typical bar lighting

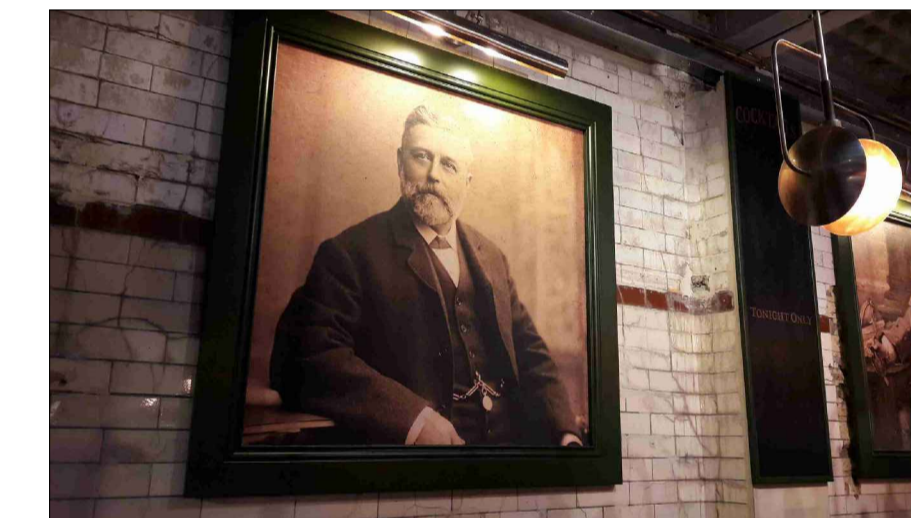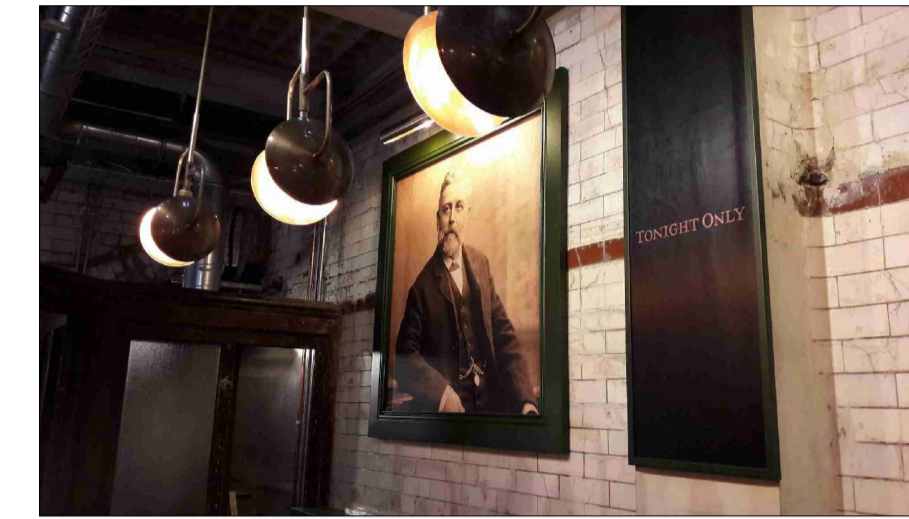


Typical picture lighting behind bar (will be straightened once approved)



Typical emergency lighting

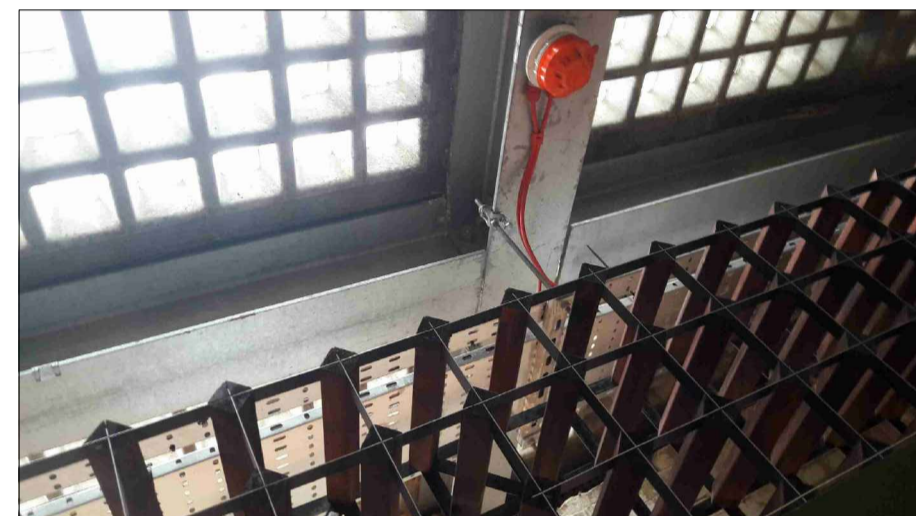


Typical fire safety sensor

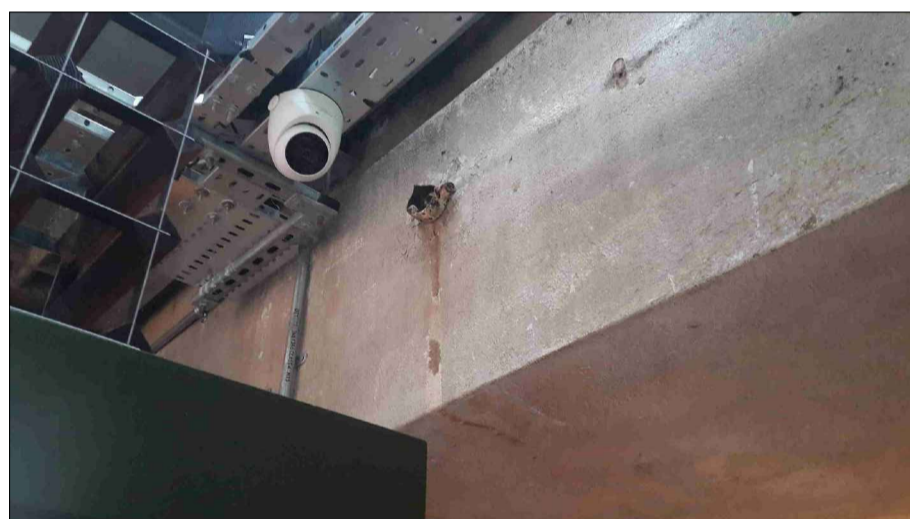


Typical CCTV

Proposed conversion of former Public
Conveniences to Restaurant (A1, A3)
Ladies and Gentlemans Public Conveniences,
Guilford Place, Camden, London, WC1



PRELIMINARY
NOT FOR
CONSTRUCTION

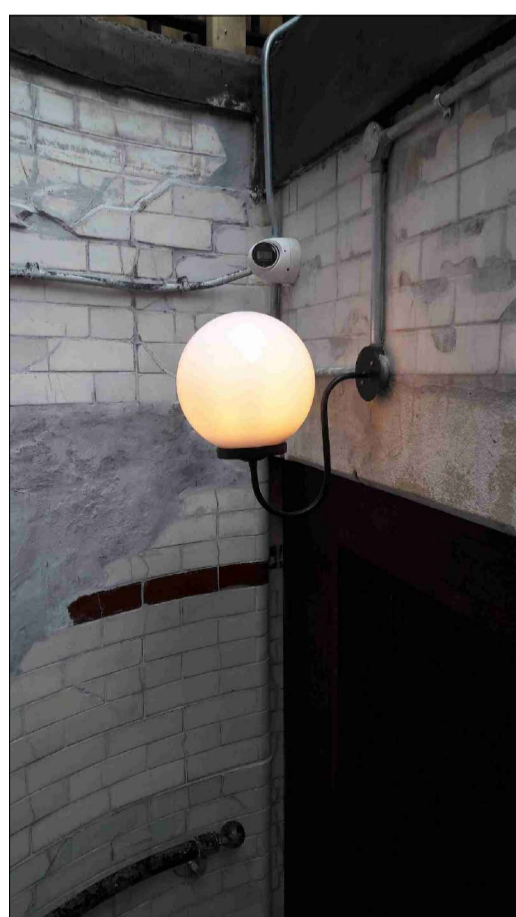

Typical entrance lighting

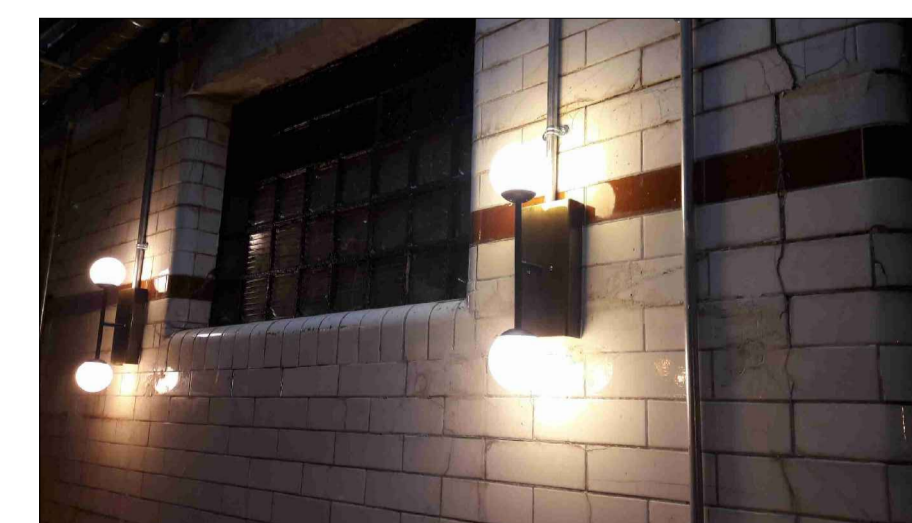

Typical lighting above bench seating

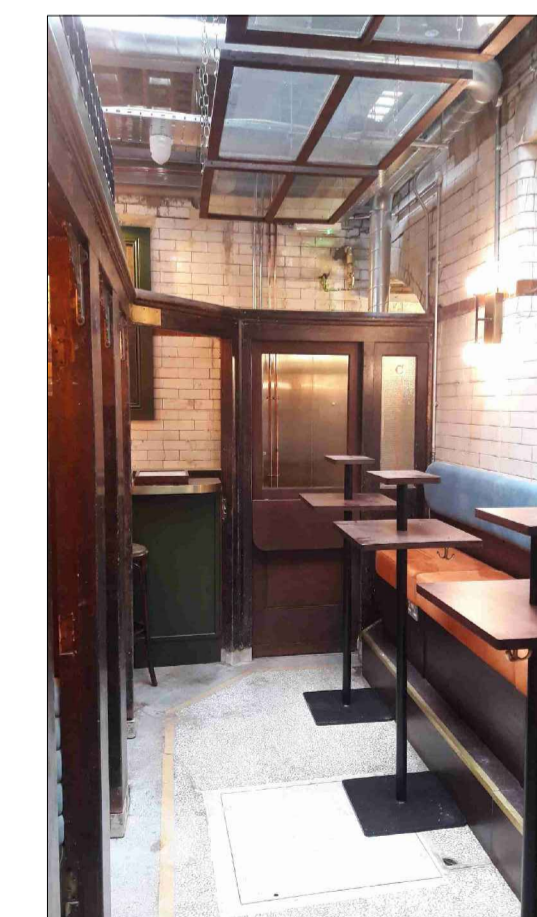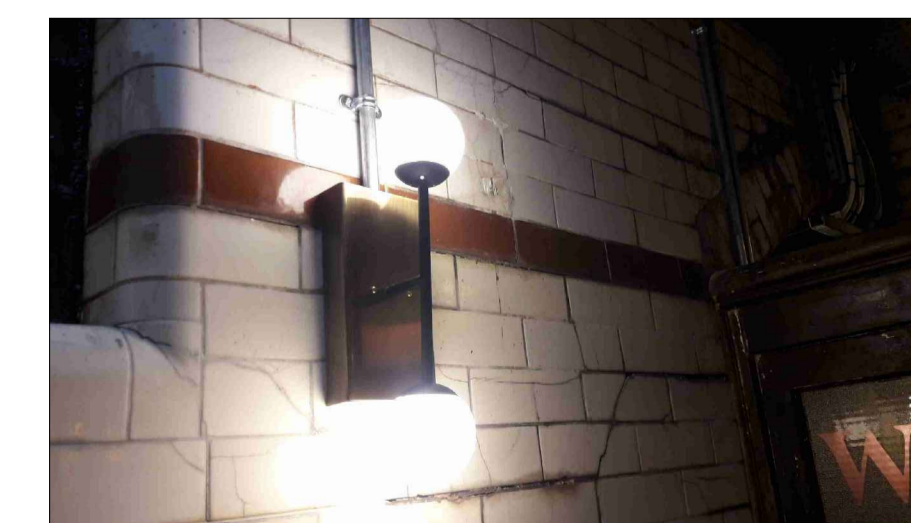

Revision no.	
Project No.	737
Cad File	1346_V02.08.dwg
Drawn	
Checked	JD
Date	03/11/2020
Scale	As shown
TitleNo.	

Record drawings
Lighting style sheet