

C1 - DIMMABLE
 C2 - DIMMABLE
 C3 - DIMMABLE
 C4 - DIMMABLE
 C5 - DIMMABLE
 C6 - MOTION SENSOR

Notes:

LEGEND

	S-1
	PL-1
	PL-2
	PL-3 FITTED INTO FALSE CUBICLE CEILING
	EX-1
	EX-2
	WL-1
	WL-2
	WL-3
	WL-2
	CL-2
	LB-1
	LB-2
	LB-3
	MB-1
	LED-1 UNDER SHELVING LED STRIP
	TL-1 ELECTRICS TO BE WIRED UP THROUGH TABLE
	TL-3 PLUG SOCKET LAMP HARDWIRED IN FOR DIMMABILITY
	CL-1
	SWITCH
	LIGHTING CONTROL PANEL

NOTE: ALL CONDUIT BOXES FOR LIGHTING MUST BE 28MM DEEP AND 65 MM IN DIAMETER

NOTE: LIGHT BOXES NEED TO BE VERY LOW LIGHT LEVELS

NOTE: ELECTRICIAN TO CONFIRM HOW TABLE LAMPS WILL BE INSTALLED AND ROUTE OF CONDUIT BEFORE ANY MATERIALS ARE PURCHASED.

NOTE: BE AWARE OF PENDANT LIGHTS AND HANGING VINTAGE WINDOWS

NOTE: PROPER SITE SURVEY HAS NOT BEEN PERFORMED SO DIMENSIONS ON DRAWINGS MAY DIFFER TO THOSE ON SITE

Note: All dimensions should be checked on site and verified with the designer.

A	EXTERIOR LIGHT ADDITION, DIMMABLE	KC	19.06.19	SIGNED
B	LIGHTING POSITIONS CHANGED AND LIGHTS OMITTED AND UPDATED TO CONSTRUCTION	KC	19.06.19	SIGNED
C	LIGHTING POSITIONS CHANGED AND LIGHTS OMITTED, WC BOX OMITTED	RS	22.11.19	SIGNED
D	PICTURE LIGHTS POSITION CHANGE	RS	04.12.19	SIGNED
E	UPGRADED TO AS BUILT	EC	07.01.20	SIGNED

DESIGNER:
 KAI Interiors
 Unit B2
 1B Mentmore Terrace
 E8 3DO London

STATUS:
 AS BUILT

CLIENT:
 CLAPHAM LEISURE


SITE:
 FORMER PUBLIC TOILETS
 GUILDFORD PLACE, LONDON,
 WC1N 1EA

TITLE:
 LIGHTING PLAN

SCALE AT A3: AS SHOWN	DATE: 07/01/20	DRAWN: SS	CHECKED: MMR
PROJECT NO: 624	DRAWING NO: 1-07	REVISION: E	

1 LIGHTING PLAN- LOWER LEVEL
 1:50 @ A3

2 LIGHTING PLAN- STREET LEVEL
 1:125 @ A3

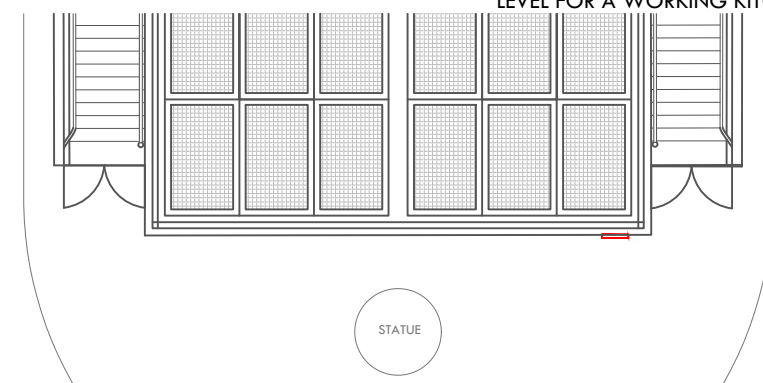

KAI INTERIORS HAVE ADVISED CLIENT THAT THIS IS NOT A SUFFICIENT LUX LEVEL FOR A WORKING KITCHEN