


REVISIONS

Rev. By Date
A. As built floor layout. LV 07/10/19
B. A/C ceiling units added in. LV 14/10/19

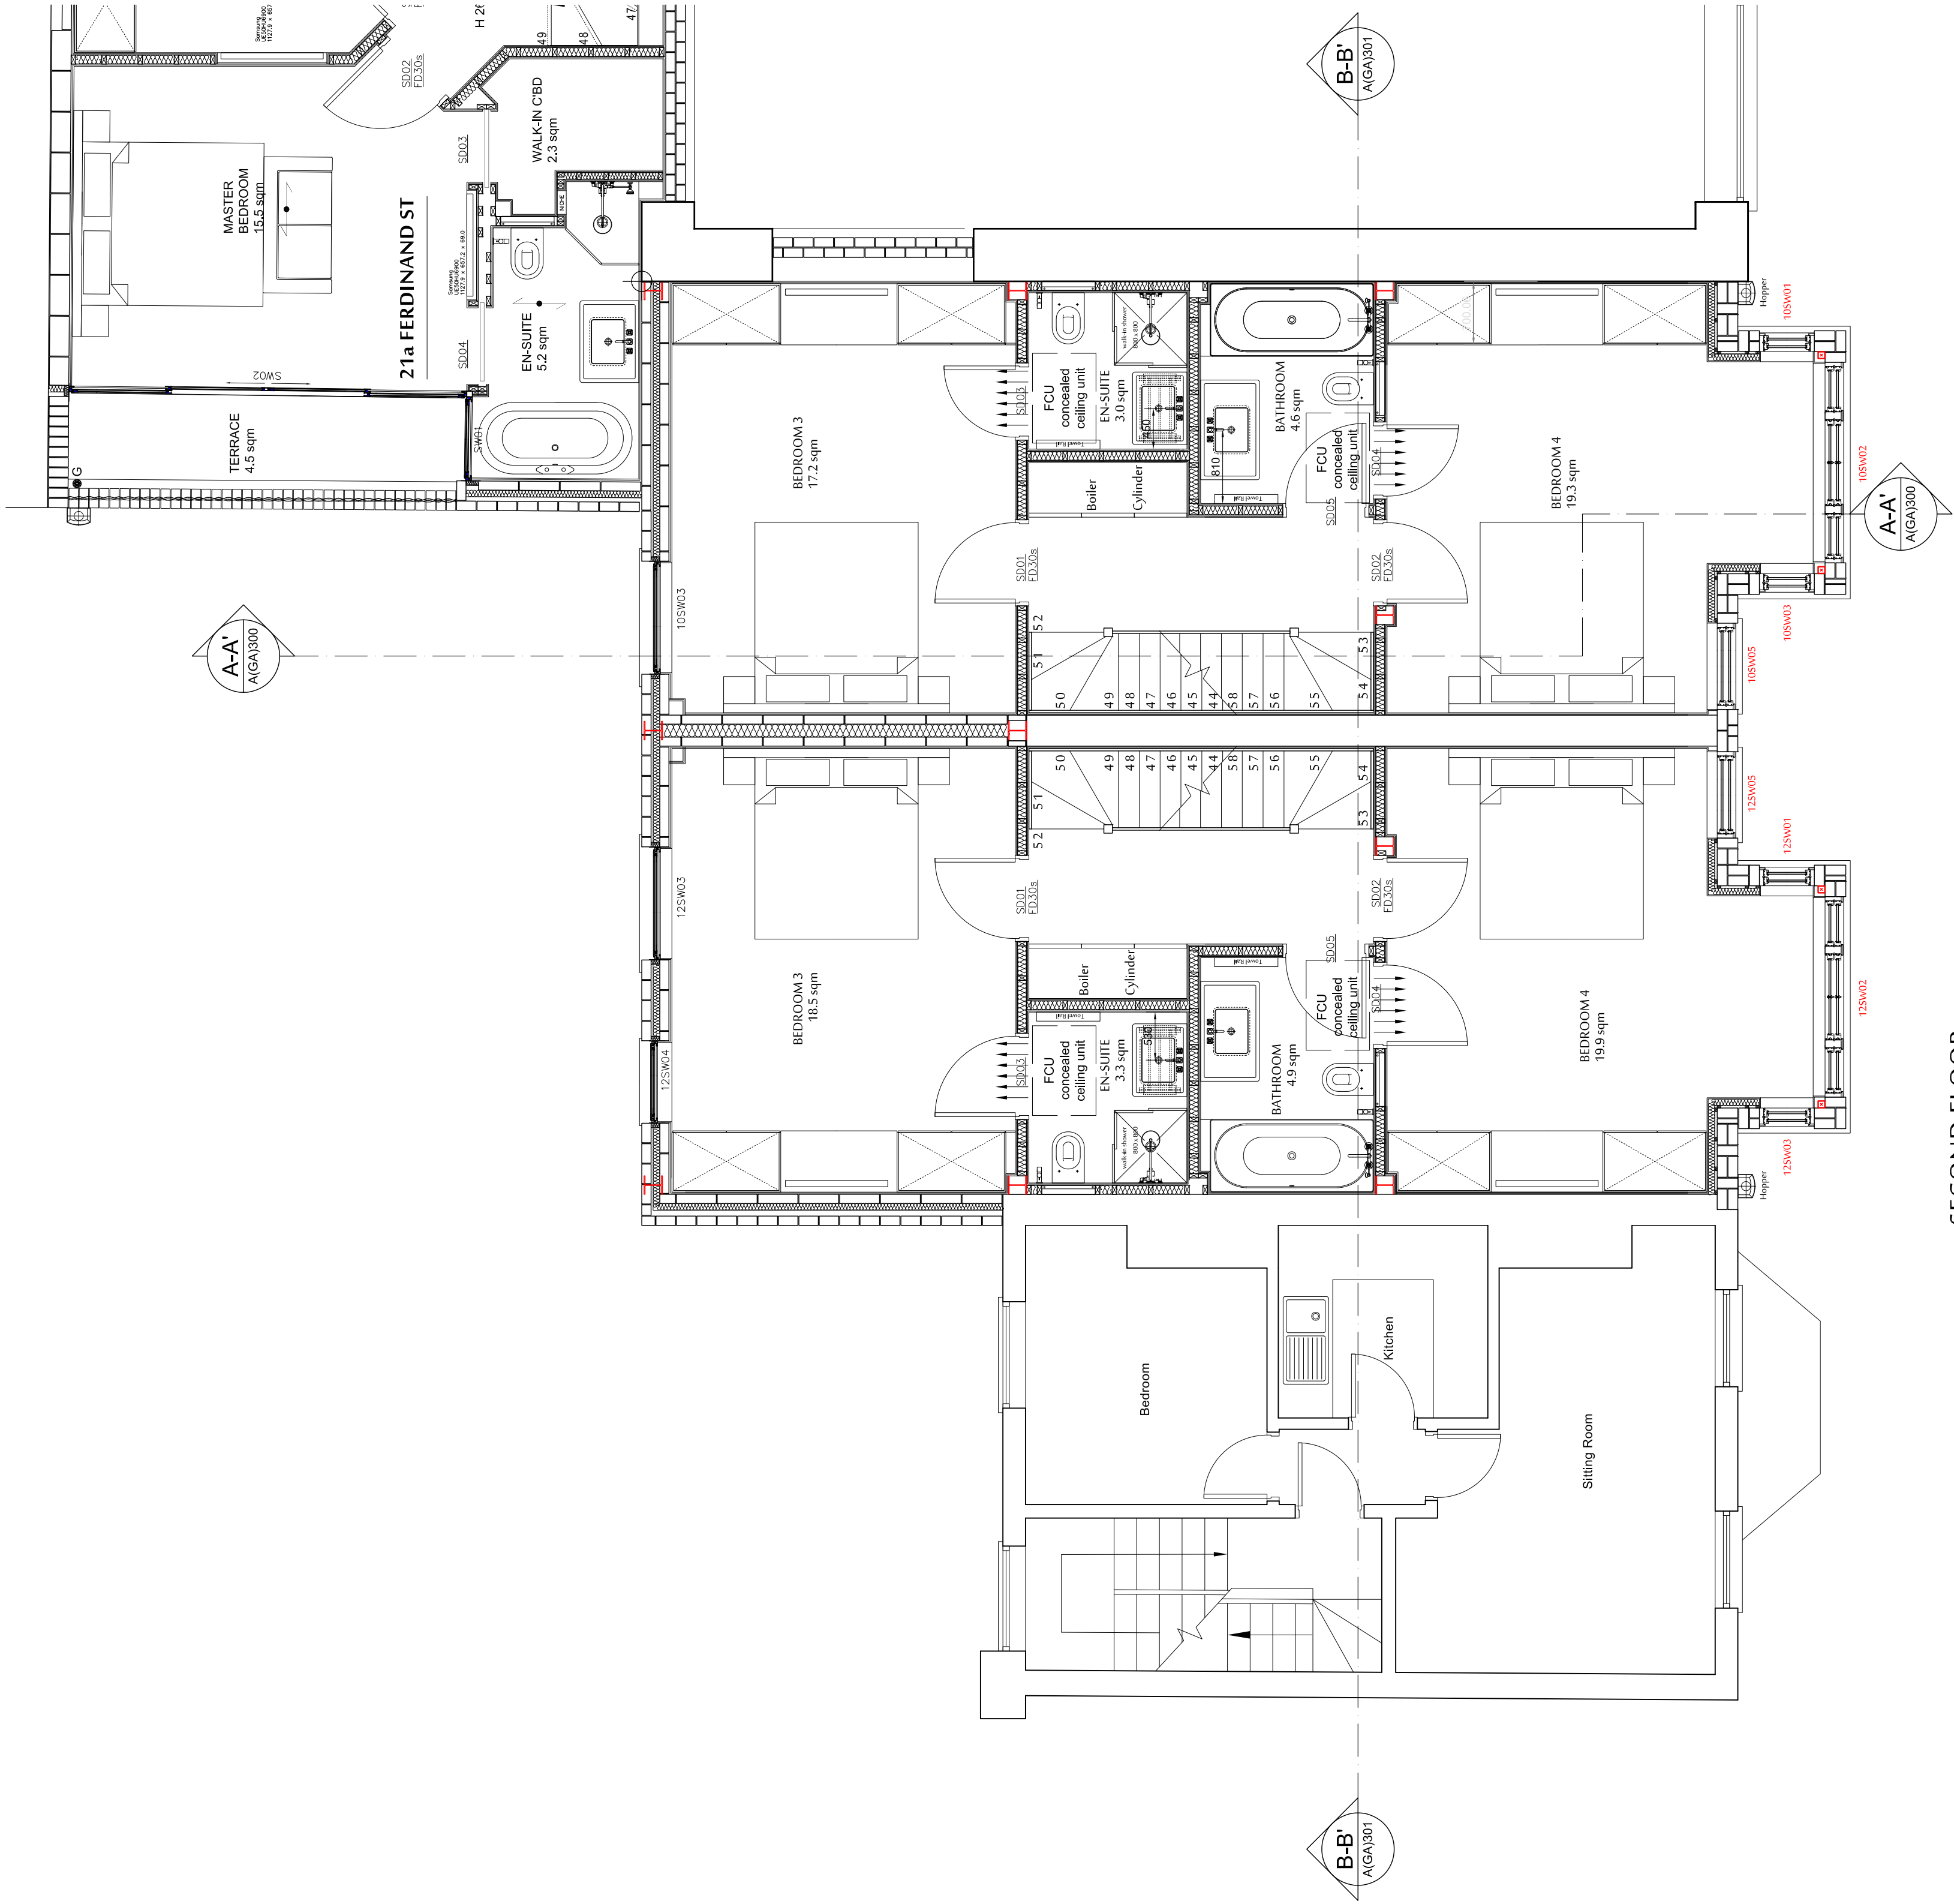

PLANNING APPLICATION

ALL DIMENSIONS TO BE CHECKED ON SITE
WORK TO FINISHED DIMENSIONS ONLY
REPAIRS TO EXISTING STRUCTURE TO BE COMPLETED
AT ONCE BEFORE PROCEEDING

Contemporary Design Solutions



46 Great Marlborough Street
W1F 7JN
London
Telephone: 020 7464 8000 Fax: 020 7464 4044

Client

WARMHAZE LTD

Project Title

New Bay Windows
10-12 Belmont Street, LONDON NW1

Drawing Title

As Built Second Floor Plan

Scale: 1:50@A1, 1:100@A3 Date: SEPTEMBER 2016
Drawn: SN Checked: DL
Drawing No. 160910-A(GA)120 Rev. B

