



REVISIONS

| Rev. | Date     | By |
|------|----------|----|
| A.   | 07/10/19 | LV |
| B.   | 19/11/19 | LV |

A. As built floor layout.  
B. Cycle storage added.

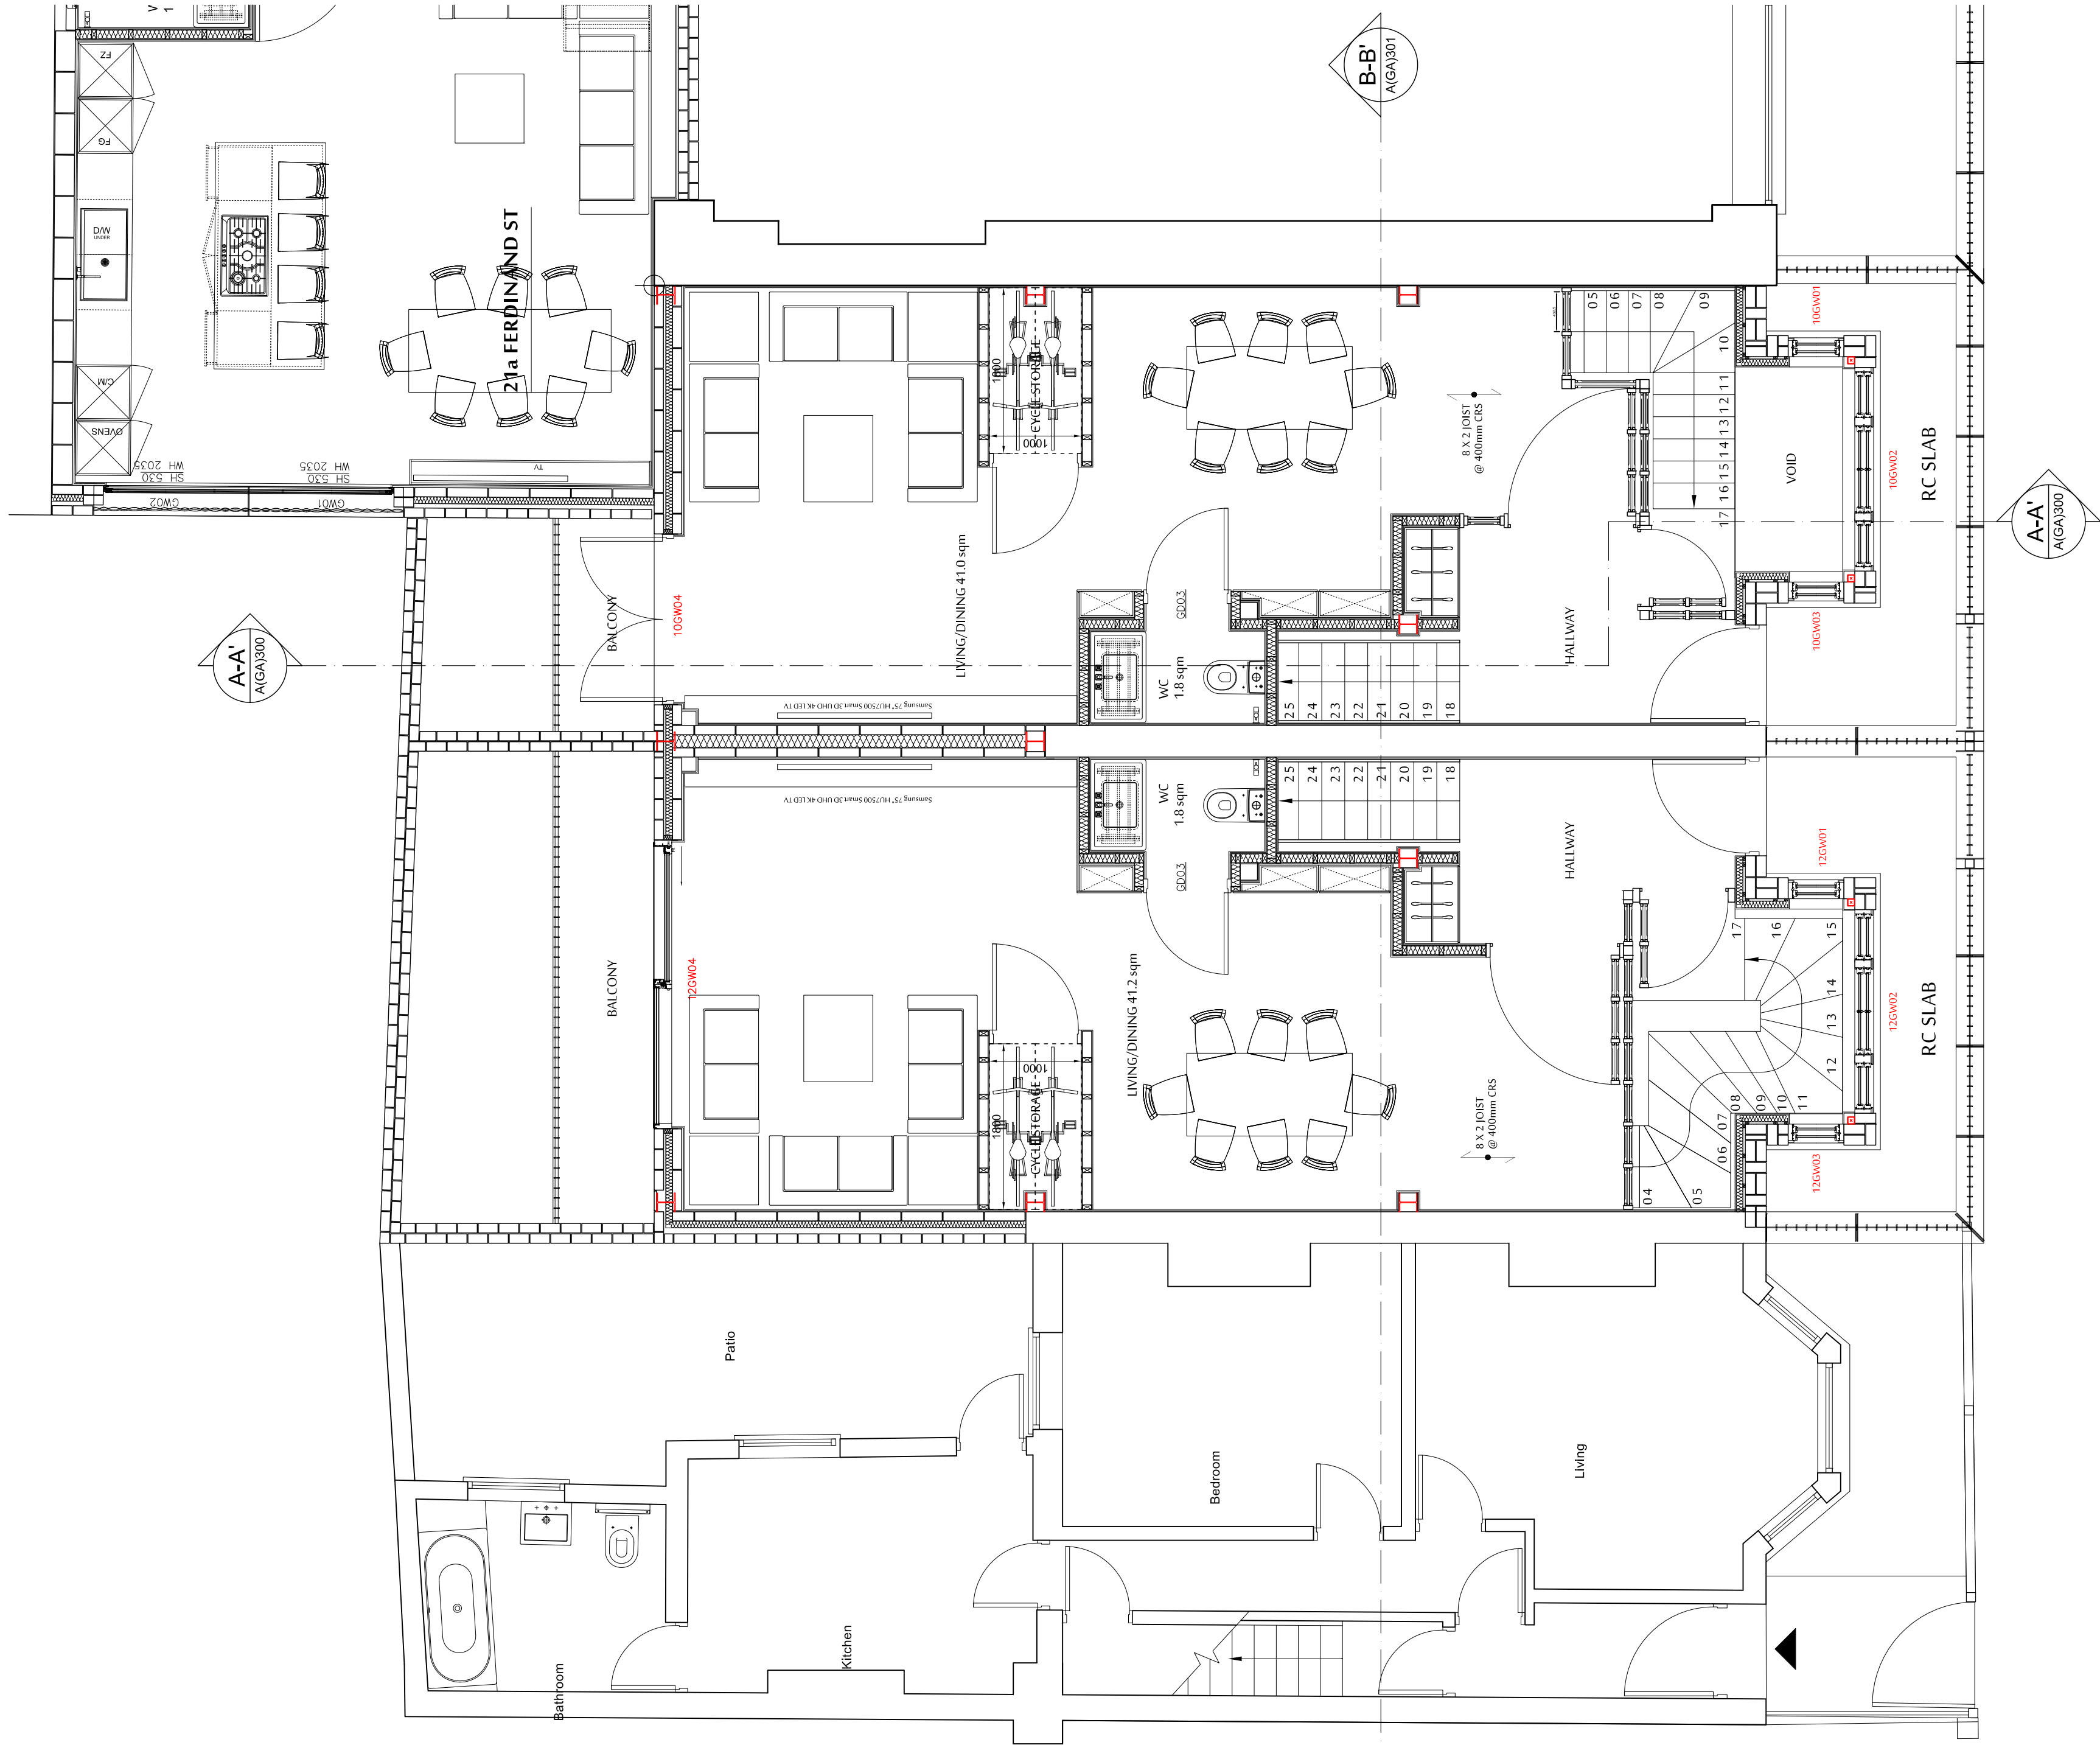

GROUND FLOOR

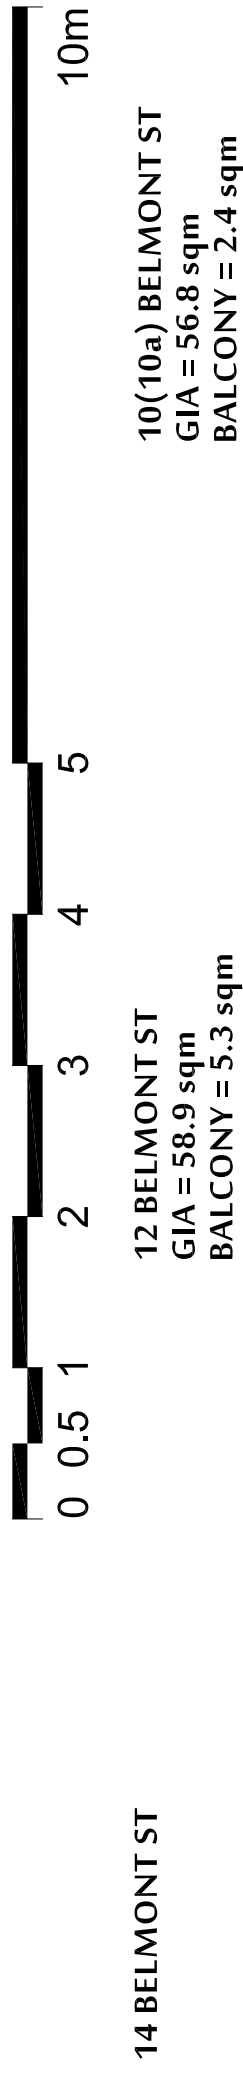

|             |                   |         |                |
|-------------|-------------------|---------|----------------|
| Scale       | 1:50@A1, 1:100@A3 | Date    | SEPTEMBER 2016 |
| Drawn       | SN                | Checked | DL             |
| Drawing No. | 160910-A(GA)100   |         |                |
| Rev.        | B                 |         |                |