
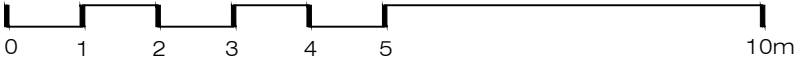
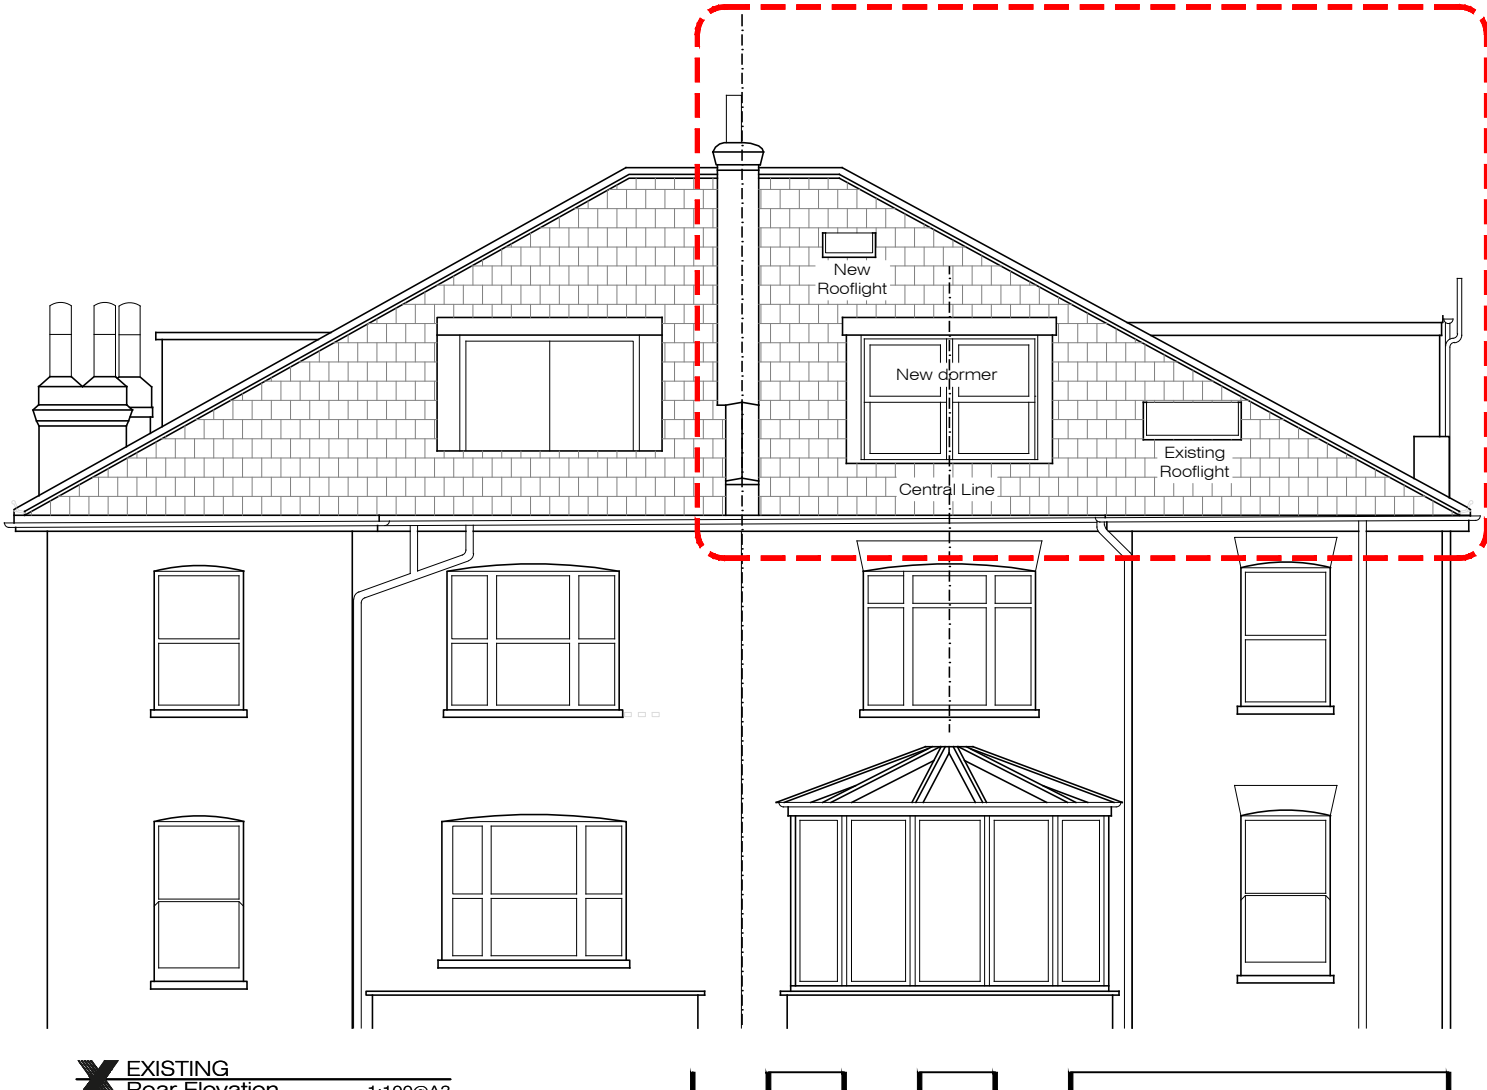
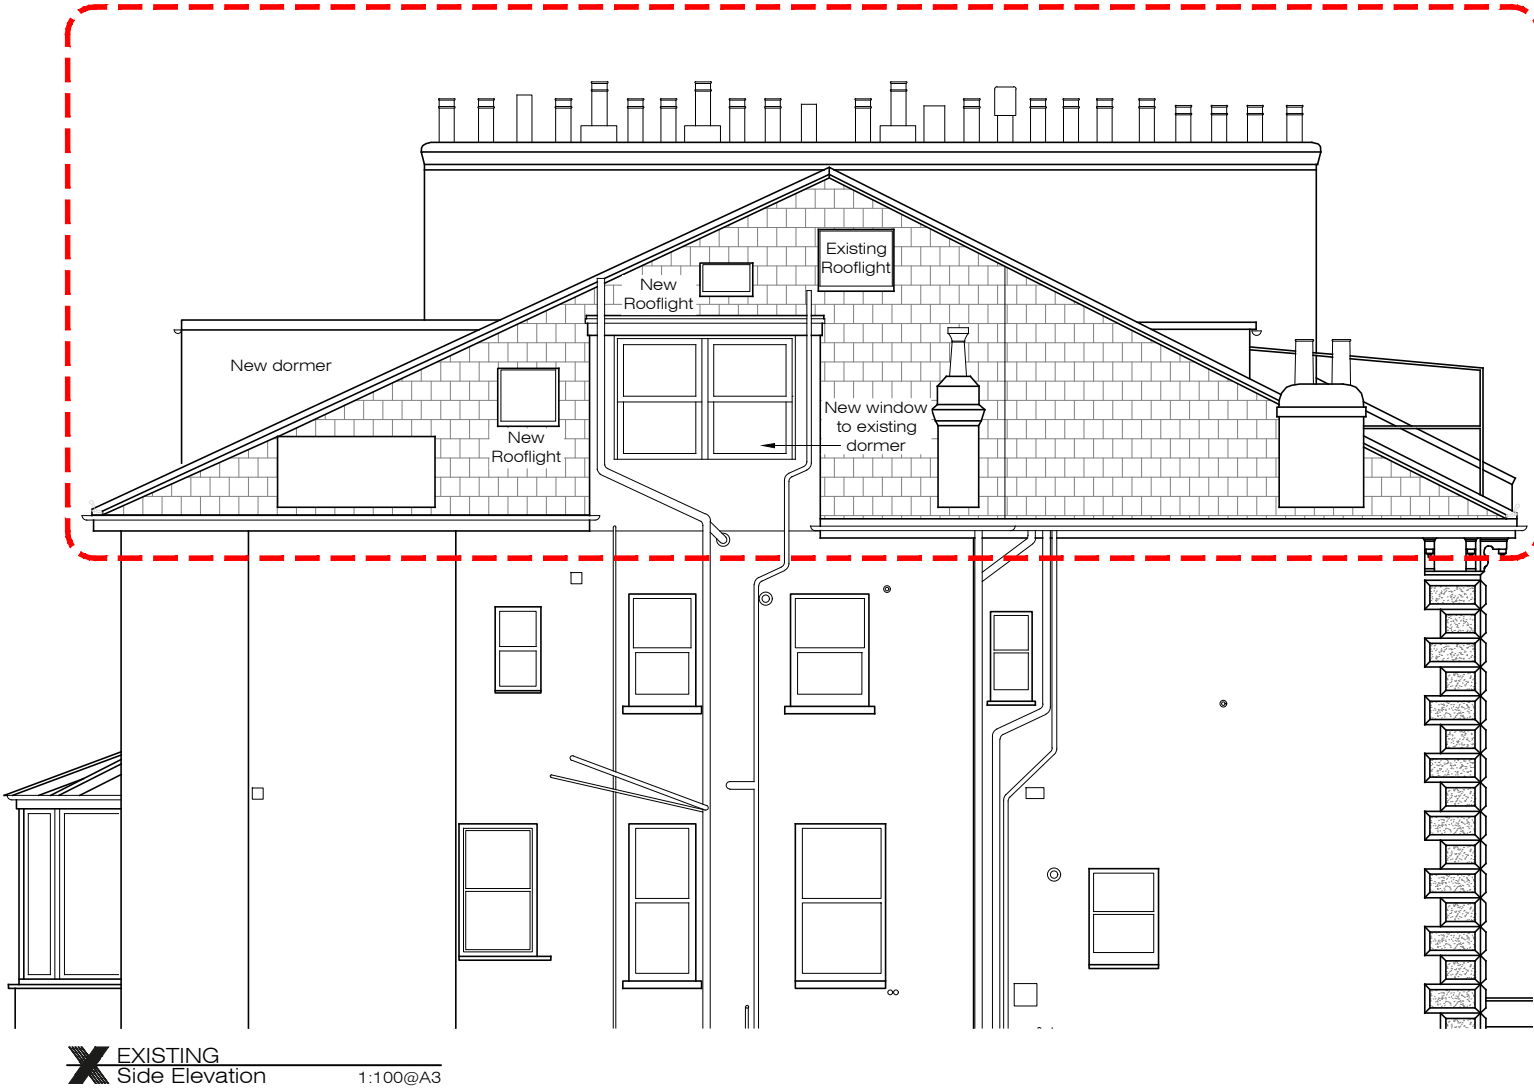


All new windows and new skylights to be conservation area style

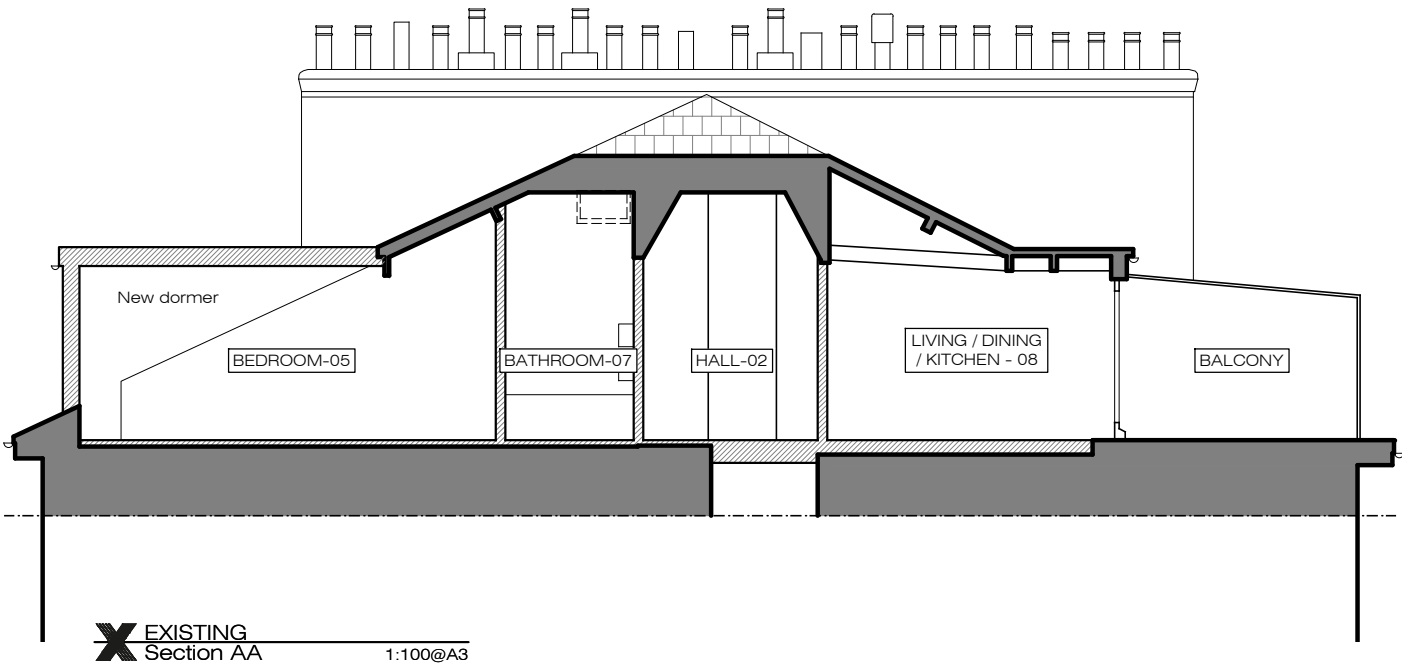

Ground Floor Office  
33 Belsize Lane  
London NW3 5AS  
Office: +44 (0) 207 431 9014  
info@xularchitecture.co.uk  
www.xularchitecture.co.uk

PLEASE NOTE:

1. All dimensions to be checked on site before fabrication,
2. Contractor to refer to engineers drawings before proceeding with works.
3. All drawings and designs are covered by design right (intellectual property), and may not be distributed, copied or issued without written permission by the Architect.
4. All design concepts are the sole property of the Architect and no adaptations, reproductions or copies may be made without written permission of the Architect.
5. These drawings are subject to any variation required or recommendation by any statutory authority, or for the better carrying out of the works.
6. Samples to be provided by contractor for XUL Architecture's approval.
7. All finishes to XUL Architecture's satisfaction.
8. All drawings to be approved by XUL Architecture prior to construction.

ADDITIONNAL NOTE:

Issue key:

Information (I)  
Planning (P)  
Tender (T)  
Construction (C)  
As Built (B)

Project Address  
50 Belsize Park Gardens, NW3 4ND

Scale 1:100@A3

Rev. Date 02.04.20

PROPOSED  
Front & Rear Elevations  
Drawn TP Dwg. No. PA-02 Rev. P-00  
Checked SS Project Number 19175

Issue For:  
PLANNING