





BOUYGUES MARK UP
PRIVACY SCREEN LOCATIONS
A.PETRASEVIC 19/02/2020

LEGEND

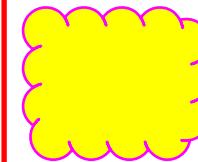

HIGHLIGHTED AREA SHOWS LOCATION
OF PRIVACY SCREEN AS PER
STANMORE DESIGN

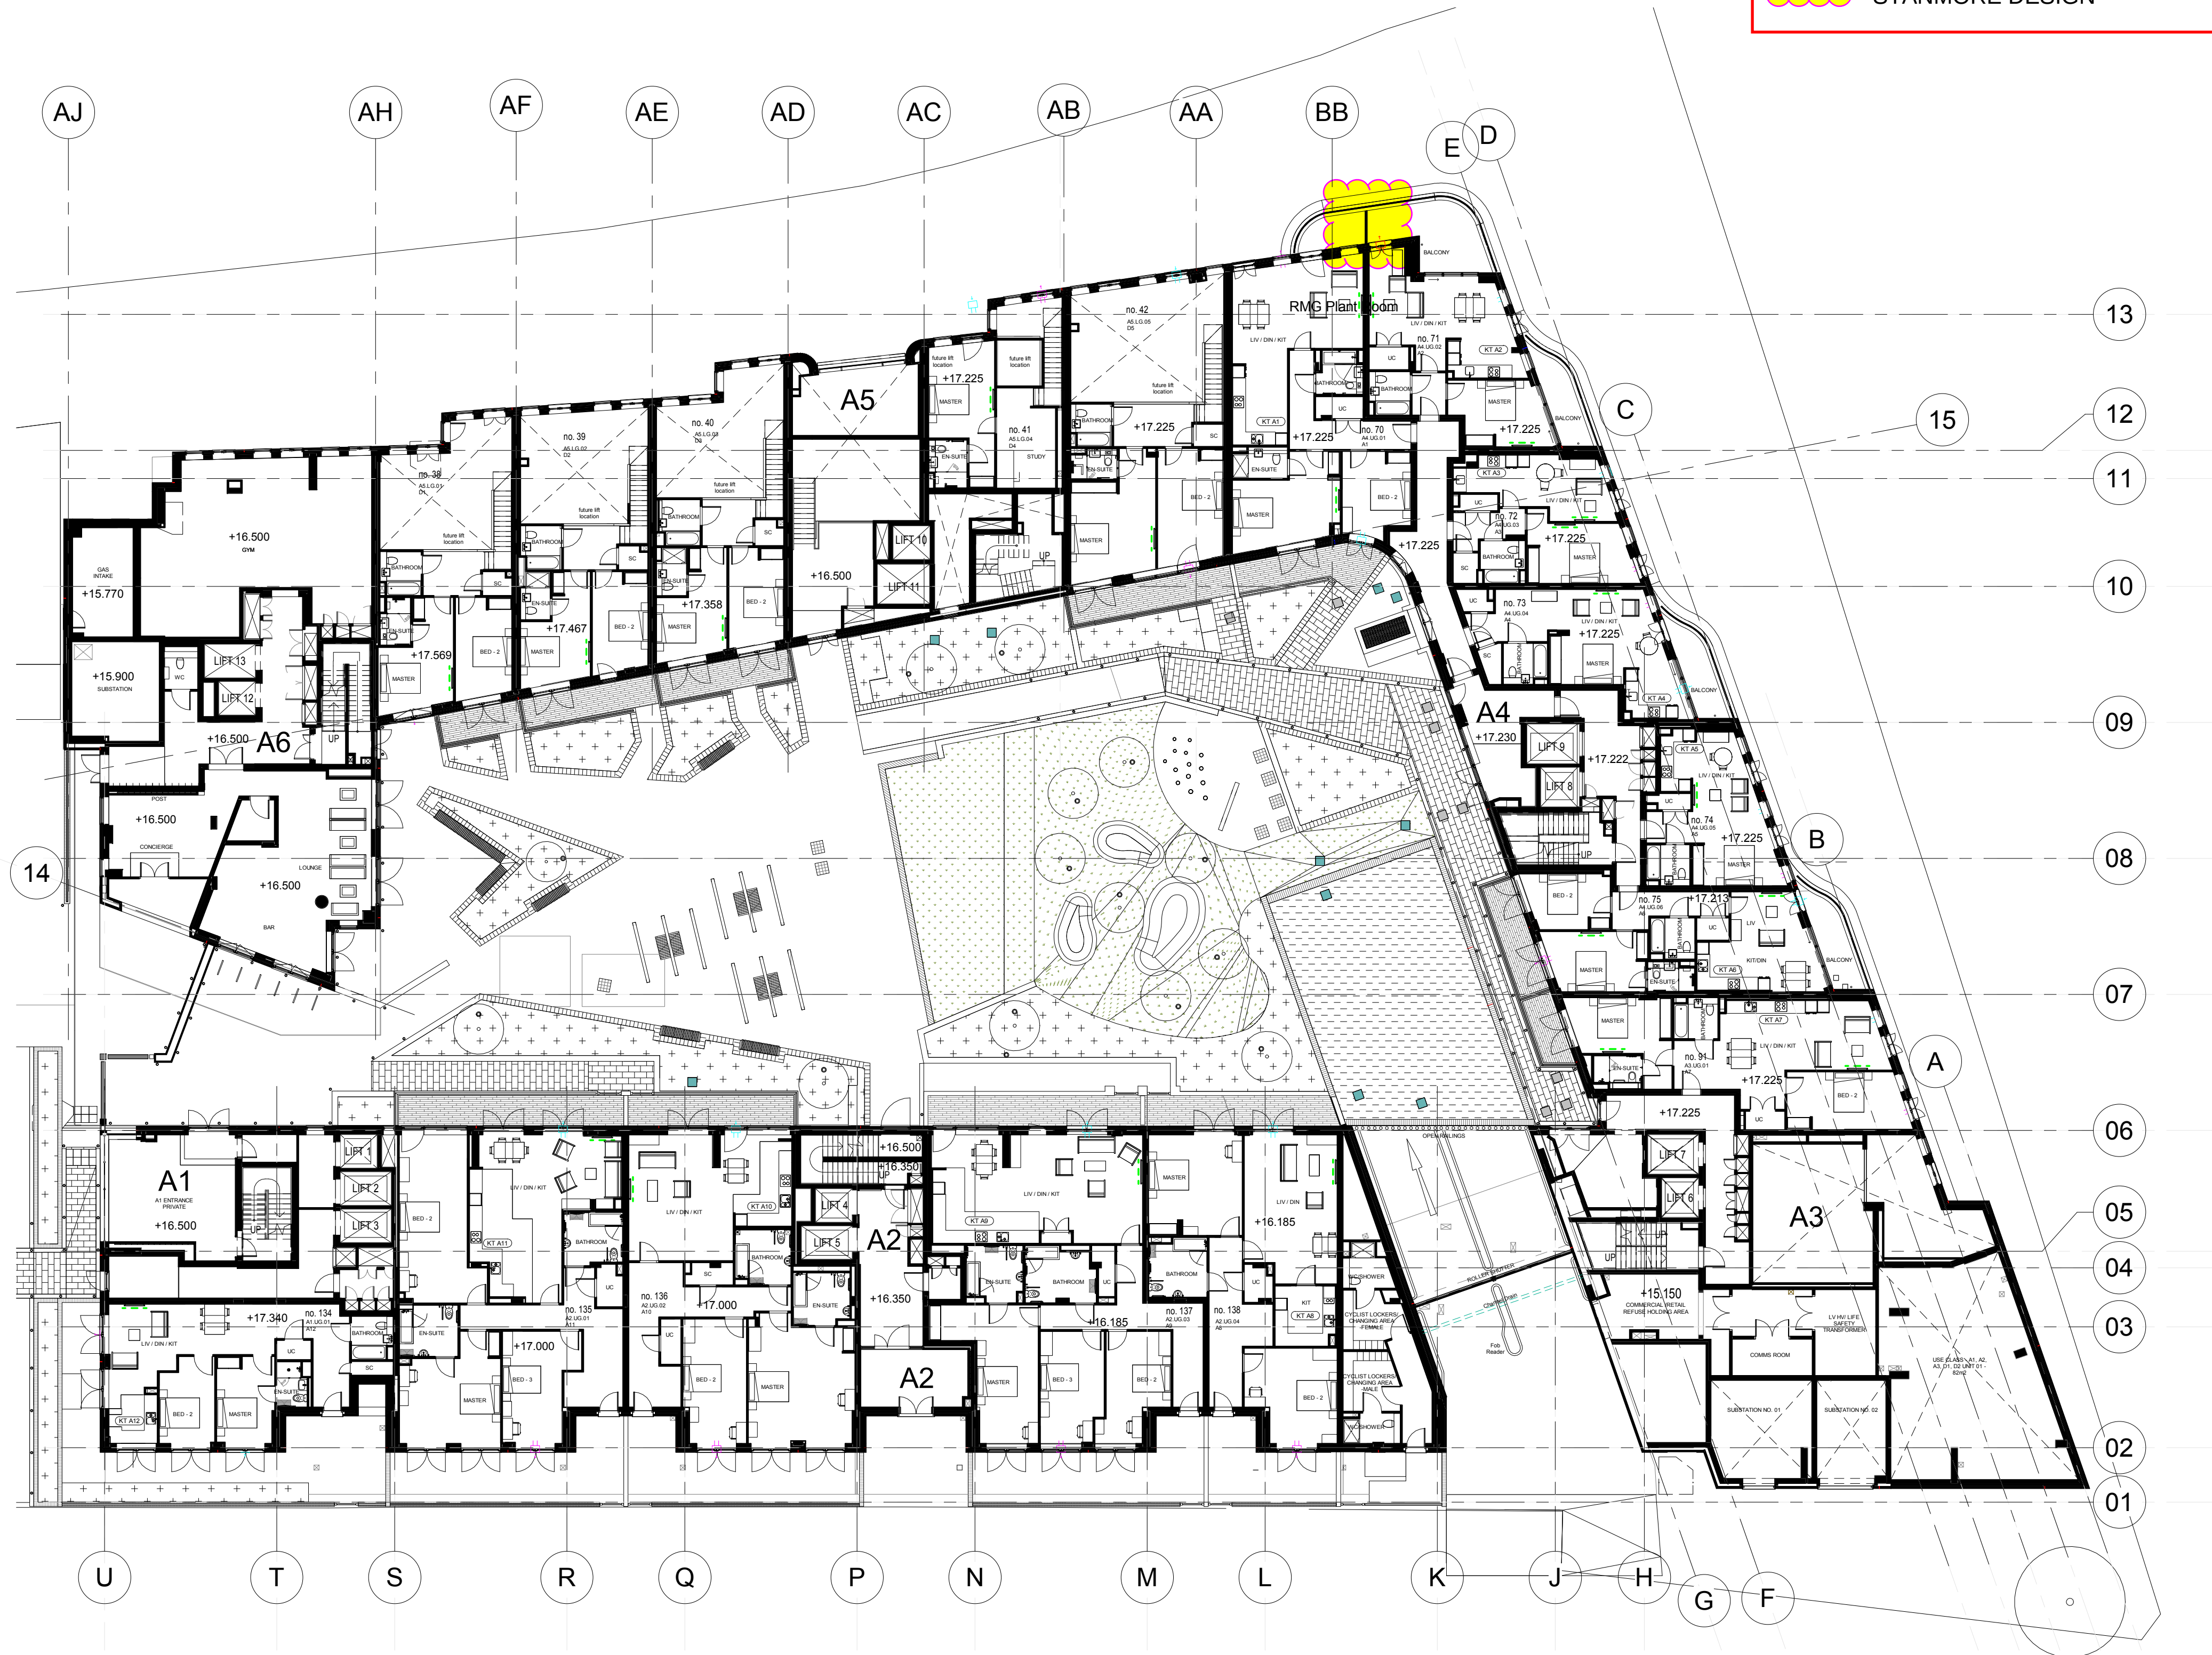

1 00 Upper Ground Level GA
Scale 1 : 200

Reference list:

Notes:
Copyright of this drawing and contents remain with Broadway Malyan.
Do not scale from drawing.
The contractor and all sub-contractors have to verify dimensions on site prior to the commencement of any works.
Any discrepancies are to be reported to the Architect / Supervising Officer immediately. If in doubt - seek clarification.

All work must comply with the current Building Regulations. No materials are to be used or method of workmanship employed unless conformity with the current Codes of the Practice & British Standards is ensured.

Refer to drawings :

MP1-BMA-ALL-SL-GA-A31-903xxx for Site Layout Plans
MP1-BMA-ALL-SL-SEC-A31-904xxx for GA Sections
MP1-BMA-ALL-SL-ELV-A31-905xxx for External Elevations
MP1-BMA-ALL-xx-GA-A31-921xxx for External Wall Setting Out
MP1-BMA-ALL-xx-GA-A31-922xxx for External Door & Windows References
MP1-BMA-ALL-xx-GA-A31-923xxx for Dry Lining Setting Out & Internal Door Ref.
MP1-BMA-ALL-xx-GA-A31-924xxx for Reflected Ceiling Plans
MP1-BMA-ALL-xx-GA-A31-925xxx for Fire Strategy Plans
MP1-BMA-ALL-SL-SCH-A31-973500 for Kitchen Types Specifications


Rev	DATE	REVISION HISTORY	Dsg	Drw	Chk	App
N	06.12.19	Drawing amended following comments				
M	28.02.19	Builders works update				
L	04.02.19	Added notes, Lift Numbers, Apartment numbers, FFL information, Stairs runs, Room names and updated Roof plant locations				

ALL REVISIONS

CLIENT LOGO

Taylor Wimpey
Central London

www.bouygues-uk.com

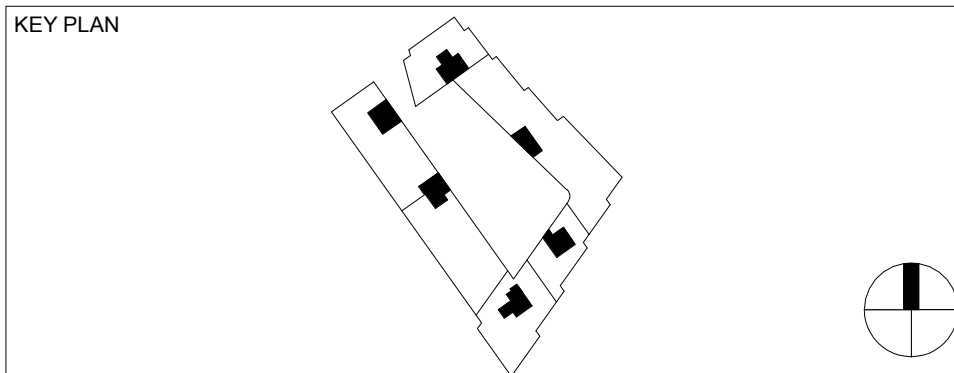

ORIGINATOR

BroadwayMalyan^{BM}
2 Castle Street, Castlefield, Manchester. M3 4LZ.
0161 819 2277

DRAWING TITLE

Mount Pleasant Phase 1
Upper Ground Plan

	Name	Signature	Date
Designed by	BMA	Broadway Malyan	06.12.19
Drawn by	VA	V. Alyas for Broadway Malyan	06.12.19
Checked	SMC	S. mcallen Broadway Malyan	06.12.19
Approved	SMC	s.mc allen Broadway Malyan	06.12.19


SCALE	@ A1	BIM FILE NAME	---
As indicated			
FIRST ISSUE DATE	03/06/18	PROPOSED STATUS	For Construction

PROJECT	ISSUER	AREA	LEVEL	TYPE	TRADE	SEQUENCE	REV
MP1	BMA	BA1	UG	GA	A31	103003	N



BOUYGUES MARK UP
PRIVACY SCREEN LOCATIONS
A.PETRASEVIC 19/02/2020

LEGEND

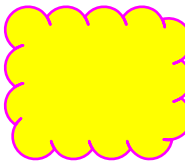

HIGHLIGHTED AREA SHOWS LOCATION
OF PRIVACY SCREEN AS PER
STANMORE DESIGN

Reference list:
List all external references and models used, this must include the revision
e.g.
MP1-AA-B1-SL-M3-A31-030001 REV A (Architectural Revit model Block 1)
MP1-BB-B1-SL-M3-A31-020002 REV C (Structural Revit model Block 1)
MP1-ZZ-B1-SL-M3-A71-050001 REV B (MEP Revit model Block 1 - Mechanical)
MP1-ZZ-B1-SL-M3-A71-060001 REV D (MEP Revit model Block 1 - Electrical)
4607-T-G-REV B (Topological Survey)
etc.

Notes:
Copyright of this drawing and contents remain with Broadway Malyan.
Do not scale from drawing.
The contractor and all sub-contractors have to verify dimensions on site prior to the
commencement of any works.
Any discrepancies are to be reported to the Architect / Supervising Officer immediately. If in
doubt - seek clarification.

All work must comply with the current Building Regulations. No materials are to be used or
method of workmanship employed unless conformity with the current Codes of the Practice &
British Standards is ensured.

Refer to drawings :

MP1-BMA-ALL-SL-GA-A31-903xxx for Site Layout Plans
MP1-BMA-ALL-SL-SEC-A31-904xxx for GA Sections
MP1-BMA-ALL-SL-ELV-A31-905xxx for External Elevations
MP1-BMA-ALL-xx-GA-A31-921xxx for External Wall Setting Out
MP1-BMA-ALL-xx-GA-A31-921xxx for External Door & Windows References
MP1-BMA-ALL-xx-GA-A31-922xxx for Dry Lining Setting Out & Internal Door Ref.
MP1-BMA-ALL-xx-GA-A31-923xxx for Reflected Ceiling Plans
MP1-BMA-ALL-xx-GA-A31-968xxx for Fire Strategy Plans
MP1-BMA-ALL-SL-SCH-A31-973500 for Kitchen Types Specifications

Inlet
Outlet


Rev	DATE	REVISION HISTORY	Dsg	Drw	Chk	App
I	19.11.19	Drawing amended following comments				
H	08.07.19	Contractors comments incorporated. Issued for construction				
G	01.03.19	Builders works & MEP update as per comments, Kitchen type tags added.				
F	04.02.19	Added notes, Lift Numbers, Apartment numbers, FFL information, Stairs runs, Room names and updated Roof plant locations				

CLIENT LOGO

**Taylor Wimpey**
Central London

www.bouygues-uk.com

KEY PLAN

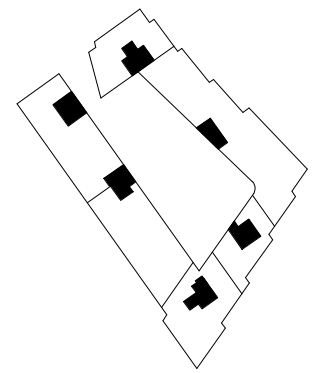

ORIGINATOR

BroadwayMalyan^{BM}
2 Castle Street, Castlefield, Manchester. M3 4LZ.
0161 819 2277

DRAWING TITLE

Mount Pleasant Phase 1
First Floor Plan

	Name	Signature	Date
Designed by	BMA		19.11.19
Drawn by	VA		19.11.19
Checked	SMC		19.11.19
Approved	SMC		19.11.19

SCALE	@ A1	BIM FILE NAME	---
As indicated			
FIRST ISSUE DATE	03/05/18	PROPOSED STATUS	FOR CONSTRUCTION

PROJECT	ISSUER	AREA	LEVEL	TYPE	TRADE	SEQUENCE	REV
MP1	BMA	BA1	01	GA	A31	103004	I



1 01 Level FFL
Scale 1 : 200



BOUYGUES MARK UP
PRIVACY SCREEN LOCATIONS
A.PETRASEVIC 19/02/2020

LEGEND



HIGHLIGHTED AREA SHOWS LOCATION
OF PRIVACY SCREEN AS PER
STANMORE DESIGN

Reference list:
List all external references and models used, this must include the revision
e.g.
MP1-AA-B1-SL-M3-A31-030001 REV A (Architectural Revit model Block 1)
MP1-BB-B1-SL-M3-A31-020002 REV C (Structural Revit model Block 1)
MP1-ZZ-B1-SL-M3-A71-050001 REV B (MEP Revit model Block 1 - Mechanical)
MP1-ZZ-B1-SL-M3-A71-060001 REV D (MEP Revit model Block 1 - Electrical)
4607-T-G-REV B (Topological Survey)
etc.

Notes:
Copyright of this drawing and contents remain with Broadway Malyan.
Do not scale from drawing.
The contractor and all sub-contractors have to verify dimensions on site prior to the
commencement of any works.
Any discrepancies are to be reported to the Architect / Supervising Officer immediately. If in
doubt - seek clarification.

All work must comply with the current Building Regulations. No materials are to be used or
method of workmanship employed unless conformity with the current Codes of the Practice &
British Standards is ensured.

Refer to drawings :

MP1-BMA-ALL-SL-GA-A31-903xxx for Site Layout Plans
MP1-BMA-ALL-SL-SEC-A31-904xxx for GA Sections
MP1-BMA-ALL-SL-ELV-A31-905xxx for External Elevations
MP1-BMA-ALL-xx-GA-A31-921xxx for External Wall Setting Out
MP1-BMA-ALL-xx-GA-A31-921xxx for External Door & Windows References
MP1-BMA-ALL-xx-GA-A31-922xxx for Dry Lining Setting Out & Internal Door Ref.
MP1-BMA-ALL-xx-GA-A31-935xxx for Reflected Ceiling Plans
MP1-BMA-ALL-xx-GA-A31-968xxx for Fire Strategy Plans
MP1-BMA-ALL-SL-SCH-A31-973500 for Kitchen Types Specifications


Inlet
Outlet

H	19.11.19	Drawing amended following comments			
G	08.07.19	Contractors comments incorporated. Issued for construction			
F	01.03.19	Builders works & MEP update as per comments, Kitchen type tags added.			
E	04.02.19	Added notes, Lift Numbers, Apartment numbers, FFL information, Stairs runs, Room names and updated Roof plant locations			
Rev	DATE	REVISION HISTORY	Dsg	Drw	Chk
ALL REVISIONS					

CLIENT LOGO

Taylor Wimpey
Central London

www.bouygues-uk.com

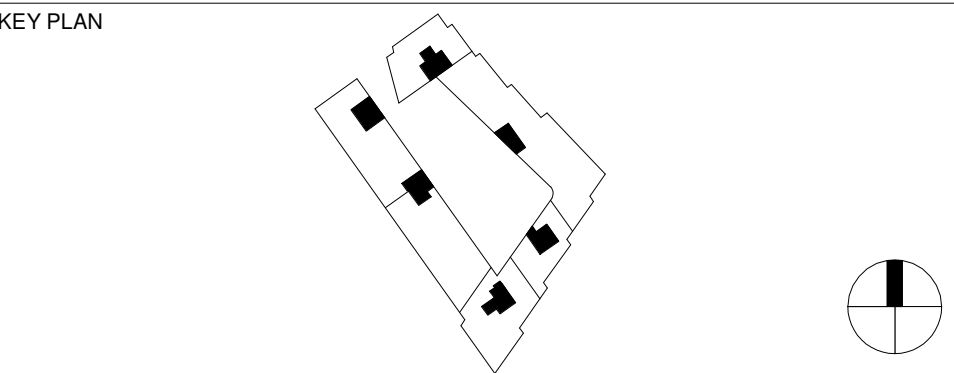

ORIGINATOR

BroadwayMalyan^{BM}

2 Castle Street, Castlefield, Manchester. M3 4LZ.
0161 819 2277

DRAWING TITLE

Mount Pleasant Phase 1
Sixth Floor Plan

	Name	Signature	Date
Designed by	BMA		19.11.19
Drawn by	VA		19.11.19
Checked	SMC		19.11.19
Approved	SMC		19.11.19

SCALE	@ A1	BIM FILE NAME	---
As indicated			
FIRST ISSUE DATE	03/05/18	PROPOSED STATUS	FOR CONSTRUCTION

PROJECT	ISSUER	AREA	LEVEL	TYPE	TRADE	SEQUENCE	REV
MP1	BMA	BA1	06	GA	A31	103009	H




1 06 Level FFL
Scale 1 : 200



BOUYGUES MARK UP
PRIVACY SCREEN LOCATIONS
A.PETRASEVIC 19/02/2020

LEGEND

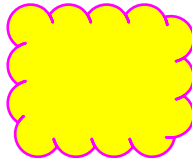

HIGHLIGHTED AREA SHOWS LOCATION
OF PRIVACY SCREEN AS PER
STANMORE DESIGN

Reference list:
List all external references and models used, this must include the revision
e.g.
MP1-AA-B1-SL-M3-A31-030001 REV A (Architectural Revit model Block 1)
MP1-BB-B1-SL-M3-A21-020002 REV C (Structural Revit model Block 1)
MP1-ZZ-B1-SL-M3-A71-050001 REV B (MEP Revit model Block 1 - Mechanical)
MP1-ZZ-B1-SL-M3-A71-060001 REV D (MEP Revit model Block 1 - Electrical)
4607-T-G-REV B (Topological Survey)
etc.
Notes:
Copyright of this drawing and contents remain with Broadway Malyan.
Do not scale from drawing.
The contractor and all sub-contractors have to verify dimensions on site prior to the commencement of any works.
Any discrepancies are to be reported to the Architect / Supervising Officer immediately. If in doubt - seek clarification.

All work must comply with the current Building Regulations. No materials are to be used or method of workmanship employed unless conformity with the current Codes of the Practice & British Standards is ensured.

Refer to drawings :


MP1-BMA-ALL-SL-GA-A31-903xxx for Site Layout Plans
MP1-BMA-ALL-SL-SEC-A31-904xxx for GA Sections
MP1-BMA-ALL-SL-ELV-A31-905xxx for External Elevations
MP1-BMA-ALL-xx-GA-A31-921xxx for External Wall Setting Out
MP1-BMA-ALL-xx-GA-A31-921xxx for External Door & Windows References
MP1-BMA-ALL-xx-GA-A31-922xxx for Dry Lining Setting Out & Internal Door Ref.
MP1-BMA-ALL-xx-GA-A31-925xxx for Reflected Ceiling Plans
MP1-BMA-ALL-xx-GA-A31-968xxx for Fire Strategy Plans
MP1-BMA-ALL-SL-SCH-A31-973500 for Kitchen Types Specifications

G	19.11.19	Drawing amended following comments				
F	01.03.19	Builders works & MEP update as per comments, Kitchen type tags added.				
E	04.02.19	Added notes, Lift Numbers, Apartment numbers, FFL information, Stairs runs, Room names and updated Roof plant locations				
D	22.10.18	SVM comments received 17.10.18 incorporated				
Rev	DATE	REVISION HISTORY	Dsg	Drw	Chk	App

CLIENT LOGO

**Taylor Wimpey**
Central London

www.bouygues-uk.com

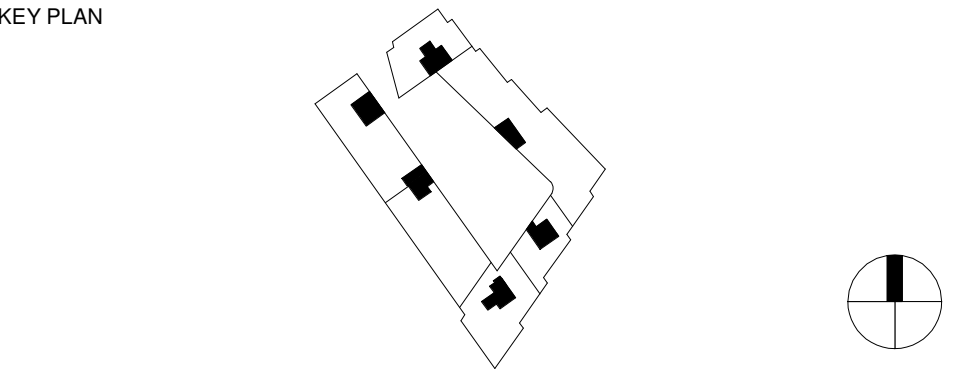

ORIGINATOR

BroadwayMalyan^{BM}
2 Castle Street, Castlefield, Manchester. M3 4LZ.
0161 819 2277

DRAWING TITLE

Mount Pleasant Phase 1
Thirteenth Floor Plan

	Name	Signature	Date
Designed by	BMA		19.11.19
Drawn by	VA		19.11.19
Checked	SMC		19.11.19
Approved	SMC		19.11.19

SCALE	@ A1	BIM FILE NAME	---
As indicated			
FIRST ISSUE DATE	03/06/18	PROPOSED STATUS	REVIEW

PROJECT	ISSUER	AREA	LEVEL	TYPE	TRADE	SEQUENCE	REV
MP1	BMA	BA1	13	GA	A31	103016	G