


CONNAUGHTS SITE INVESTIGATION LTD

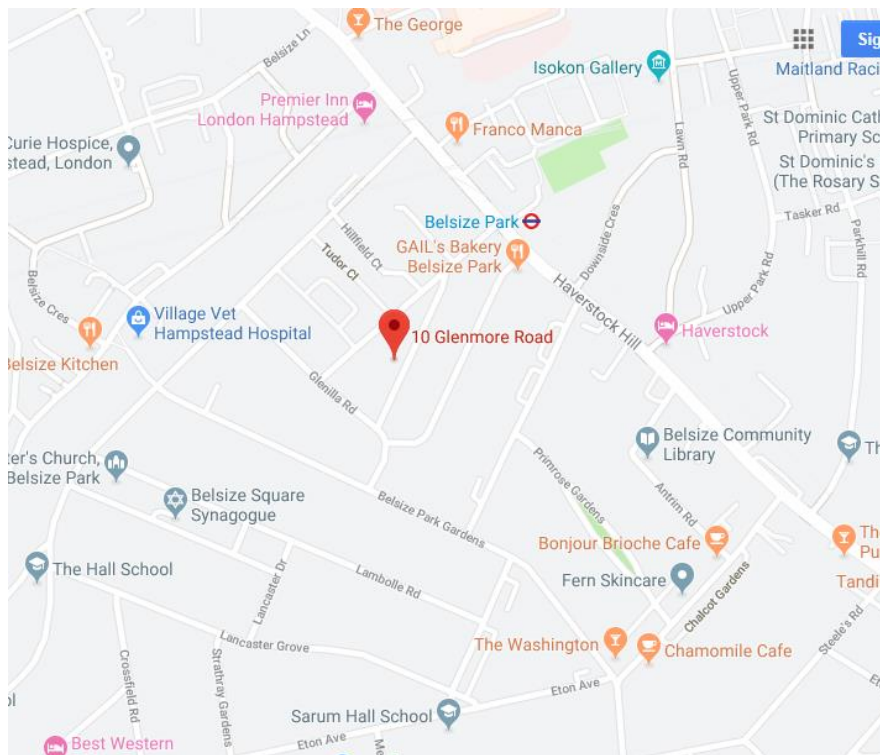

Site Investigation Report

10 Glenmore Road
London
NW3 4DB

Report No.: 0762

Date: 7th August 2019

Engineers: Structure Workshop
(Sam Riley)

Structure Workshop
4 Illiffe Yard
Walworth
London
SE17 3QA

Our Ref: SW/JW/0762
Date: 7th August 2019

F.A.O: Sam Riley (Engineer)

Dear Sir

Re: 10 Glenmore Road, London, NW3 4DB: Site Investigation Report

1.0 INTRODUCTION

In accordance with your instructions, we visited the above site on the 10th, 11th and 12th July 2019 to excavate trial pits, drill shallow hand augered boreholes and a deeper mechanical borehole. The purpose of our site investigation was to provide information on the foundations to the property in order for designs to be finalised for a proposed construction at this property. In addition to these works, contamination samples were taken in order for a preliminary contamination assessment report to be produced by Terragen Ltd. This report will be sent separately but should be read alongside this report.

The property 10 Glenmore Road is a large mid-terrace four storey residential property of estimated 1900 age. The property contained a partial basement which was 1.10m below the internal first floor level and 1.40m below the front pavement level and 1.20m below the rear garden level. It is understood that the proposed development comprises the lowering of the existing basement by approximately 1.50m to create a full habitable basement level and for this basement to be extended beneath the footprint of the property to the rear as the existing basement is only situated to the front half of the property.



2.0 GEOLOGICAL INFORMATION

The geological survey map of the area shows the site to be situated in a relatively simple geological area with the site and surrounding area underlain by the London Clay Formation of Eocene age. No other deposits were noted in close proximity to the site.

The London Clay Formation of Eocene age (34-56 million years) comprises a series of silty clays which can become clayey silts and sands. The upper sections of the London Clay is typically an orange brown colour due to oxidation of the iron within the clay and becomes stiffer and a dark brown grey colour with depth signifying less weathering.

The London Clay Formation contains silt and fine sand partings along with shell layers and also concretions of cementstone nodules and pyrite and selenite crystals. Where compaction and dewatering has occurred to a greater level, the clay can become an extremely weak mudstone. The top of the London Clay Formation can contain an overlying head deposit comprising a reworked clay mixed with locally derived flint gravels. This deposit rarely extends much beyond 2.00m and the base tends to be signified by a lack of gravels.

A borehole record search revealed two boreholes drilled close to the east of the site with both encountering made ground over the London Clay Formation. A borehole drilled in 1941 encountered MADE GROUND over a soft mud MADE GROUND to 2.43m over what appeared to be a reworked clay (MADE GROUND) to 3.84m. Below this a natural yellow CLAY (Upper weathered London Clay Formation) was encountered which became a blue CLAY (Lower less weathered London Clay Formation) below 7.62m with this clay then present to the close of the borehole at 44.19m.

3.0 FIELDWORK

The site investigation works comprised the excavation of eight trial pits internally within the house (TP1, TP2, TP3) and within the basement area (TP4, TP5, TP6, TP7, TP8) to the property.

The trial pits exposed the foundations to the property which were then logged with measurements taken along with sampling and insitu strength testing using the hand held shear vane within the base of the trial pits. The findings from the trial pit excavations is discussed within Chapter 5.0 and are held as scaled foundation diagrams within Appendix 2. The location of the trial pits are also marked on the site plan within Appendix 1.

In addition to this, a single window sample borehole was drilled to the rear of the building using a light weight, restricted access, Competitor Window Sampling drilling rig with the borehole drilled within the rear garden. The borehole was progressed by the hammer drilling of 1m long steels cutting tubes within which are held a 1m long clear plastic liner which collects undisturbed samples. The diameter of the cutting tube is reduced regularly to allow for drilling to depths. This borehole was drilled to a depth of 5.00m where an impenetrable claystone layer prevented any further progress. Within the deep borehole a water monitoring standpipe was installed within the borehole at a depth of 5.00m.



Insitu strength testing was conducted within the borehole using the dynamic probe test which was set up to use the same drop weight and height as the Standard Penetration Testing (SPT). This test comprises the recording of the number of blows taken to drive a steel cone into the soil from the drop of a 63.5kg hammer of a distance of 760mm. For the dynamic probe test blow counts are taken at 100mm intervals throughout. To determine the SPT N Value, three of these increments are added together. To convert into an estimated shear strength a factor of 4.8 is used based on Stroud & Butler - The Standard Penetration Test and the Engineering Properties of Glacial Materials – 1975. The findings of the borehole drilling is discussed within Chapter 6.0 and held as a borehole log within Appendix 3. The location of the borehole is marked on the site plan within Appendix 1.

4.0 LABORATORY TESTING

Selected soil samples taken from the window sample boreholes were sent to Soil Property Testing for UKAS accredited soils testing in accordance with British Standards 1377: Testing of soils for civil engineering purposes.

Six samples were tested for their moisture content with three samples also tested for their plasticity using the Atterberg limits test. A single undisturbed sample was tested for its undrained shear strength using the triaxial compression test with another sample tested for its one dimensional consolidation properties using the oedometer test. Four samples were tested for their soluble sulphate and pH value. The results of the soil laboratory testing is discussed within Chapter 5.0 and held as results summaries and test sheets within Appendix 4.

5.0 TRIAL PIT FINDINGS

i. Trial pits excavated within the main house

Trial pit 1 was excavated internally on the right hand party wall and exposed the party wall foundation (A-A) and the small internal return wall (B-B). The party wall foundation (A-A) comprised brickwork which extended to 1.64m below the first floor level where a projection was encountered. Unfortunately, due to the depth of the foundation and the collapse of trial pit sides, it was not possible to expose or locate by probing the extent of the projection or the base of the foundation.

The internal return wall foundation comprised brickwork which appeared to follow the party wall foundation with the brickwork continuing below 1.00m. A sleeper wall was constructed in front of this wall which was seated onto the oversite concrete. Again, the base of this foundation could not be exposed due to the depths involved and collapse of the excavations.



Trial pit 2 was excavated internally on the left hand party wall and exposed the party wall foundation (A-A) and the small internal return wall (B-B). The party wall foundation (A-A) comprised brickwork which extended to 1.50m (proved by full excavation) and then continued to a depth in excess of 2.00m (proved by probing). Unfortunately, due to the depth of the foundation and the collapse of trial pit sides, it was not possible to expose or locate by probing the extent of the projection or the base of the foundation.

The internal return wall foundation comprised brickwork which appeared to follow the party wall foundation with the brickwork continuing below 1.85m where a possible step out of the brickwork was present, although this was difficult to determine accurately due to the depths involved and collapse of the excavations.

Trial pit 3 was excavated internally on the left hand party wall and exposed the party wall foundation (A-A) and the small internal return wall (B-B). Both foundation profiles (A-A & B-B) comprised brickwork which extended to 1.60m below the first floor level. Unfortunately, due to the depth of the foundation, the collapse of trial pit sides and lack of space available, it was not possible to expose or locate by probing the extent of the projection or the base of the foundation.

ii. Trial pits excavated within the basement

Trial pit 4 was excavated in the rear right hand corner of the basement to the property and exposed the foundations to the rear wall (A-A) and right hand flank wall (B-B). The rear wall foundation (A-A) comprised brickwork with a single step out onto a concrete strip. The total projection of this foundation was 240mm with the concrete 100mm thick and the foundation seated at a depth of 0.34m below the basement level. The foundation was seated onto soft to firm, medium strength (V: 48-54kPa), orange brown, silty CLAY.

The right hand flank wall foundation (B-B) comprised brickwork with three step outs onto a concrete strip. The total projection of this foundation was 250mm with the concrete 200mm thick and the foundation seated at a depth of 0.50m below the basement level. The foundation was seated onto soft to firm, medium strength (V: 46-58kPa), orange brown, silty CLAY. This trial pit was extended slightly with a hand augered borehole which found the clay to remain medium strength (V: 56-62kPa) at 1.00m.



Trial pit 5 was excavated in the rear left hand corner of the basement to the property and exposed the foundations to the left hand flank wall (A-A) and the rear wall (B-B). The left hand flank wall foundation (A-A) comprised brickwork with three step outs onto a concrete strip. The total projection of this foundation was 240mm with the concrete 200mm thick and the foundation seated at a depth of 1.12m below the basement level. The foundation was seated onto soft to firm, medium strength (V: 42-44kPa), orange brown, silty CLAY.

The rear wall foundation (B-B) comprised brickwork with a single step out onto a concrete strip. The total projection of this foundation was 130mm with the concrete 250mm thick and the foundation seated at a depth of 0.54m below the basement level. The foundation was seated onto soft to firm, low to medium strength (V: 38-40kPa), orange brown, silty CLAY.

Trial pit 6 was excavated on the right hand flank wall to the basement and exposed the flank wall (A-A) and a small internal return wall (B-B). The right hand flank wall foundation (A-A) comprised brickwork with four step outs onto a concrete strip. The total projection of this foundation was 270mm with the concrete 190mm thick and the foundation seated at a depth of 1.05m below the basement level. The foundation was seated onto soft to firm, medium strength (V: 40-42kPa), orange brown, silty CLAY. This clay was found to remain medium strength (V: 52-54kPa) at 1.50m.

The internal wall foundation (B-B) comprised brickwork with a single step out (projection 75mm) seated directly onto the subsoil at a depth of 0.69m. This foundation was seated onto soft, low strength (V: 32-36kPa), orange brown, silty CLAY.



Trial pit 7 was excavated in the front right hand corner of the basement to the property and exposed the foundations to the front wall (A-A) and the right hand flank wall (B-B). The front wall foundation (A-A) comprised brickwork with two step outs onto a concrete strip. The total projection of this foundation was 380mm with the concrete 270mm thick and the foundation seated at a depth of 0.565m below the basement level. The foundation was seated onto soft, low strength (V: 34-38kPa), orange brown, silty CLAY.

The right hand flank wall foundation (B-B) comprised brickwork with three step outs onto a concrete strip. The total projection of this foundation was 245mm with the concrete 260mm thick and the foundation seated at a depth of 0.545m below the basement level. The foundation was seated onto soft, low strength (V: 34-38kPa), orange brown, silty CLAY.

Trial pit 8 was excavated in the front lightwell and exposed the foundations to the rear wall to the lightwell structure (A-A) and a return wall at the bottom of the lightwell (B-B). The rear wall to the lightwell comprised brickwork with a single step out (projection 60mm) onto a weak concrete and brick footing which was 350mm thick and seated at a depth of 0.88m onto a soft, low strength (V: 28-32kPa), orange brown, silty CLAY. The side wall to the lightwell (B-B) foundation comprised brickwork onto weak brick concrete which was 800mm thick and appeared to be seated onto dense clinker / concrete which may be drain benching associated with the drainage running across the front of the house in this location.



No root activity was encountered within any of the trial pits.

No water inflows were encountered within any of the trial pits which were found to be dry on completion of the site works.

6.0 BOREHOLE FINDINGS

The borehole was drilled in the rear garden at a level approximately 200mm below the front pavement level, 200mm above the basement level and 900mm below the first floor level. This borehole encountered astroturf over a sand layer to 0.20m over a soft to firm, low strength, brown and brownish grey, slightly gravelly slightly sandy clay with red brick, coal and charcoal fragments (MADE GROUND). This was present to a depth of 1.60m where a firm, medium strength, brown with some light grey veining CLAY was encountered. This stratum was found to become high strength by 4.15m and was present to a depth of 5.00m where a very dense / hard, CLAYSTONE layer was encountered. This stratum was found to be impenetrable with the window sampling drilling rig and the borehole was closed at 5.10m due to a lack of progress.

No water inflows were encountered within this borehole which was found to be dry on completion of the site works and on removal of the borehole casing. A water monitoring standpipe was installed within this borehole at a depth of 5.00m with a gravel pack from 5.00-1.00m followed by a one metre bentonite seal and a steel security cover.

Depth	N Value (conversion to undrained shear strength)	Strength description
1.15m	8 blows (38.4kPa)	Low strength
2.15m	9 blows (43.5kPa)	Medium strength
3.15m	12 blows (57.6kPa)	Medium strength
4.15m	19 blows (91.2kPa)	High strength
5.15m	75+ blows	Very dense

7.0 LABORATORY TESTING RESULTS

The **moisture content** and the **plasticity** of samples of the underlying silty, shelly CLAYS was tested using the Atterberg limits test. This testing found the samples to be of high to very high plasticity with a plasticity indices ranging from **40% to 55%** which indicates that this clay has a high volume change potential.

BH	Depth	Soil Type	MC	LL	PL	PI	Class	Ret	Comments
WS1	1.00m	MADE GROUND	38.6%						
	1.50m	MADE GROUND	35.5%						
	2.00m	CLAY	36.5%	85	26	59	CVO	0%	1. No Des 2. No Des
	2.50m	CLAY	32.9%						
	3.00m	CLAY	33.5%	83	25	58	CV	0%	1. No Des 2. No Des
	4.00m	CLAY	30.1%	84	26	58	CV	0%	
	4.50m	CLAY	31.0%						

MC: moisture content (MC): Corrected moisture content due to gravel content
 LL: Liquid Limit PL: Plastic limit PI: Plastic Index

Desiccation analysis of the clay samples showed no evidence for significant levels of desiccation when applying the moisture content relationships devised by Professor Driscoll's involving the liquid limit⁽¹⁾ and plastic limit⁽²⁾. This would indicate that the clay underlying this site has not been affected by desiccation by removal of moisture.

Triaxial compression testing was conducted on an undisturbed sample extracted from the boreholes at a depth of 3.50m in order to determine the undrained shear strength of the cohesive soil at this depth. This testing was conducted at overburden pressures to replicate the pressure conditions the samples would have been in within the ground. This testing finds the CLAY present at the anticipated foundation level for the proposed new basement to be of high strength (92kPa) which is consistent with the insitu strength testing which found this soil to be high strength at 3.15m (78kPa).

BH	Depth	MC	Wet Density Mg/m3	Dry Density Mg/m3	Deviator Stress (kPa)	Shear Stress (cu)	Soil Strength Descriptions using BS5930 and (BS 14688)
WS1	3.50m	32.2	1.96	1.48	182	92kPa	High strength

A single undisturbed soil sample from 3.50m was tested for its consolidation properties using the one dimensional oedometer test. This test involves applying increasing pressure to a prepared specimen of soil and measuring the amount of compaction (settlement) followed by removal of the loading and measuring the uplift. This provides information to enable an assessment to be made regarding the effect on the soil of increased loadings and removal of loading.

DETERMINATION OF THE ONE-DIMENSIONAL CONSOLIDATION PROPERTIES											
Borehole/ Pit No.	Depth (m)	Type	Ref.	Specimen Depth (m) and Orientation	Water Content (%)	Description					Remarks
WS1	3.50	L	4	3.50	30.9	Stiff (high strength) fissured orangish brown CLAY with occasional brown mottling, and selenite crystals.					Specimen dried at 80°C due to the presence of selenite.
				Horizontal							
Initial Conditions				Increment No.	Load (kN/m ²)	Change in Height (mm)	Void Ratio	Cv (m ² /yr)	Mv (m ² /MN)	Temp (°C)	Corrected Cv
Height	mm			1	80	0.070	0.902			22	
Diameter	mm			2	4	-0.266	0.939		0.25	22	
Wet Weight	g			3	80	-0.008	0.911	0.37	0.19	22	0.35
Water Content	%			4	200	0.363	0.870	0.34	0.18	22	0.32
Bulk Density	Mg/m ³			5	400	0.803	0.823	0.26	0.13	21	0.25
Particle Density			Assumed	2.82	6	800	1.325	0.766	0.24	0.08	0.23
Voids Ratio					7	80	0.620	0.842	0.06	21	
Degree of Saturation	%										
Swelling Pressure	kN/m ²										
Dry Density	Mg/m ³										

Four samples were also tested for their **soluble sulphate content and pH value**. British Standards guidelines for assessing the aggressive chemical environment provide classification of sites based on SO₄ levels. To convert SO₃ to SO₄ levels a factor of 1.2 must be applied followed by multiplying by 1000 to convert from g/l to mg/kg.

BH	Depth	Soil type	Water soluble sulphate 2:1 (g/l)	Calculated Concentration So4 (g/l)	Calculated total So4 result	pH Value	Concrete Class
WS1	1.00m	MG	0.34	0.41	408mg/kg	7.7	DS1
	1.50m	MG	0.31	0.38	372mg/kg	7.7	DS1
	2.50m	CLAY	0.18	0.22	216mg/kg	8.1	DS1
	4.50m	CLAY	2.37	2.84	2844mg/kg	7.5	DS3

Applying these results to the standards chart indicates that the underlying CLAY soils at shallower depths have a low level of sulphates with three of the samples falling within the concrete class DS1 which indicate that no precaution against sulphate attack is required. However, the deeper sample tested at 4.50m fell within the concrete class DS3 which indicates that deeper concrete may require special precautions. We would note that further testing may be required if deeper concrete is to be installed.

8.0 COMMENTS

i. Ground Conditions

The geological survey map of the area suggested that the site was situated within an area underlain by a variable amount of MADE GROUND over the London Clay Formation. This is consistent with the findings from the trial pit and borehole drilling which found MADE GROUND to 1.60m and then beneath this, a brown CLAY with a very dense claystone layer present at 5.00m.

We would note that the laboratory testing revealed the sample of clay at 2.00m to be an organic clay which may mean that this could be reworked ground with the natural soil coming in slightly deeper at between 2.00-2.50m.



Laboratory testing did not reveal any significant desiccation was present within the soil although allowances will need to be made for the mature tree present in the neighbouring rear garden with foundations taken below the influence of this tree. A useful guide is provided by the NHBC Chapter 4.2 – building near trees which gives recommended foundation depths based on the size species and proximity of the tree within either a low, medium or as in this case high volume change potential soil.

No water inflows were encountered within any of the trial pits or boreholes which were all found to be dry on completion of site works. The water monitoring standpipe will provide longer term information but it would appear that groundwater will not significantly affect the proposed construction with any inflows likely to be localised and should be controllable with pumping. As with all basements, longer term waterproofing will be needed as part of the design.

Trial pit excavations found the original foundations to the property to be seated at a substantial depth in excess of 1.60-2.00m in trial pits 1, 2 and 3 excavated on the walls to the rear part of the property which was not underlain by the basement. Given the depth of these foundations, the base of these could not be revealed or detected by probing but from the foundations exposed within the basement it would be reasonable to assume a similar founding depth.

The borehole drilled to the rear found MADE GROUND to 1.60m with possible reworked ground to 2.00-2.50m (based only on the laboratory testing). Below this the natural very highly plastic silty CLAY (London Clay Formation) was encountered. In terms of foundations for the new rear basement extension and the deepened basement to the front of the house, then foundations should be taken into the natural London Clay formation where suitable bearing capacity exists and at a depth below the influence of the mature tree to the rear of the site.

We would envisage that given the limited access then the most likely foundation solution would be sectional underpinning of the existing foundations using mass concrete footings. Although a piled solution could be considered, the need for specialist plant and difficulty in gaining access may mean this is problematical. In order to provide a full basement height it is understood that the existing basement is to be lowered by 1.50m which would mean a basement level of approximately 1.90m below the pavement level, 2.60m below the internal first floor level and 2.10m below the borehole location. This will mean foundations taken into the underlying London Clay Formation and seated at an estimated depth of around 3.00-3.50m below the borehole level.

Figures have been provided to give a guide to the anticipated bearing capacities of the soil based on the SPT N values and corresponding conversions to undrained shear strengths and also from the triaxial strength testing. We would note that all figures provided should be used as a guide to soil bearing capacities but should be verified by a structural engineer with knowledge of the design criteria and loadings. All bearing capacity figures provided are based on an assumed 1.00m wide strip foundation unaffected by groundwater with clearly greater bearing capacities achievable with wider foundations.

Test Depth	Soil Type	SPT & Shear strength	Approximate Bearing Capacity
WS1 at 2.15m	CLAY (reworked?)	9 blows (43.2kPa)	85kN/m ²
WS1 at 3.15m	London Clay Fm	12 blows (57.6kPa)	110kN/m ²
WS1 at 3.50m	London Clay Fm	92kPa (triaxial test)	180kN/m ²
WS1 at 4.15m	London Clay Fm	19 blows (91.2kPa)	180kN/m ²

Sufficient information is held in the report for the initial design assessment for foundations for the proposed basement construction. From the bearing capacities stated above, it would appear on initial assessment to possess adequate bearing for the use of mass concrete foundations seated into the underlying London Clay Formation, especially at 3.00m and below. If additional bearing capacity is required, then it is possible to incorporate the basement floor into the design almost creating a box type structure with the floor acting like a reinforced raft tied into the footings. The results of the oedometer testing should provide sufficient information to determine the possible extent of any settlement associated with adding addition loadings along with any uplift caused when removing overburden pressures as the soil is removed.

If a piled foundation solution is to be chosen, then it is likely that a deeper borehole will be required to provide information on subsoil conditions at depth. In order to penetrate through any claystone layers then a larger window sample rig will be needed and would most likely need to be drilled within the front garden.

As with all such basement developments, care will need to be taken to ensure that the adjacent buildings and structures are not adversely impacted by the proposed works.


9.0 CERTIFICATION

The conclusions and recommendations given within this report, are based upon the stated development plans for the site. If the site is to be developed for a more or less sensitive use then a different interpretation may be appropriate. This report relies upon the co-operation of other organisations and the free availability of information and total access. Therefore, no responsibility can be accepted for conditions arising from information, which was not available to the investigation team as a result of information being withheld or access prevented.

The analyses and opinions expressed in the report are based upon data obtained from the site investigation. Responsibility cannot be accepted for variation in ground conditions between and around exploratory points not revealed by the data or at the time of the investigation.

The report may suggest an opinion on the nature of the strata or conditions between exploratory points and below the maximum depth of investigation. However, this is for guidance only and no liability can be accepted for its accuracy.

Signed

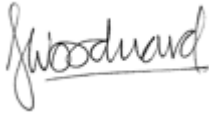

James Woodward BSc(Hons) DipHE

For and on behalf of
CONNAUGHTS SITE INVESTIGATION LTD

Signed




Mark Pickering FGS

For and on behalf of
CONNAUGHTS SITE INVESTIGATION LTD

Fastest 2.10m clear line.
 800 Salt Glass
 80.95

live/Elev?
 12-11-2
 5
 12.05

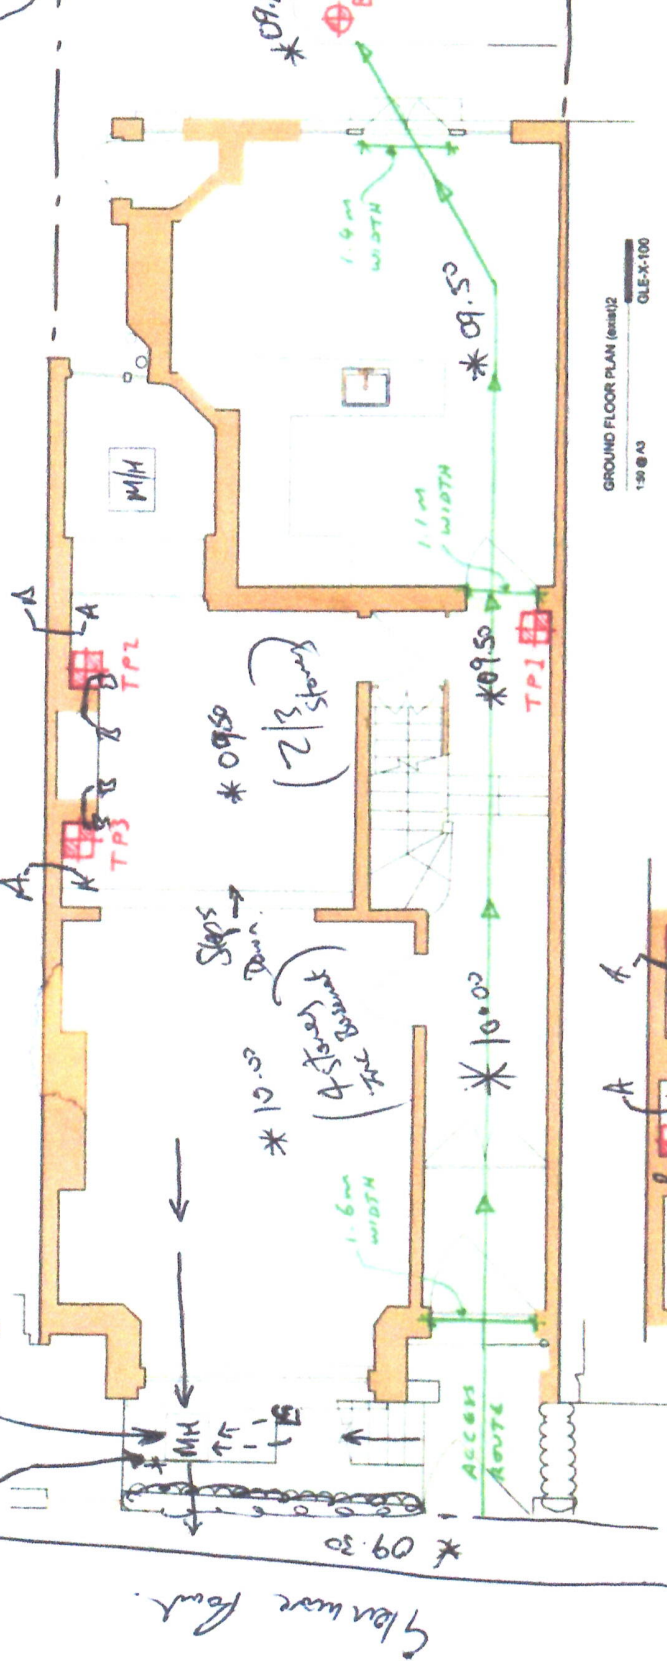

GROUND FLOOR PLAN (sheet 2)
 1:50 @ A3 GLE-X-100

BASEMENT PLAN (sheet 1)
 1:50 @ A3 GLE-X-100

<p>PROJECT INFORMATION</p> <p>PROJECT NAME: [illegible]</p> <p>CLIENT: [illegible]</p> <p>DATE: [illegible]</p> <p>SCALE: [illegible]</p> <p>PROJECT NO: [illegible]</p> <p>REVISION: [illegible]</p>	
<p>DESIGNER:</p> <p>[illegible]</p>	
<p>10 GLENHOMER ROAD WILSON NSW 4030</p>	
<p>EXISTING GROUND AND BASEMENT FLOOR PLANS</p>	
<p>DATE: 12.05.12</p> <p>BY: [illegible]</p> <p>FOR: [illegible]</p>	<p>PROJECT NO: GLE-X-100</p> <p>REVISION: [illegible]</p>

INFORMATION

PLEASE REFER TO THE PROJECT INFORMATION SHEET FOR A FULL LIST OF THE PROJECT'S SPECIFICATIONS AND CONDITIONS. THIS DRAWING IS A PRELIMINARY DESIGN AND IS SUBJECT TO CHANGE WITHOUT NOTICE. THE CLIENT ACCEPTS RESPONSIBILITY FOR THE ACCURACY OF THE INFORMATION PROVIDED TO THE DESIGNER. THE DESIGNER ACCEPTS RESPONSIBILITY FOR THE DESIGN AND CONSTRUCTION OF THE PROJECT. THIS DRAWING IS NOT TO BE USED FOR ANY OTHER PURPOSES WITHOUT THE WRITTEN PERMISSION OF THE DESIGNER.

Connaughts Site Investigation Ltd

35 Green Lane, Leigh on Sea, Essex, SS9 5AP

Tel: 01702 528098

Fax: 01702 528098

Appendix No. 2

Sheet No. 1

Job No. 0762

Date: July 2019

LOCATION 10 Glenmore Road, London, NW3 4DB

Scale: 1:20


Trial Pit 1

Profile A-A

Profile B-B

No roots encountered

No water inflows encountered
trial pit dry on completion.

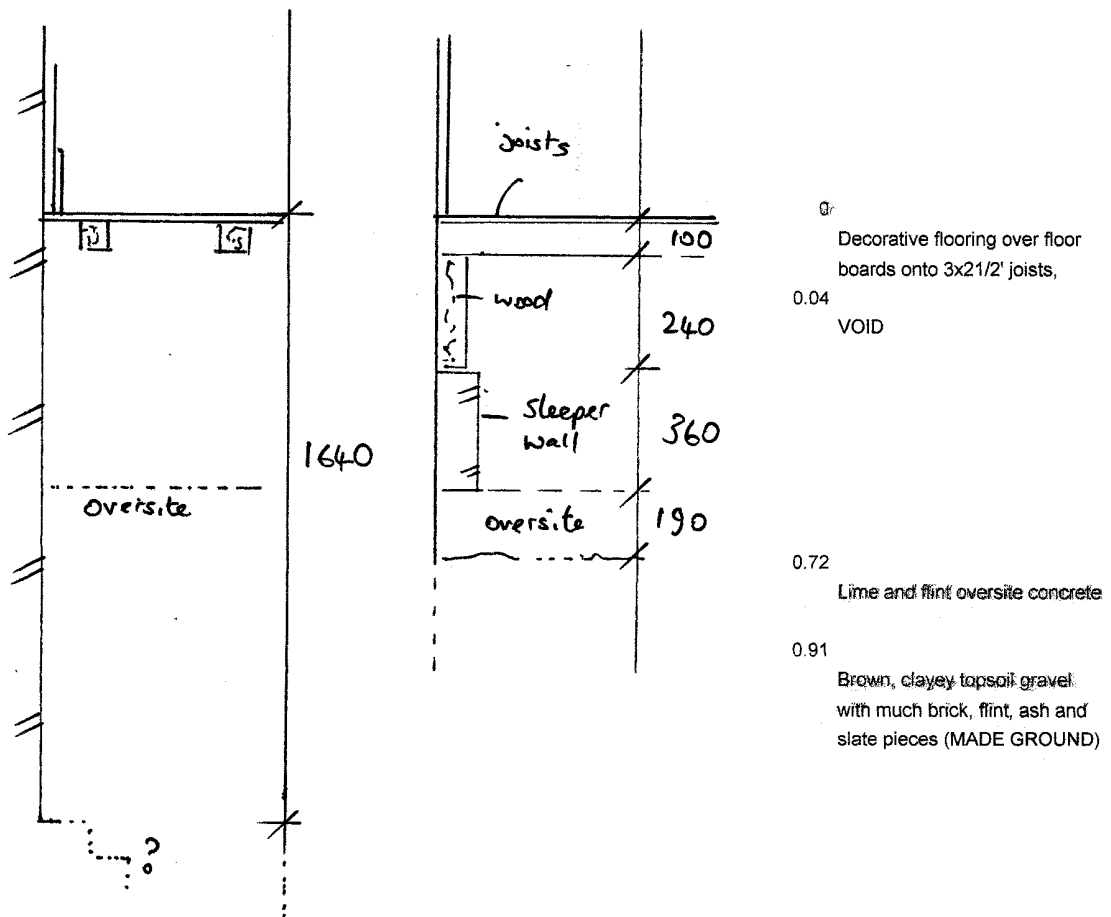

This foundation was difficult to expose due to the sleeper wall obstructing the excavation. Probing showed it was present at 1.00m+

Unable to locate base of foundation due to depth and collapse of trial pit sides.

D= small disturbed sample, B= large bulk sample, U= Undisturbed sample, MP= Mackintosh probe blow counts, V= Shear Vane Reading (kPa)

Connaughts Site Investigation Ltd

35 Green Lane, Leigh on Sea, Essex, SS9 5AP

Tel: 01702 528098

Fax: 01702 528098

Appendix No. 2

Sheet No. 2

Job No. 0762

Date July 2019

LOCATION 10 Glenmore Road, London, NW3 4DB

Scale: 1:20


Trial Pit 2

Profile A-A

Profile B-B

No roots encountered

No water inflows encountered
trial pit dry on completion.

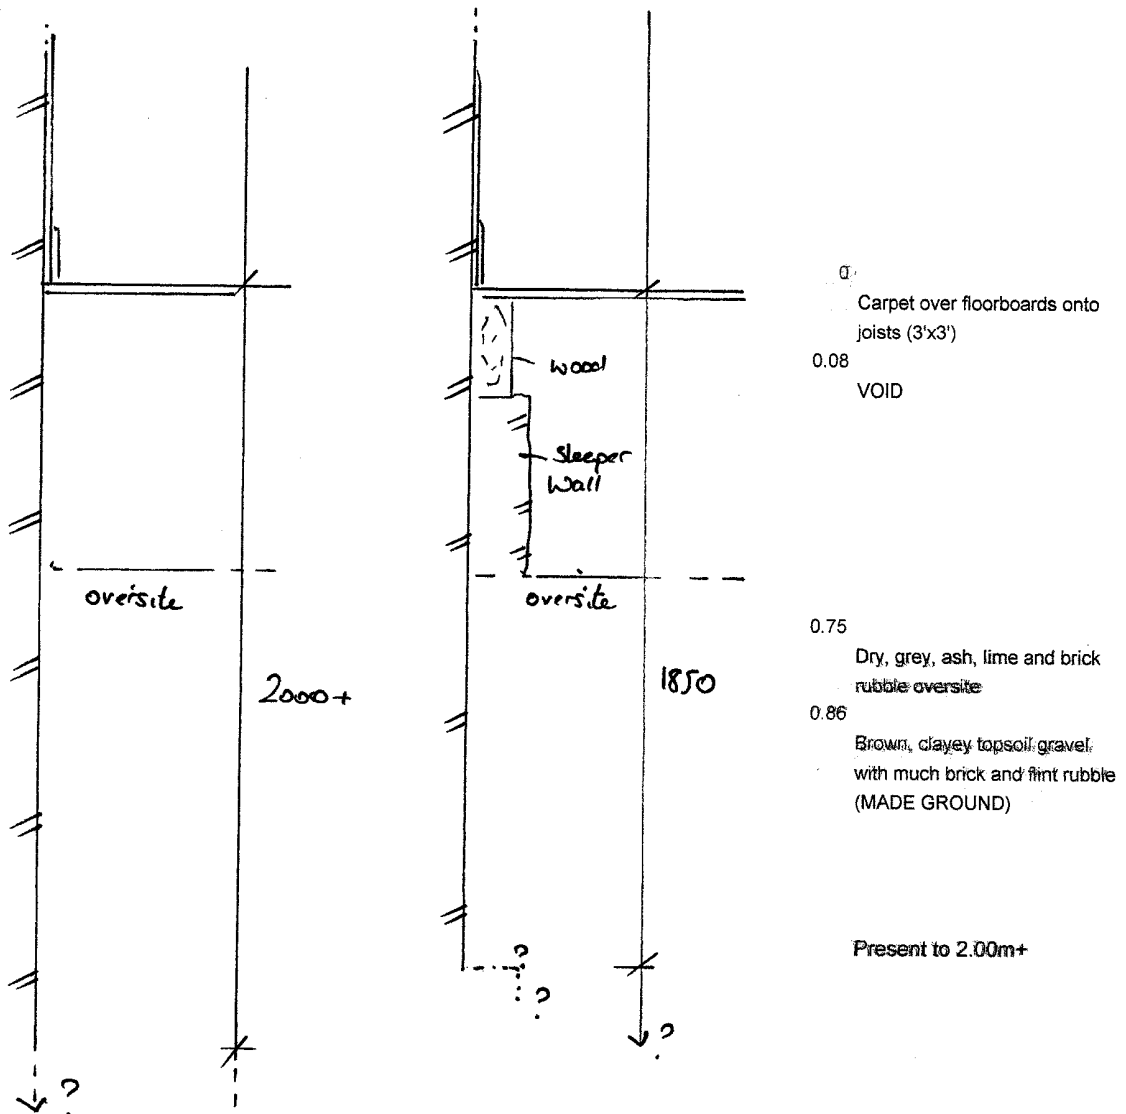

Unable to locate base of foundation due to depth and collapse of trial pit sides - stopped at 2.00m

Possible step out at 1.85m but unable to determine projection or depth of foundation due to the depth and collapse of trial pit sides

D= small disturbed sample, B= large bulk sample, U= Undisturbed sample, MP= Mackintosh probe blow counts, V= Shear Vane Reading (kPa)

Connaughts Site Investigation Ltd

35 Green Lane, Leigh on Sea, Essex, SS9 5AP

Tel: 01702 528098

Fax: 01702 528098

Appendix No. 2

Sheet No. 3

Job No. 0762

Date: July 2019

LOCATION 10 Glenmore Road, London, NW3 4DB


Scale: 1:20

Trial Pit 3

Profile A-A & B-B

No roots encountered

No water inflows encountered
trial pit dry on completion.

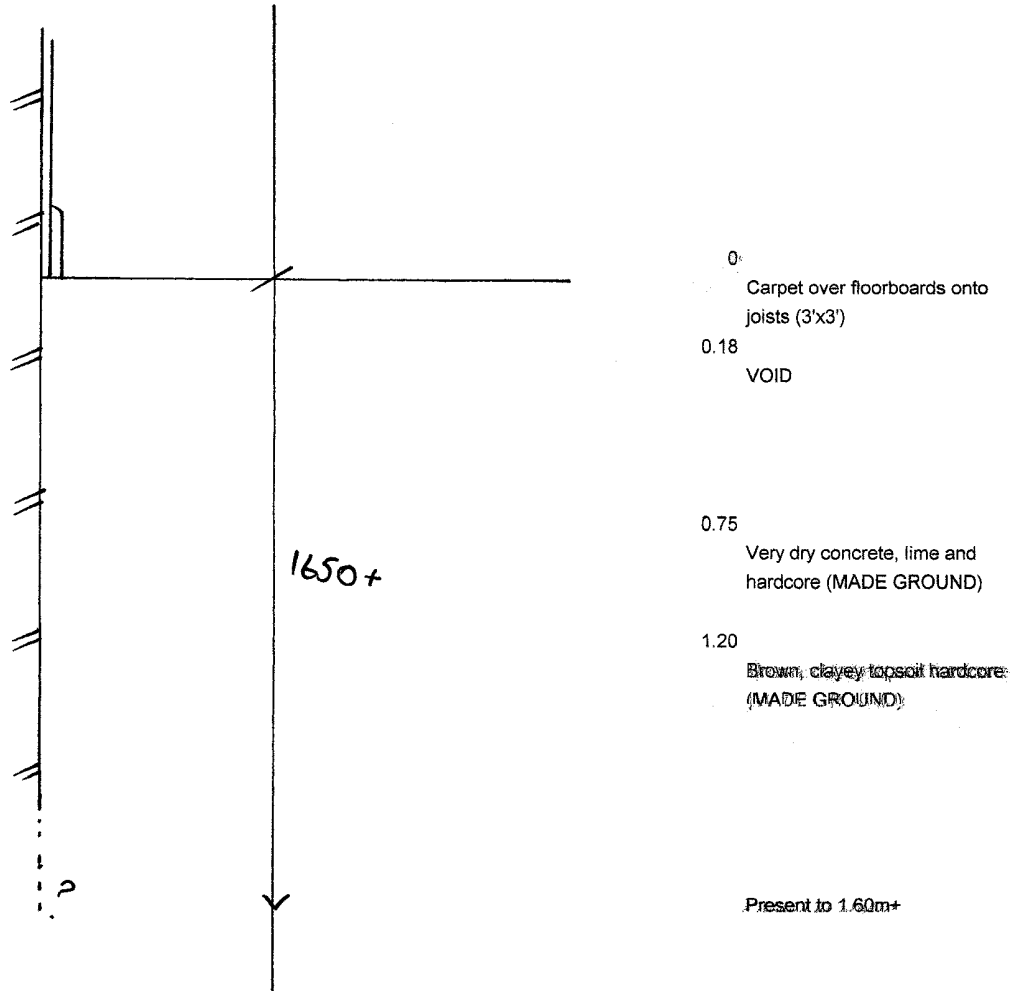

Unable to work in the space available very easily - the steps and floor joists meant little access was available. Excavated and probed to 1.60m but with both profiles continuing below this depth. Unable to excavate further with collapse of trial pit sides.

D= small disturbed sample, B= large bulk sample, U= Undisturbed sample, MP= Mackintosh probe blow counts, V= Shear Vane Reading (kPa)

Connaughts Site Investigation Ltd

35 Green Lane, Leigh on Sea, Essex, SS9 5AP

Tel: 01702 528098

Fax: 01702 528098

Appendix No. 2

Sheet No. 4

Job No. 0762

Date: July 2019

LOCATION 10 Glenmore Road, London, NW3 4DB

Scale: 1:10


Trial Pit 4

Profile A-A

Profile B-B

No roots encountered

No water inflows encountered
trial pit dry on completion.

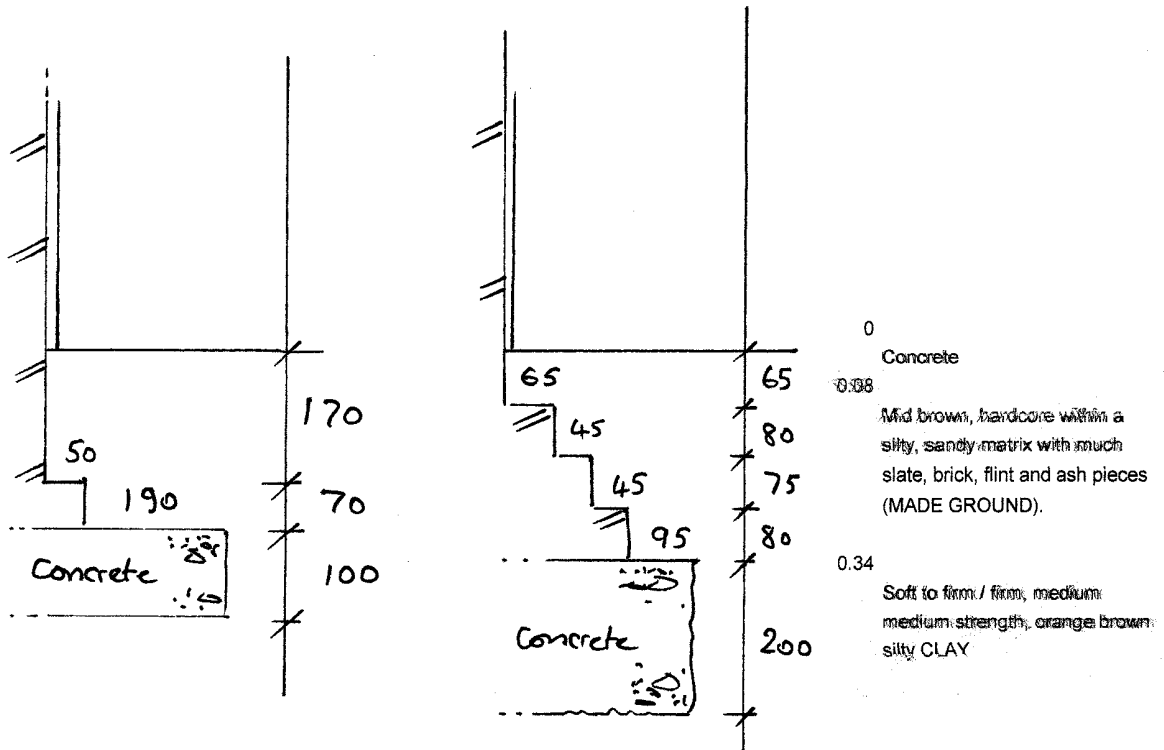

D1 at F.L.(0.34m)
V: 48-54kPa

D1 at F.L.(0.50m)
V: 46-58kPa

Founding stratum:

Soft to firm / firm, medium strength, orange brown silty CLAY

Connaughts Site Investigation Ltd

35 Green Lane, Leigh on Sea, Essex, SS9 5AP

Tel: 01702 528098

Fax: 01702 528098

Appendix No. 2

Sheet No. 5

Job No. 0762

Date. July 2019

LOCATION 10 Glenmore Road, London, NW3 4DE

Scale: 1:10



Trial Pit 5

Profile A-A

Profile B-B

No roots encountered

No water inflows encountered
trial pit dry on completion.

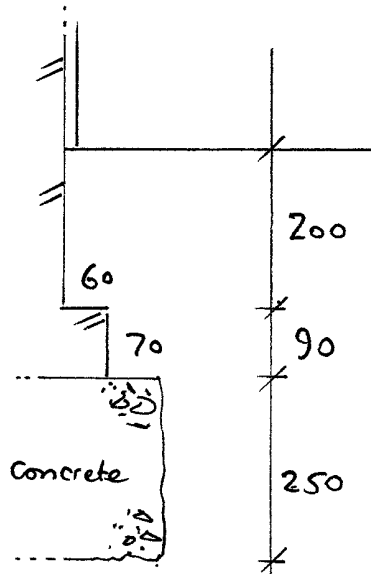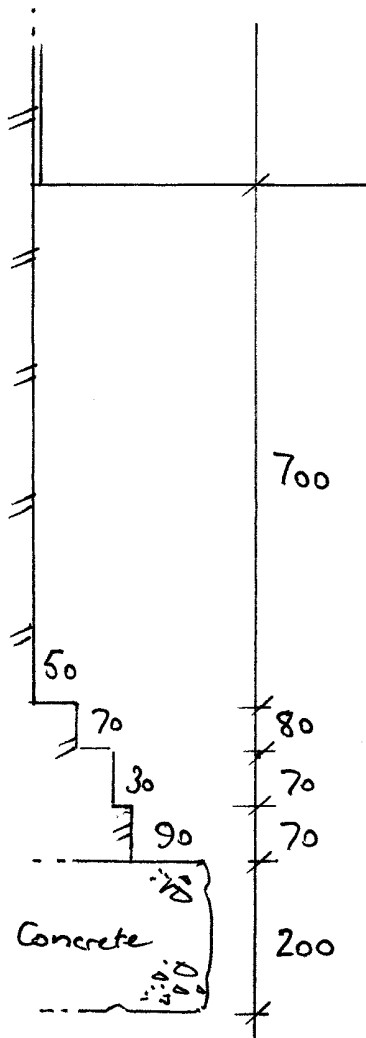

- 0 Concrete
- 0.12 Mid brown, hardcore within a silty, sandy matrix with much slate, brick, flint and ash pieces (MADE GROUND).
- 0.50 Soft to firm, low to medium strength, orange brown, silty CLAY

D1 at F.L.(0.54m)
V: 38-40kPa

Founding stratum:
Soft to firm, low to medium strength,
orange brown, silty CLAY

D1 at F.L.(1.12m)
V: 42-44kPa

Founding stratum:
Soft to firm, medium strength, orange
brown, silty CLAY

Note: Profile A-A had a 200mm projection which stepped up into profile B-B

D= small disturbed sample, B= large bulk sample, U= Undisturbed sample, MP= Mackintosh probe blow counts, V= Shear Vane Reading (kPa)

Connaughts Site Investigation Ltd

35 Green Lane, Leigh on Sea, Essex, SS9 5AP

Tel: 01702 528098

Fax: 01702 528098

Appendix No. 2

Sheet No. 6

Job No. 0762

Date: July 2019

LOCATION 10 Glenmore Road, London, NW3 4DE

Scale: 1:10



Trial Pit 6

No roots encountered

No water inflows encountered
trial pit dry on completion.

Profile A-A

Profile B-B

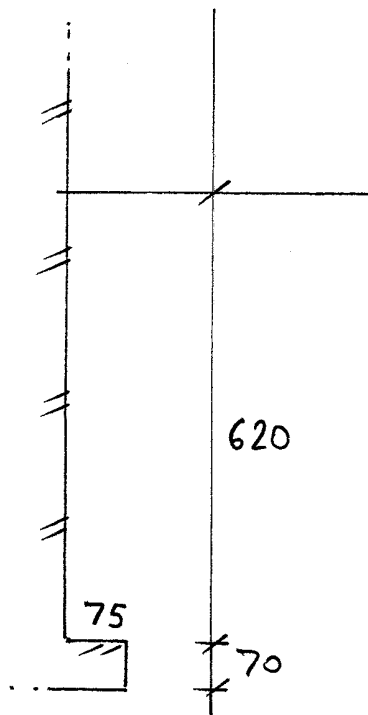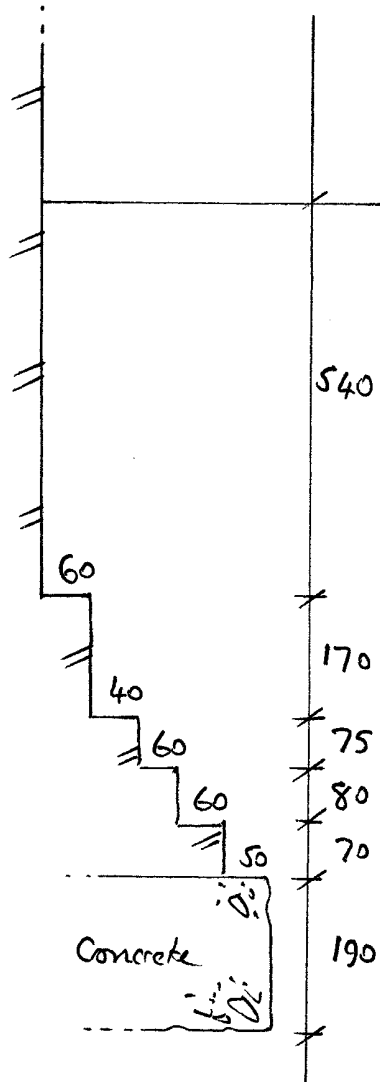

0
Concrete

0.13
Mid: brown, hardcore within a silty, sandy matrix with much slate, brick, flint and ash pieces (MADE GROUND).

0.63
Soft to firm, low to medium strength, orange brown, silty CLAY

D1 at F.L.(0.69m)
V: 32-36kPa

Founding stratum:
Soft to firm, low strength,
orange brown, silty CLAY

D1 at F.L (1.05m)
V: 40-42kPa

Founding stratum:
Soft to firm, medium strength, orange
brown, silty CLAY

D2 at 1.50m. V: 52-54kPa

D= small disturbed sample, B= large bulk sample, U= Undisturbed sample, MP= Mackintosh probe blow counts, V= Shear Vane Reading (kPa)

Connaughts Site Investigation Ltd

35 Green Lane, Leigh on Sea, Essex, SS9 5AP

Tel: 01702 528098

Fax: 01702 528098

Appendix No. 2

Sheet No. 7

Job No. 0762

Date: July 2019

LOCATION 10 Glenmore Road, London, NW3 4DB

Scale: 1:10


Trial Pit 7

Profile A-A

Profile B-B

No roots encountered

No water inflows encountered
trial pit dry on completion.

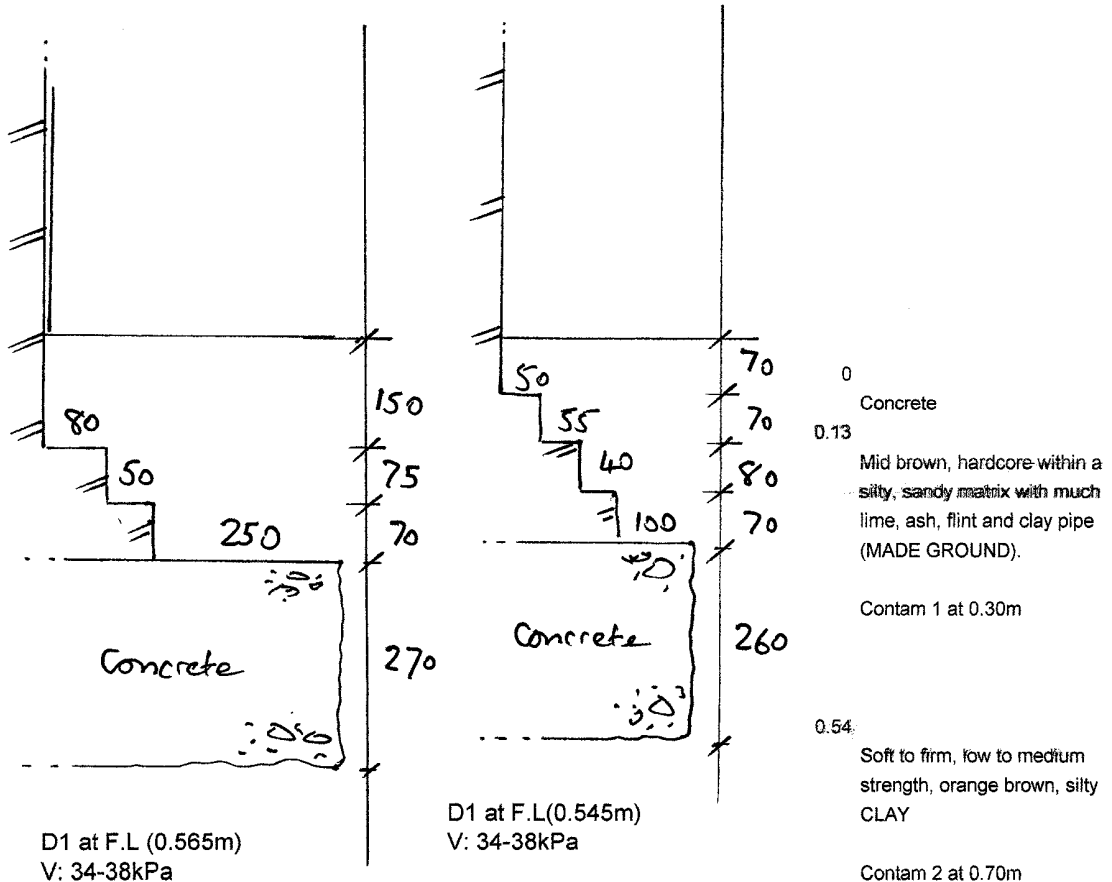

Connaughts Site Investigation Ltd

35 Green Lane, Leigh on Sea, Essex, SS9 5AP

Tel: 01702 528098

Fax: 01702 528098

Appendix No. 2

Sheet No. 8

Job No. 0762

Date: July 2019

LOCATION 10 Glenmore Road, London, NW3 4DB

Scale: 1:10


Trial Pit 8 (through bottom step)

No roots encountered

No water inflows encountered
trial pit dry on completion.

Profile A-A

Profile B-B

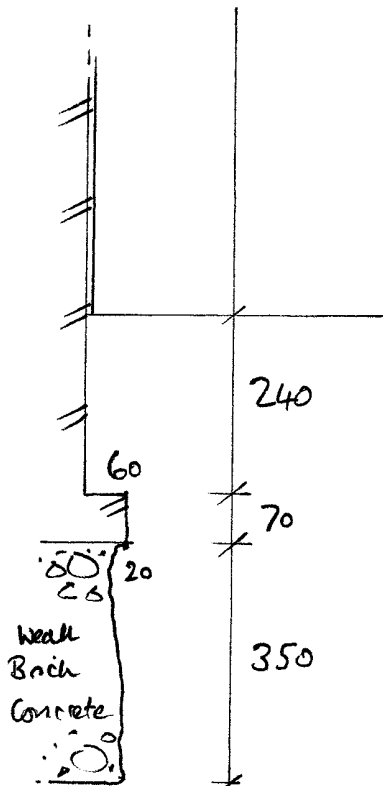


D1 at F.L. (0.66m)
V: 28-32kPa

Founding stratum:

Soft, low strength, brown grey, gravelly clay with occasional ash and flint gravel (MADE GROUND)

D2 at 1.00m
V: 40-42kPa

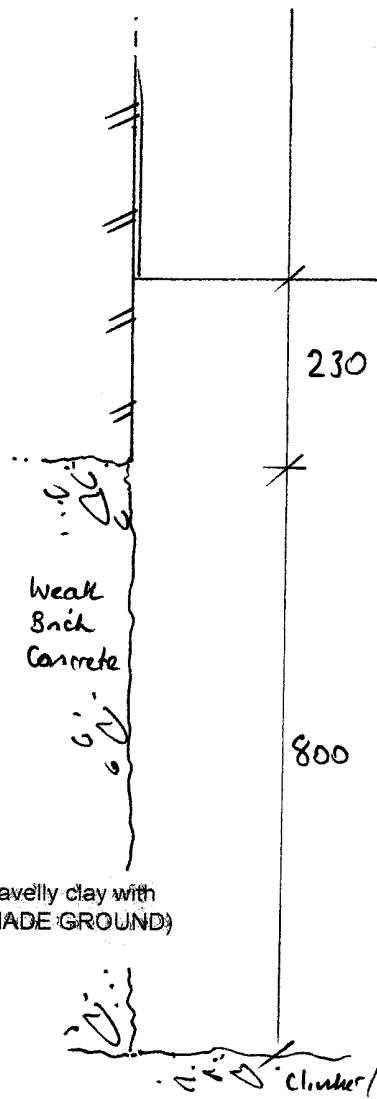

- 0 Concrete
- 0.12 Weak leanmix clinker, flint and brick rubble FILL
- Contam 1 at 0.30m
- 0.60 Brown grey, gravelly clay with occasional ash and flint gravel (MADE GROUND).
- 0.85 Soft to firm, medium strength, orange brown, silty CLAY

Notes: Layer of hard clinker / concrete possibly benching associated with drainage entering manhole?

Connaughts Site Investigation Ltd

35 Green Lane, Leigh on Sea, Essex, SS9 5AP

Tel: 01702 528098

Fax: 01702 528098

Appendix No. 3

Sheet No. 1

Job No. 0762

Date. July 2019

Borehole 1

LOCATION

10 Glenmore Road, London, NW3 4DB

Method: Window sampler

Description of Stratum (m)	Legend	Depth (m)	Samples		Tests		Field Observations
			Type	Depth	Type	Value	
Astriturf over orange brown, coarse sand		0.20m	U1	0.00			87mm dia. 90% recovery
Soft to firm, brpwn and brownish grey, slightly gravelly, slightly sandy clay with gravel fine, angular, red brick and rare ash fragments (MADE GROUND).		0.5	U2	1.00	N	8 blows	87mm dia 90% recovery Borehole cased to 1.00m
		1.0					
		1.5					
Firm becoming stiff, medium strength, brown with some light grey veining, CLAY		2.0	U3	2.00	N	9 blows	77mm dia 100% recovery
		2.5					
		3.0	U4	3.00	N	12 blows	77mm dia 100% recovery
		3.5					
		4.0	U5	4.00	N	19 blows	77mm dia 100% recovery
Becoming high strength from 3.00m		4.5					
		5.0					
Hard / vey dense light brown CLAYSTONE		5.00m					
WS1 closed at 5.10m due to impenetrable nature of claystone band.		5.10m	*	5.00	N	75+ blows	for 100mm travel
		5.5					
		6.0					

Remarks:

No water inflows encountered in trial pit or borehole - dry on completion of site works. Water monitoring standpipe installed at 5.00m with gravel pack from 1.00-5.00m and a bentonite seal from G.L to 1.00m. Steel security cover fitted to standpipe.

Engineers: Structure Workshop


Key

U Undisturbed Sample	N Standard Penetration Test (C / S)
D Small disturbed sample	N* SPT test as a dynamic probe
B Bulk distured sample	V Shear vane test
W Water sample	MP Nackintosh probe (blows/0.3m)
	BL No. blows to obtain U100 sample



TEST REPORT
ISSUED BY SOIL PROPERTY TESTING LTD
DATE ISSUED: 02/08/2019



Contract	10 Glenmore Road, London, NW3 4DB	
Serial No.	35570	
Client:	<i>Soil Property Testing Ltd</i>	
Connaughts Site Investigation Ltd 35 Green Lane Leigh on Sea Essex SS9 5AP	15, 16, 18 Halcyon Court, St Margaret's Way, Stukeley Meadows, Huntingdon, Cambridgeshire, PE29 6DG Tel: 01480 455579 Email: enquiries@soilpropertytesting.com Website: www.soilpropertytesting.com	
Samples Submitted By: Connaughts Site Investigation Ltd	Approved Signatories:	
Samples Labelled: 10 Glenmore Road, London, NW3 4DB	<input checked="" type="checkbox"/> J.C. Garner B.Eng (Hons) FGS Technical Director <input type="checkbox"/> S.P. Townend FGS Quality Manager <input type="checkbox"/> W. Johnstone Materials Lab Manager <input type="checkbox"/> D. Sabnis Operations Manager 	
Date Received: 19/07/2019	Samples Tested Between: 19/07/2019 and 02/08/2019	
Remarks: For the attention of Mark Pickering		
Notes:		
1	All remaining samples or remnants from this contract will be disposed of after 21 days from today, unless we are notified to the contrary.	
2	(a) UKAS - United Kingdom Accreditation Service (b) Opinions and interpretations expressed herein are outside the scope of UKAS accreditation	
3	Tests marked "NOT UKAS ACCREDITED" in this test report are not included in the UKAS Accreditation Schedule for this testing laboratory.	
4	This test report may not be reproduced other than in full except with the prior written approval of the issuing laboratory.	



TEST REPORT

ISSUED BY SOIL PROPERTY TESTING LTD
DATE ISSUED: 02/08/2019



0998

Contract		10 Glenmore Road, London, NW3 4DB																	
Serial No.		35570							Target Date			01/08/2019							
Scheduled By		Connaughts Site Investigation Ltd																	
SCHEDULE OF LABORATORY TESTS																			
Schedule Remarks																			
Bore Hole No.	Type	Sample Ref.	Top Depth	<div style="display: flex; justify-content: space-between;"> <div style="writing-mode: vertical-rl; transform: rotate(180deg);">Sulphate Content / pH Value</div> <div style="writing-mode: vertical-rl; transform: rotate(180deg);">Water Content (BS EN)</div> <div style="writing-mode: vertical-rl; transform: rotate(180deg);">Liquid Plastic Limits</div> <div style="writing-mode: vertical-rl; transform: rotate(180deg);">Triaxial Test</div> <div style="writing-mode: vertical-rl; transform: rotate(180deg);">One Dimensional Consolidation</div> </div>												Sample Remarks			
				1	2	3	4	5	6	7	8	9	10	11	12		13	14	15
TP4	D	-	1.00	1															
TP6	D	-	1.50	1															
WS1	L	1	1.00		1														
WS1	L	2	1.50		1														
WS1	L	2	2.00			1													
WS1	L	3	2.50	1	1														
WS1	L	3	3.00		1	1													
WS1	L	4	3.50				1	1											
WS1	L	4	4.00		1	1													
WS1	L	5	4.50	1	1														
Totals				4	6	3	1	1											
End of Schedule																			



TEST REPORT

ISSUED BY SOIL PROPERTY TESTING LTD
DATE ISSUED: 02/08/2019



0998

Contract	10 Glenmore Road, London, NW3 4DB
Serial No.	35570

SUMMARY OF WATER CONTENT, LIQUID LIMIT, PLASTIC LIMIT, PLASTICITY INDEX AND LIQUIDITY INDEX

Borehole /Pit No.	Depth (m)	Type	Ref.	Water Content (%)	Liquid Limit (%)	Plastic Limit (%)	Plasticity Index (%)	Liquid-ity Index (%)	SAMPLE PREPARATION				Description	CLASS
									Method	Ret'd 0.425mm (%)	Corr'd W/C <0.425mm	Curing Time (hrs)		
WS1	2.00	L	2	36.5	85	26	59	0.18	From Natural	0 (A)		26	Firm olive grey slightly organic CLAY with occasional dark grey mottling, and rare recently active and decayed roots.	CVO
WS1	3.00	L	3	33.5	83	25	58	0.15	From Natural	0 (A)		26	Firm closely fissured yellowish brown CLAY with rare bluish grey veins, and decayed roots.	CV
WS1	4.00	L	4	30.1	84	26	58	0.07	From Natural	0 (A)		26	Stiff fissured orangish brown CLAY with occasional brown mottling, and selenite crystals.	CV

Method Of Preparation: BS EN ISO: 17892-1: 2014 & BS 1377: Part 2:1990:4.2
 Method of Test: BS EN ISO: 17892-1: 2014 & BS 1377: Part 2:1990:3.2, 4.4, 5.3, 5.4
 Type of Sample Key: U = Undisturbed, B = Bulk, D = Disturbed, J = Jar, W = Water, SPT = Split Spoon Sample, C = Core Cutter
 Comments:
 Remarks to Include: Sample disturbance, loss of water, variation from test procedure, location and origin of test specimen within original sample, oven drying temperature if not 105-110C



TEST REPORT

ISSUED BY SOIL PROPERTY TESTING LTD
DATE ISSUED: 02/08/2019




0998

Contract	10 Glenmore Road, London, NW3 4DB
Serial No.	35570

PLOT OF PLASTICITY INDEX AGAINST LIQUID LIMIT USING CASAGRANDE CLASSIFICATION CHART

Plasticity				
Low	Medium	High	Very High	Extremely High

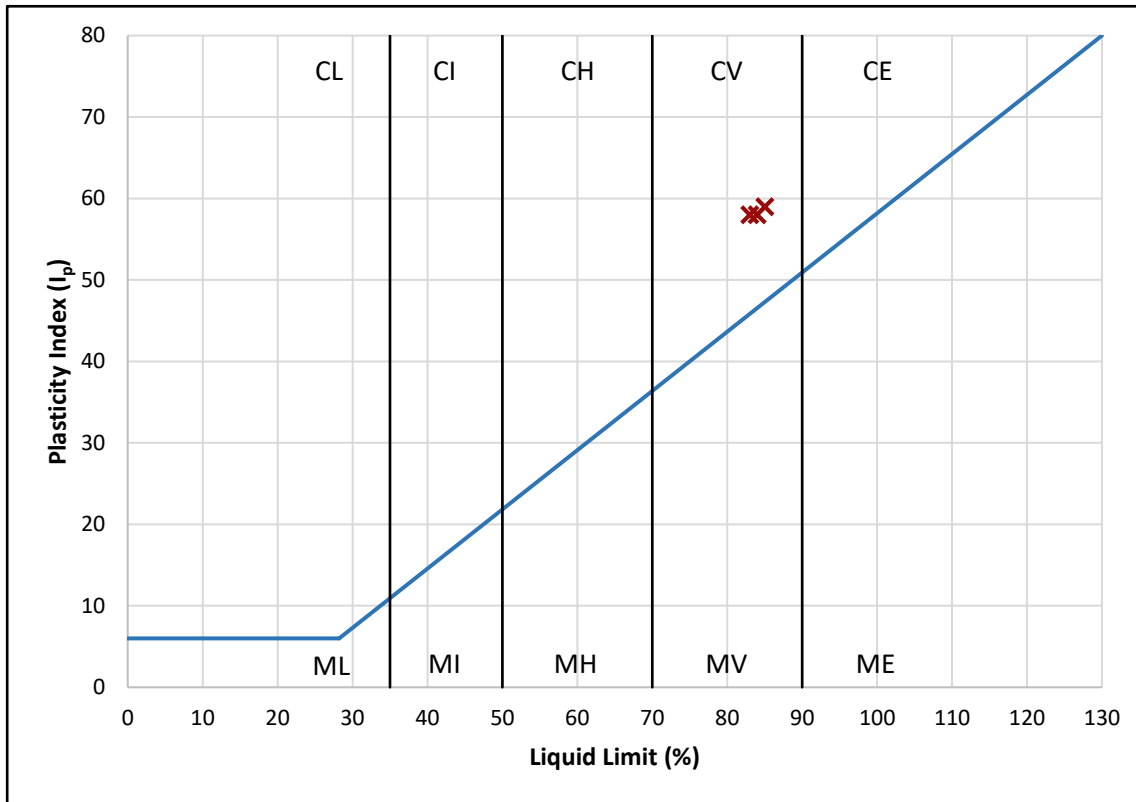

Plasticity Chart BS5930: 2015: Figure 8

High	NHBC Volume Change Potential
Medium	
Low	

Method of Preparation:	BS EN ISO: 17892-1: 2014 & BS 1377: Part 2: 1990: 4.2
Method of Test:	BS EN ISO: 17892-1: 2014 & BS1377: Part 2: 3.2, 4.4, 5.3, 5.4
Type of Sample Key:	U = Undisturbed, B = Bulk, D = Disturbed, J = Jar, W = Water, SPT = Split Spoon Sample, C = Core Cutter
Comments:	Volume Change Potential: NHBC Standards Chapter 4.2 Unmodified Plasticity Index



TEST REPORT

ISSUED BY SOIL PROPERTY TESTING LTD
DATE ISSUED: 02/08/2019




0998

Contract	10 Glenmore Road, London, NW3 4DB
Serial No.	35570

DETERMINATION OF WATER CONTENT, LIQUID LIMIT AND PLASTIC LIMIT AND DERIVATION OF PLASTICITY INDEX AND LIQUIDITY INDEX

Borehole / Pit No.	Depth m	Sample		Water Content (W) %	Description	Remarks
		Type	Reference			
WS1	2.00	L	2	36.5	Firm olive grey slightly organic CLAY with occasional dark grey mottling, and rare recently active and decayed roots.	

PREPARATION			Liquid Limit	85 %	
Method of preparation		From natural	Plastic Limit	26 %	
Sample retained 0.425mm sieve	(Assumed)	0 %	Plasticity Index	59 %	
Corrected water content for material passing 0.425mm			Liquidity Index	0.18	
Sample retained 2mm sieve	(Assumed)	0 %	NHBC Modified (I'p)	n/a	
Curing time	26 hrs	Clay Content	Not analysed	Derived Activity	Not analysed

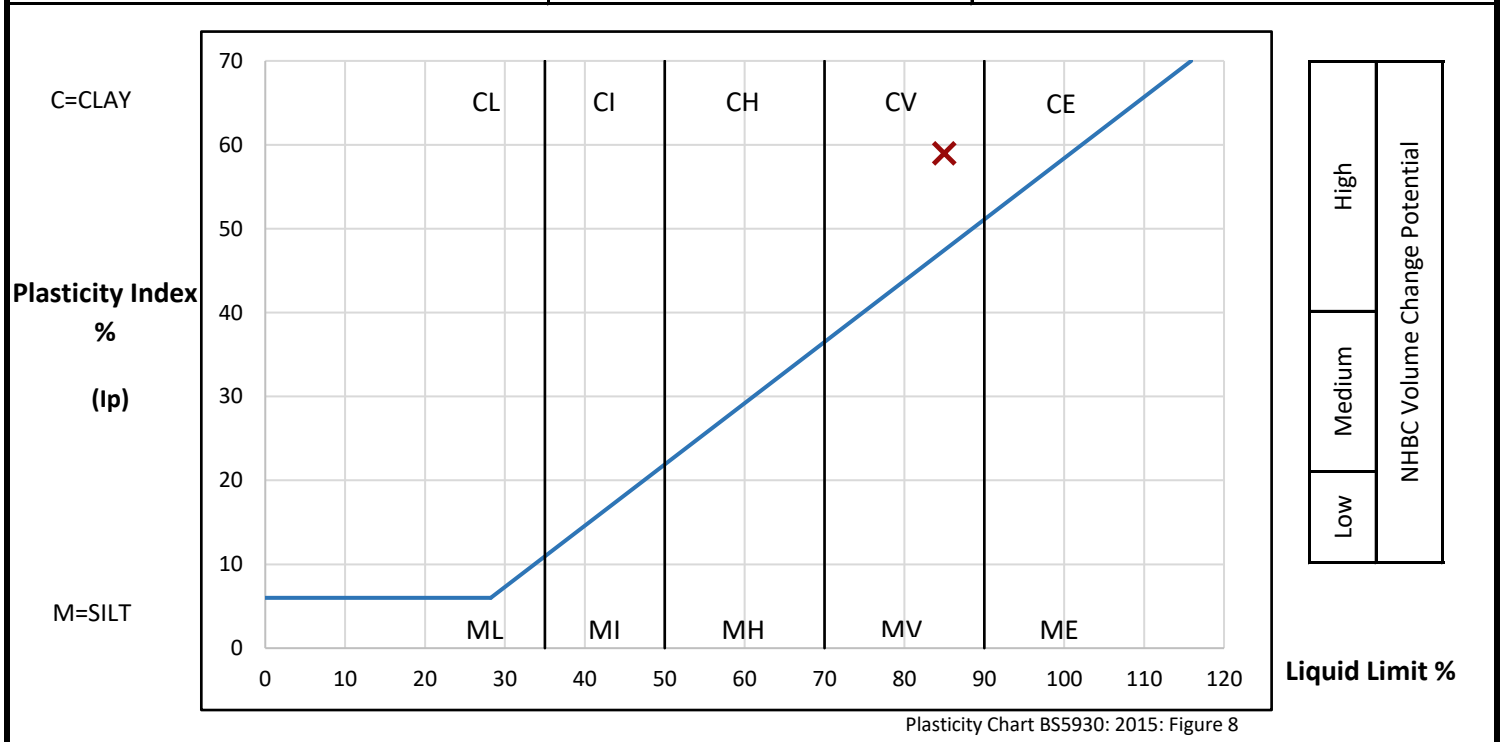

Method of Preparation: BS EN ISO: 17892-1: 2014 & BS 1377: Part 2: 1990: 4.2
 Method of Test: BS EN ISO: 17892-1: 2014 & BS 1377: Part 2: 1990: 3.2, 4.4, 5.3, 5.4
 Type of Sample Key: U=Undisturbed, B=Bulk, D=Disturbed, J=Jar, W=Water, SPT=Split Spoon Sample, C=Core Cutter
 Comments:



TEST REPORT

ISSUED BY SOIL PROPERTY TESTING LTD
DATE ISSUED: 02/08/2019




0998

Contract	10 Glenmore Road, London, NW3 4DB
Serial No.	35570

DETERMINATION OF WATER CONTENT, LIQUID LIMIT AND PLASTIC LIMIT AND DERIVATION OF PLASTICITY INDEX AND LIQUIDITY INDEX

Borehole / Pit No.	Depth m	Sample		Water Content (W) %	Description	Remarks
		Type	Reference			
WS1	3.00	L	3	33.5	Firm closely fissured yellowish brown CLAY with rare bluish grey veins, and decayed roots.	

PREPARATION			Liquid Limit	83 %	
Method of preparation		From natural	Plastic Limit	25 %	
Sample retained 0.425mm sieve	(Assumed)	0 %	Plasticity Index	58 %	
Corrected water content for material passing 0.425mm			Liquidity Index	0.15	
Sample retained 2mm sieve	(Assumed)	0 %	NHBC Modified (I'p)	n/a	
Curing time	26 hrs	Clay Content	Not analysed	Derived Activity	Not analysed

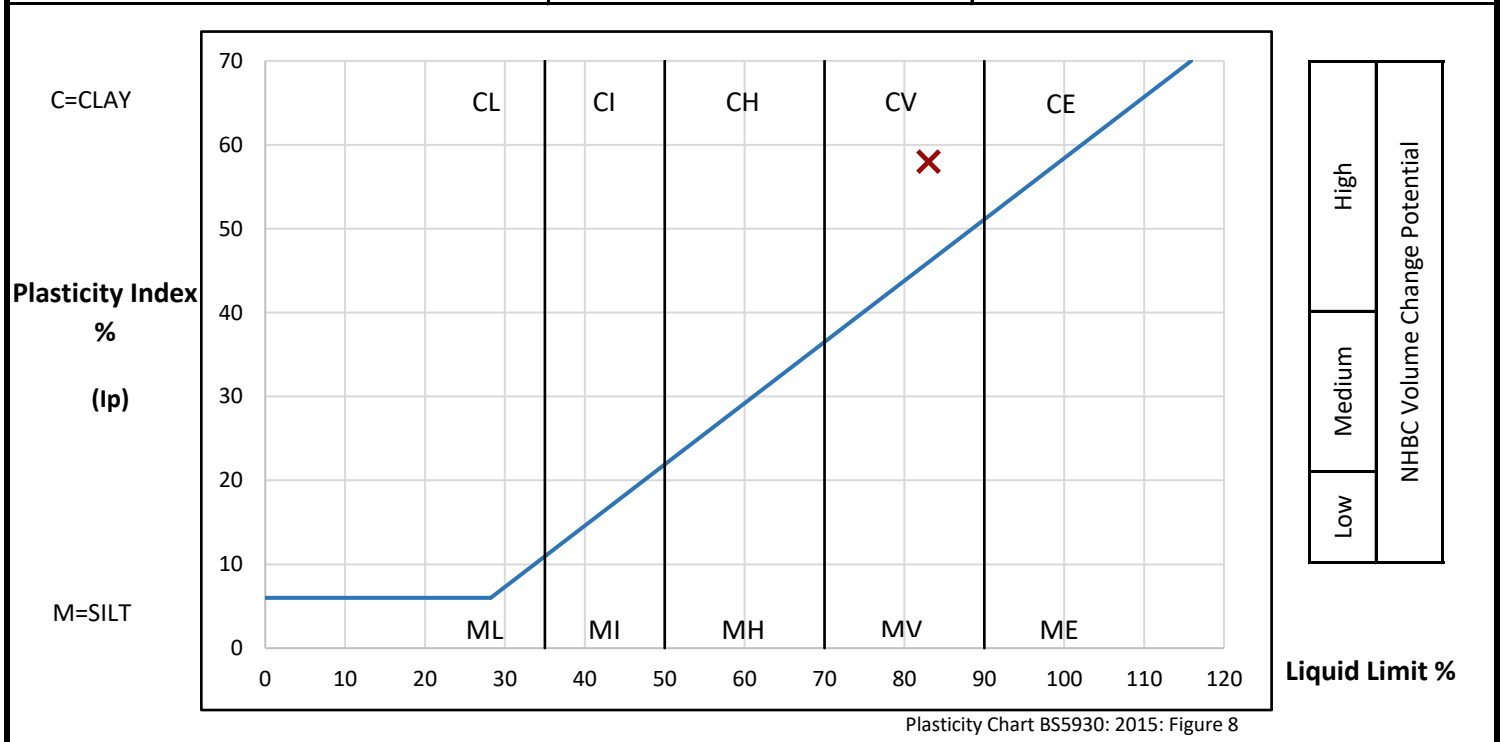

Method of Preparation: BS EN ISO: 17892-1: 2014 & BS 1377: Part 2: 1990: 4.2
 Method of Test: BS EN ISO: 17892-1: 2014 & BS 1377: Part 2: 1990: 3.2, 4.4, 5.3, 5.4
 Type of Sample Key: U=Undisturbed, B=Bulk, D=Disturbed, J=Jar, W=Water, SPT=Split Spoon Sample, C=Core Cutter
 Comments:



TEST REPORT

ISSUED BY SOIL PROPERTY TESTING LTD
DATE ISSUED: 02/08/2019




0998

Contract	10 Glenmore Road, London, NW3 4DB
Serial No.	35570

DETERMINATION OF WATER CONTENT, LIQUID LIMIT AND PLASTIC LIMIT AND DERIVATION OF PLASTICITY INDEX AND LIQUIDITY INDEX

Borehole / Pit No.	Depth m	Sample		Water Content (W) %	Description	Remarks
		Type	Reference			
WS1	4.00	L	4	30.1	Stiff fissured orangish brown CLAY with occasional brown mottling, and selenite crystals.	Specimen dried at 80°C due to the presence of selenite.

PREPARATION			Liquid Limit	84 %	
Method of preparation			From natural	Plastic Limit	26 %
Sample retained 0.425mm sieve	(Assumed)	0 %	Plasticity Index	58 %	
Corrected water content for material passing 0.425mm			Liquidity Index	0.07	
Sample retained 2mm sieve	(Assumed)	0 %	NHBC Modified (I'p)	n/a	
Curing time	26 hrs	Clay Content	Not analysed	Derived Activity	Not analysed

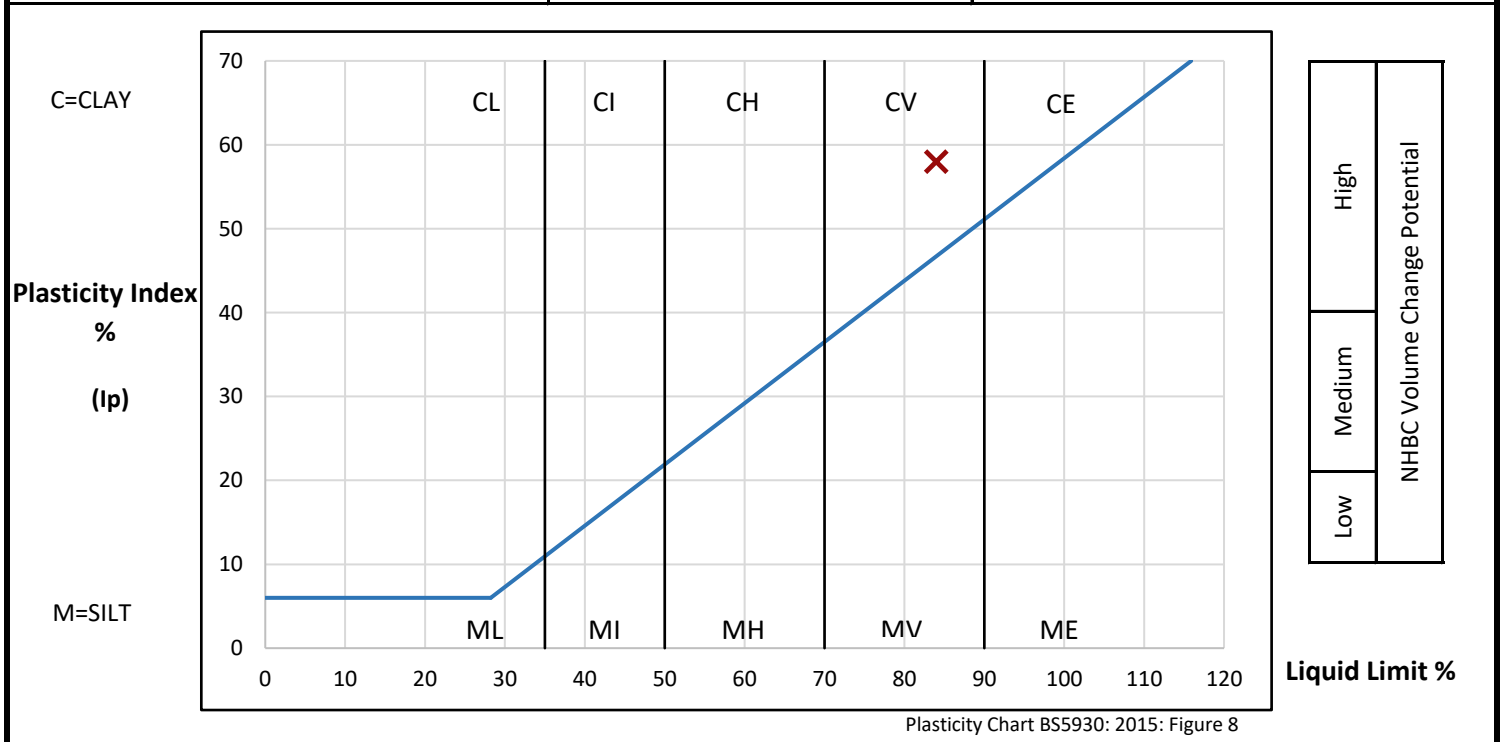

Method of Preparation: BS EN ISO: 17892-1: 2014 & BS 1377: Part 2: 1990: 4.2
 Method of Test: BS EN ISO: 17892-1: 2014 & BS 1377: Part 2: 1990: 3.2, 4.4, 5.3, 5.4
 Type of Sample Key: U=Undisturbed, B=Bulk, D=Disturbed, J=Jar, W=Water, SPT=Split Spoon Sample, C=Core Cutter
 Comments:



TEST REPORT

ISSUED BY SOIL PROPERTY TESTING LTD
DATE ISSUED: 02/08/2019




0998


Contract	10 Glenmore Road, London, NW3 4DB
Serial No.	35570


DETERMINATION OF UNDRAINED SHEAR STRENGTH IN TRIAXIAL COMPRESSION WITHOUT MEASUREMENT OF PORE PRESSURE

Borehole /Pit No.	Depth (m)	Type	Reference	Description	Remarks
WS1	3.50	L	4	Stiff (high strength) fissured orangish brown CLAY with occasional brown mottling, and selenite crystals.	Specimen oven dried at 80°C due to the presence of selenite.

Initial Specimen	Height (mm)	Diameter (mm)	Weight (g)	Water Content (%)	Bulk Density (Mg/m ³)	Dry Density (Mg/m ³)
 Depth of Top of Specimen (m) 3.54	121.0	62.7	730	32.2	1.96	1.48

TEST INFORMATION	Rate of Strain	1.1	% per Min	Rubber Membrane Thickness	0.3	mm
------------------	----------------	------------	-----------	---------------------------	------------	----

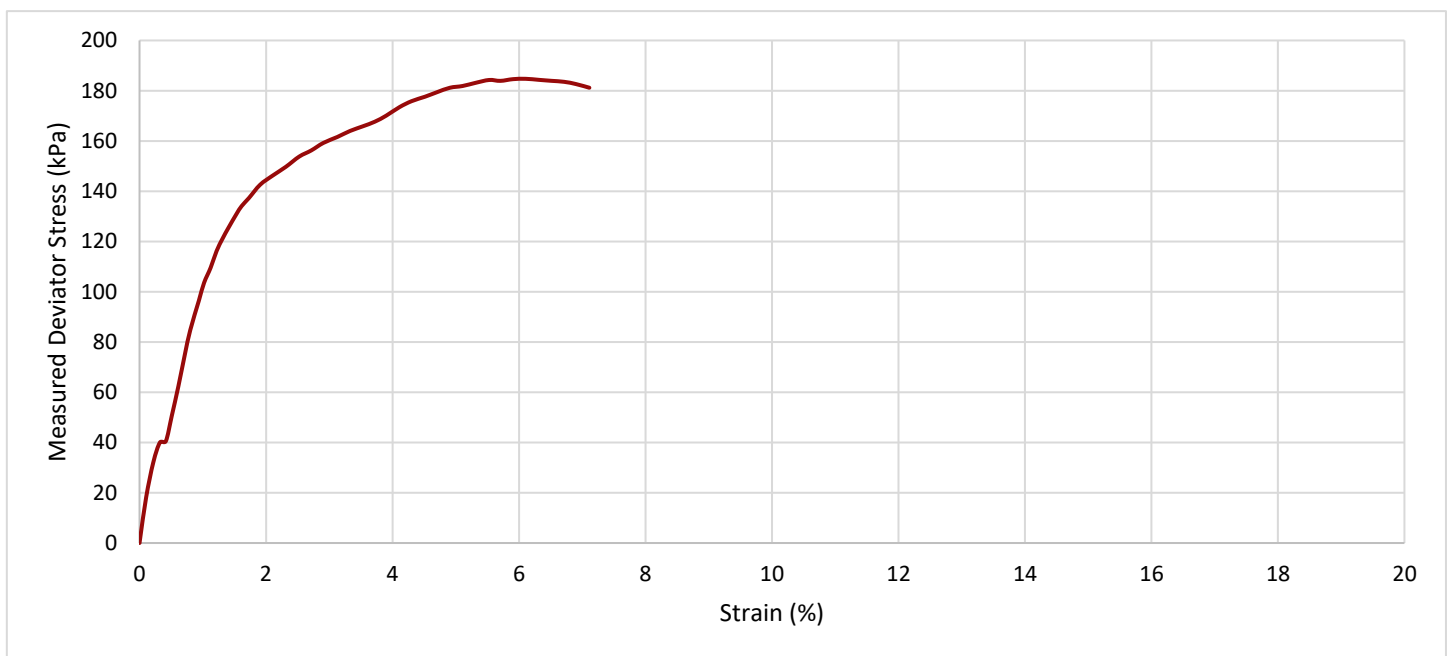

Specimen at failure	Measured Cell Pressure, σ_3 (kPa)	Strain at Failure (%)	Stress Corrections (kPa)		Corrected Max. Deviator Stress, $(\sigma_1 - \sigma_3)_f$ (kPa)	Shear Stress C_u , $\frac{1}{2}(\sigma_1 - \sigma_3)_f$ (kPa)	Mohr's Circle Analysis	
			Rubber Membrane	Piston Friction			C_u (kPa)	PHI (degrees)
	68	6.1	0.8	\	184	92		

Method of Preparation: BS 1377: Part 1: 1990
 Method of Test: BS 1377: Part 7: 1990: 8 Definitive Method, 1990: 9 Multi-stage loading
 Type of Sample Key: U = Undisturbed, B = Bulk, D = Disturbed, J = Jar, W = Water, SPT = Split Spoon Sample, C = Core Cutter
 Comments: Tested in Vertical Condition
 UKAS Calibration - loads from 0.2 to 10kN
 Remarks to Include: Sample disturbance, loss of moisture, variation from test procedure, location and origin of test specimen within original sample, oven drying temperature if not 105-110°C



TEST REPORT

ISSUED BY SOIL PROPERTY TESTING LTD
DATE ISSUED: 02/08/2019




0998

Contract	10 Glenmore Road, London, NW3 4DB
Serial No.	35570

DETERMINATION OF THE ONE-DIMENSIONAL CONSOLIDATION PROPERTIES

Borehole/ Pit No.	Depth (m)	Type	Ref.	Specimen Depth (m) and Orientation	Water Content (%)	Description					Remarks	
WS1	3.50	L	4	3.50 Horizontal	30.9	Stiff (high strength) fissured orangish brown CLAY with occasional brown mottling, and selenite crystals.					Specimen dried at 80°C due to the presence of selenite.	
Initial Conditions					Increment No.	Load (kN/m ²)	Change in Height (mm)	Void Ratio	Cv (m ² /yr)	Mv (m ² /MN)	Temp (°C)	Corrected Cv
Height	mm			17.52	1	80	0.070	0.902			22	
Diameter	mm			50.02	2	4	-0.266	0.939		0.25	22	
Wet Weight	g			66.51	3	80	-0.008	0.911	0.37	0.19	22	0.35
Water Content	%			30.9	4	200	0.363	0.870	0.34	0.18	22	0.32
Bulk Density	Mg/m ³			1.93	5	400	0.803	0.823	0.26	0.13	21	0.25
Particle Density			Assumed	2.82	6	800	1.325	0.766	0.24	0.08	21	0.23
Voids Ratio				0.910	7	80	0.620	0.842		0.06	21	
Degree of Saturation	%			96								
Swelling Pressure	kN/m ²			80								
Dry Density	Mg/m ³			1.48								

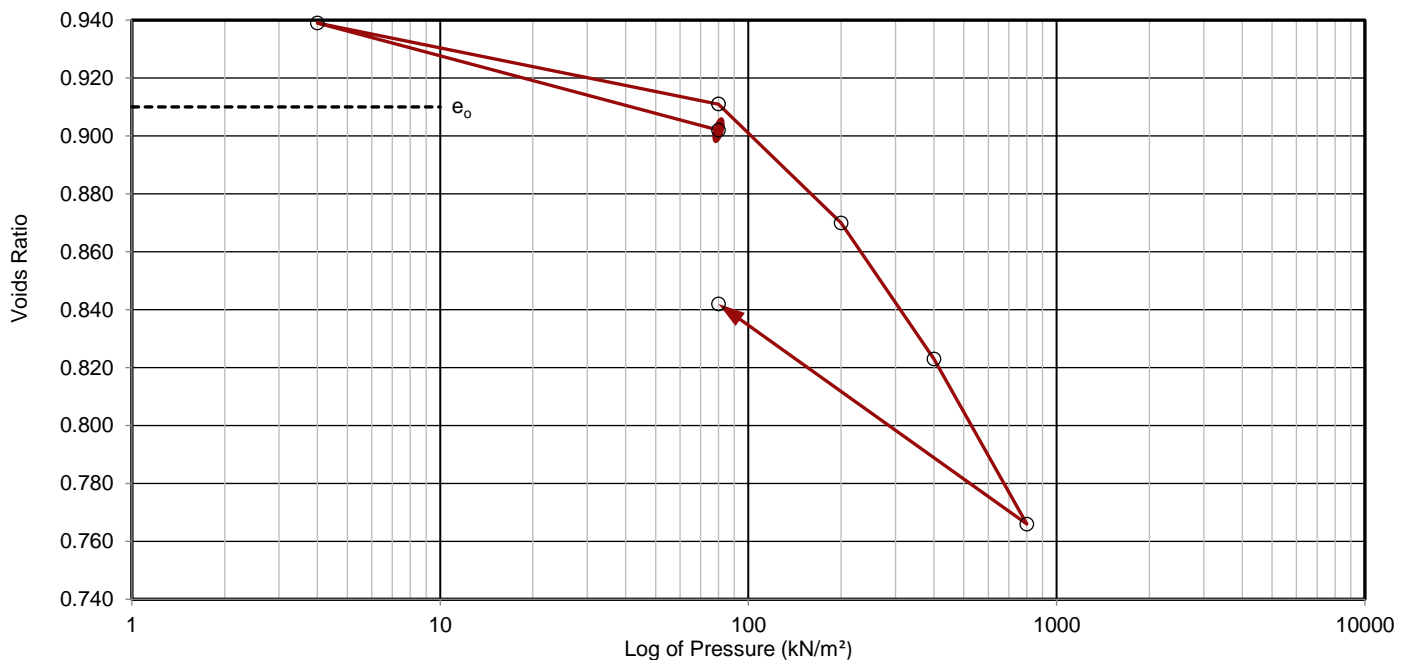

Method of Preparation:	BS 1377: Part 5: 1990: 3.3 & 3.4
Method of Test:	BS 1377: Part 5: 1990: 3.5
Method of Time Fitting Used:	Square root
Type of Sample Key:	U = Undisturbed, B = Bulk, D = Disturbed, J = Jar, W = Water, SPT = Split Spoon Sample, C = Core Cutter
Comments:	
Remarks to Include:	Sample disturbance, loss of water, variation from test procedure, location and origin of test specimen within original sample, oven drying temperature if not 105-110 °C.



TEST REPORT

ISSUED BY SOIL PROPERTY TESTING LTD
DATE ISSUED: 02/08/2019

Contract:	10 Glenmore Road, London, NW3 4DB
Serial No:	35570

DETERMINATION OF THE SULPHATE CONTENT AND pH OF SOIL AND GROUNDWATER

Borehole / Pit No.	Depth (m)	Sample		Conc. of Soluble SO ₃		Calc'd Conc. Of SO ₄ (g/L)	pH Value	% Sample Passing 2mm Sieve	Description	Remarks
		Type	Ref.	Water Soluble 2:1 (g/L)	Ground Water (g/L)					
TP4	1.00	D	-	0.34		0.41	7.7	100	Firm yellowish brown CLAY	
TP6	1.50	D	-	0.31		0.38	7.7	100	Firm yellowish brown CLAY	
WS1	2.50	L	3	0.18		0.22	8.1	100	Firm yellowish brown CLAY.	
WS1	4.50	L	5	2.37		2.84	7.5	100	Stiff yellowish brown CLAY with rare grey veins, decayed roots, and selenite crystals.	

Method of Preparation: BS1377: Part 1: 2016: 8.5, BS1377: Part 3: 1990: 5.3 Soil/Water Extract, 5.4 Groundwater
 Method of Test: BS1377: Part 3: 1990: 5.5
 Type of Sample Key: U= Undisturbed, B= Bulk, D= Disturbed, J= Jar, W= Water, SPT= Split Spoon Sample, C= Core Cutter
 Comments: **Test not UKAS accredited**
 Remarks to Include: Sample disturbance, loss of moisture, variation from test procedure, location, and origin of test specimen within original sample. Oven drying temperature if not 105-110C.