
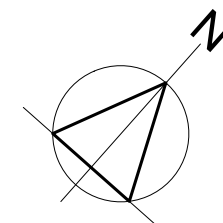



Copyright notice:

This and all other documents authored by VMA and all information and concepts both depicted and implied therein are the sole property of VMA. Reproduction or transmission in any form is strictly forbidden unless prior permission is obtained in writing from VMA. Construction based on the depicted information at any time or location not related to this project is strictly forbidden unless prior permission is obtained in writing from VMA.

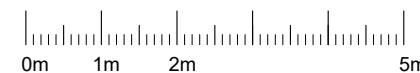


HMO UNIT
Gross internal area
135.57 m² or 516.34 sq ft


NOTE:
The scheme was approved
under planning application
ref. no. 2018/4784/P

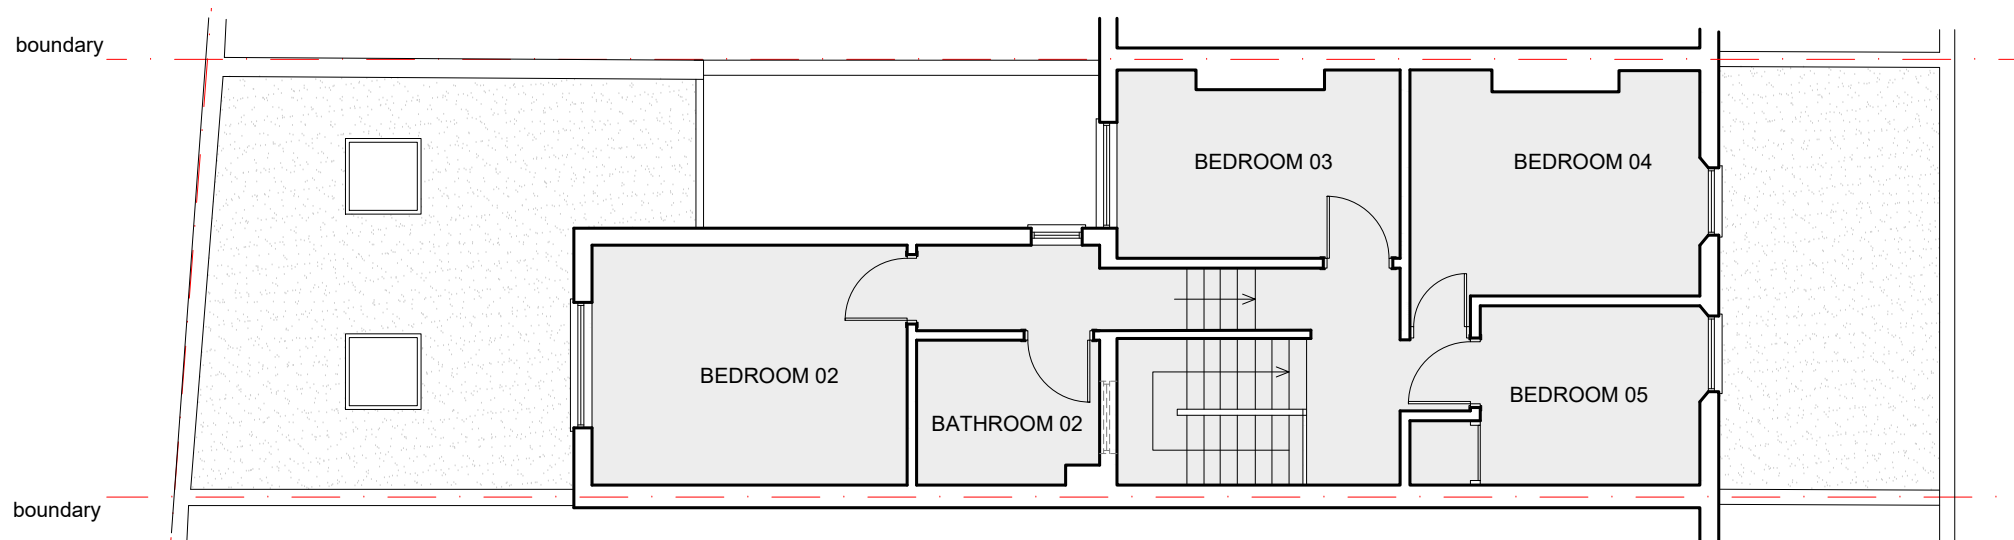

SECOND FLOOR PLAN

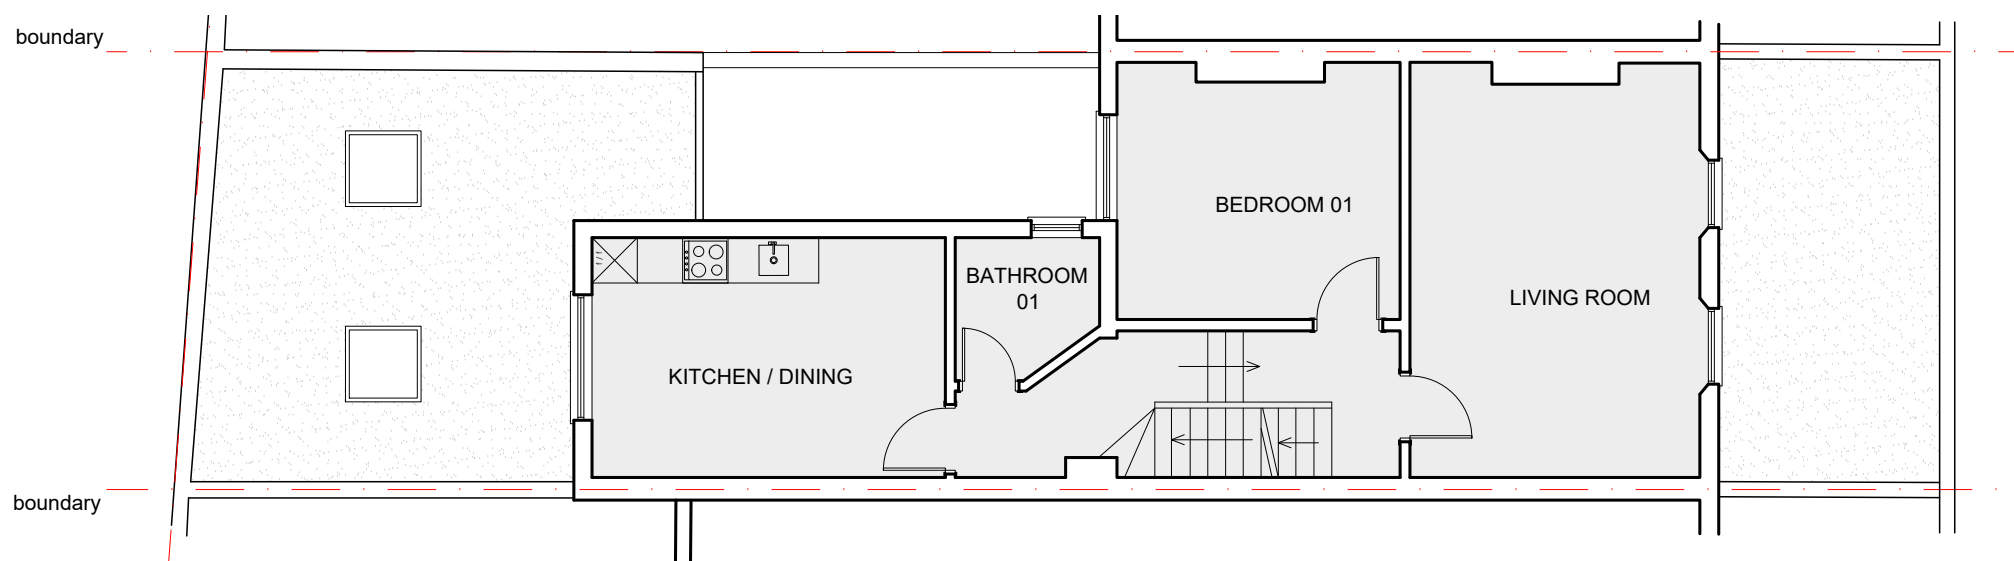

FIRST FLOOR PLAN

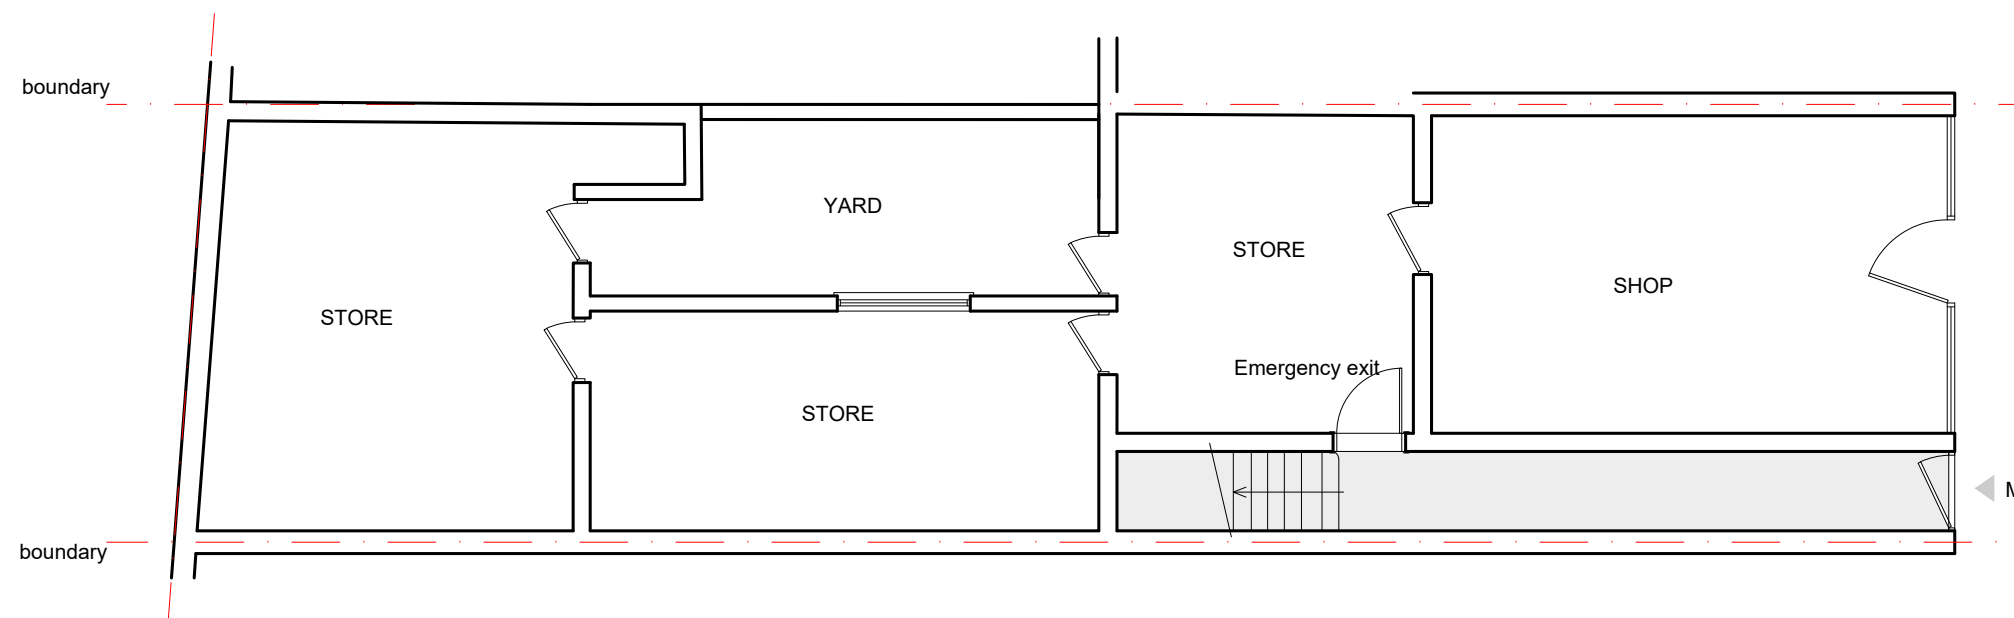

**GROUND FLOOR PLAN
AS APPROVED**

00 15.04.20 PLANNING

VMA Architects

203 Hamilton House DDI: 020 7943 2444
1 Temple Avenue DDI: 020 7489 2025
London EC4 Y 0HA office@vm-arch.com

Job title
5 BRECKNOCK ROAD
LONDON - N7 0BL



Drawing title
GROUND, 1ST & 2ND FLOOR PLANS
AS APPROVED

Scale	Date	Drawn	Checked
1:100@ A3	Mar 20	SB	VM

Drawing No.	Rev. No.
380 - 001	00


Copyright notice:

This and all other documents authored by VMA and all information and concepts both depicted and implied therein are the sole property of VMA. Reproduction or transmission in any form is strictly forbidden unless prior permission is obtained in writing from VMA. Construction based on the depicted information at any time or location not related to this project is strictly forbidden unless prior permission is obtained in writing from VMA.

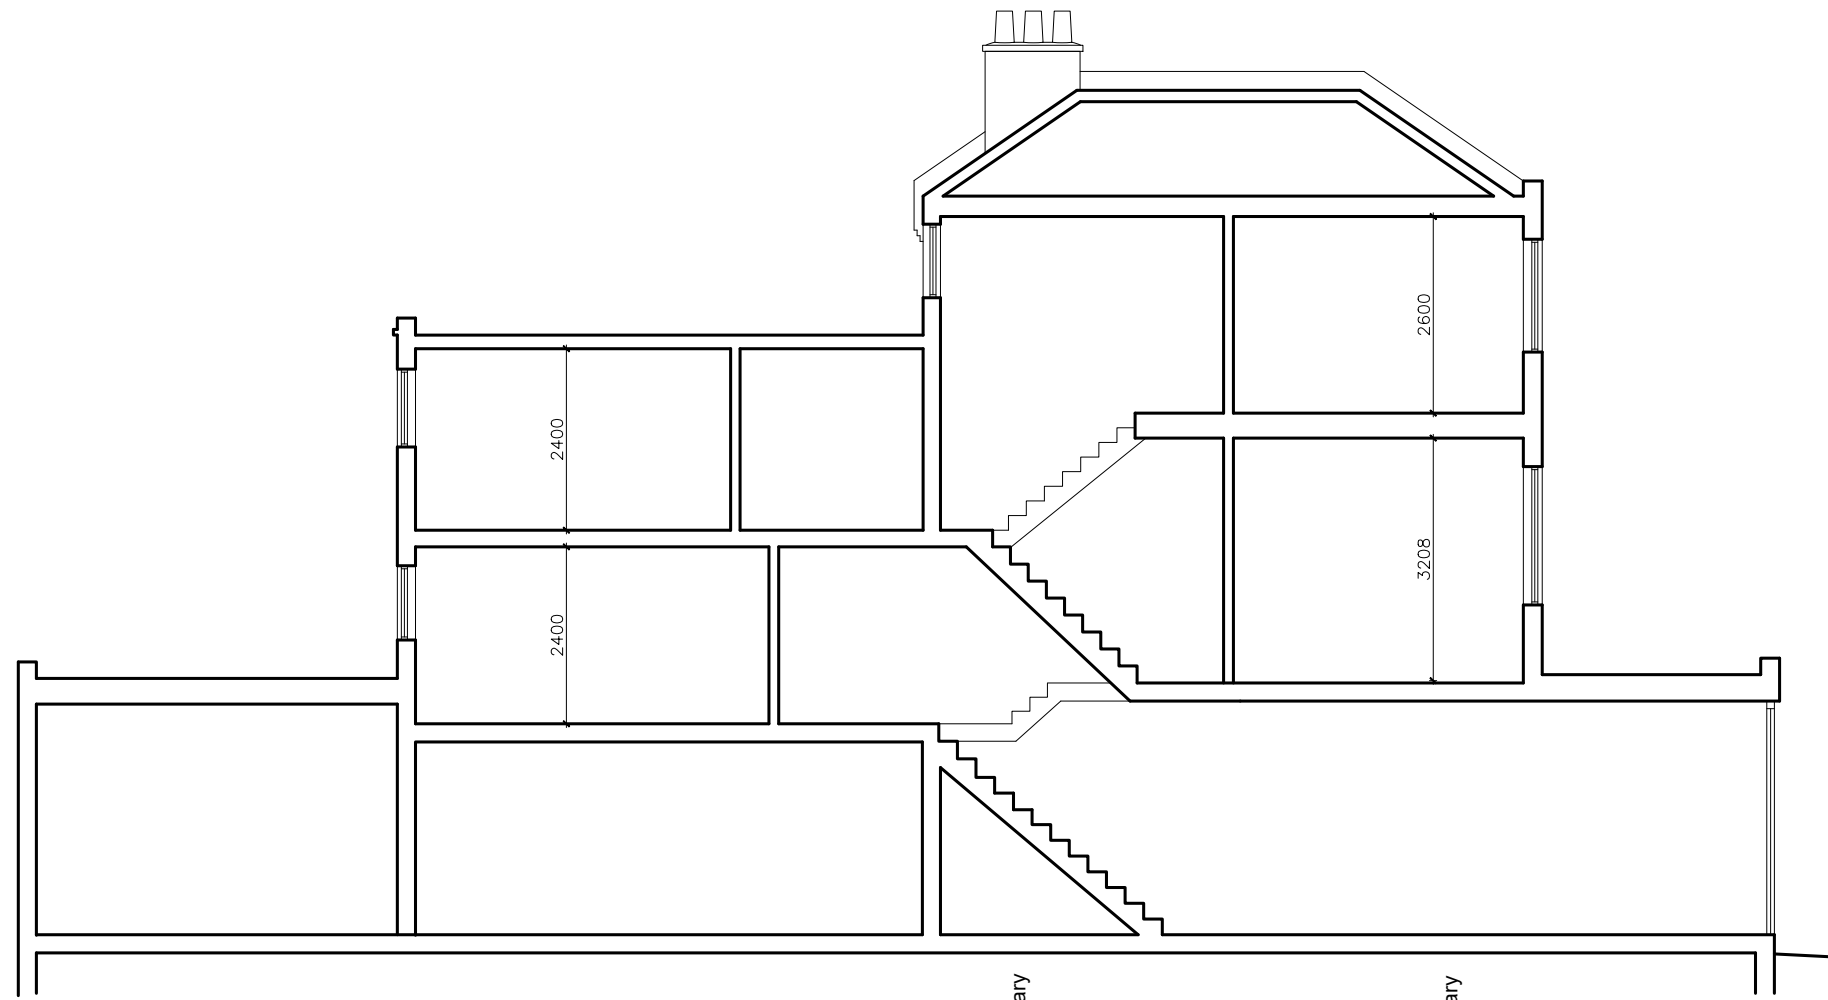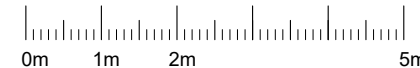

SECTION


NOTE:
The scheme was approved under planning application ref. no. 2018/4784/P

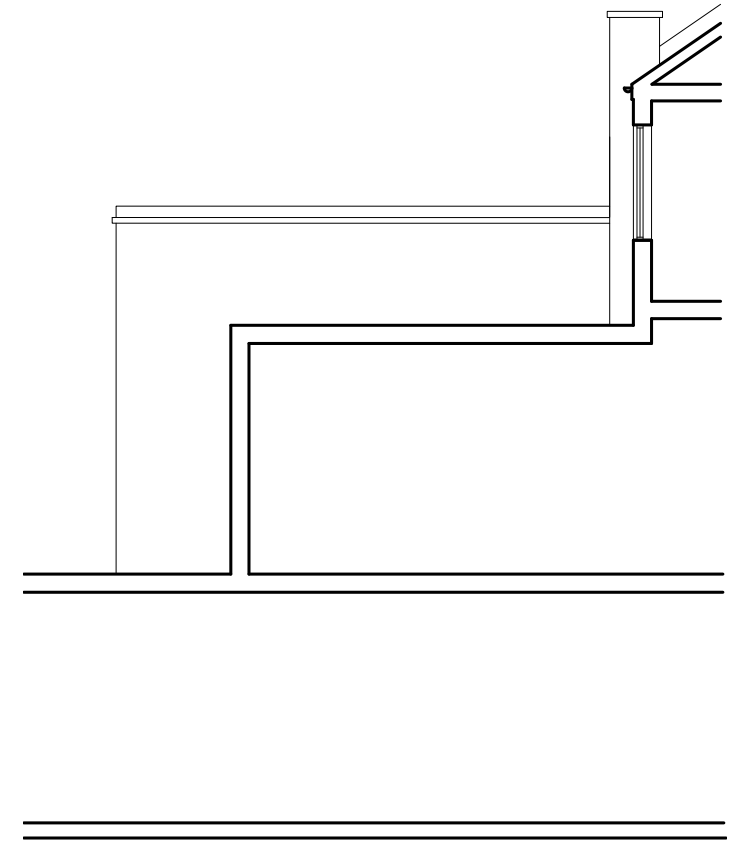

**SOUTH ELEVATION
AS APPROVED**



WEST ELEVATION

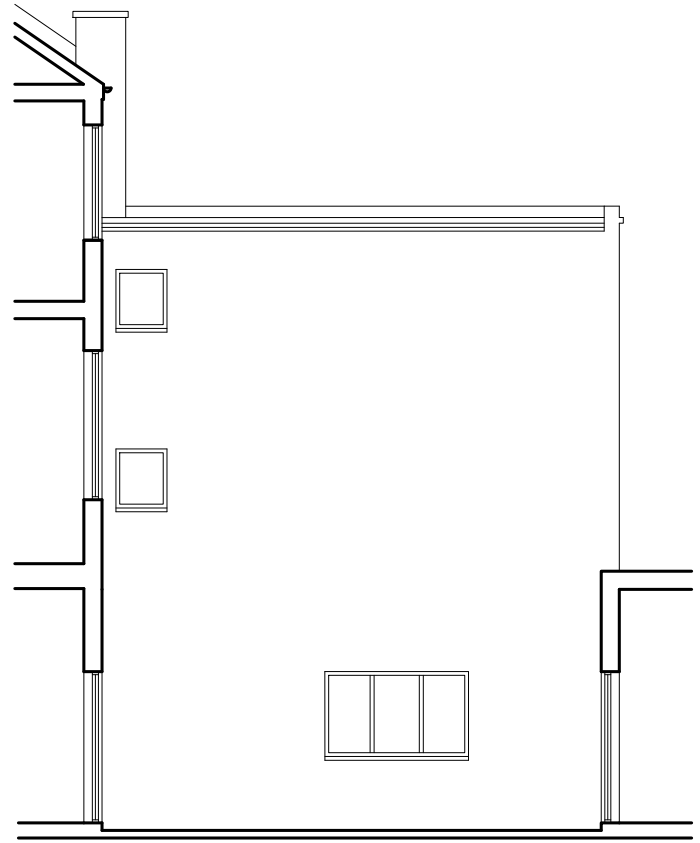

NORTH ELEVATION

00 15.04.20 PLANNING

VMA architects

203 Hamilton House DDI: 020 7943 2444
1 Temple Avenue DDI: 020 7489 2025
London EC4 Y 0HA office@vm-arch.com



Job title
5 BRECKNOCK ROAD
LONDON - N7 0BL

Drawing title
**SECTION AND ELEVATIONS
AS APPROVED**


Scale	Date	Drawn	Checked
1:100@ A3	Mar 20	SB	VM

Drawing No.	Rev. No.
380 - 010	00


Copyright notice:
 This and all other documents authored by VMA and all information and concepts both depicted and implied therein are the sole property of VMA. Reproduction or transmission in any form is strictly forbidden unless prior permission is obtained in writing from VMA. Construction based on the depicted information at any time or location not related to this project is strictly forbidden unless prior permission is obtained in writing from VMA.

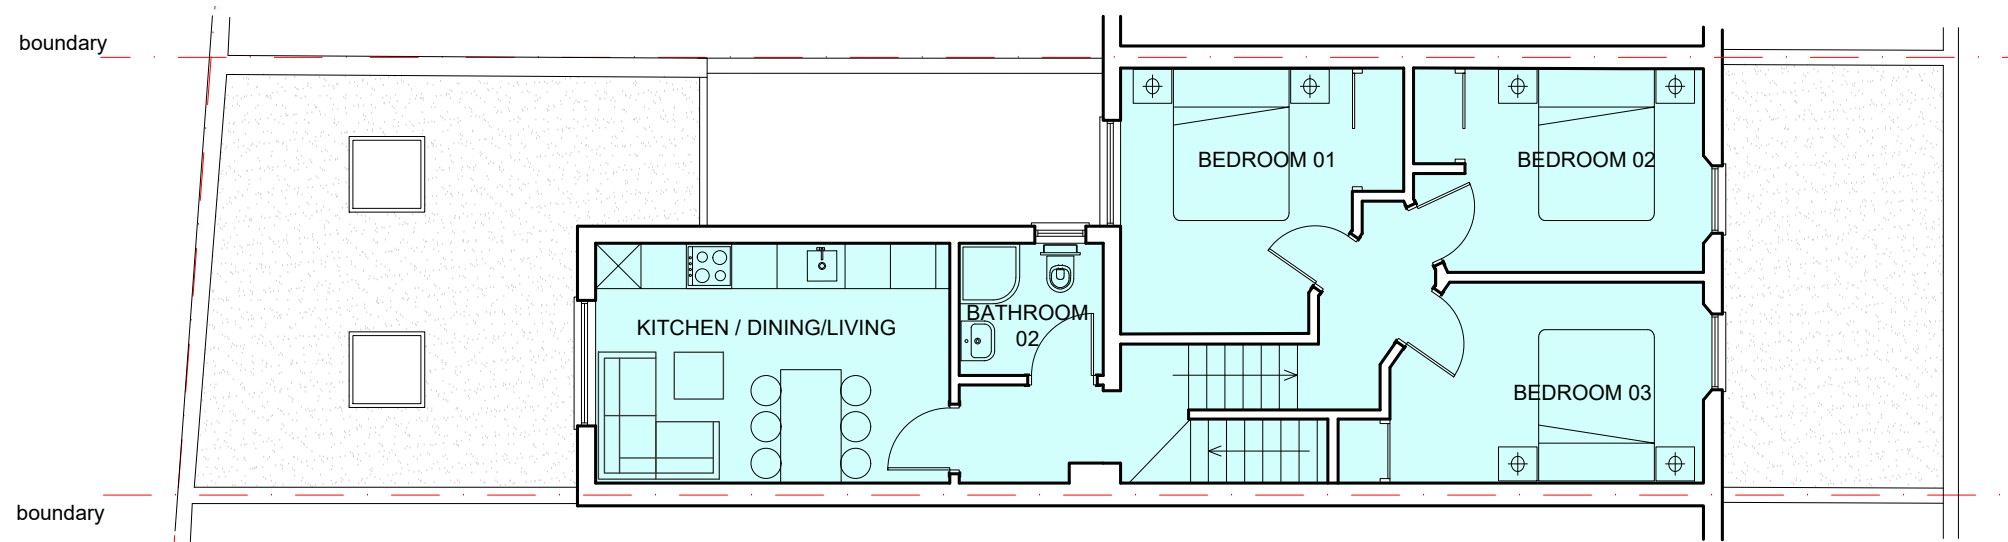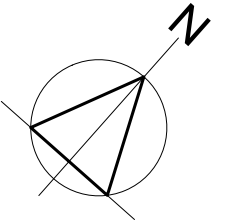

SECOND FLOOR PLAN

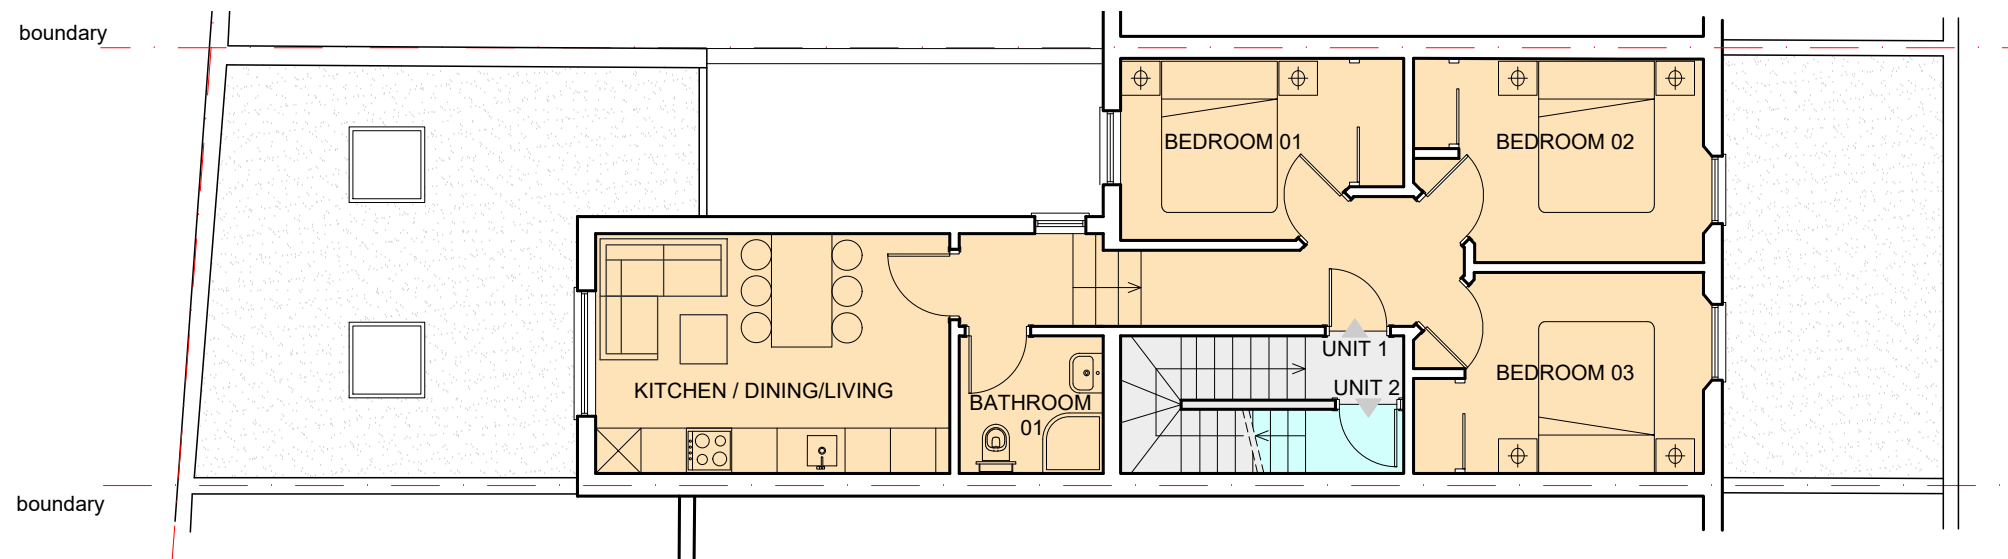

FIRST FLOOR PLAN

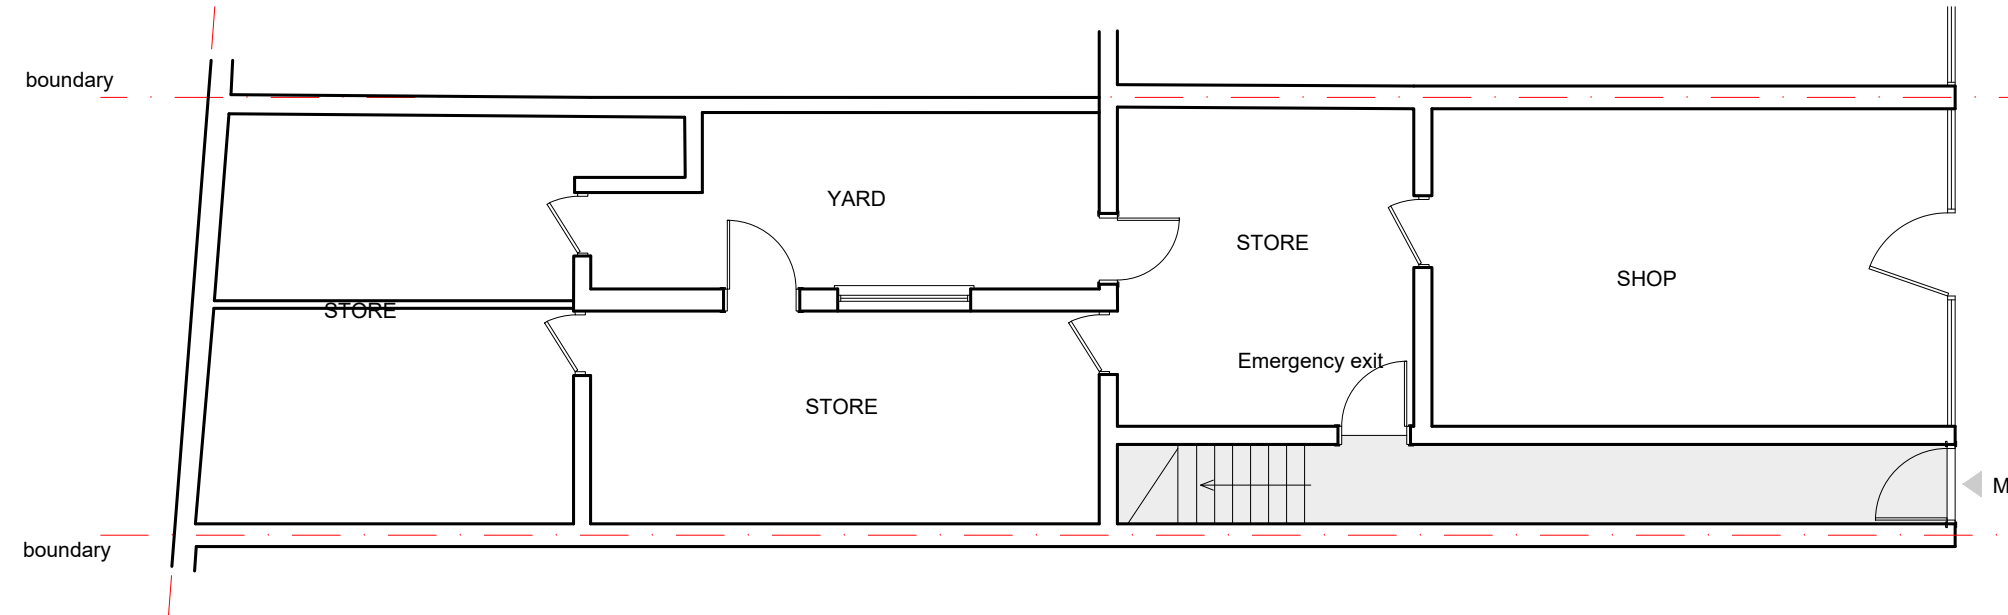

GROUND FLOOR PLAN AS BUILT

- HMO UNIT 2**
Gross internal area
64.69 m²
- HMO UNIT 1**
Gross internal area
56.29 m²
- COMMON AREA**
Gross internal area
14.59 m²

00 | 15.04.20 | PLANNING

VMArchitects

203 Hamilton House DDI: 020 7943 2444
 1 Temple Avenue DDI: 020 7489 2025
 London EC4 Y 0HA office@vm-arch.com

Job title
 5 BRECKNOCK ROAD
 LONDON - N7 0BL


Drawing title
GROUND, 1ST & 2ND FLOOR PLANS AS BUILT

Scale	Date	Drawn	Checked
1:100@ A3	Mar 20	SB	VM

Drawing No.	Rev. No.
380 - 101	00


Copyright notice:

This and all other documents authored by VMA and all information and concepts both depicted and implied therein are the sole property of VMA. Reproduction or transmission in any form is strictly forbidden unless prior permission is obtained in writing from VMA. Construction based on the depicted information at any time or location not related to this project is strictly forbidden unless prior permission is obtained in writing from VMA.

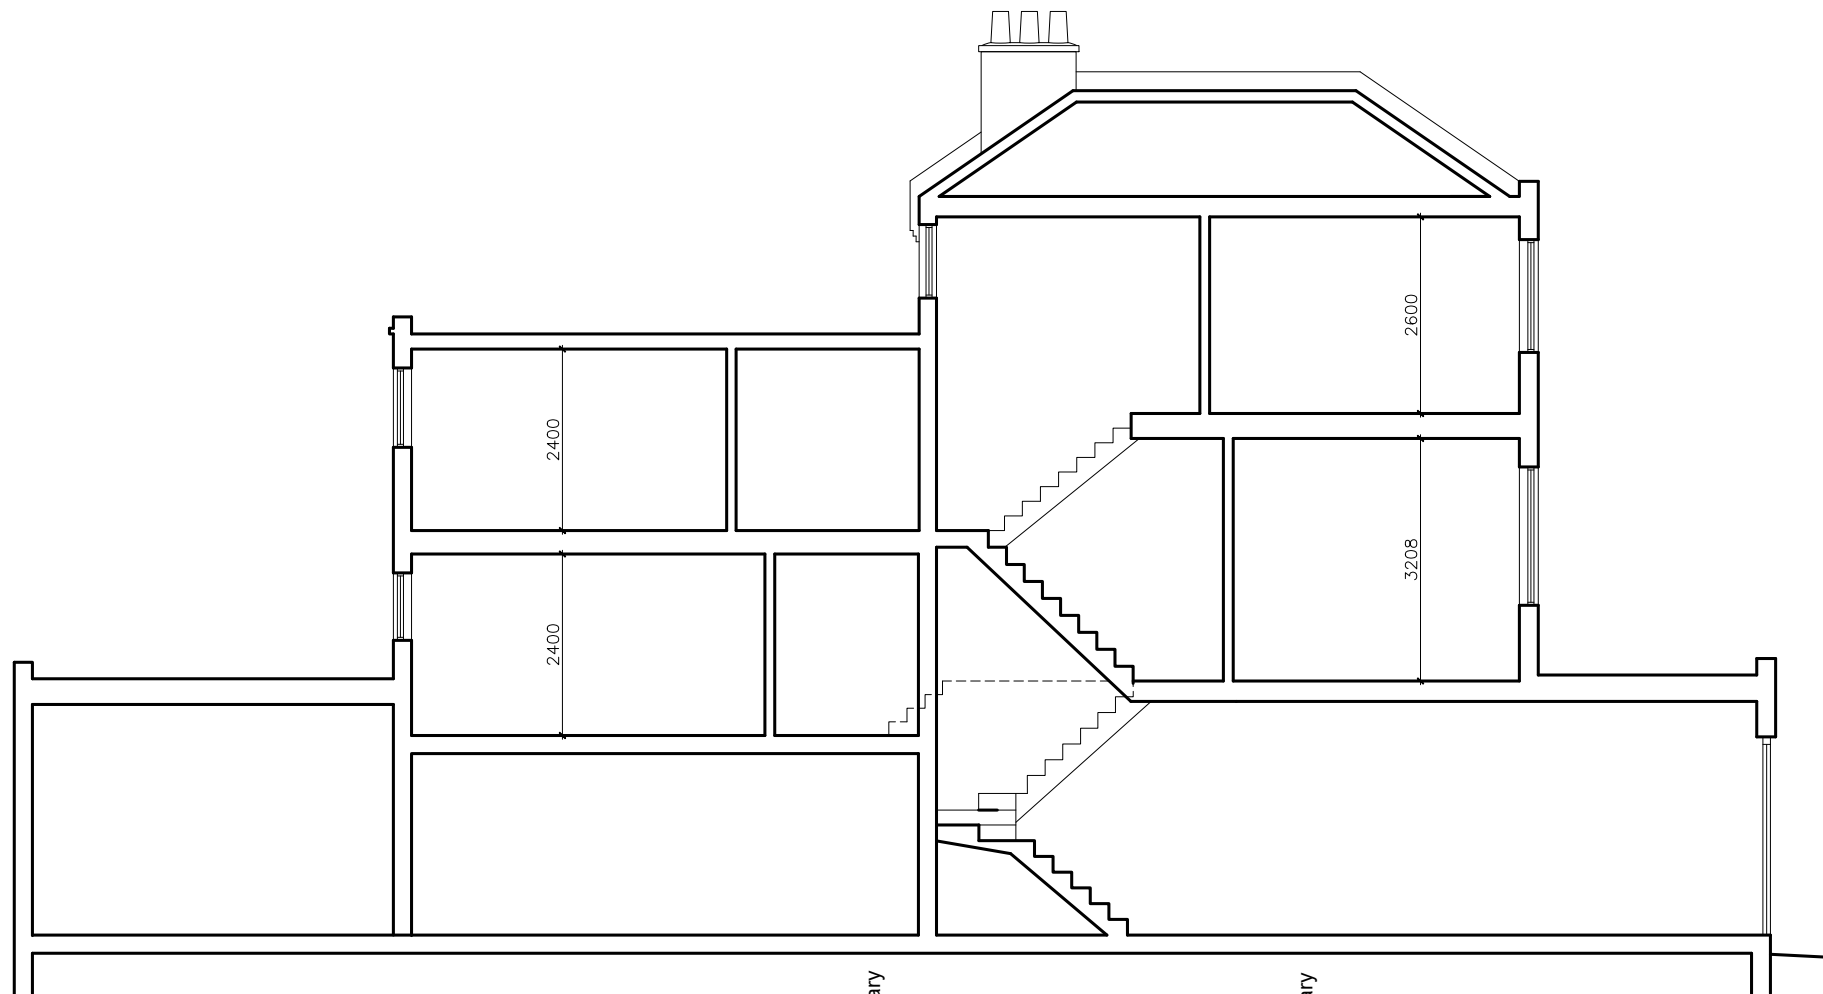

NOTE:
No changes to external envelope
from the approved scheme


SECTION

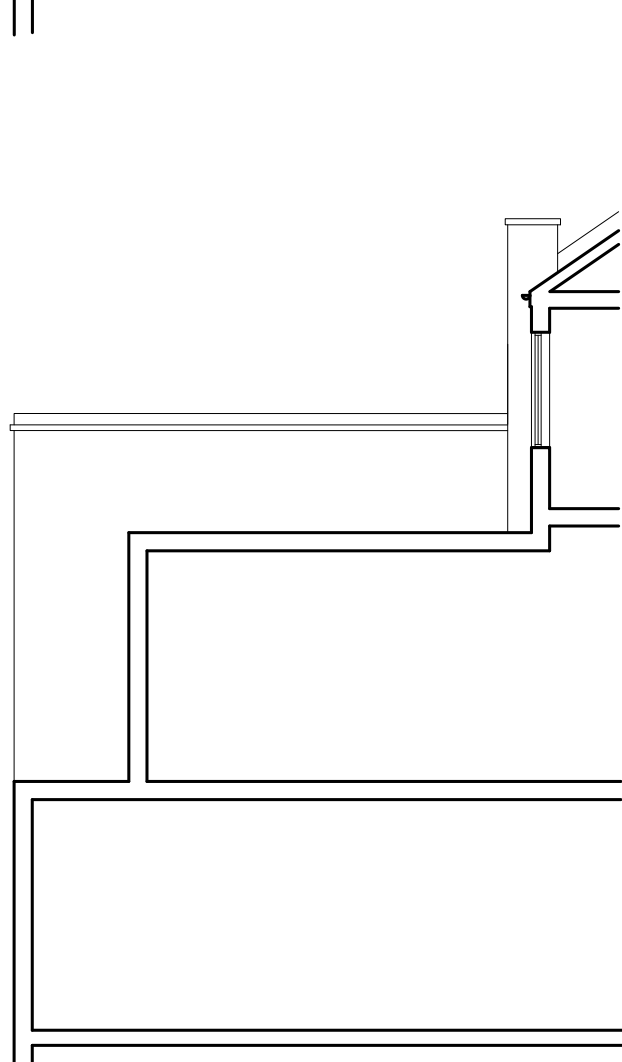

**SOUTH ELEVATION
AS BUILT**



WEST ELEVATION

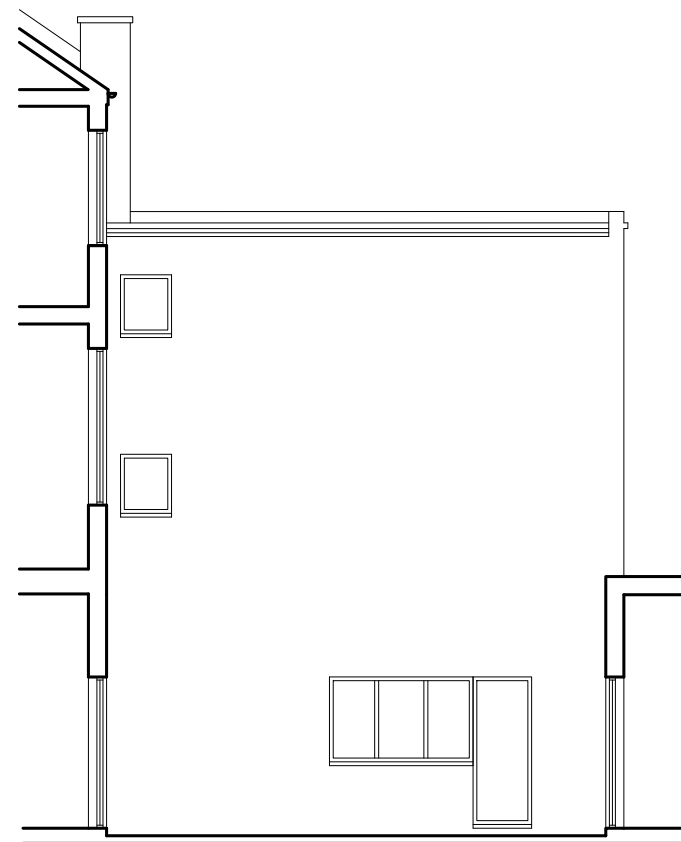

NORTH ELEVATION

00 15.04.20 PLANNING

VMArchitects

203 Hamilton House DDI: 020 7943 2444
1 Temple Avenue DDI: 020 7489 2025
London EC4 Y 0HA office@vm-arch.com

Job title
5 BRECKNOCK ROAD
LONDON - N7 0BL

Drawing title
**SECTION AND ELEVATIONS
AS BUILT**

Scale	Date	Drawn	Checked
1:100@ A3	Mar 20	SB	VM

Drawing No.	Rev. No.
380 - 110	00