


DETAIL A-A
(1:5)

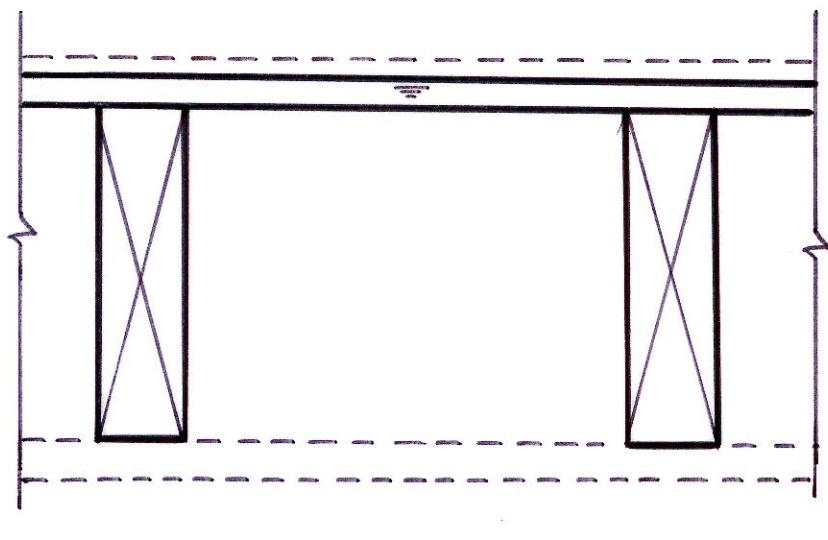


DETAIL B-B
(1:5)

JOISTS ARE ORIGINAL
IN THIS AREA
(220 x 60 mm)
SPANNING WALL TO
WALL WITH BLOCKING

EVIDENCE OF FIRE
DAMAGE OBSERVED
HERE.

FLOOR ARRANGEMENT ASSUMED
BASED ON RECORD DRAWINGS
OF PROPERTY 42, AND FLOOR DEPTH
SHOWN ON RECORD DRAWINGS.

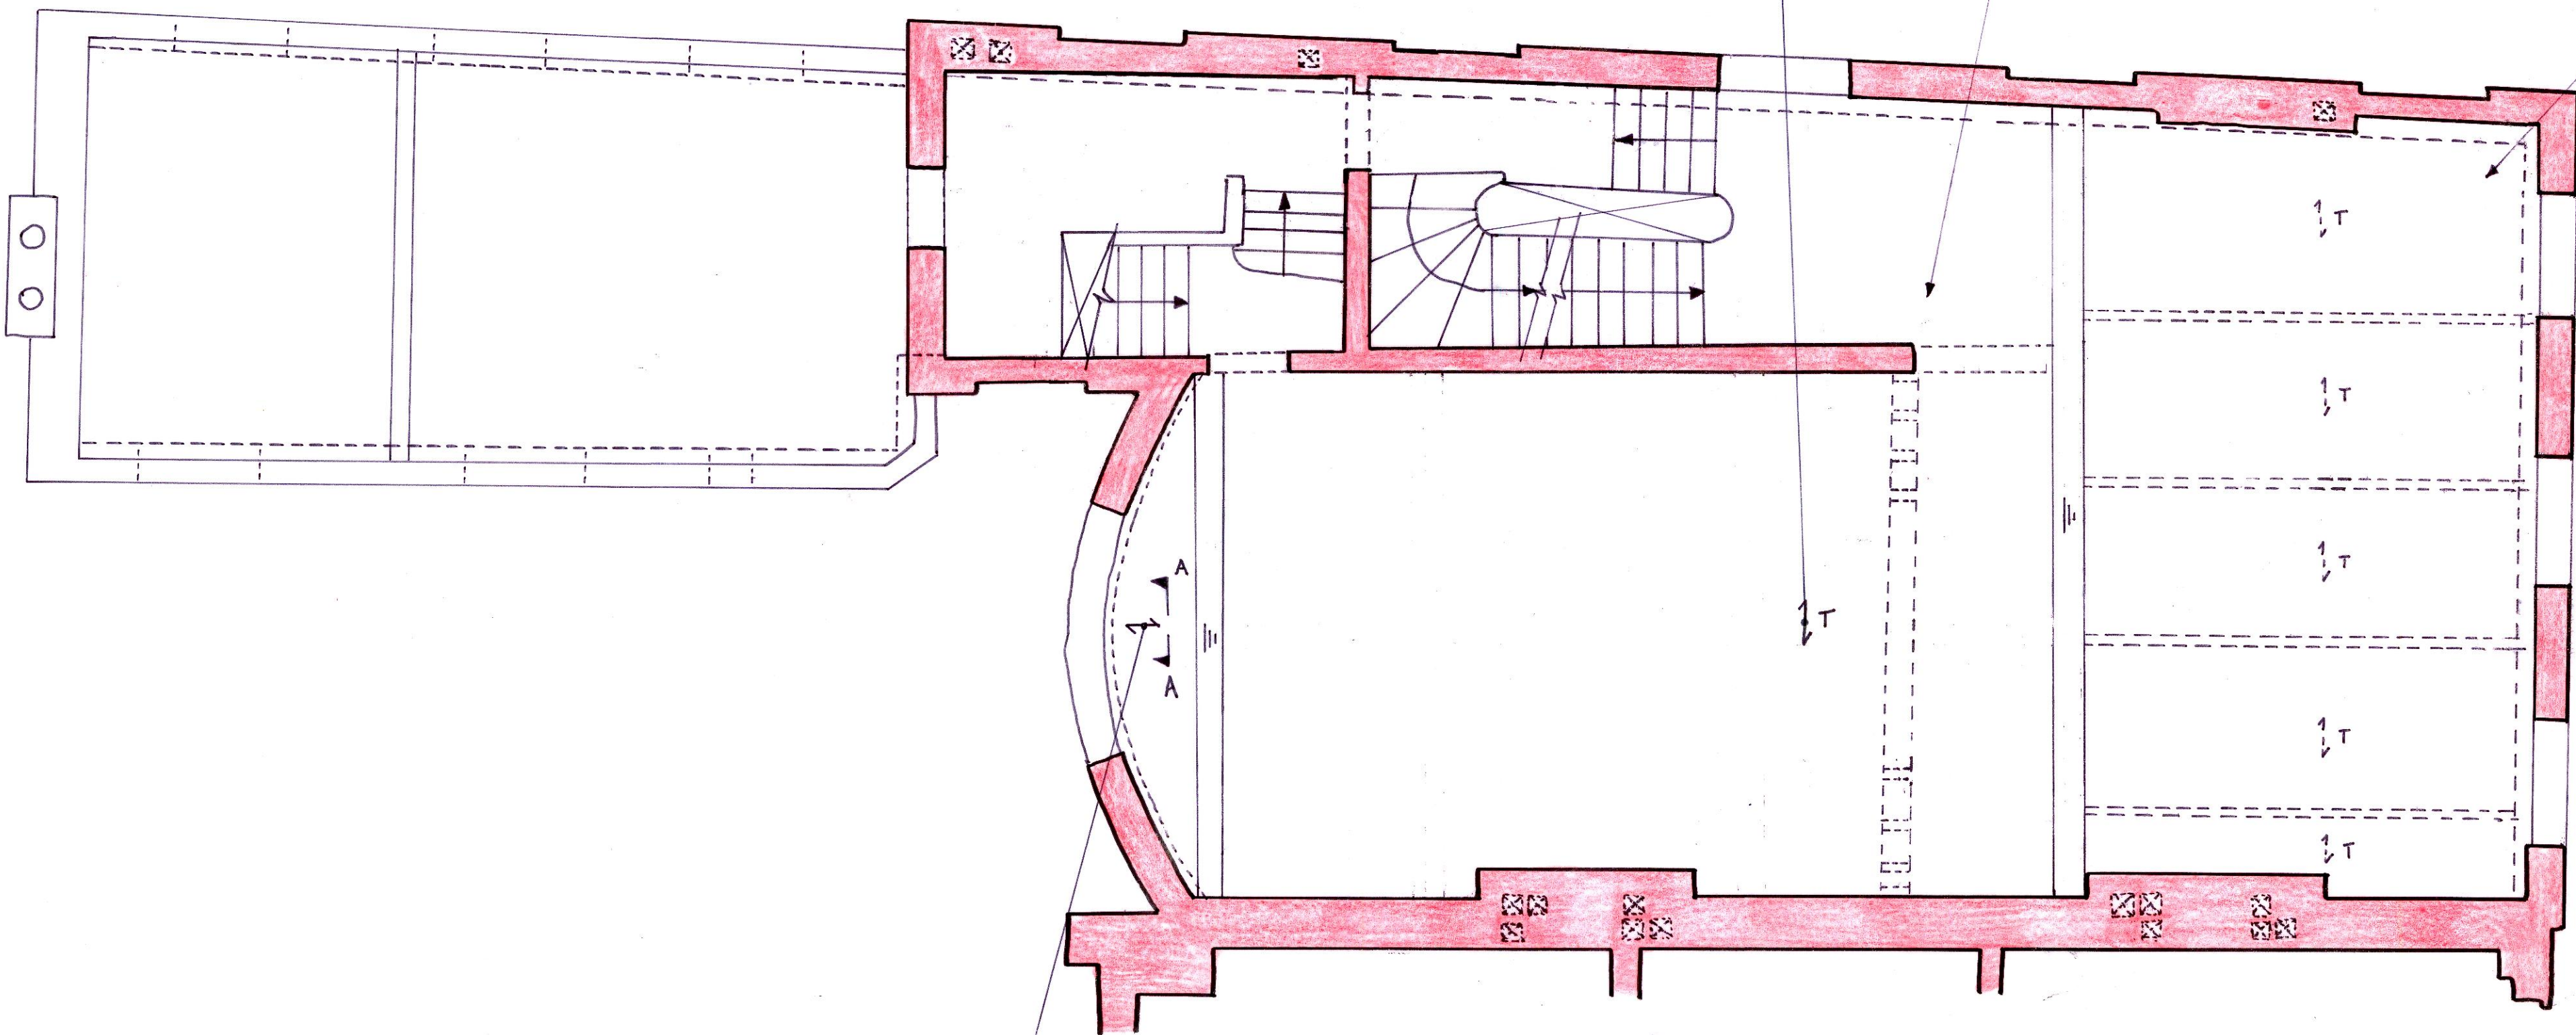

JOISTS 215 mm x 60 mm @ 400 mm c/c
SPANNING ONTO MASONRY WALL.
2 NO. LAYERS 18 mm PLY OVER.
FLOOR APPEARS NON-ORIGINAL.

- notes
1. DO NOT SCALE FROM THIS DRAWING.
 2. THE STRUCTURAL ARRANGEMENT SHOWN ON THESE DRAWINGS ARE BASED ON PRELIMINARY SITE INVESTIGATIONS CARRIED OUT JANUARY 2018, AND ARCHIVE DRAWINGS OF NEIGHBOURING PROPERTY No. 42.

A	1.6.18	ISSUED FOR INFORMATION. NOTE ADDED, FLUES ADDED.	LK
-	21.2.18	ISSUED FOR INFORMATION.	LK

job
**BRITISH MUSEUM,
38 RUSSELL SQUARE**

title
**EXISTING STRUCTURE
SECOND FLOOR PLAN**

drawn RG	checked LK
date FEB'18	scale (original - A1) 1:50

Alan Baxter

75 Cowcross Street London EC1M 6EL
tel 020 7250 1555
email aba@alanbaxter.co.uk

www.alanbaxter.co.uk

drg. no. 1756/702/004	rev. A
---------------------------------	------------------