


These plans are project and site specific and shall only be used for their intended purpose unless otherwise permitted by written consent of Brian O'Reilly Architects. All dimensions shown are indicative and must be double checked on site by the contractor. Any inconsistencies found must be reported to Brian O'Reilly Architects. DO NOT SCALE FROM THE DRAWINGS.

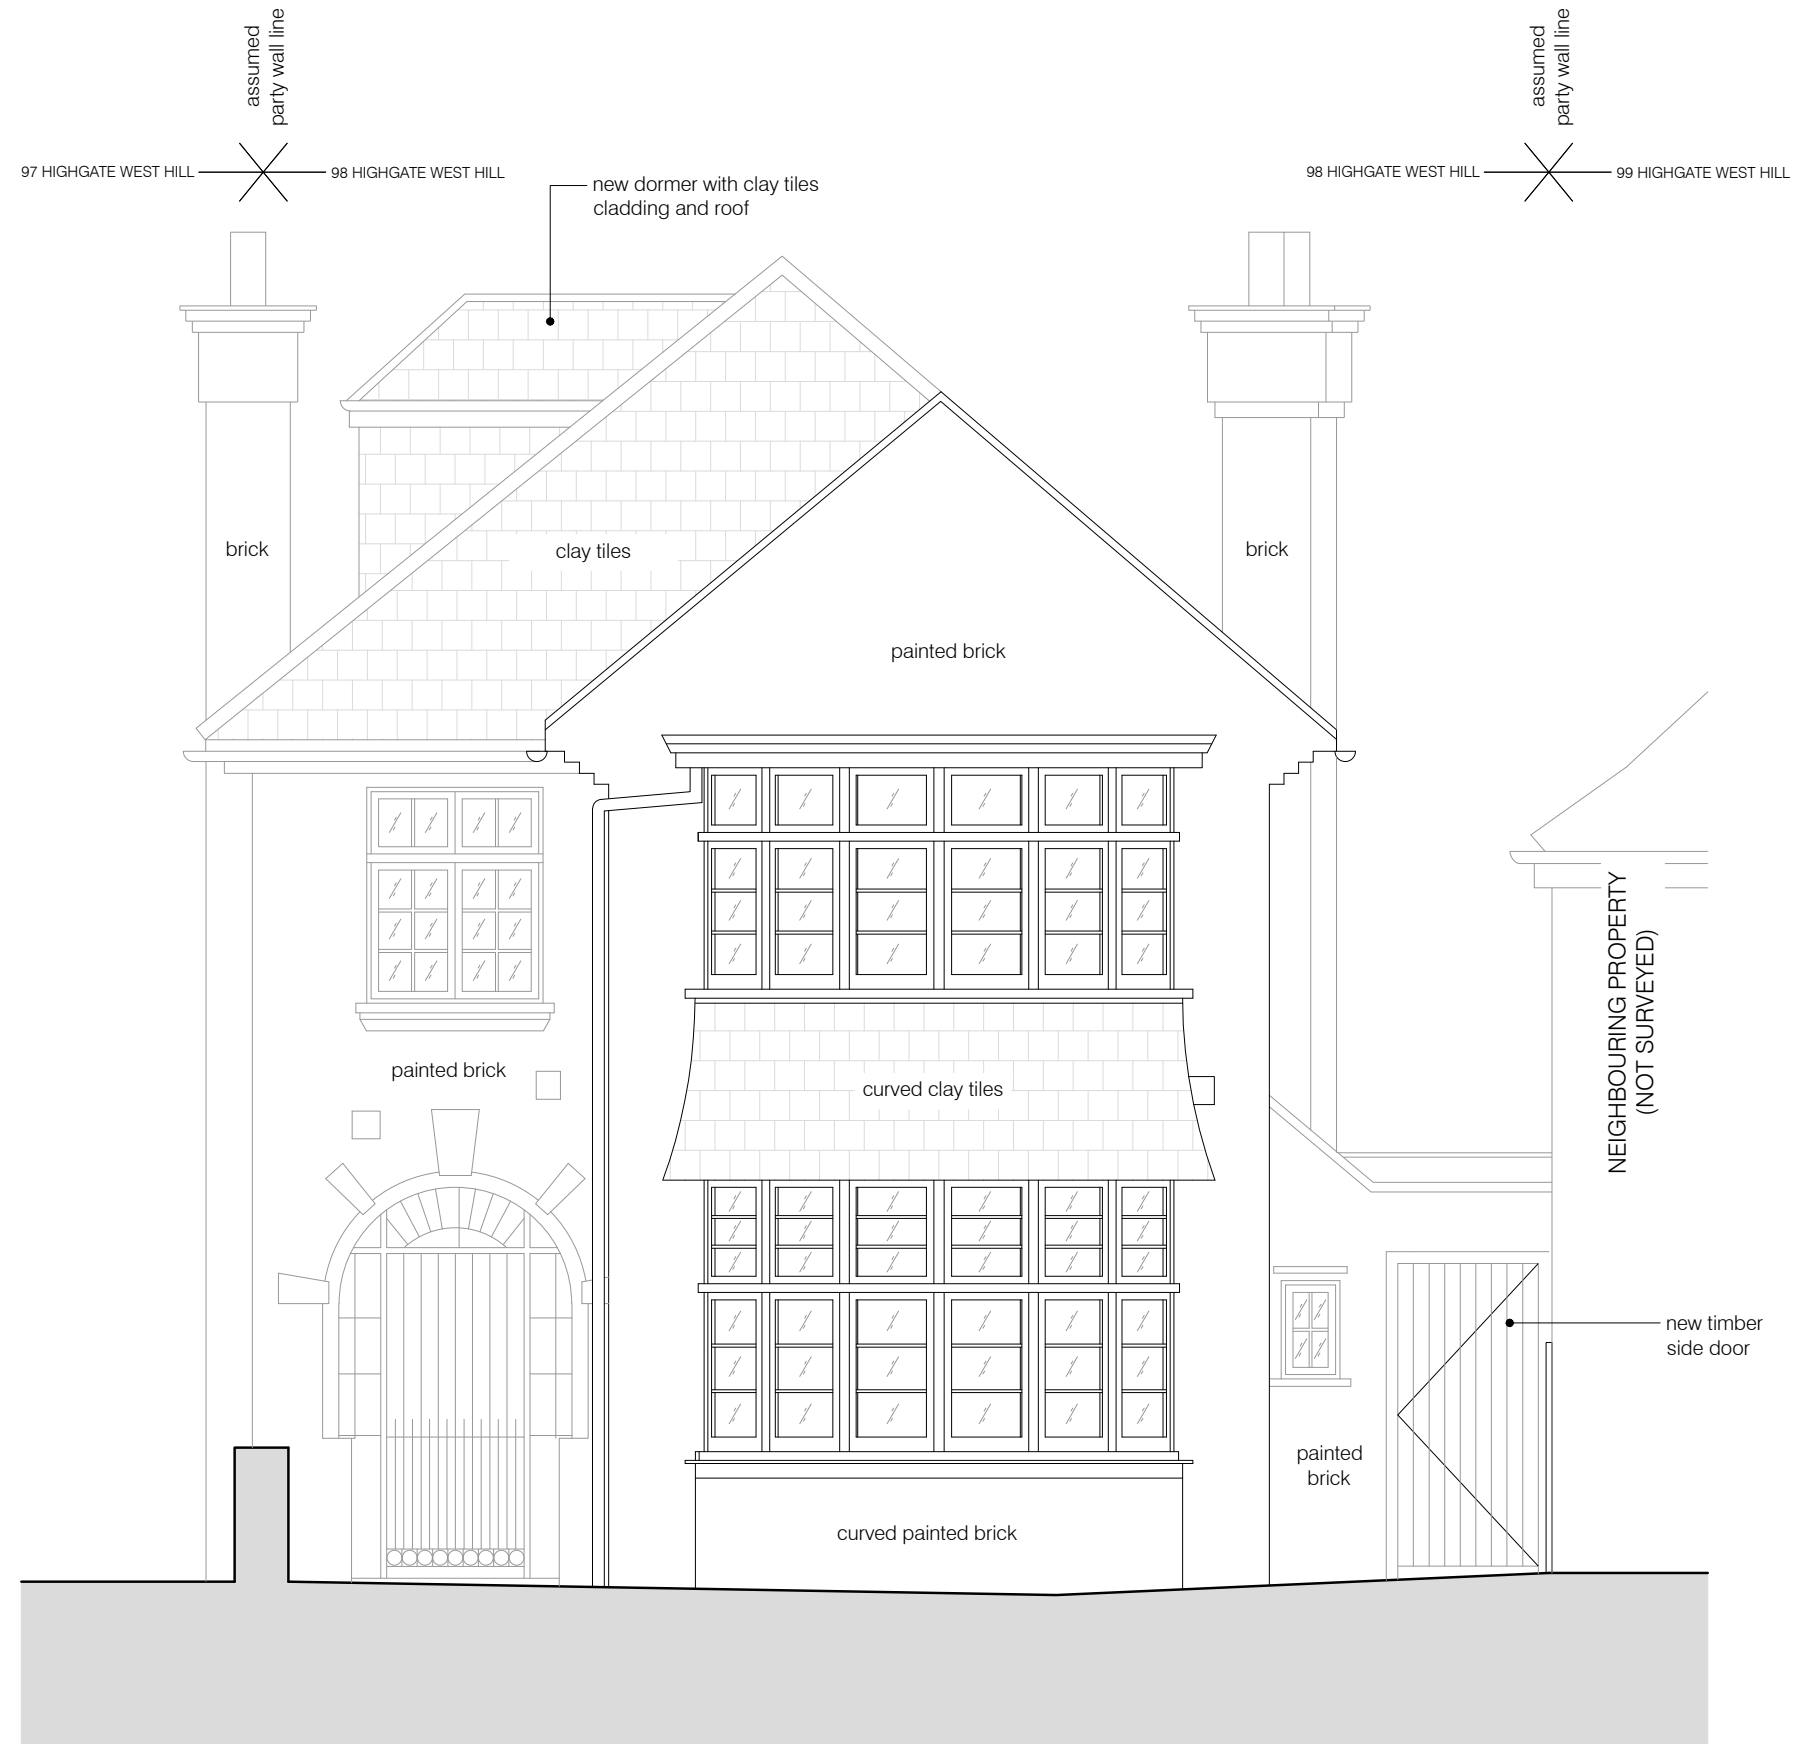


01 AS BUILT WEST (FRONT) ELEVATION
scale 1:50



project	status / number	scale
98 HIGHGATE WEST HILL N6 6NR	PLANNING/442-200-P_B	1:50 @ A3
BRIAN O'REILLY ARCHITECTS	drawing	date
31 Oval Road, London, NW1 7EA +44 (0)20 7267 1184 www.brianoreillyarchitects.com mail@brianoreillyarchitects.com	AS BUILT WEST (FRONT) ELEVATION	24.03.2020

These plans are project and site specific and shall only be used for their intended purpose unless otherwise permitted by written consent of Brian O'Reilly Architects.
 All dimensions shown are indicative and must be double checked on site by the contractor. Any inconsistencies found must be reported to Brian O'Reilly Architects.
 DO NOT SCALE FROM THE DRAWINGS.

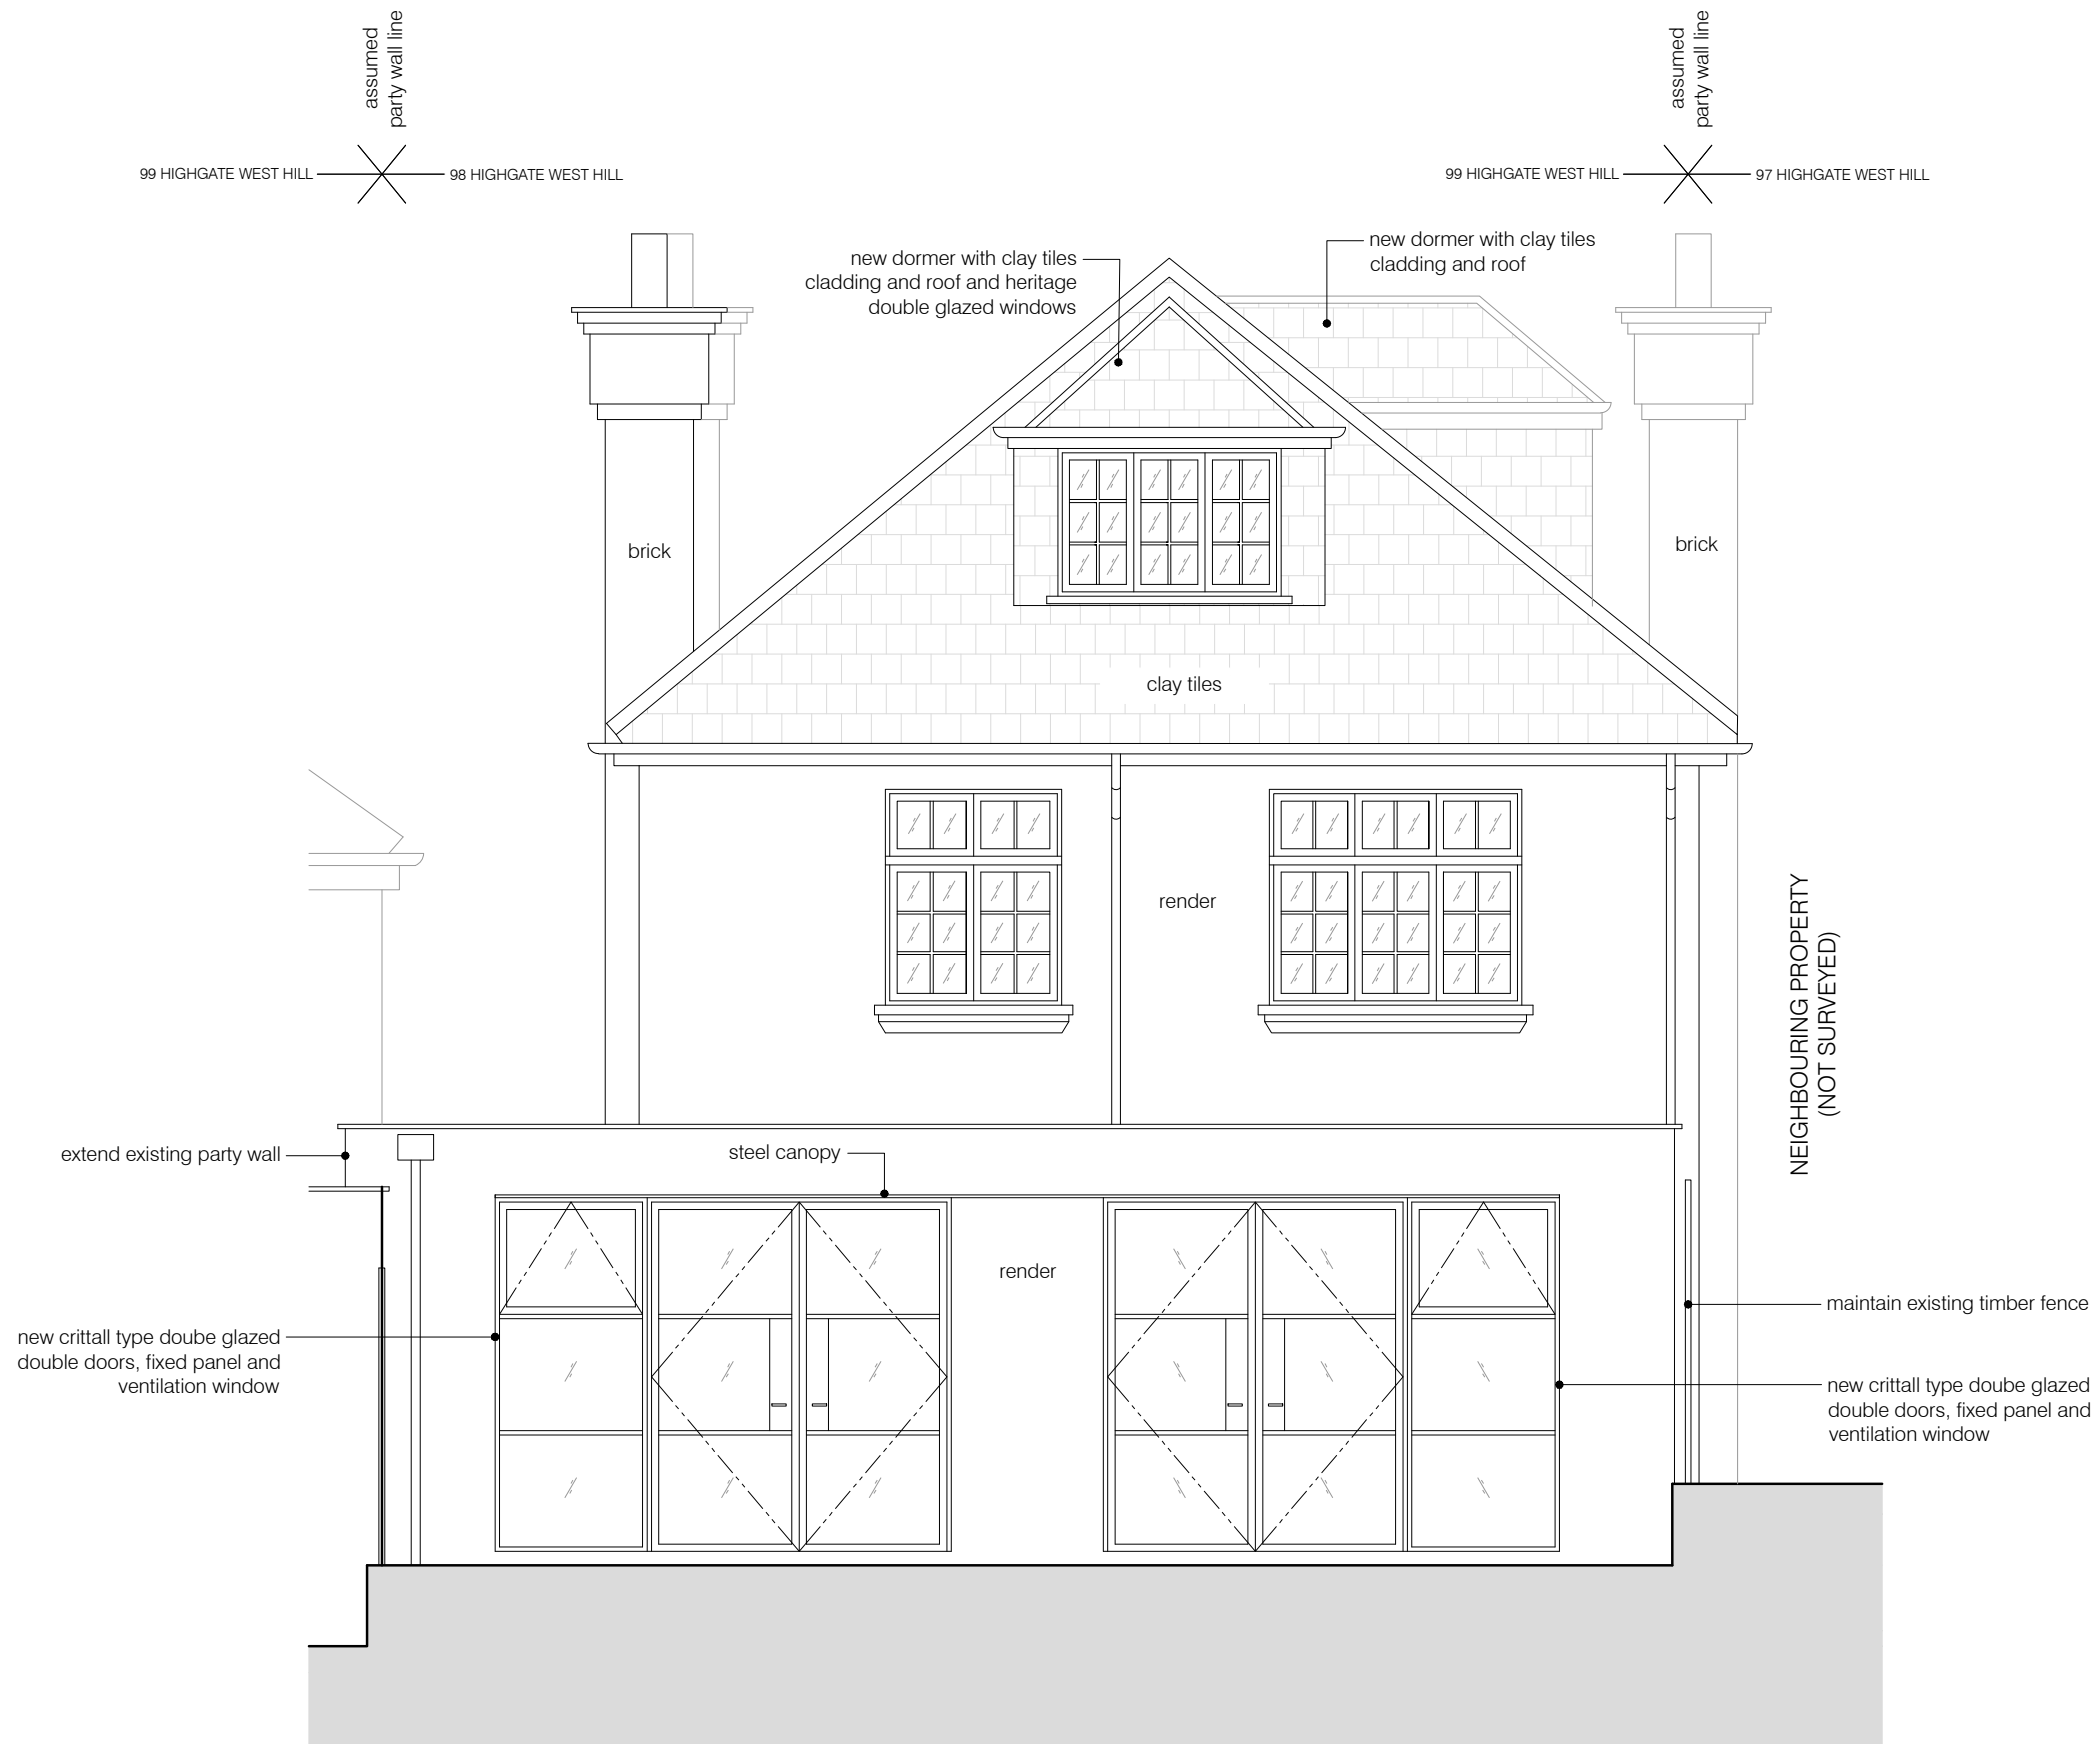

01 AS BUILT EAST (BACK) ELEVATION
 scale 1:50



project	status / number	scale
98 HIGHGATE WEST HILL N6 6NR	PLANNING/442-201-P_B	1:50 @ A3
BRIAN O'REILLY ARCHITECTS	drawing	date
31 Oval Road, London, NW1 7EA +44 (0)20 7267 1184 www.brianoreillyarchitects.com mail@brianoreillyarchitects.com	AS BUILT EAST (REAR) ELEVATION	24.03.2020

These plans are project and site specific and shall only be used for their intended purpose unless otherwise permitted by written consent of Brian O'Reilly Architects.
 All dimensions shown are indicative and must be double checked on site by the contractor. Any inconsistencies found must be reported to Brian O'Reilly Architects.
 DO NOT SCALE FROM THE DRAWINGS.




01 AS BUILT NORTH (SIDE) ELEVATION
 scale 1:50




project	status / number	scale
98 HIGHGATE WEST HILL N6 6NR	PLANNING/442-203-P_B	1:50 @ A3
BRIAN O'REILLY ARCHITECTS	drawing	date
31 Oval Road, London, NW1 7EA +44 (0)20 7267 1184 www.brianoreillyarchitects.com mail@brianoreillyarchitects.com	AS BUILT NORTH (SIDE) ELEVATION	24.03.2020

These plans are project and site specific and shall only be used for their intended purpose unless otherwise permitted by written consent of Brian O'Reilly Architects.
 All dimensions shown are indicative and must be double checked on site by the contractor. Any inconsistencies found must be reported to Brian O'Reilly Architects.
 DO NOT SCALE FROM THE DRAWINGS.

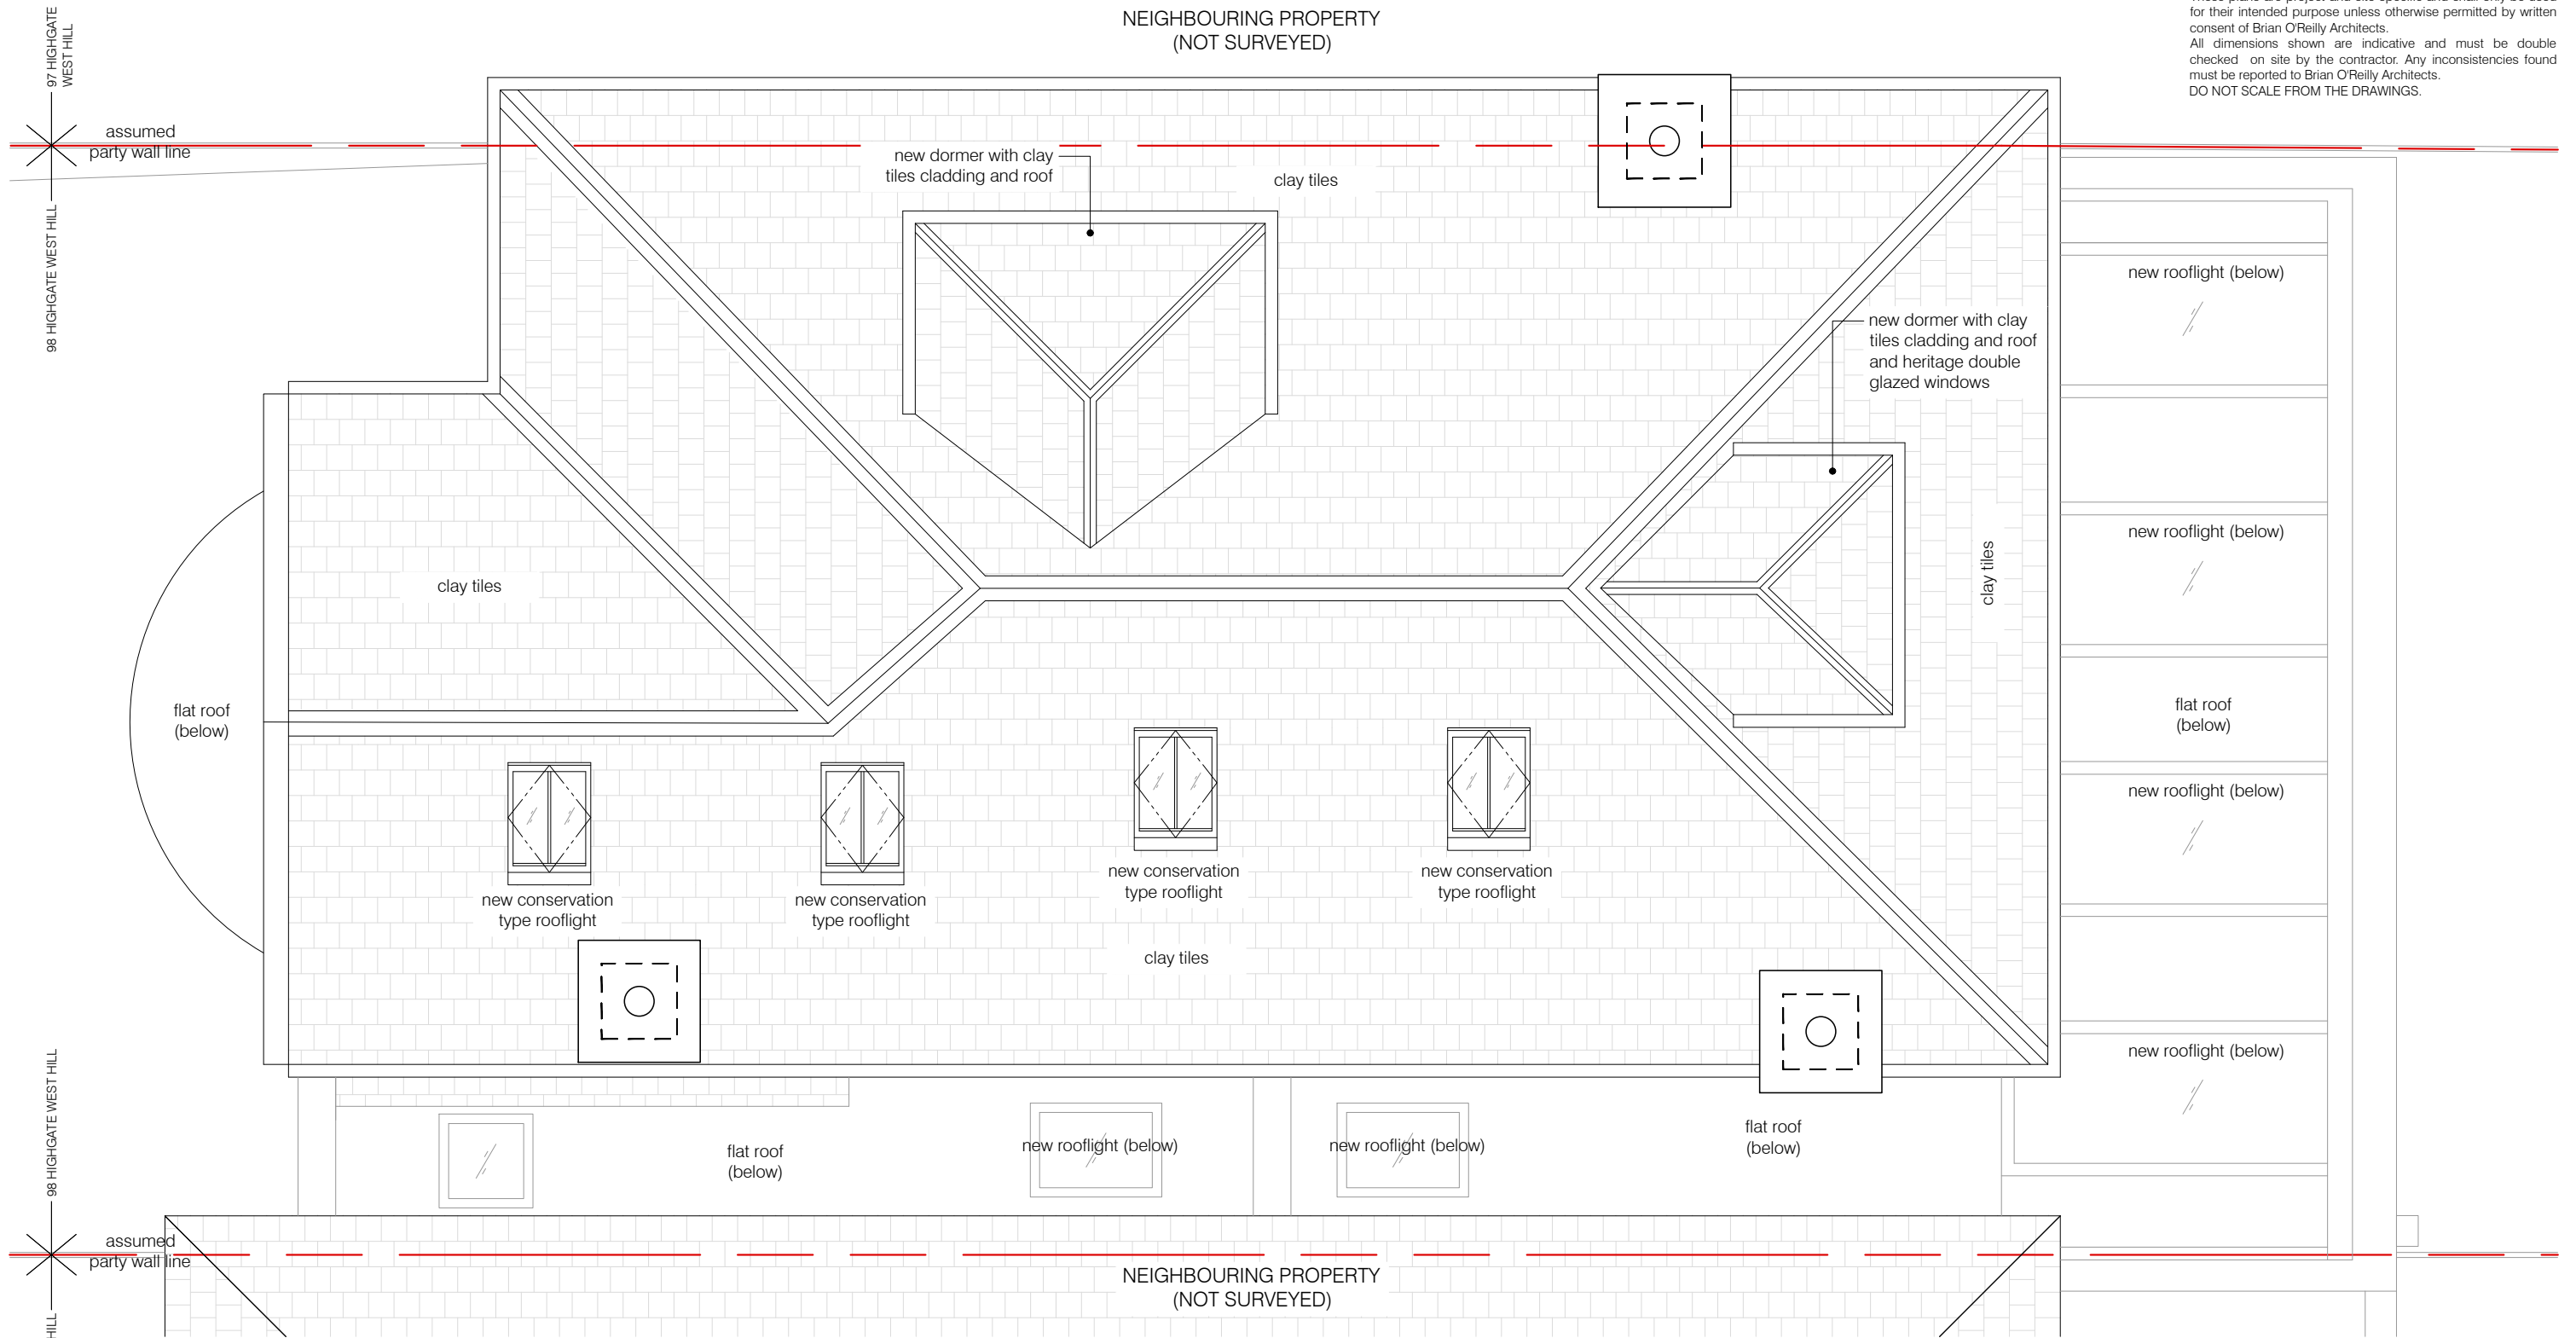

01 AS BUILT ROOF PLAN
 scale 1:50

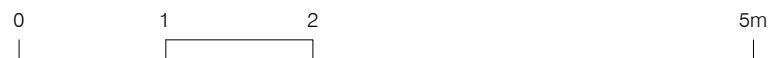

project	status / number	scale
98 HIGHGATE WEST HILL N6 6NR	PLANNING/442-104-P_B	1:50 @ A3
BRIAN O'REILLY ARCHITECTS	drawing	date
31 Oval Road, London, NW1 7EA +44 (0)20 7267 1184 www.brianoreillyarchitects.com mail@brianoreillyarchitects.com	AS BUILT ROOF PLAN	24.03.2020