


Proposed Ground Floor Plan


1:100

dashed red line
indicates profile of
existing garden shed

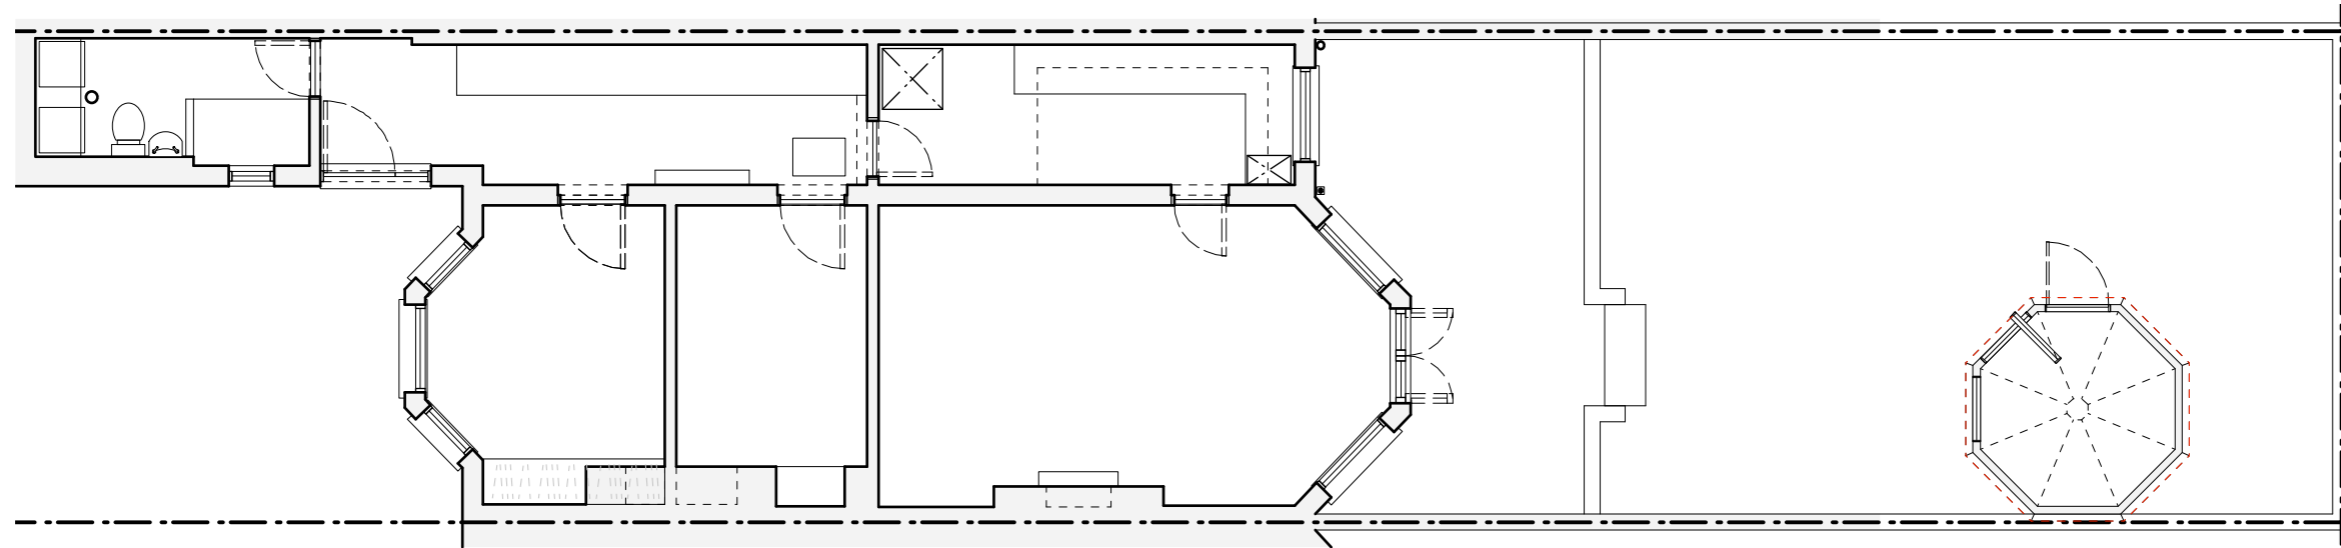

Existing Ground Floor Plan

1:100

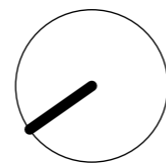

Rev: 00	Date: 04.05.2020	Description: Issue for planning
<p>NOTES: Do not scale from this drawing. All dimensions in millimeters. All dimensions to be checked on site. All omissions and discrepancies to be reported to the architect immediately. This drawing is © betterPAD.</p>		

Project: 11 Elsworthy Terrace NW3 3DR			
Dwg no: 1927 / PL.07			
Drawing: Existing & Proposed Site Plan			
Date: May 2020	Scale: as shown @ A3	C bP	D bP
Rev: 01			

Planning

better PAD
love your home

W www.betterpad.co.uk
E hello@betterpad.co.uk