


SECTION THROUGH DORMER ROOF -
PROPOSED MODIFICATION
u-value = 0.18 W/m²K

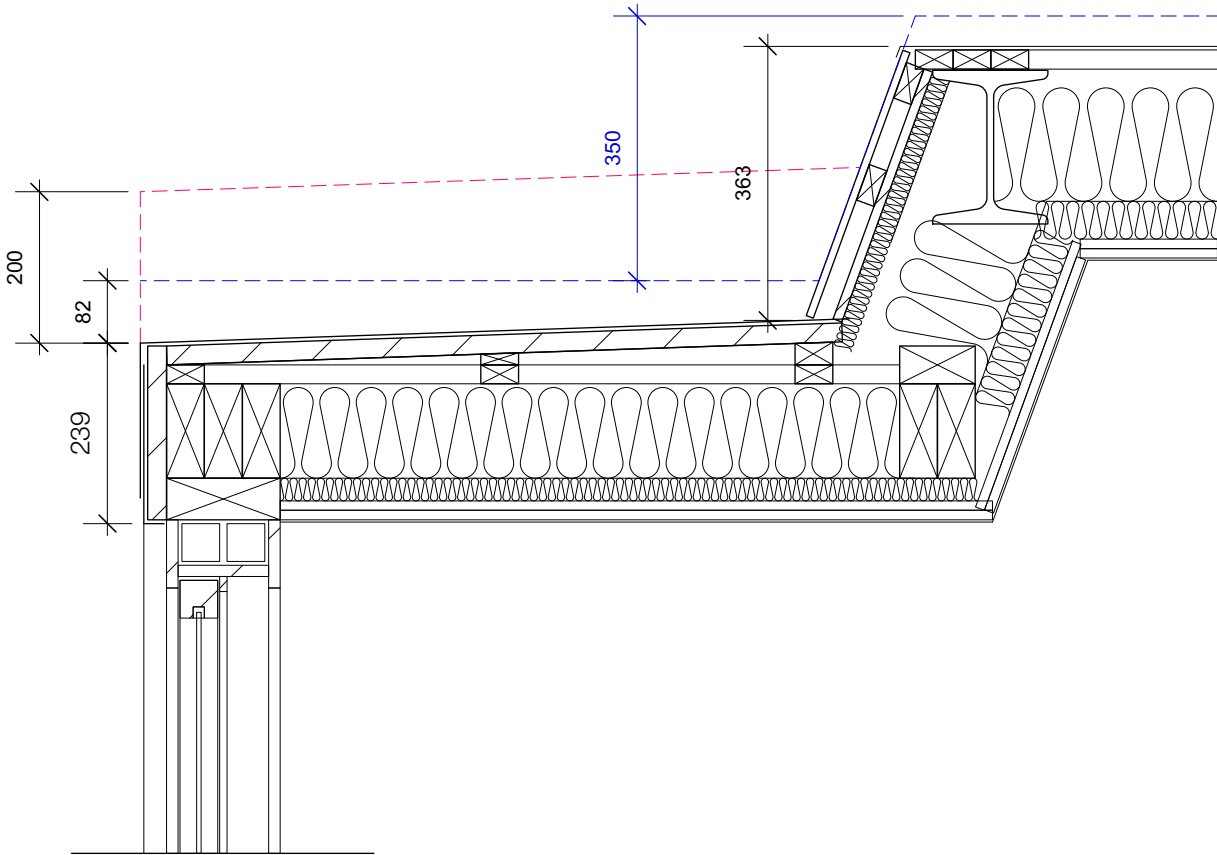

KEY

- OUTLINE OF APPROVED PERMISSION DRAWING
- OUTLINE OF 'AS BUILT' PROFILE

© Ampersand Architecture LLP
Do not scale from this drawing.
Dimensions are to be verified on site prior to construction
Ordnance Survey Data reproduced by permission of Ordnance Survey® on behalf of Her Majesty's Stationary Office. © Crown Copyright. All rights reserved.

Notes

Rev Date Prepared/Checked Description



The Studio, 4 Cole Park Road, Twickenham TW1 1HW

T: 07590 319111 E: info@amparchitecture.co.uk
www.amparchitecture.co.uk

Client

Mrs Paula Hughes

Project

108C Argyle Street WC1X 8QZ

Drawing Title

Dormer Roof Modifications
Reduction of roof height

Drawing Status

Planning

Date

03.10.19

Scale

1:10@A3

Drawn

YT

Drawing Number

083-D-091B

Revision

B