

LYNDON
GOODE
ARCHITECTS

© 2019 Lyndon Goode Architects Ltd.
For general enquires: studio@lyndongoode.com


Do not scale from this drawing. Contractor to check and verify all building and site dimensions, levels and sewer invert levels at connection points before work starts.

This drawing is to be read and checked in conjunction with information provided by the engineers and other specialists.

REV.	DATE	DESCRIPTION
------	------	-------------

P01	27/04/20	First Issue
-----	----------	-------------

KEY PLAN

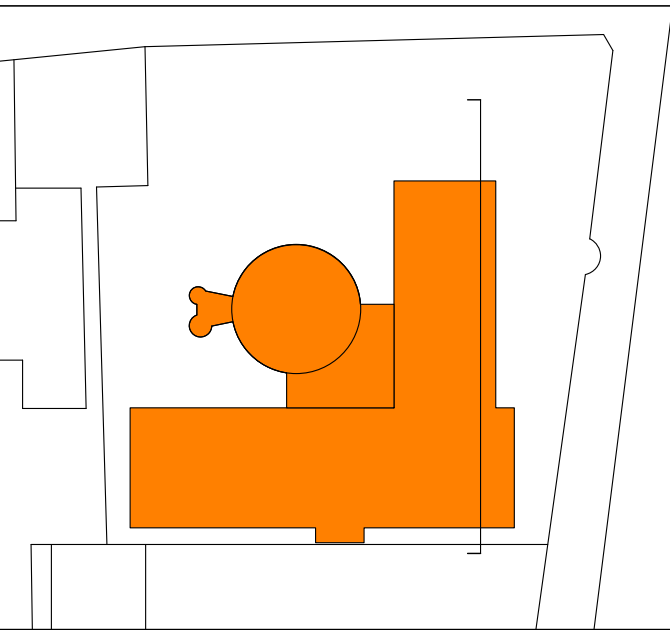

INFORMATION

--- Dashed red line indicates extent of existing building

--- Dashed blue line indicates extent of consented scheme (Application Ref: 2017/4498/P) where this differs from the line of the existing building.

0 0.5 1 2.5 m
Scale (1:50)

PROJECT
35 Templewood Avenue
DRAWING
Comparative Section BB

SCALE	REV.
1 : 50 at A1	P01

DRAWING NUMBER
TAV- LGA- ZA- XX- DR- A- 0961

DRAWING STATUS
PLANNING

