

STRIP OUT

LEADWORK

Carefully record and remove all existing leadwork and underlay. Set aside for architect's examination and instructions.

SLATE ROOF

Carefully record and dismantle existing roof slates. Store for later reinstatement.

Dismantle existing roof boarding. Set aside for architect's examination and instructions.

RENDERS AND MORTARS

Remove all existing defective mortar and reinstate with new.

Carefully remove mortar where lead has to be chased without damaging brickwork.

Carefully remove all existing added renders to brickwork.

LANTERN

Carefully record, dismantle and store for later reinstatement existing glazing panes, and SS clips.

Record and dismantle cast iron lantern. Sand blast cleaning, priming and decoration in workshop.

After removal of leadwork, lantern kerb to be examined by architect for defects.

Attention:
Asbestos may be present in putty. Works to be carried out by specialists and in accordance with all the health and safety regulations.

LEADWORK

GENERALLY

All leadwork should be in accordance with BS6915:2001+A1 2014 and the LSA recommendations as in Rolled Lead Sheet The Complete Manual 2015 Edition.

ROOFING (FLAT ROOF SLOPES AND GUTTERS)

All lead to slopes and gutters to be new 8lb rolled lead. Max. length 3000mm; max. roof bay width 750mm; max gutter girth 1000mm; min. drip 60mm. Roof fall 1:80. No splashlap.

Use 45mm preservative treated wood cored rolls to form all required bays.

Lay lead on 220g/m² non-woven geotextile over 200x25mm SW boards. Allow 3mm gap between boards for ventilation.

Fix lead with 1No row of SS nails at 50mm crs on top of drip. Nail lead undercloak to roll just on its upper third.

CLADDING

All cladding lead to be new 5lb rolled lead. Vertical welled laps at max 600mm. 2No lead burnt clips per bay at bottom. Min overlap 75mm. Fix capping with continuous SS clip, min overlap 75mm.

Cladding lead to be fixed with 2No rows of SS nails at 75mm crs.

COVER FLASHING

All cover flashing to be new 5lb rolled lead. Min height 100mm, min vertical lap 75mm. Max length 1500mm, min lap between flashings 100mm.

Fix cover flashing on mortar joints with wedges at max 450mm crs. Point with arboasil XL1099 buff colour. Lead burnt clips at max 500mm crs on free edge. Refer to DWG (27)AD002.

CLIPS

All visible clips to be 5lb lead. All secluded clips to be 0.4mm SS. 6mm expansion gap to be allowed between clip and bottom of cover flashing.

SETTING OUT

- S1. Align roll to lift box. Divide slope in 5No equal bays.
- S2. Align extreme rolls with lift box. Align roll to gutter step. Divide rest of slope in 2No equal bays.
- S3. Divide slope in 3No equal bays. Southern bay to be lower to collect water from S10.
- S10 and S11. Divide slopes in 3No bays symmetrically centred to lantern.
- S12. Divide slope in 2No equal bays. Northern bay to be lower in order to collect water from slope S11.
- S13. Divide slope in 3No equal bays.
- S15 and S16. Divide slope in 10No equal bays. Central wood cored ridge. Max length 2500mm, max width 850mm.
- S18. Divide slope in 5No bays. Rolls to be placed centred to rooflights. Minimum overlap 75mm vertical.
- G1. New gutter profile. 2No steps. Refer to DWG (27)AD001.
- G2. New 2No steps gutter profile. Refer to DWG (27)AD001.
- G3. New 2No steps gutter profile. Central roll. Refer to DWG (27)AD001.
- G4. New 3No steps gutter profile. Refer to DWG (27)AD001.
- G5. New 4No steps gutter profile. Refer to DWG (27)AD001.
- G6. New 3No steps gutter profile. Refer to DWG (27)AD001.
- G7. New 3No steps gutter profile. Refer to DWG (27)AD001.

16. New 5lb rolled lead cover flashing as specified.
17. New 5lb rolled lead step cover flashing as specified with secret gutter. Fix cover flashing on mortar joints with 1No wedge per step. Point with arboasil XL1099 buff colour. Lead burnt clips at max 450mm crs on free edge. Refer to DWG (27)AD002.
18. New 5lb rolled lead cladding as specified. Divide long front in 4No equal bays. Divide short fronts in 3No equal bays. Refer to DWG (27)AD003.
19. New 5lb rolled lead dormer cheek as specified for vertical cladding. 1No central welled joint per side. Cover flashing with secret gutter in the abutment with roof slope. 5lb rolled lead capping to be fixed with continuous SS clip. Lead apron to gutter G4. Refer to DWG (27)AD002.
20. New 5lb rolled lead lining to hatch/rooflight upstand. Refer to DWG (27)AD003.

VENTILATION

21. New abutment ventilator as Nicholson's "Airtak-AB" with SS insect screen. Refer to DWG (27)AD002.3.
22. New Layboard ventilator as Nicholson's "Airtak-LB" with SS insect screen. Refer to DWG (27)AD002.2.
23. New ridge ventilator as Nicholson's "Airtak-VR" with SS insect screen. Refer to DWG (27)AD002.1.
24. New roof void ventilator as Nicholson's "Airtak-LV15" with SS insect screen.
25. New roof void ventilator as Nicholson's "Airtak-EA" with SS insect screen. Refer to DWG (27)AD002.5.
26. New SVP ventilator as Nicholson's "Airtak" with insect mesh to suit SVP. Allow space for lead thermal expansion.

NOTE: Install ventilators in accordance with manufacturer's instructions.

SLATE ROOFING

27. S3-S8 & S14 & S17. Reused slate tiles to be nailed to 35x50mm SW battens fixed to the roof over PVC waterproof layer, as Breather Membrane Kingspan Nilvent or equal approved. Layout of slate to match existing. Allow for 30% new slates to match existing.

HEALTH AND SAFETY

28. New permanent horizontal fall arrest system as "UNI 8TM System" by DBI Sala (Capital Safety Group Ltd), or similar advised by Specialist and approved by Architect. Use lead slates for penetration of roof by safety cable anchorage; refer to Fig.111 LSA Manual.

LANTERN

29. Reinstall lantern after cleaning, priming and decoration. Allow for repairs to kerb with a two-parts epoxy resin.
30. Reinstall glazing panes to cast iron lantern on new arbostrap F90. 1No new glazing pane to match existing. Seal glazing panes with arboasil 1099. New lead coping to match existing. Refer to DWG (27)AD004.
31. New condenser units on new SS base to Structural Engineer's Specifications to be fixed through lead as shown on DWG (27)AD004.

POWER SUPPLIES

33. Cable tray

SECURITY

34. CCTV Cameras

CURRENT AS BUILT CONDITION


BUILDING DESIGN PARTNERSHIP LTD SHALL HAVE NO RESPONSIBILITY FOR ANY USE MADE OF THIS DOCUMENT OTHER THAN FOR THAT WHICH IT WAS PREPARED AND ISSUED

ALL DIMENSIONS SHOULD BE CHECKED ON SITE.

DO NOT SCALE FROM THIS DRAWING.



ANY DRAWING ERRORS OR DIVERGENCES SHOULD BE BROUGHT TO THE ATTENTION OF BUILDING DESIGN PARTNERSHIP LTD AT THE ADDRESS SHOWN.

																																																																																																																																																																																																																																																																																																																																																																																																																																																																																																																																																																																																																																																																																																																																																																																																																																																																																																																																																																																																																																																																																																																																																																																																																																																																																																																																																																																																																																																																																																																																																																																																																																																																																																																																																																																																																																																																																																																																																																																																																																																																																																																																																																																																																																																																																																																																																																																																																																																																																																																																																																																																																																																																																																																																																																																																																																																																																																																																																																																																																																																																																																																																																																																																																																																																																																																																																																																																																																																																																																																																																																																																																																																																																																																																																																																																																																																																																																																																																																																																																																																																																																																																																																																																																																																																																																																																																																																																																																																																																																																																																																																																																																																																																																																																																																																																																																																																																																																																																																																																																																																																																																																																																																																																																																																																																																																																																																																																																																																																																																																																																																																																																																																																																																																																																																																																																																																																																																																																																																																																																																																																																																																																																																																																																																																																																																																																																																																																																																																																																																																																																																																																																																																																																																																																																																																																																																																																																																																																																																																																																																																																																																																																																																																																																																																																																																																																																																																																</											
--	--	----	--	--	--	--	--	--	--	--	--	--	--

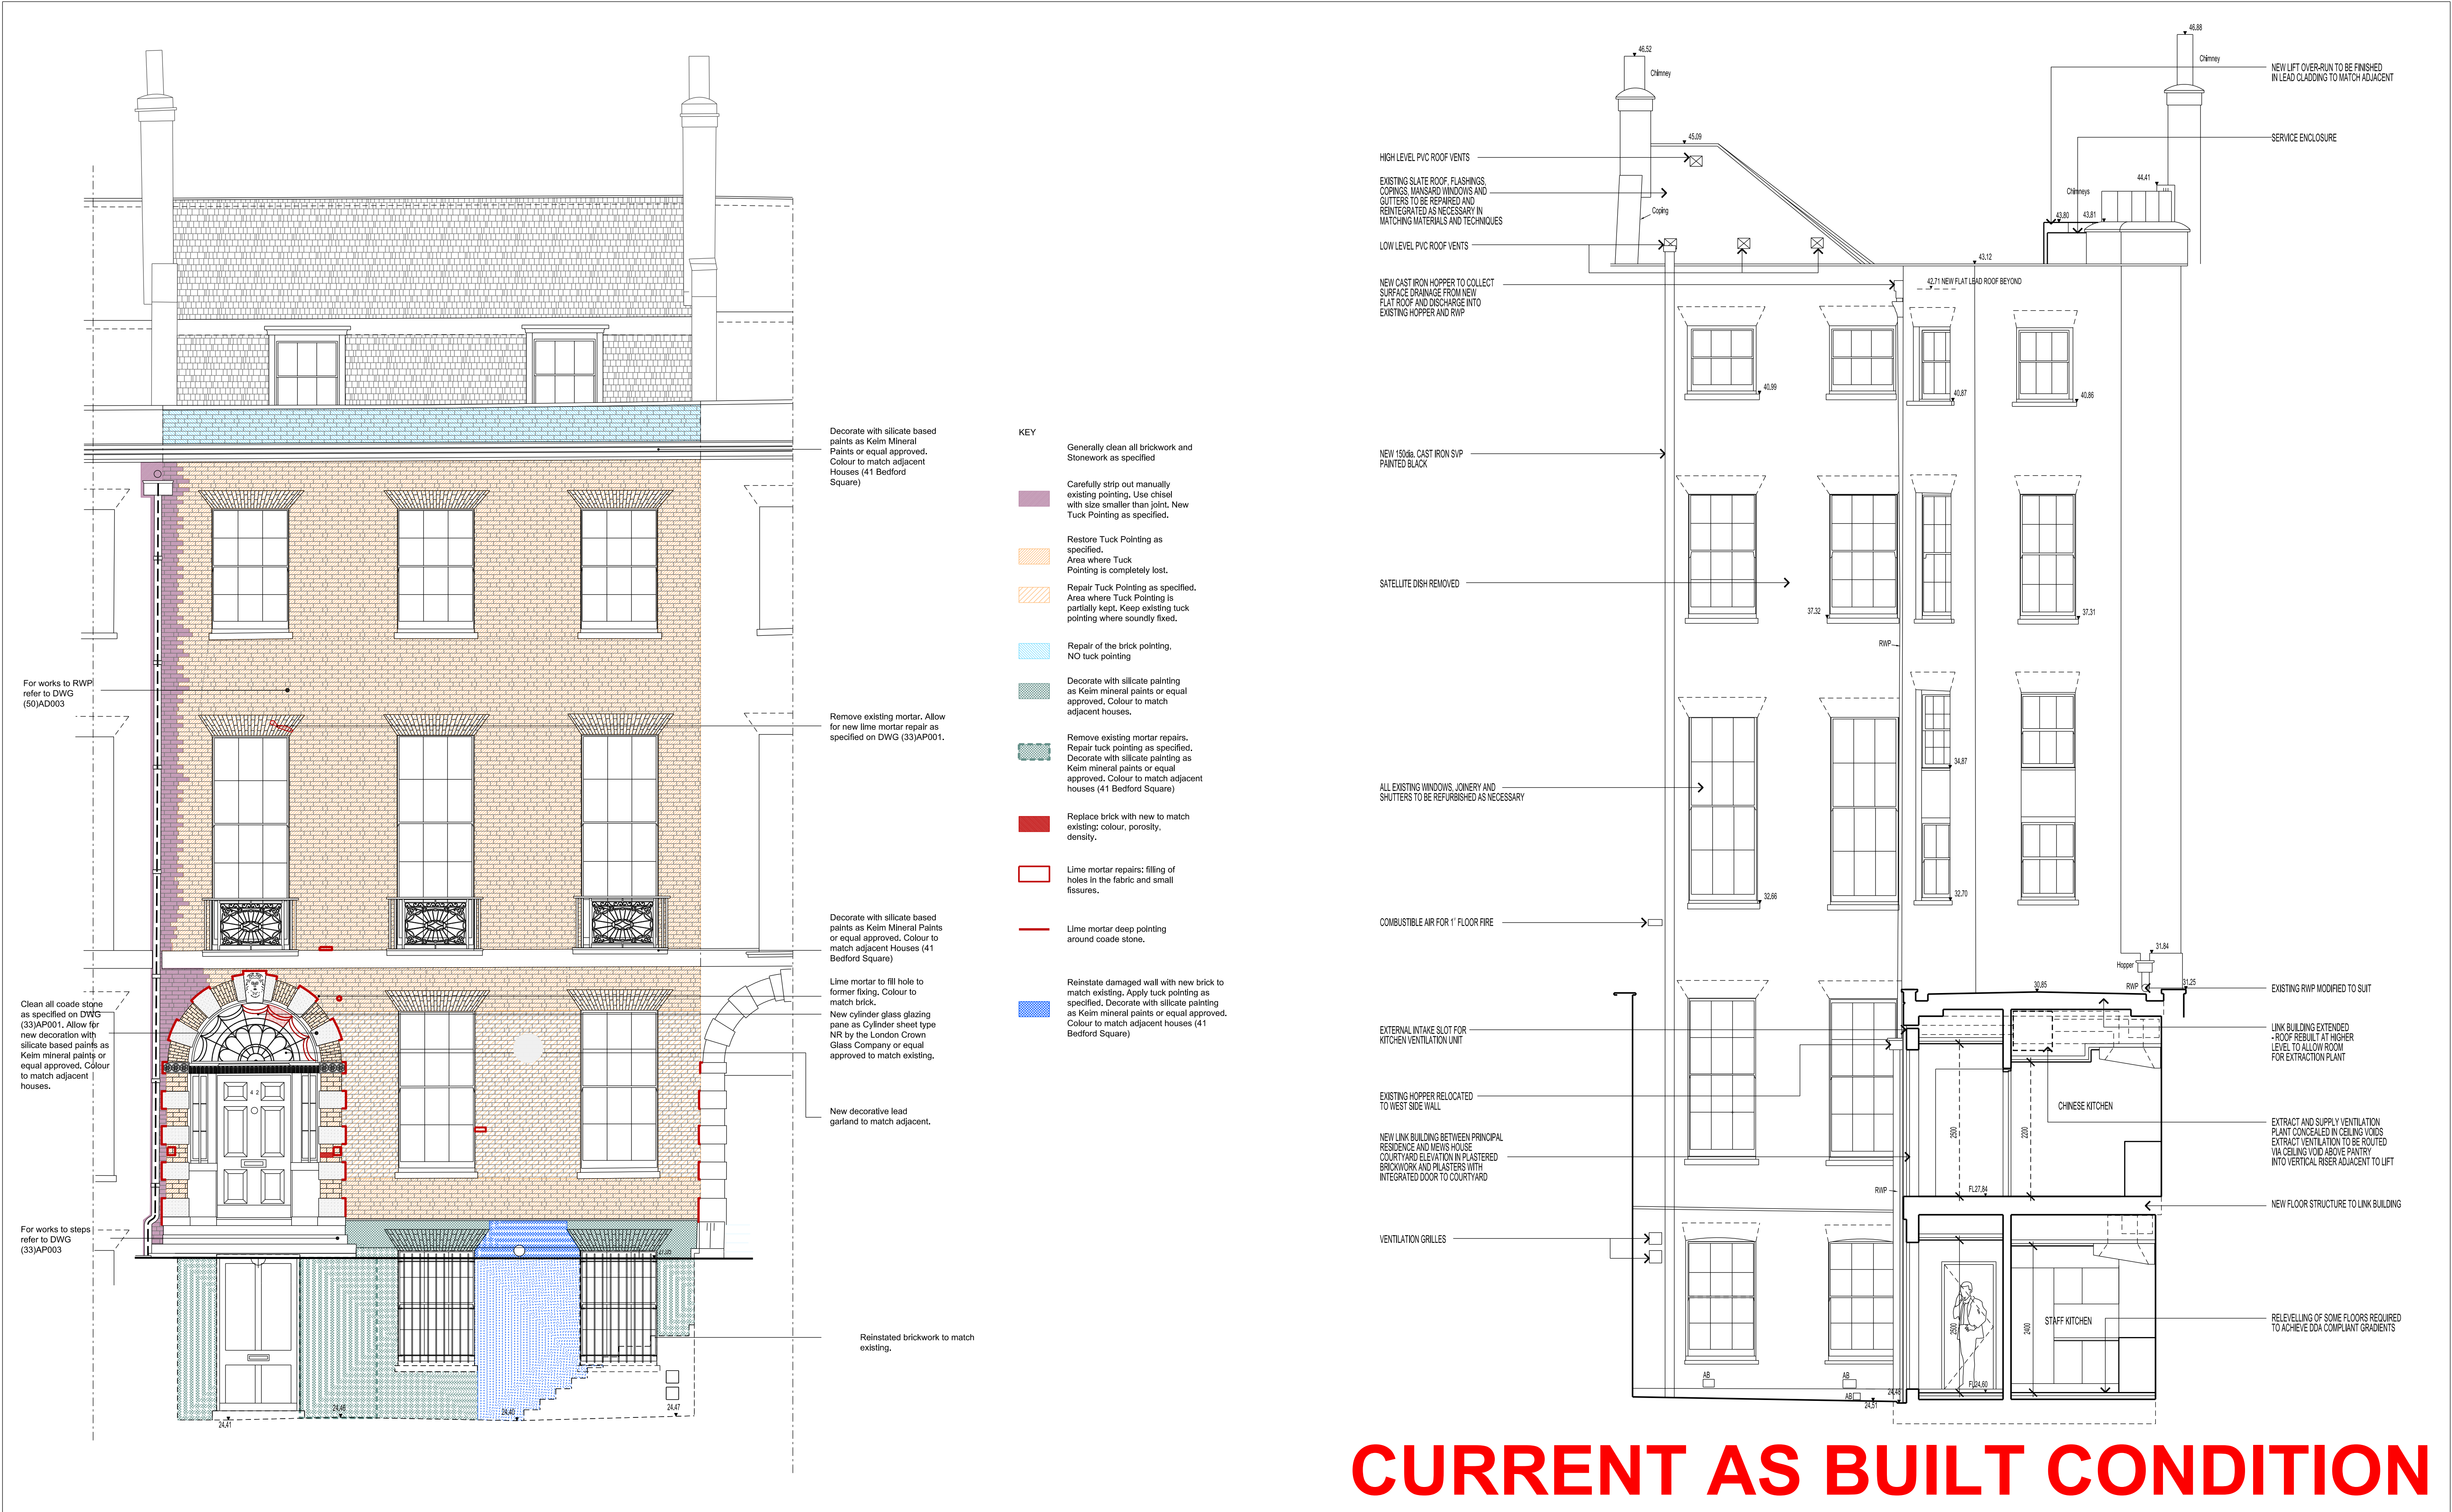

CURRENT AS BUILT CONDITION

BUILDING DESIGN PARTNERSHIP LTD SHALL HAVE NO RESPONSIBILITY FOR ANY USE MADE OF THIS DOCUMENT OTHER THAN FOR THAT WHICH IT WAS PREPARED AND ISSUED									
ALL DIMENSIONS SHOULD BE CHECKED ON SITE.									
DO NOT SCALE FROM THIS DRAWING.									
ANY DRAWING ERRORS OR DIVERGENCES SHOULD BE BROUGHT TO THE ATTENTION OF BUILDING DESIGN PARTNERSHIP LTD AT THE ADDRESS SHOWN.									
</									

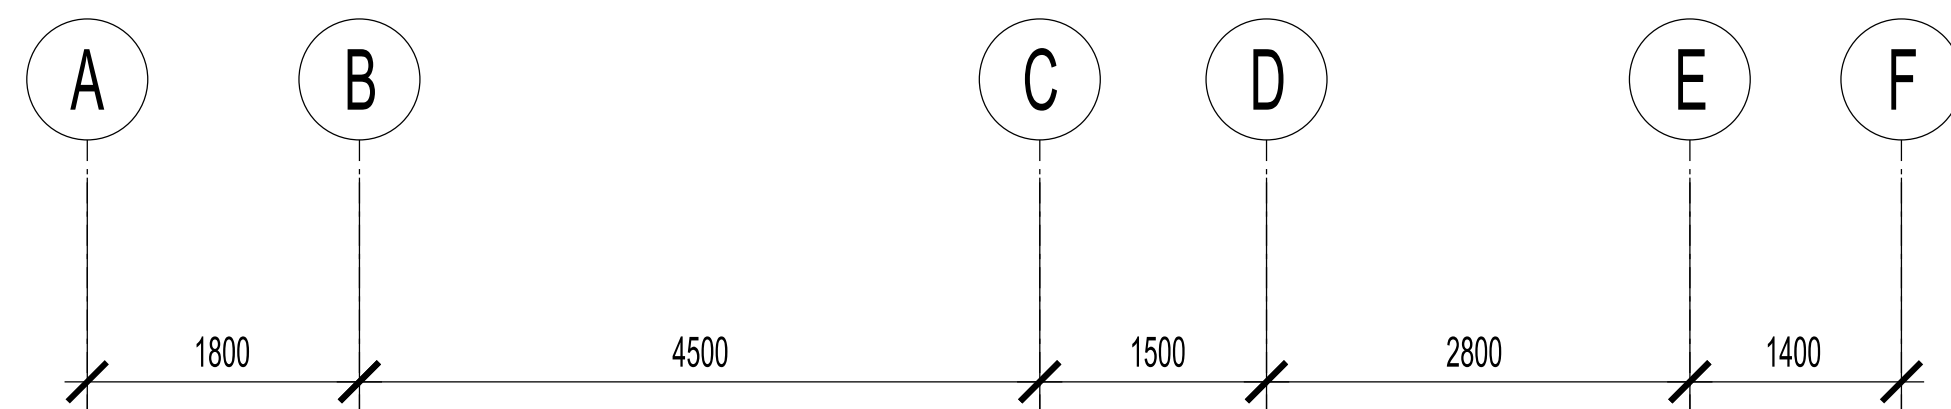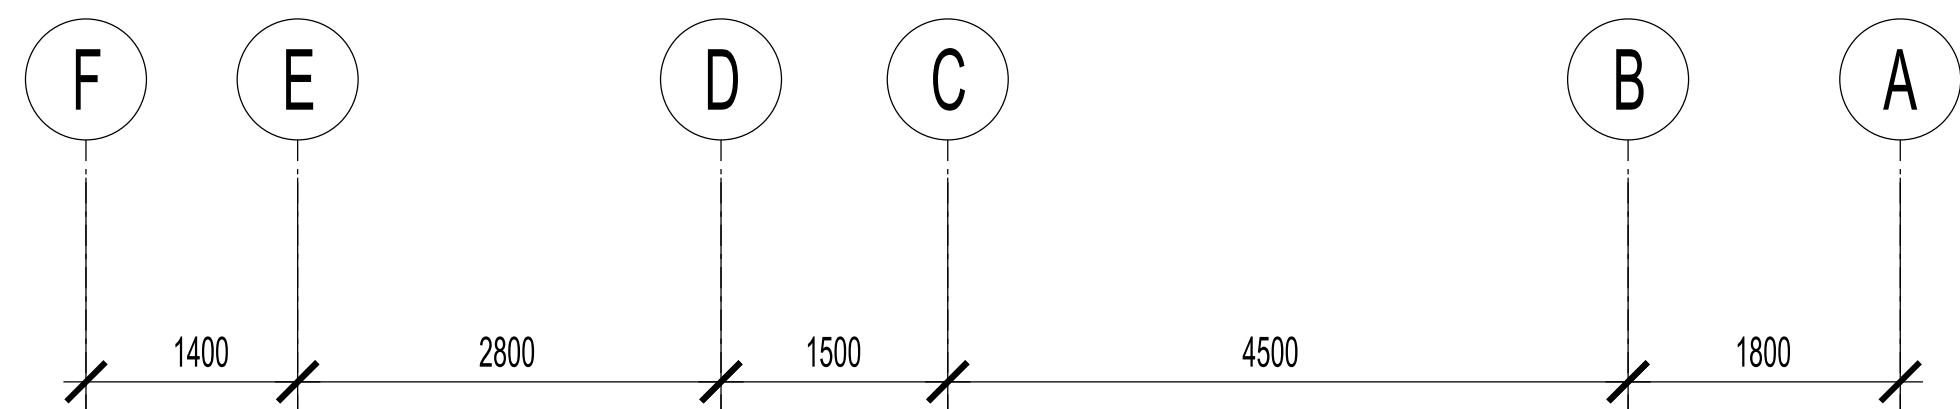

CURRENT AS BUILT CONDITION

BUILDING DESIGN PARTNERSHIP LTD SHALL HAVE NO RESPONSIBILITY FOR ANY USE OF THIS DOCUMENT OTHER THAN FOR THAT WHICH IT WAS PREPARED AND ISSUED.


ALL DIMENSIONS SHOULD BE CHECKED ON SITE.

DO NOT SCALE FROM THIS DRAWING.

ANY DRAWING ERRORS OR DISCREPANCIES SHOULD BE BROUGHT TO THE ATTENTION OF BUILDING DESIGN PARTNERSHIP LTD AT THE ADDRESS SHOWN.

REVISION DESCRIPTION	DATE	REVISION DESCRIPTION	DATE	REVISION DESCRIPTION	DATE	REVISION DESCRIPTION	DATE	REVISION DESCRIPTION	DATE	REVISION DESCRIPTION	DATE	REVISION DESCRIPTION	DATE	REVISION DESCRIPTION	DATE

A-LBC APPLICATION	GP	MB	14/12/2017
-LBC APPLICATION - DRAFT FOR COMMENT	GP	MB	08/12/2017

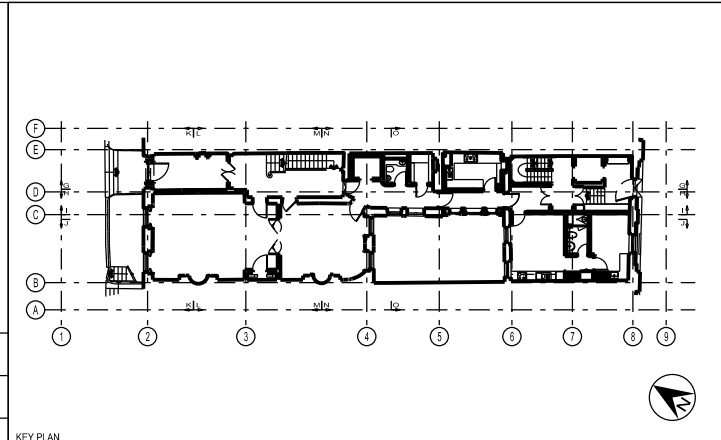

16 Greenhouse Yard
Clerkenwell
London, EC1V 4LJ
United Kingdom

T +44 (0)20 7812 8000
F +44 (0)20 7812 8399
www.bdp.com

BDP.

42 BEDFORD SQUARE

P22005698

FRONT AND REAR ELEVATIONS

MEWS HOUSE

CURRENT AS BUILT CONDITION

1:50

12.2017

(26)AE102

A

THIRD FLOOR

SECOND FLOOR

MEZZANINE

FIRST FLOOR

GROUND FLOOR

BASEMENT FLOOR

SECOND FLOOR

FIRST FLOOR

GROUND FLOOR

BASEMENT FLOOR

SECTION G - G

AS PROPOSED

BUILDING DESIGN PARTNERSHIP LTD SHALL HAVE NO RESPONSIBILITY FOR ANY USE MADE OF THIS DOCUMENT OTHER THAN THAT FOR WHICH IT WAS PREPARED AND ISSUED.

ALL DIMENSIONS SHOULD BE CHECKED ON SITE.


DO NOT SCALE FROM THIS DRAWING.

ANY DRAWING ERRORS OR OMISSIONS SHOULD BE BROUGHT TO THE ATTENTION OF BUILDING DESIGN PARTNERSHIP LTD AT THE ADDRESS SHOWN.


Existing Fabric
As Proposed Fabric

C-LBC APPLICATION
B-LBC APPLICATION - DRAFT FOR COMMENTS
A-LBC APPLICATION - DRAFT FOR COMMENTS
L-LBC APPLICATION - DRAFT FOR COMMENTS

GW MB 14.12.2017
GW MB 08.12.2017
GW MB 01.12.2017
GW MB 22.11.2017

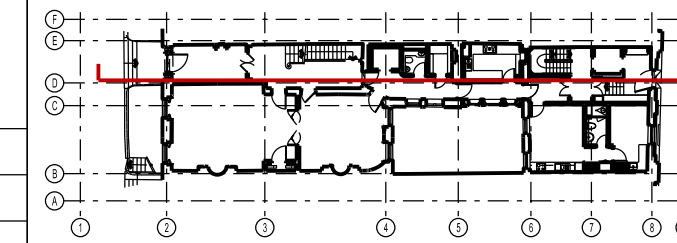


16 Greenhouse Yard Clerkenwell London, EC1V 4LJ United Kingdom T +44 (0)20 7812 8000 F +44 (0)20 7812 8599 www.bdp.com		PROJECT NO. P2005698 PROJECT TITLE PRINCIPAL HOUSE SECTION G - G AS PROPOSED DATE 11.2017 DRAWN BY (15)AS135 CHECKED BY C
--	--	--

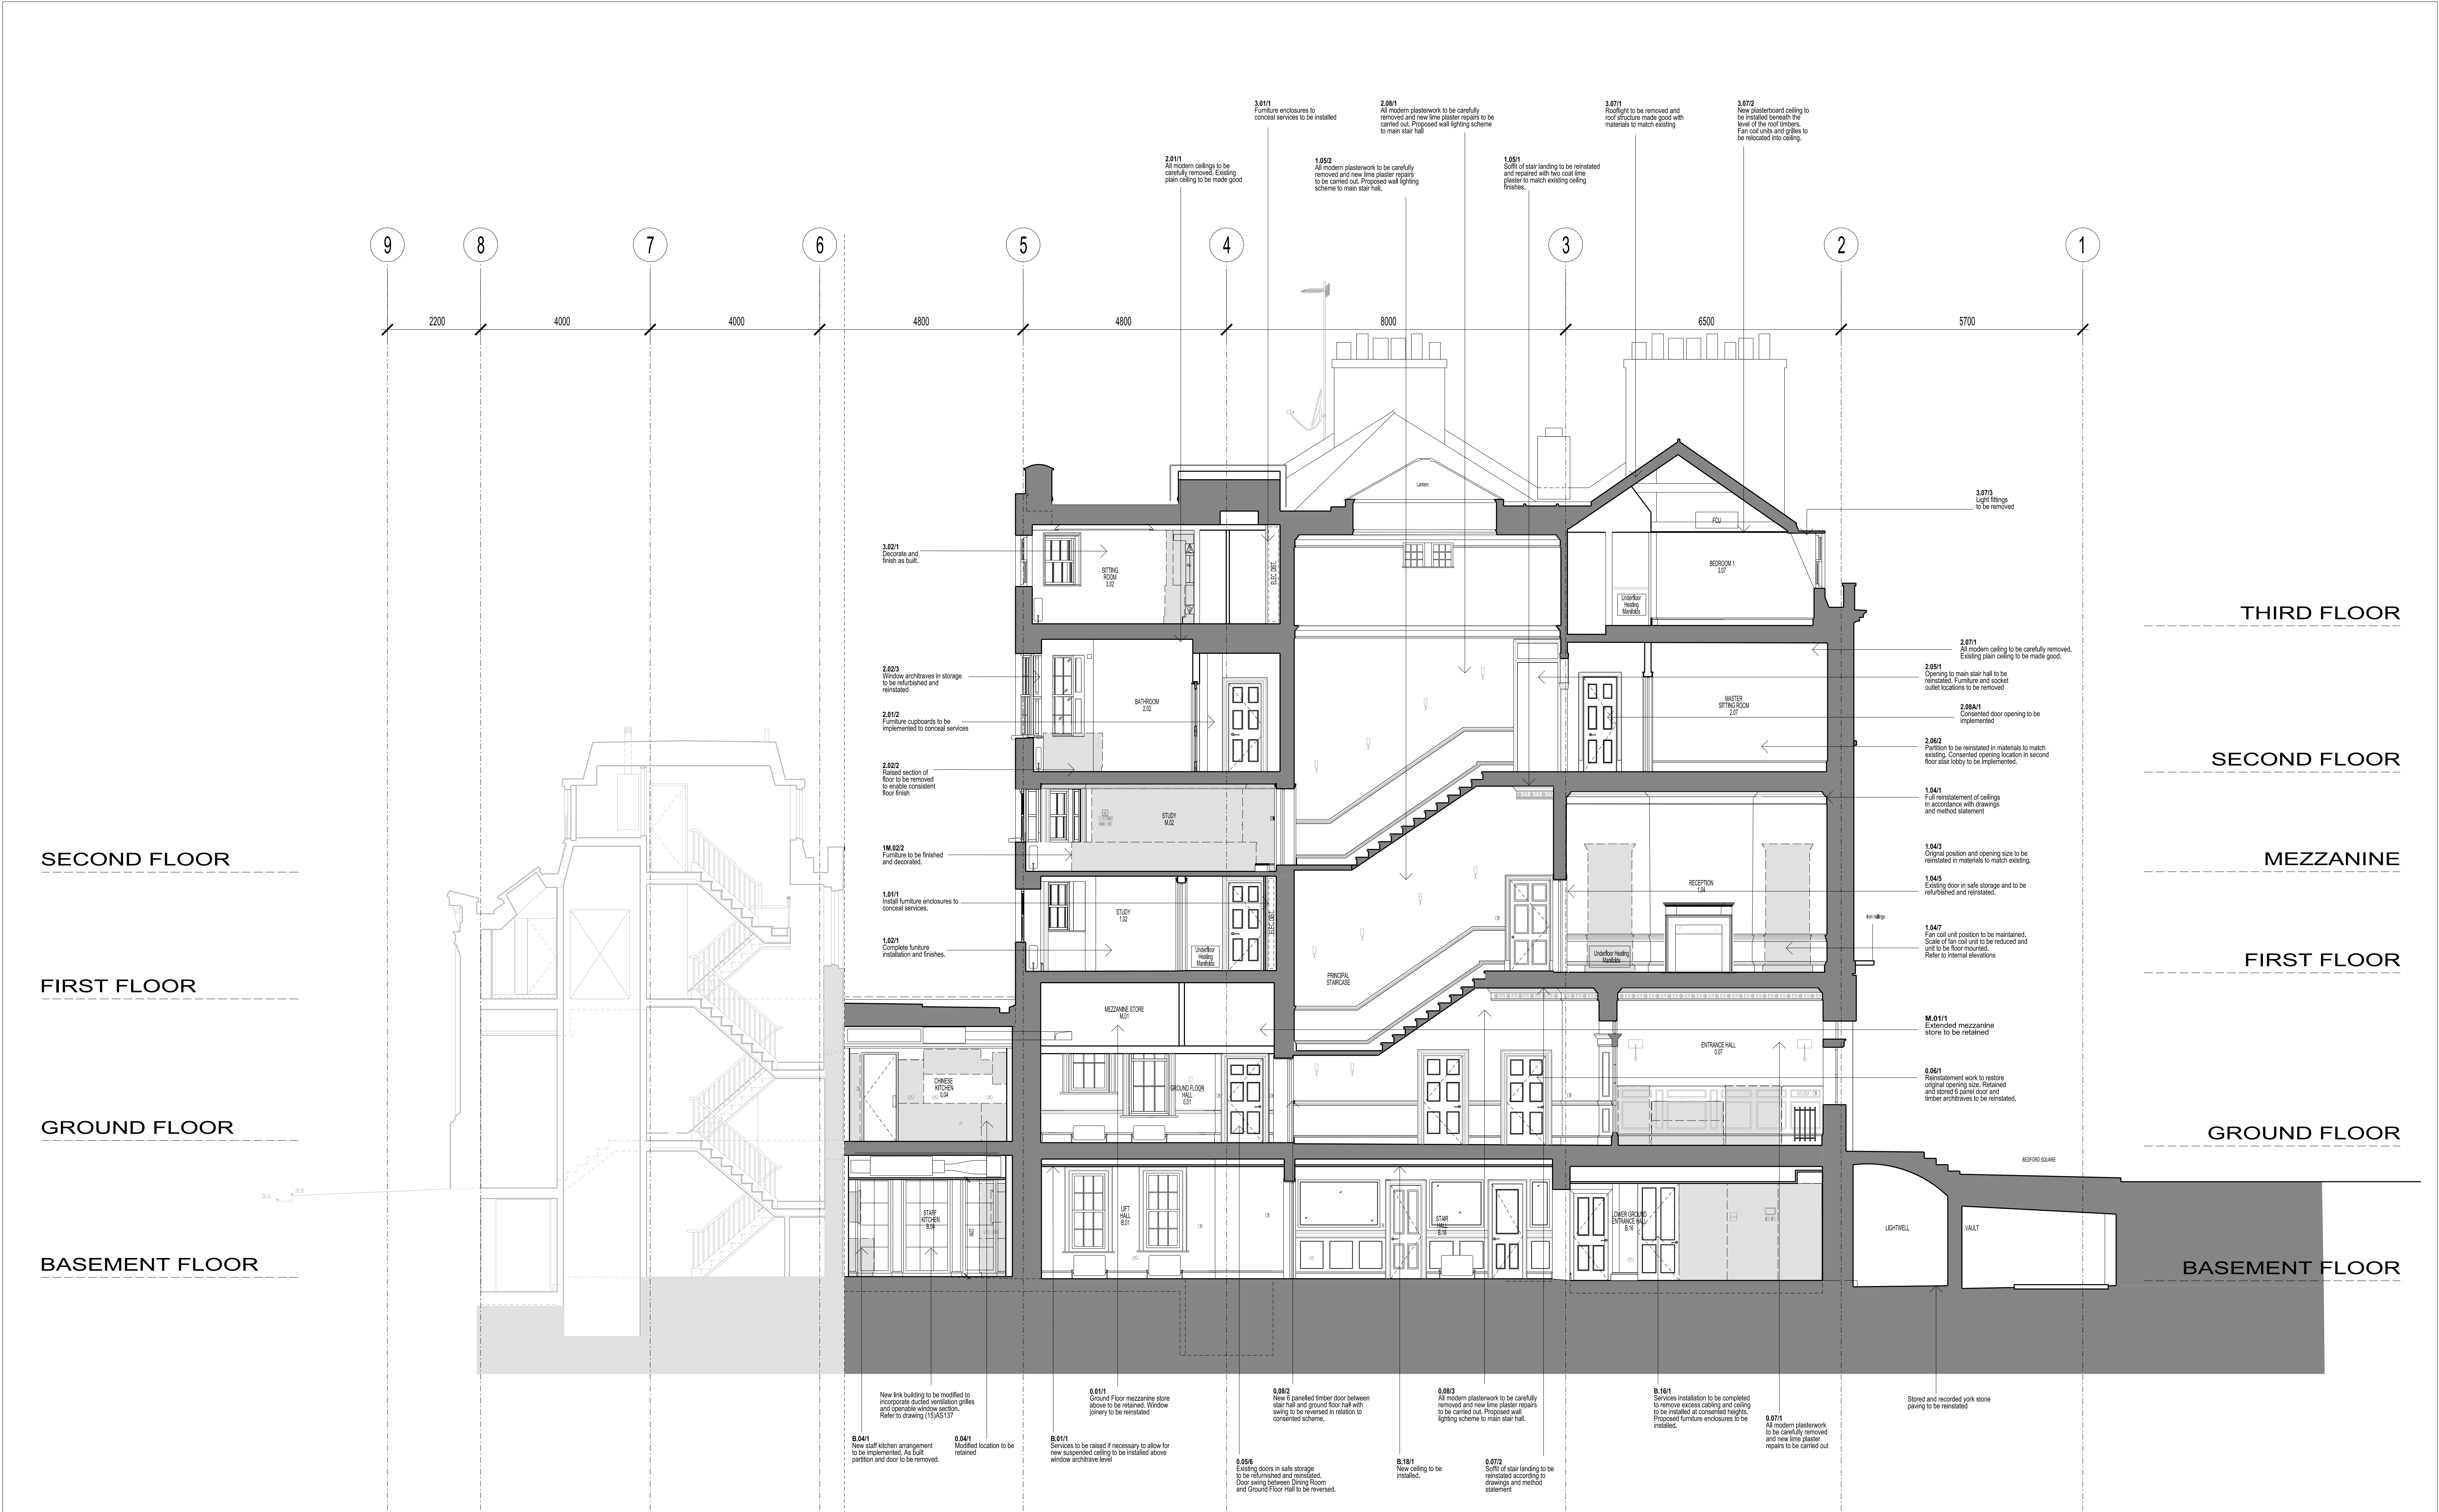

SECTION H - H

AS PROPOSED

BDP.

<div>BUILDING DESIGN PARTNERSHIP LTD SHALL HAVE NO RESPONSIBILITY FOR ANY USE MADE OF THIS DOCUMENT OTHER THAN FOR THAT WHICH IT WAS PREPARED AND ISSUED.</div> <div>ALL DIMENSIONS SHOULD BE CHECKED ON SITE.</div> <div>DO NOT SCALE FROM THIS DRAWING.</div> <div>ANY DRAWING ERRORS OR DIVERGENCES SHOULD BE BROUGHT TO THE ATTENTION OF BUILDING DESIGN PARTNERSHIP LTD AT THE ADDRESS SHOWN.</div> <div><div><div></div>Existing Fabric</div><div><div></div>As Proposed Fabric</div></div>										<div>42 BEDFORD SQUARE</div> <div>P2005698</div> <div>PRINCIPAL HOUSE</div> <div>SECTION H - H</div> <div>AS PROPOSED</div> <div>(15)AS136</div>									
<div>C-UBC APPLICATION</div> <div>B-UBC APPLICATION - DRAFT FOR COMMENTS</div> <div>A-UBC APPLICATION - DRAFT FOR COMMENTS</div> <div>LBC APPLICATION - DRAFT FOR COMMENTS</div>										<div>GN MB 14.12.2017</div> <div>GN MB 08.12.2017</div> <div>GN MB 01.12.2017</div> <div>GN MB 22.12.2017</div>									
<div>16 Broadhouse Yard</div> <div>Chislehurst</div> <div>London, ECTY 4L2</div> <div>United Kingdom</div> <div>T +44 (0)20 7812 8000</div> <div>F +44 (0)20 7812 8399</div> <div>www.bdp.com</div>										<div></div> <div>1:50</div> <div>11.2017</div> <div>C</div>									

THIRD FLOOR

SECOND FLOOR

MEZZANINE

FIRST FLOOR

GROUND FLOOR

BASEMENT FLOOR

SECOND FLOOR

FIRST FLOOR

GROUND FLOOR

BASEMENT FLOOR

SECTION I - I

CURRENT AS BUILT CONDITION

BUILDING DESIGN PARTNERSHIP LTD SHALL HAVE NO RESPONSIBILITY FOR ANY USE MADE OF THIS DOCUMENT OTHER THAN FOR THAT WHICH IT WAS PREPARED AND ISSUED.

ALL DIMENSIONS SHOULD BE CHECKED ON SITE.

DO NOT SCALE FROM THIS DRAWING.

ANY DRAWING ERRORS OR DISCREPANCIES SHOULD BE BROUGHT TO THE ATTENTION OF BUILDING DESIGN PARTNERSHIP LTD AT THE ADDRESS SHOWN.

Existing Fabric
As Built Fabric (to be removed)
As Built Fabric (to be retained)
Damaged Plaster (to be repaired)

REVISION

DATE

DESCRIPTION

REVISION

DATE

DESCRIPTION


REVISION

DATE

DESCRIPTION

REVISION

DATE

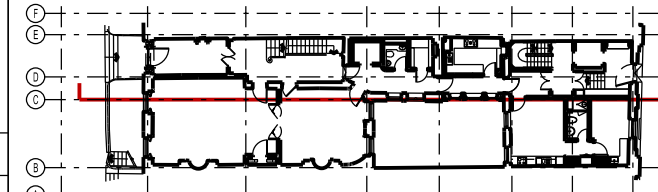

BDP.

42 BEDFORD SQUARE

P2005698

PRINCIPAL HOUSE

SECTION I - I

CURRENT AS BUILT CONDITION

(26)AS137

1:50



11.2017

C

16 Greenhouse Yard
Clarendon
London, EC1V 4LJ
United Kingdom
T +44 (0)20 7812 8000
F +44 (0)20 7812 8399
www.bdp.com




CURRENT AS BUILT CONDITION

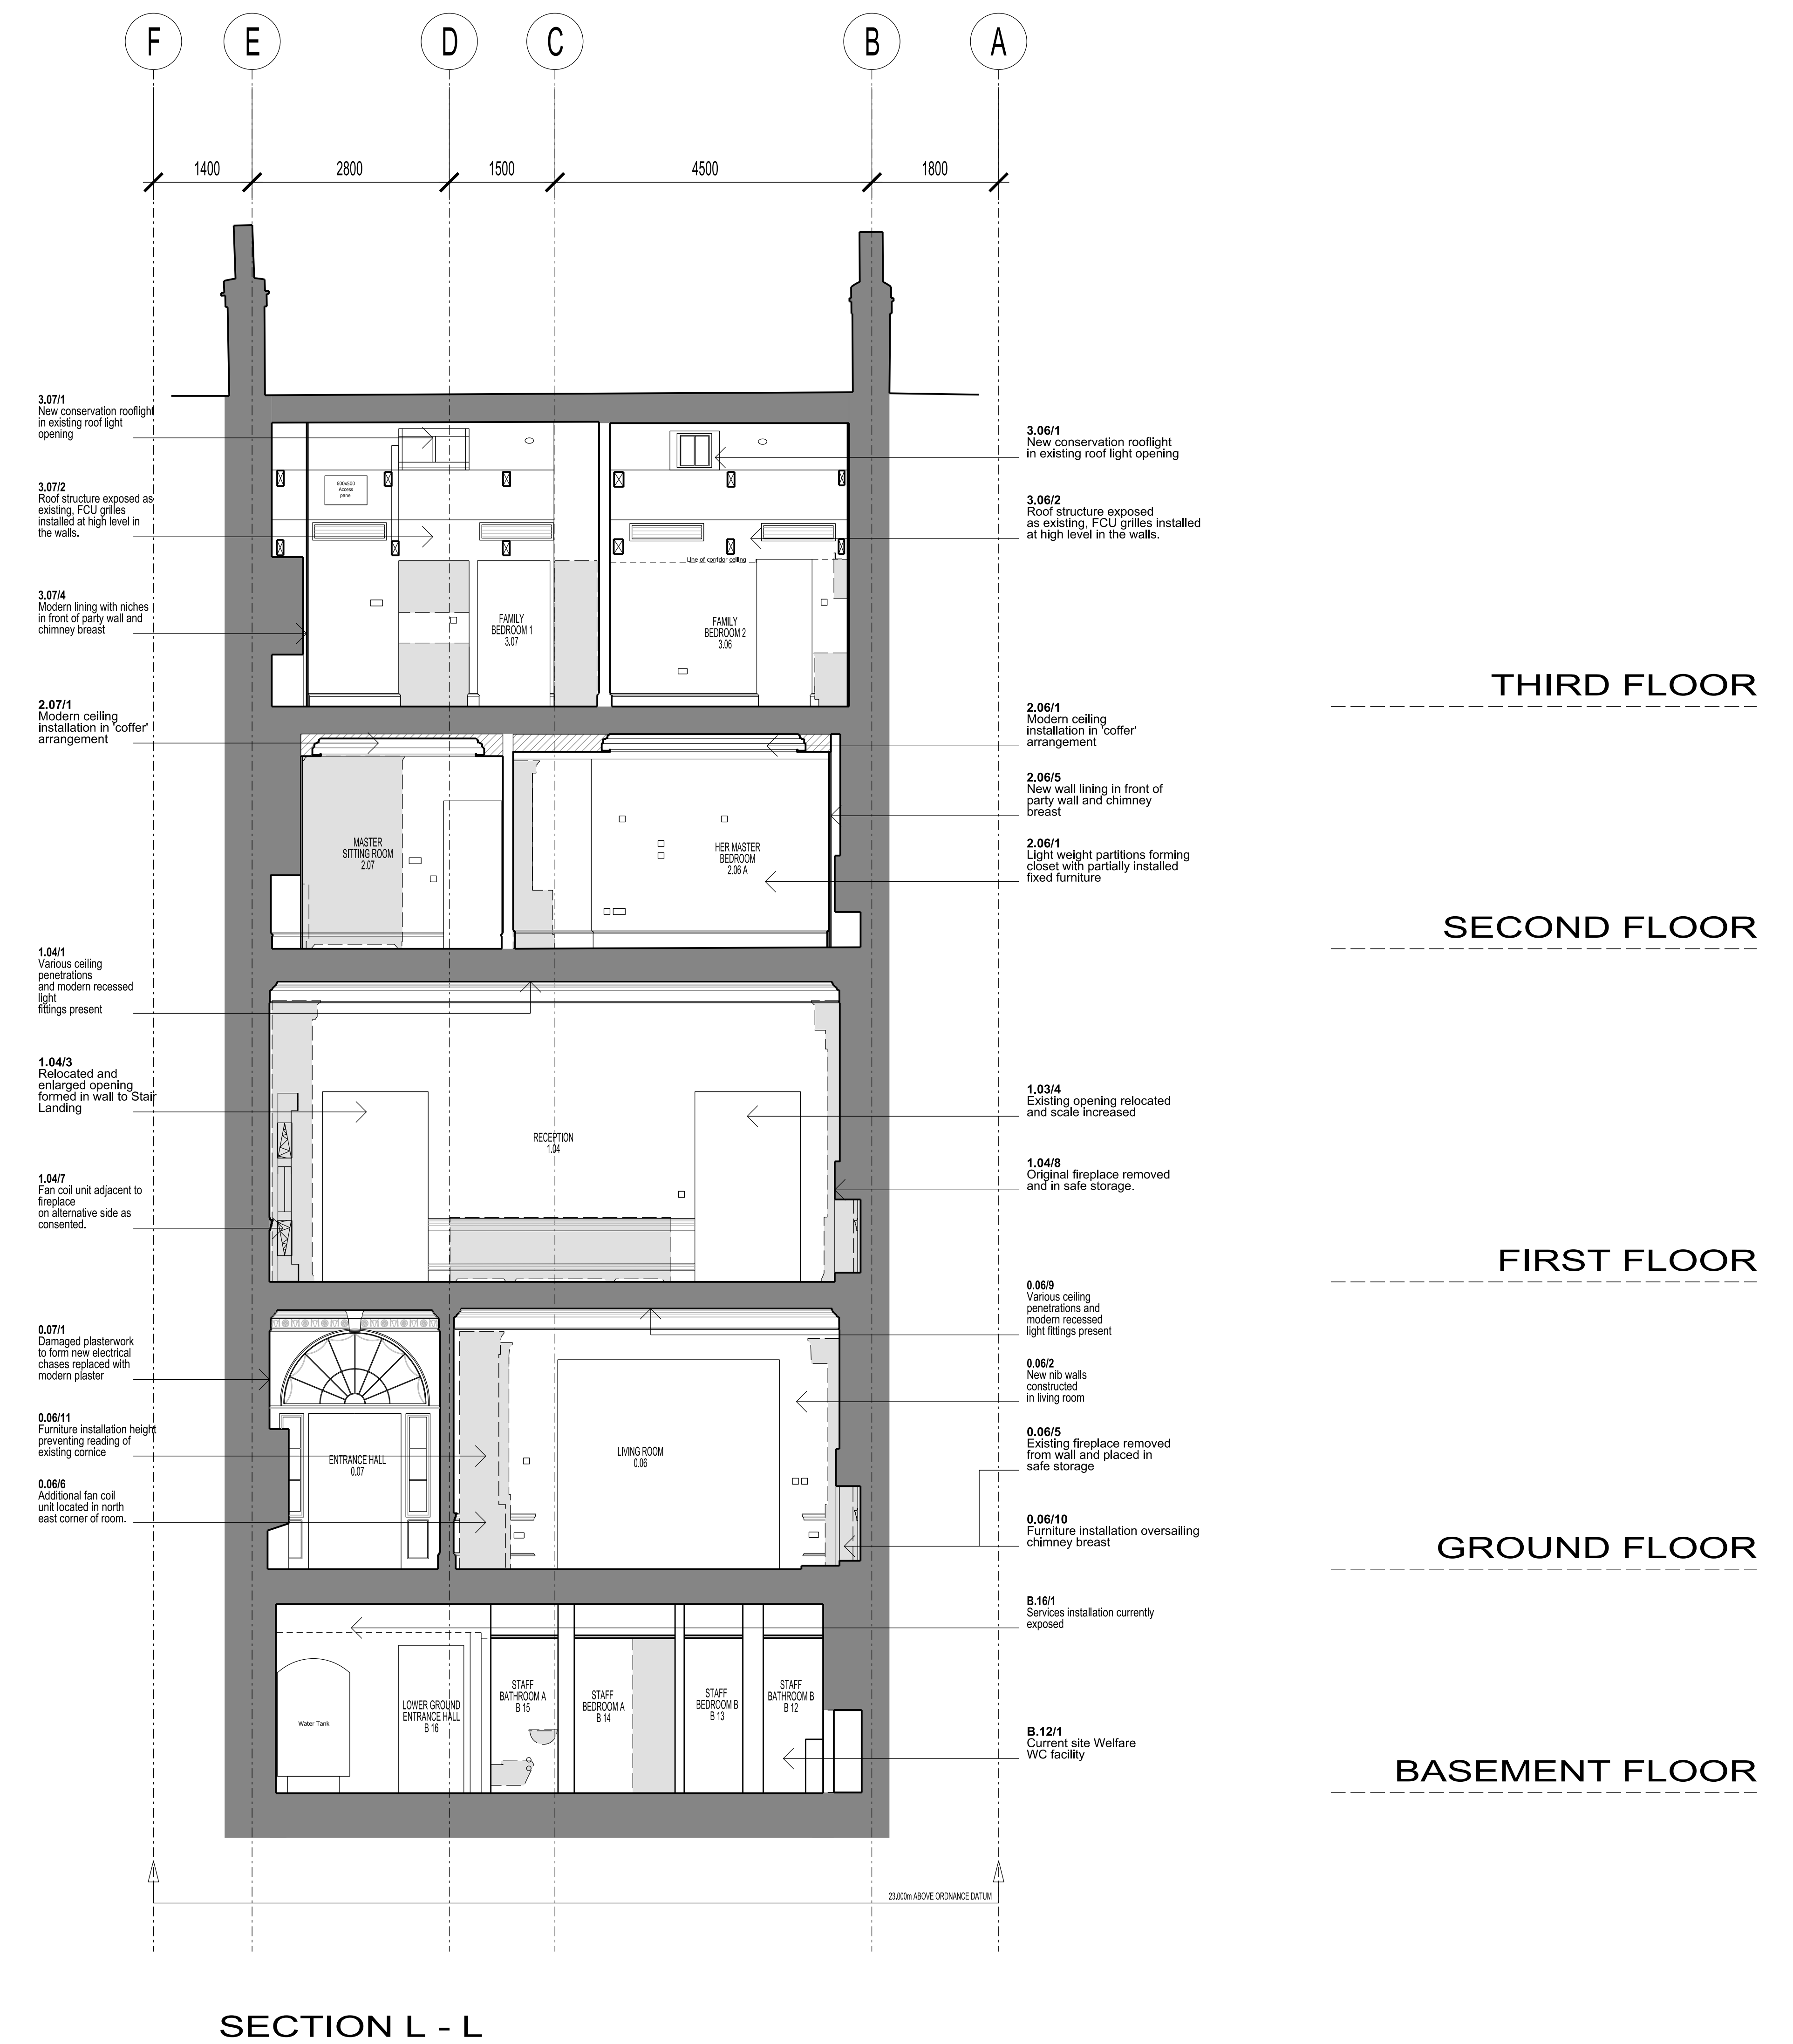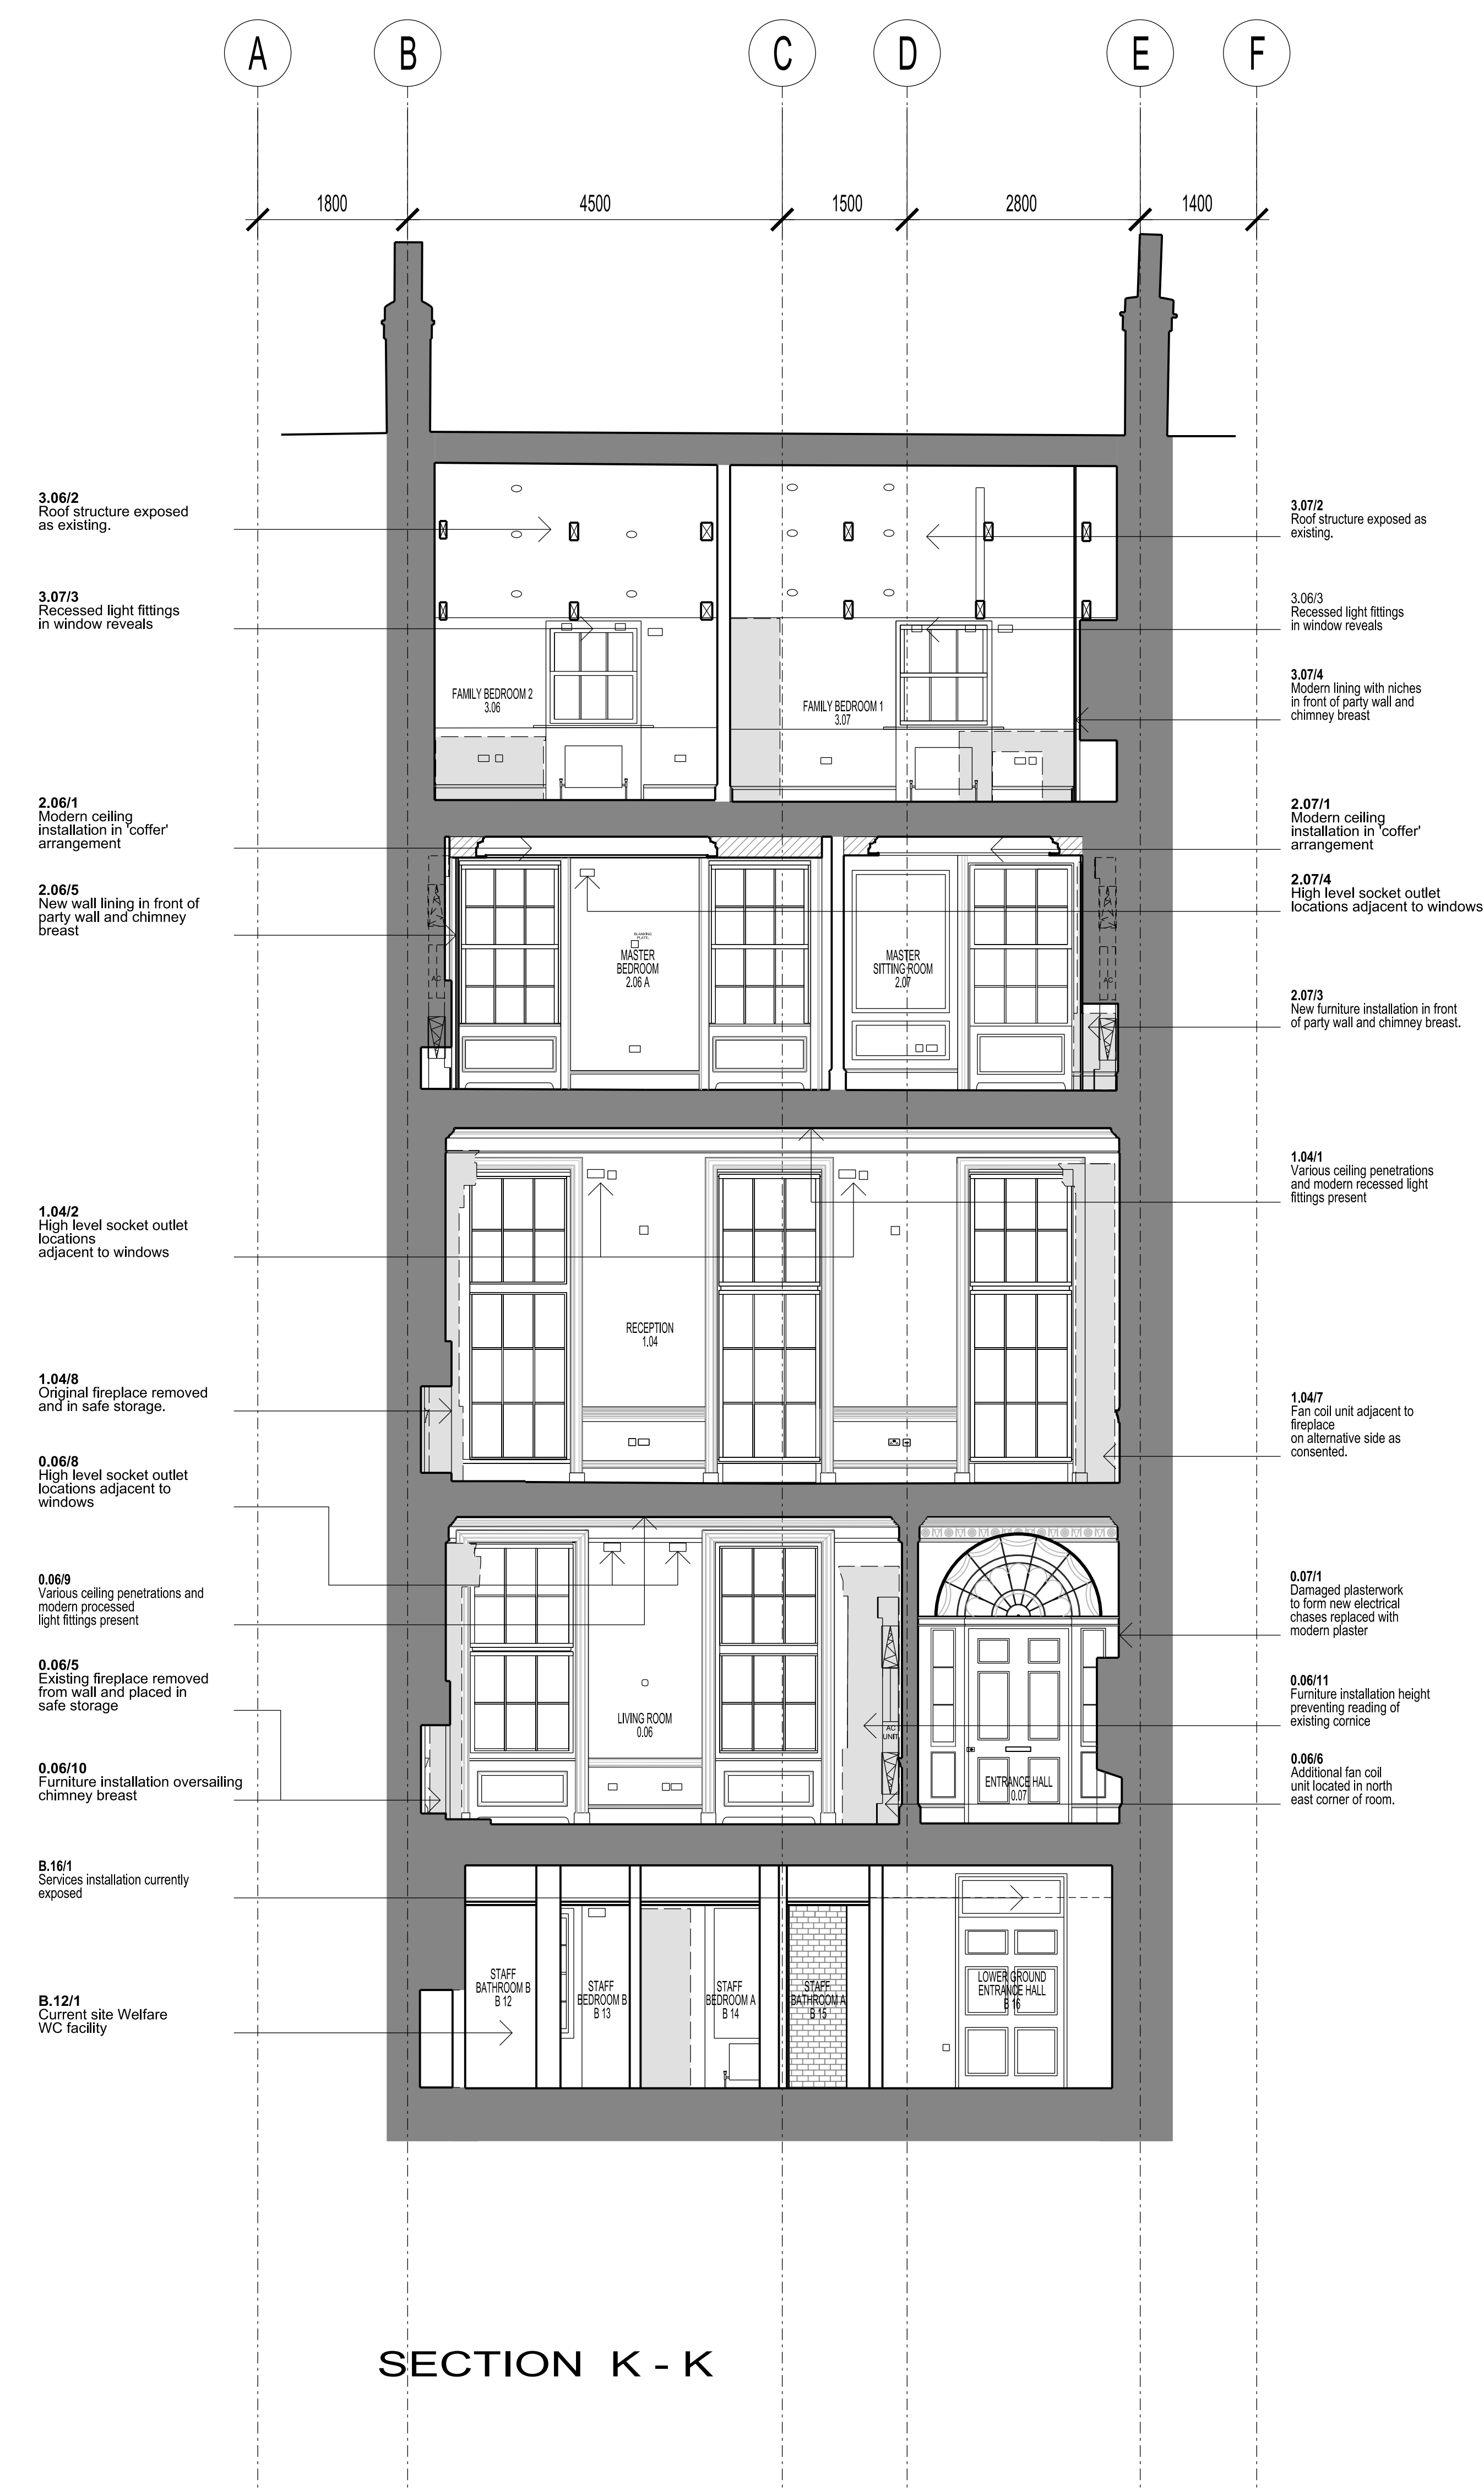


CURRENT AS BUILT CONDITION


<p>BUILDING DESIGN PARTNERSHIP LTD SHALL HAVE NO RESPONSIBILITY FOR ANY USE/ABUSE OF THIS DOCUMENT OTHER THAN FOR THAT WHICH IT WAS PREPARED AND ISSUED.</p> <p>ALL DIMENSIONS SHOULD BE CHECKED ON SITE.</p> <p>DO NOT SCALE FROM THE DRAWING.</p> <p>ANY DRAWING ERRORS OR DISCREPANCIES SHOULD BE BROUGHT TO THE ATTENTION OF BUILDING DESIGN PARTNERSHIP LTD AT THE ADDRESS SHOWN.</p>		<p>Existing Fabric</p> <p>As Built Fabric (to be removed)</p> <p>As Built Fabric (to be retained)</p> <p>Damaged Plaster (to be repaired)</p>		<p>C-LOC APPLICATION MIN MB 14.12.2017</p> <p>B-LOC APPLICATION - DRAFT FOR COMMENTS MIN MB 18.12.2017</p> <p>A-LOC APPLICATION - DRAFT FOR COMMENTS MIN MB 01.12.2017</p> <p>- LOC APPLICATION - DRAFT FOR COMMENTS MIN MB 22.11.2017</p>				<p>PROJECT SITE</p> <p>15 Breakhouse Yard Clarendon Rd London, EC1V 4LJ United Kingdom</p> <p>T +44 (0)20 7812 8000 F +44 (0)20 7812 8099 www.bdp.com</p>		<p>BDP.</p> <p>42 BEDFORD SQUARE</p> <p>P2005698</p> <p>PRINCIPAL HOUSE SECTIONS K - K AND L - L CURRENT AS BUILT CONDITION</p> <p>1:50 DATE 11.12.17</p> <p>(26)AS139 C</p>	
--	--	---	--	--	--	--	--	---	--	---	--

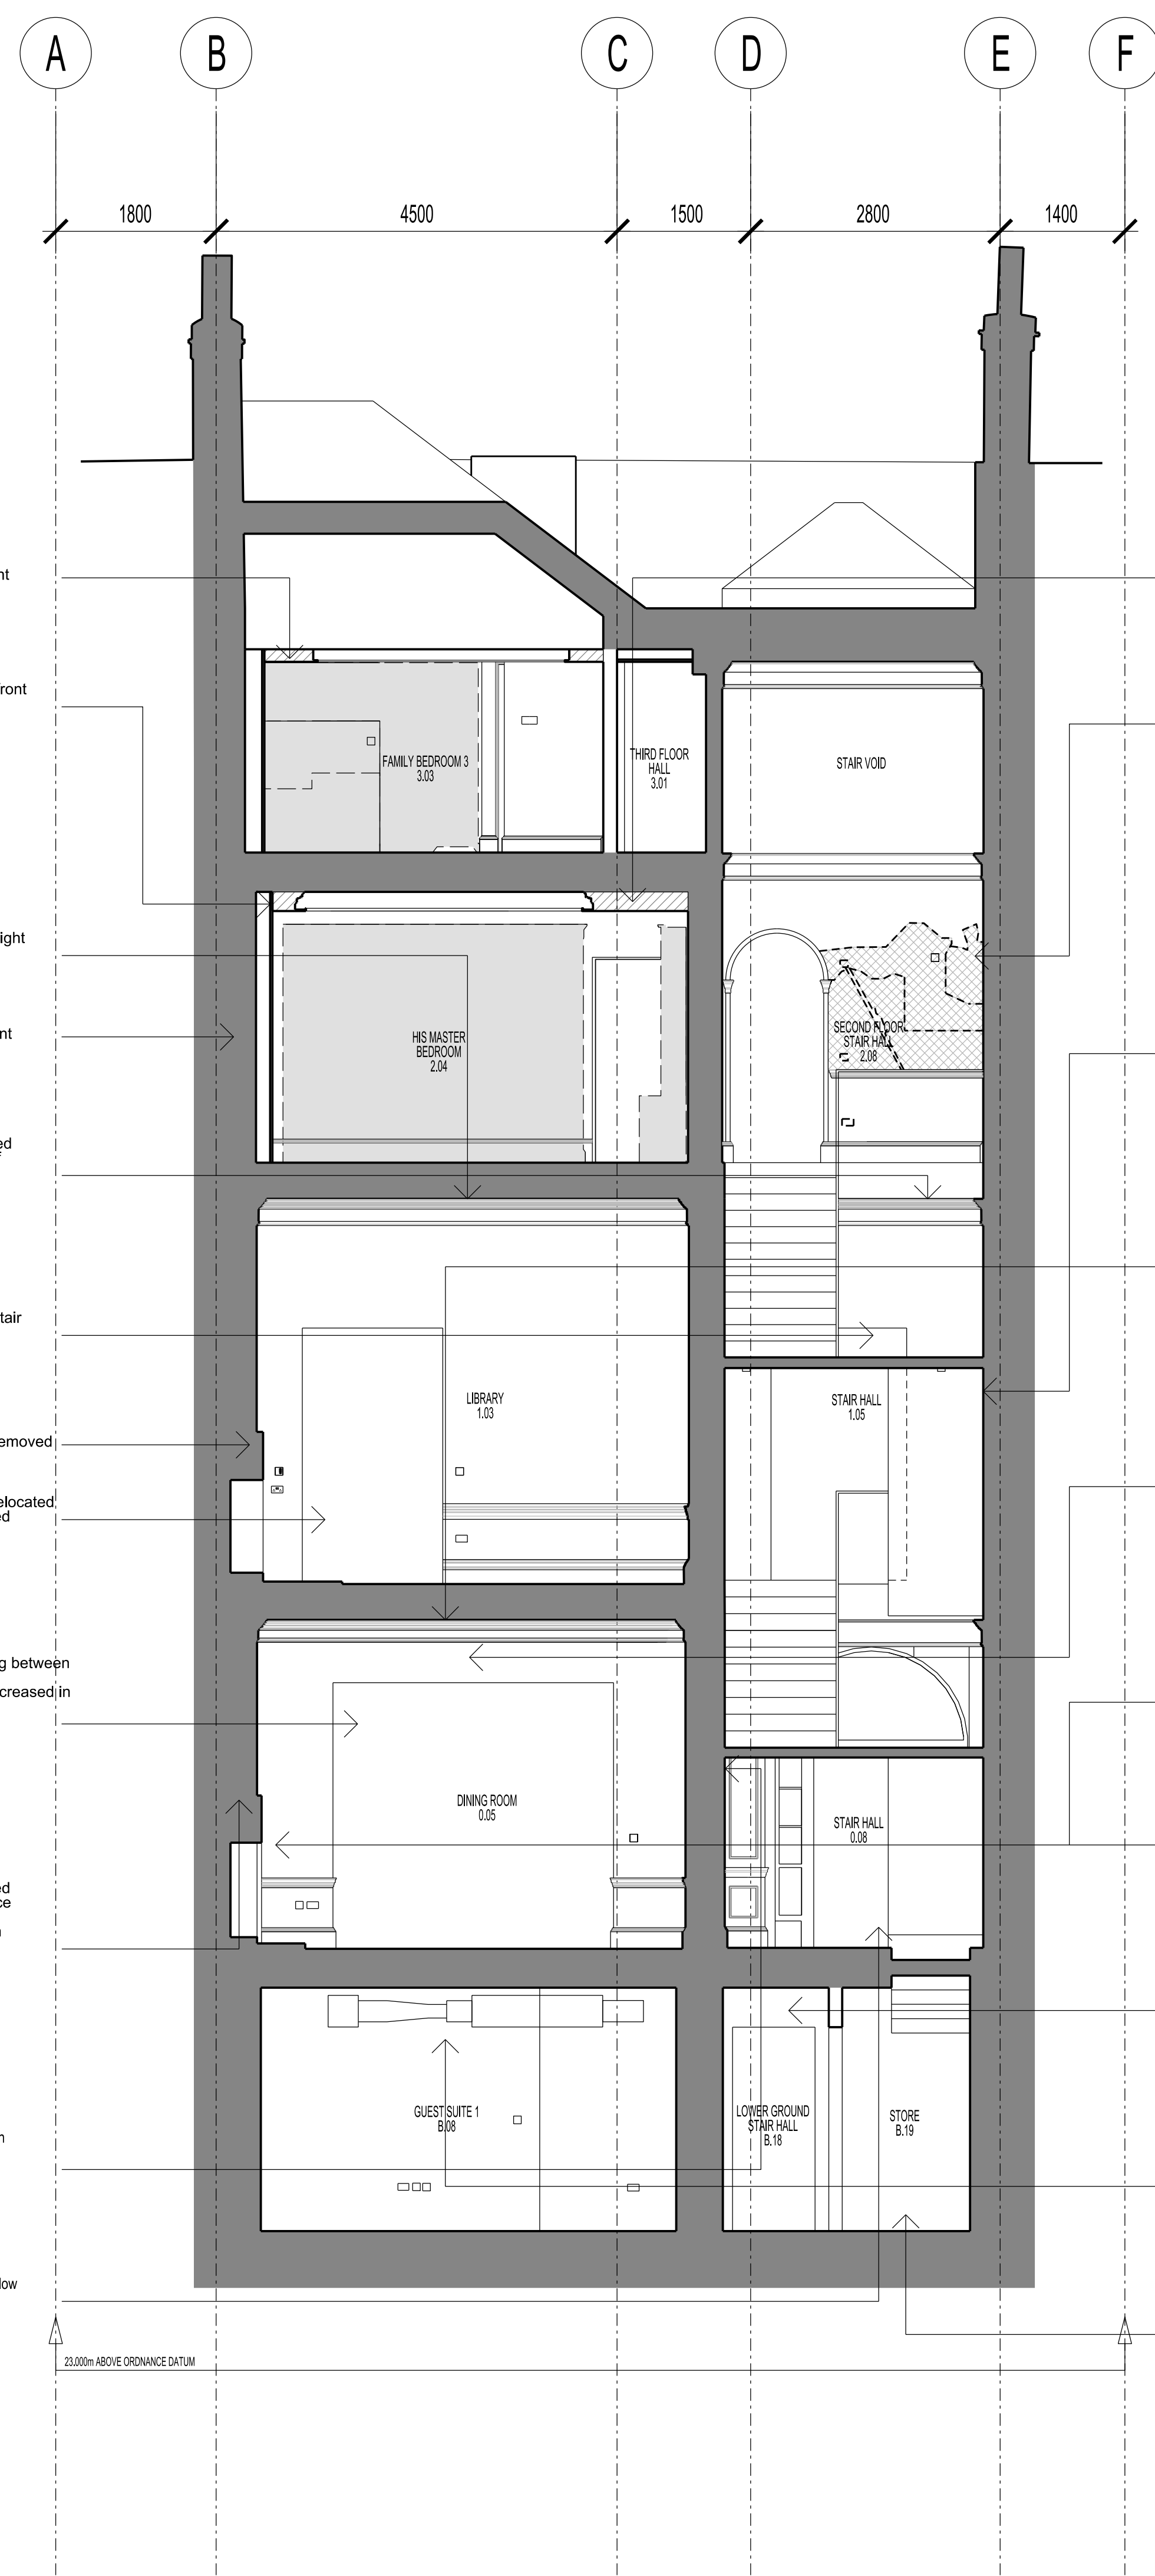

SECTION M - M

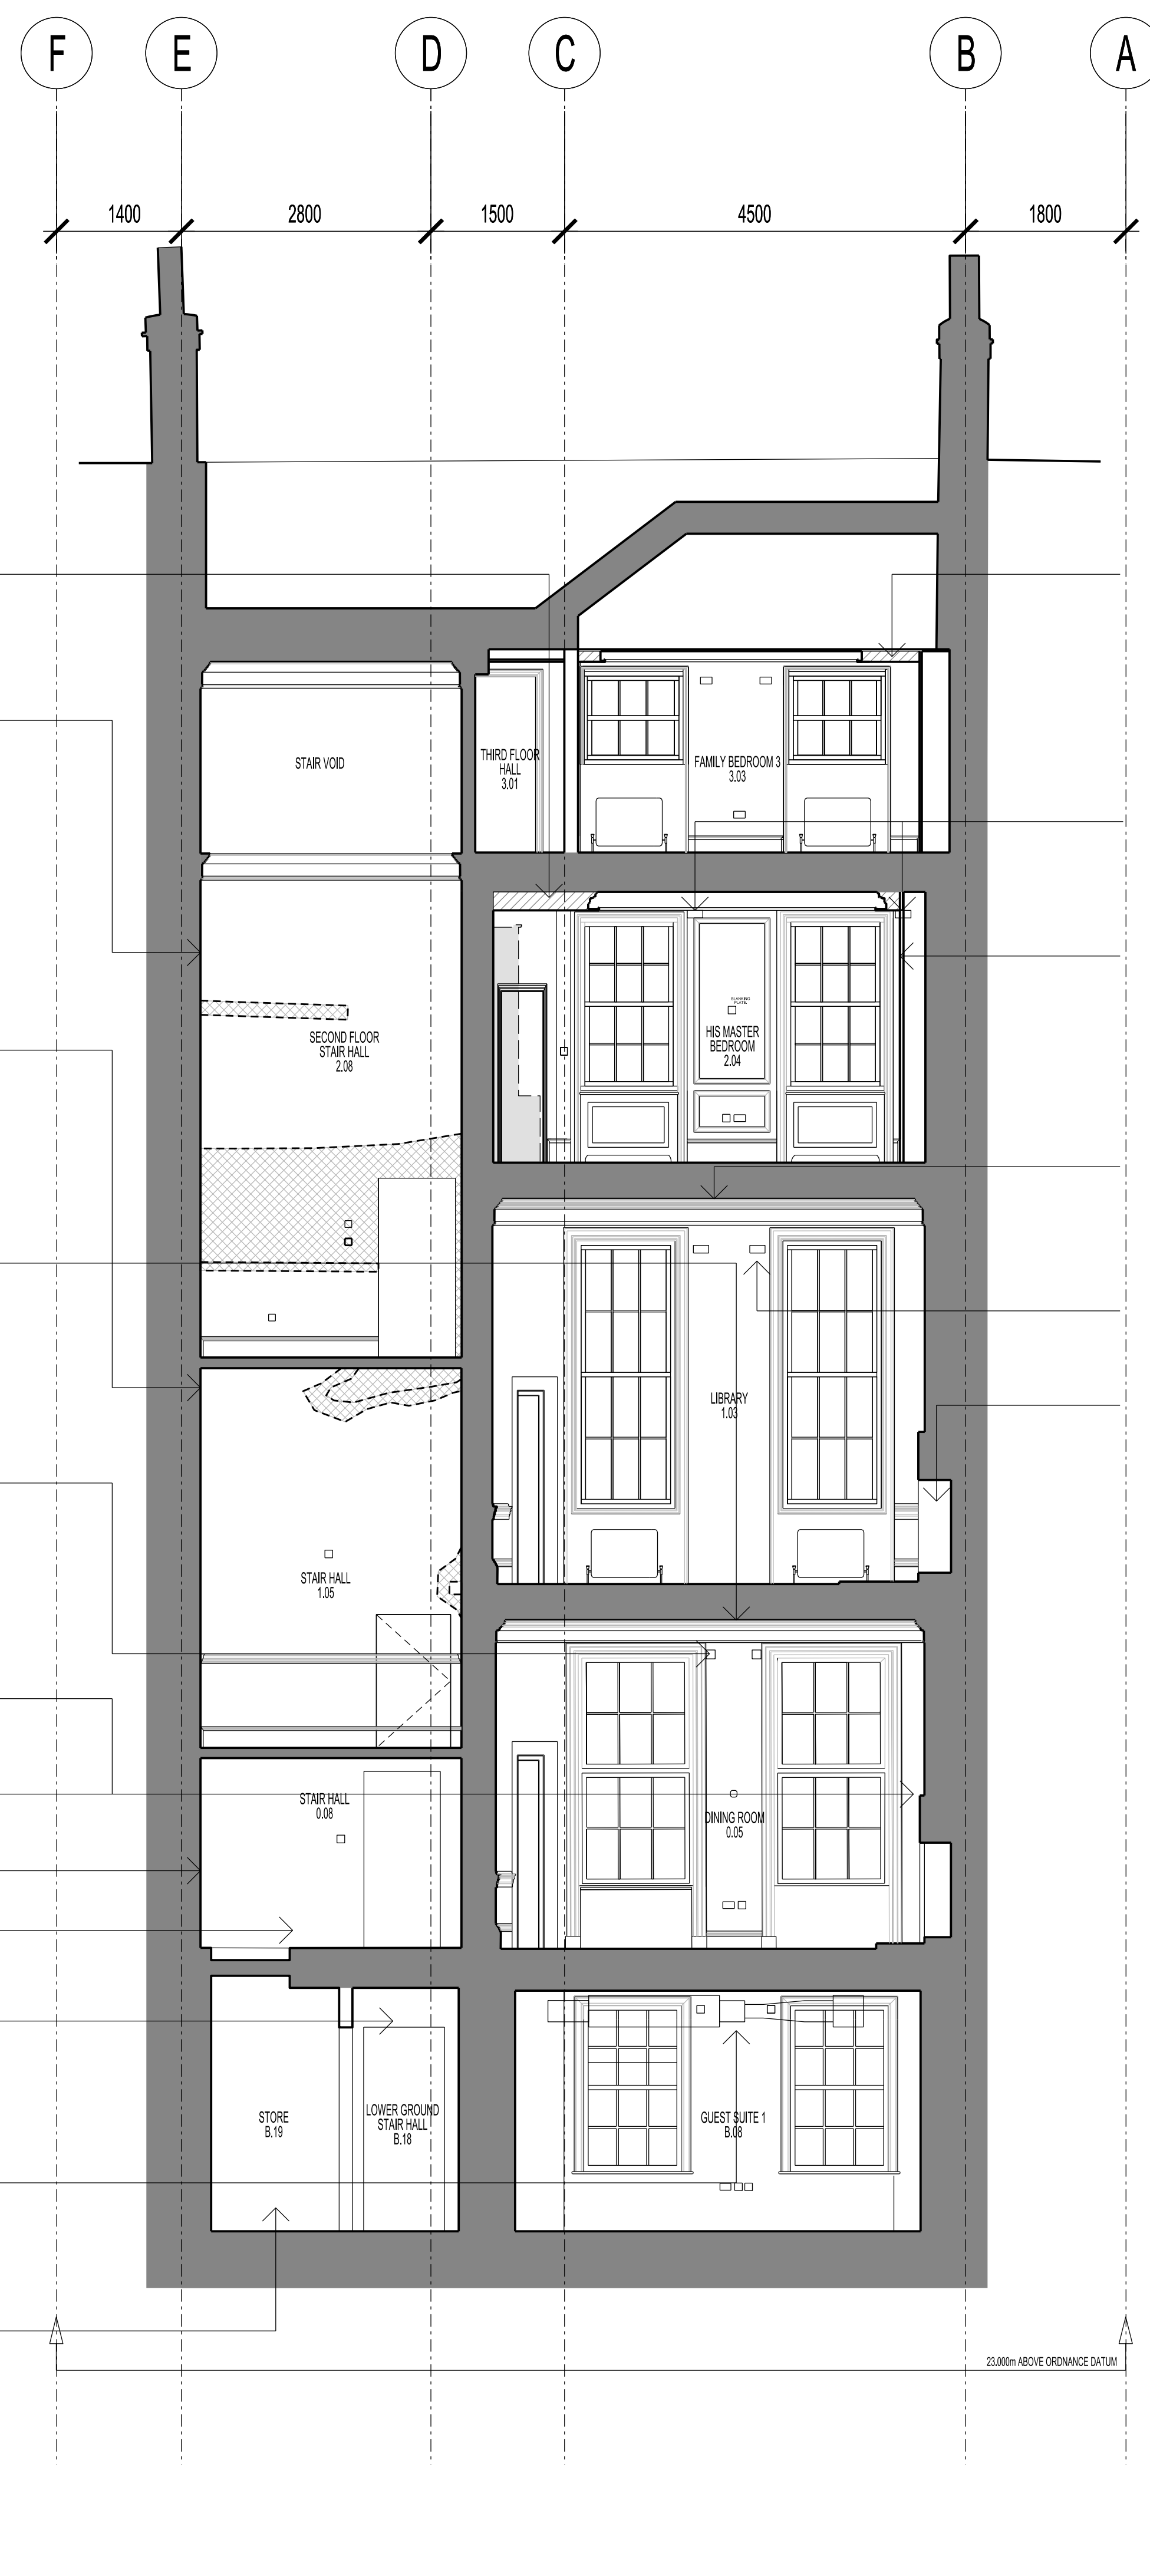


SECTION N - N

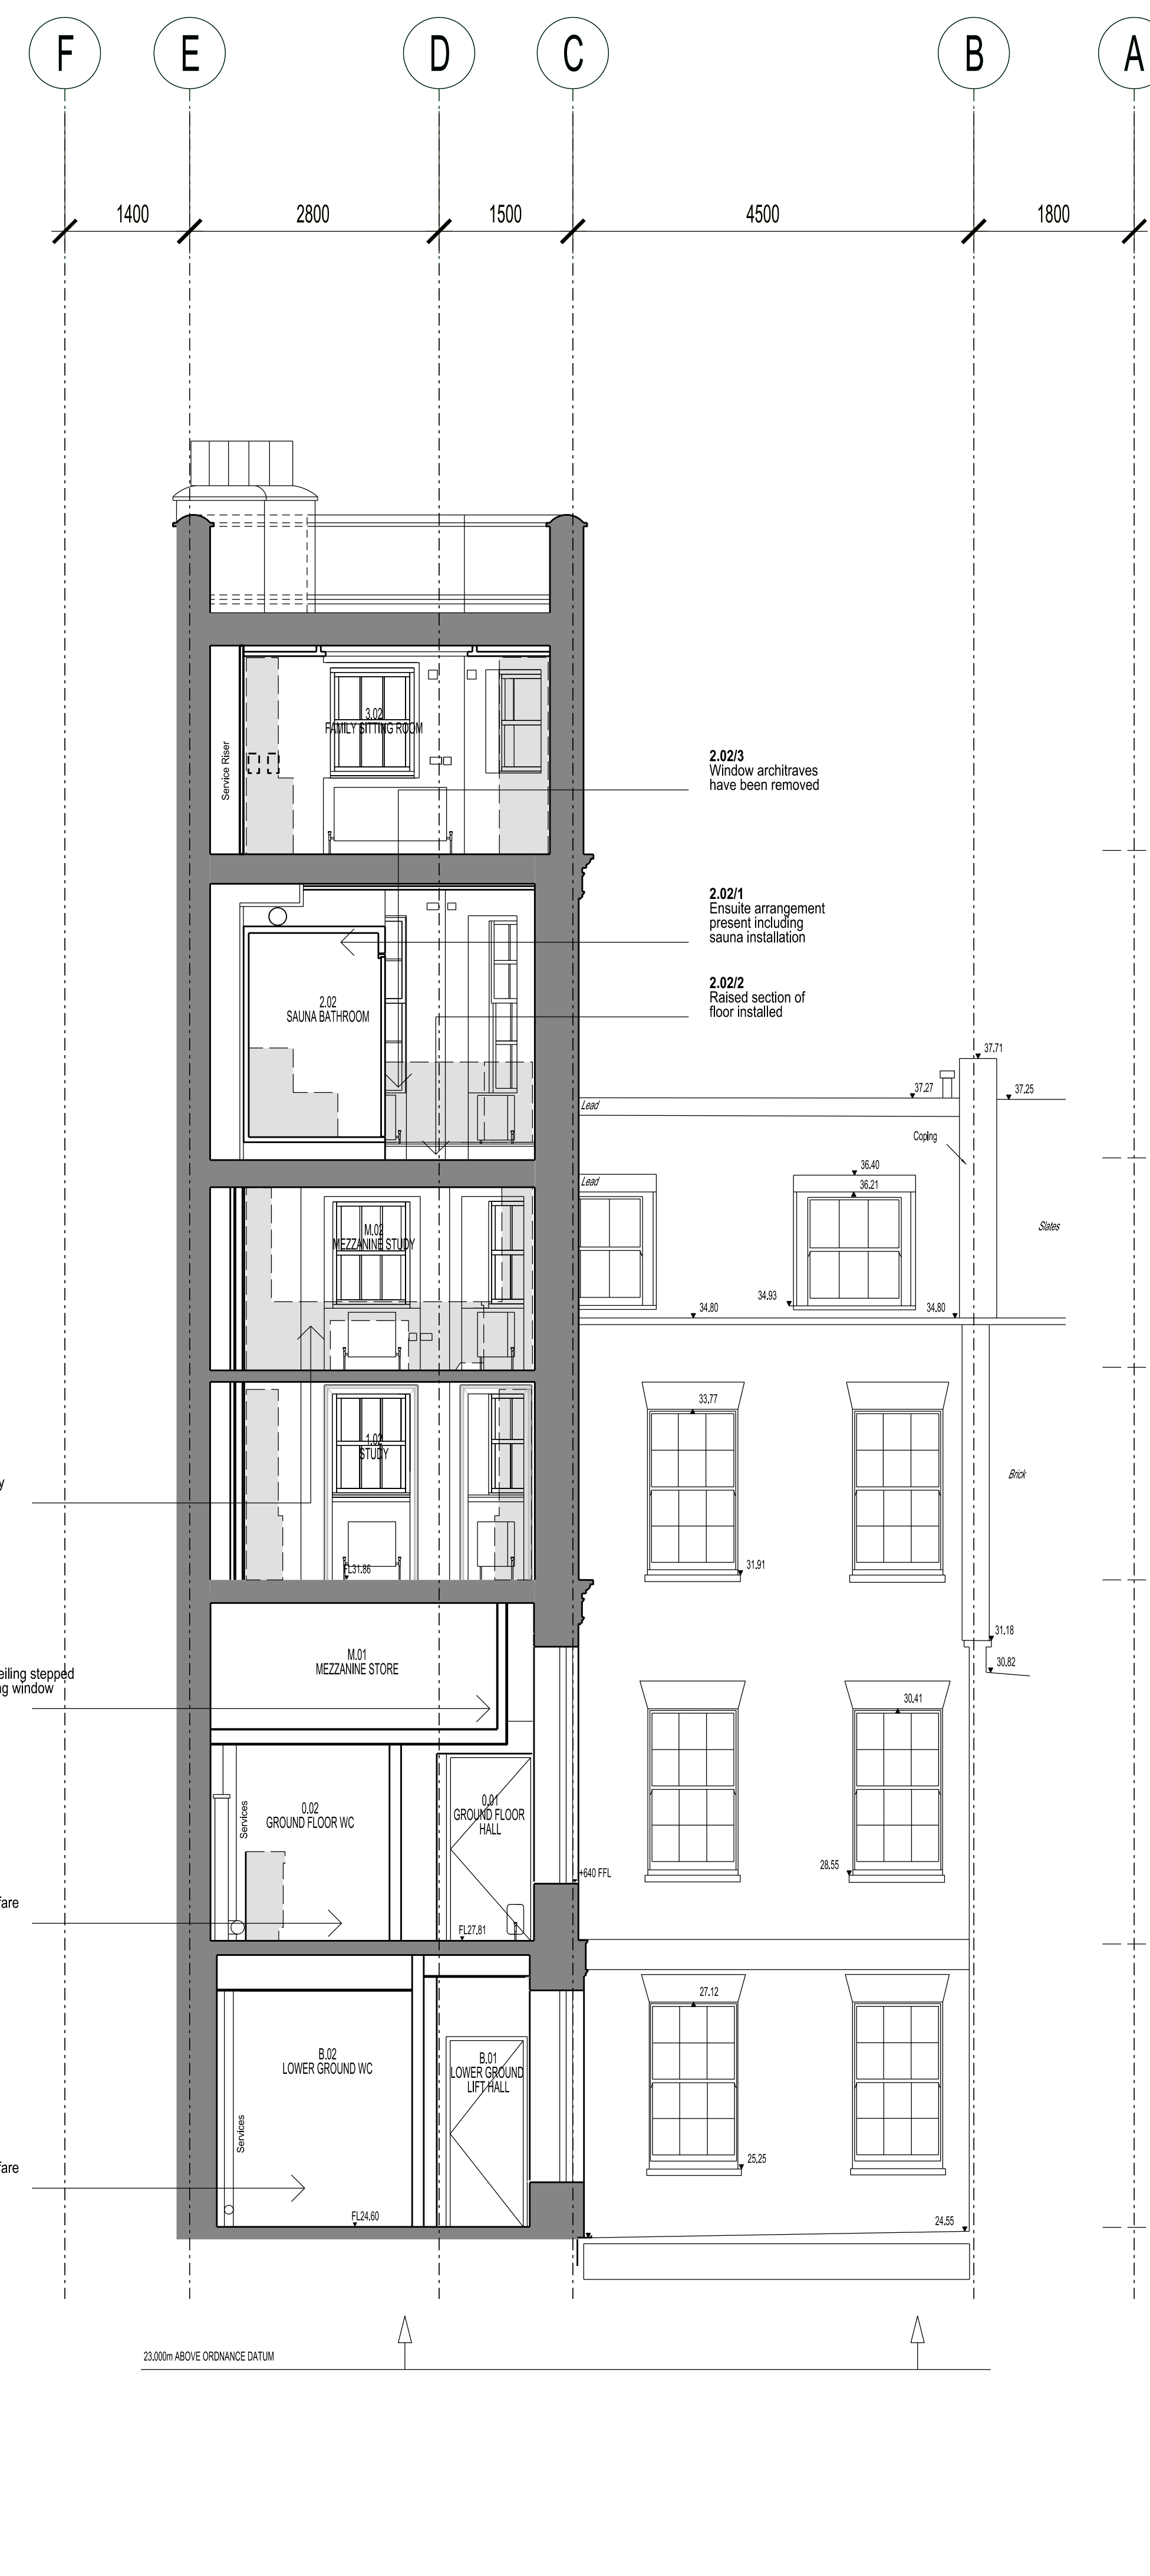





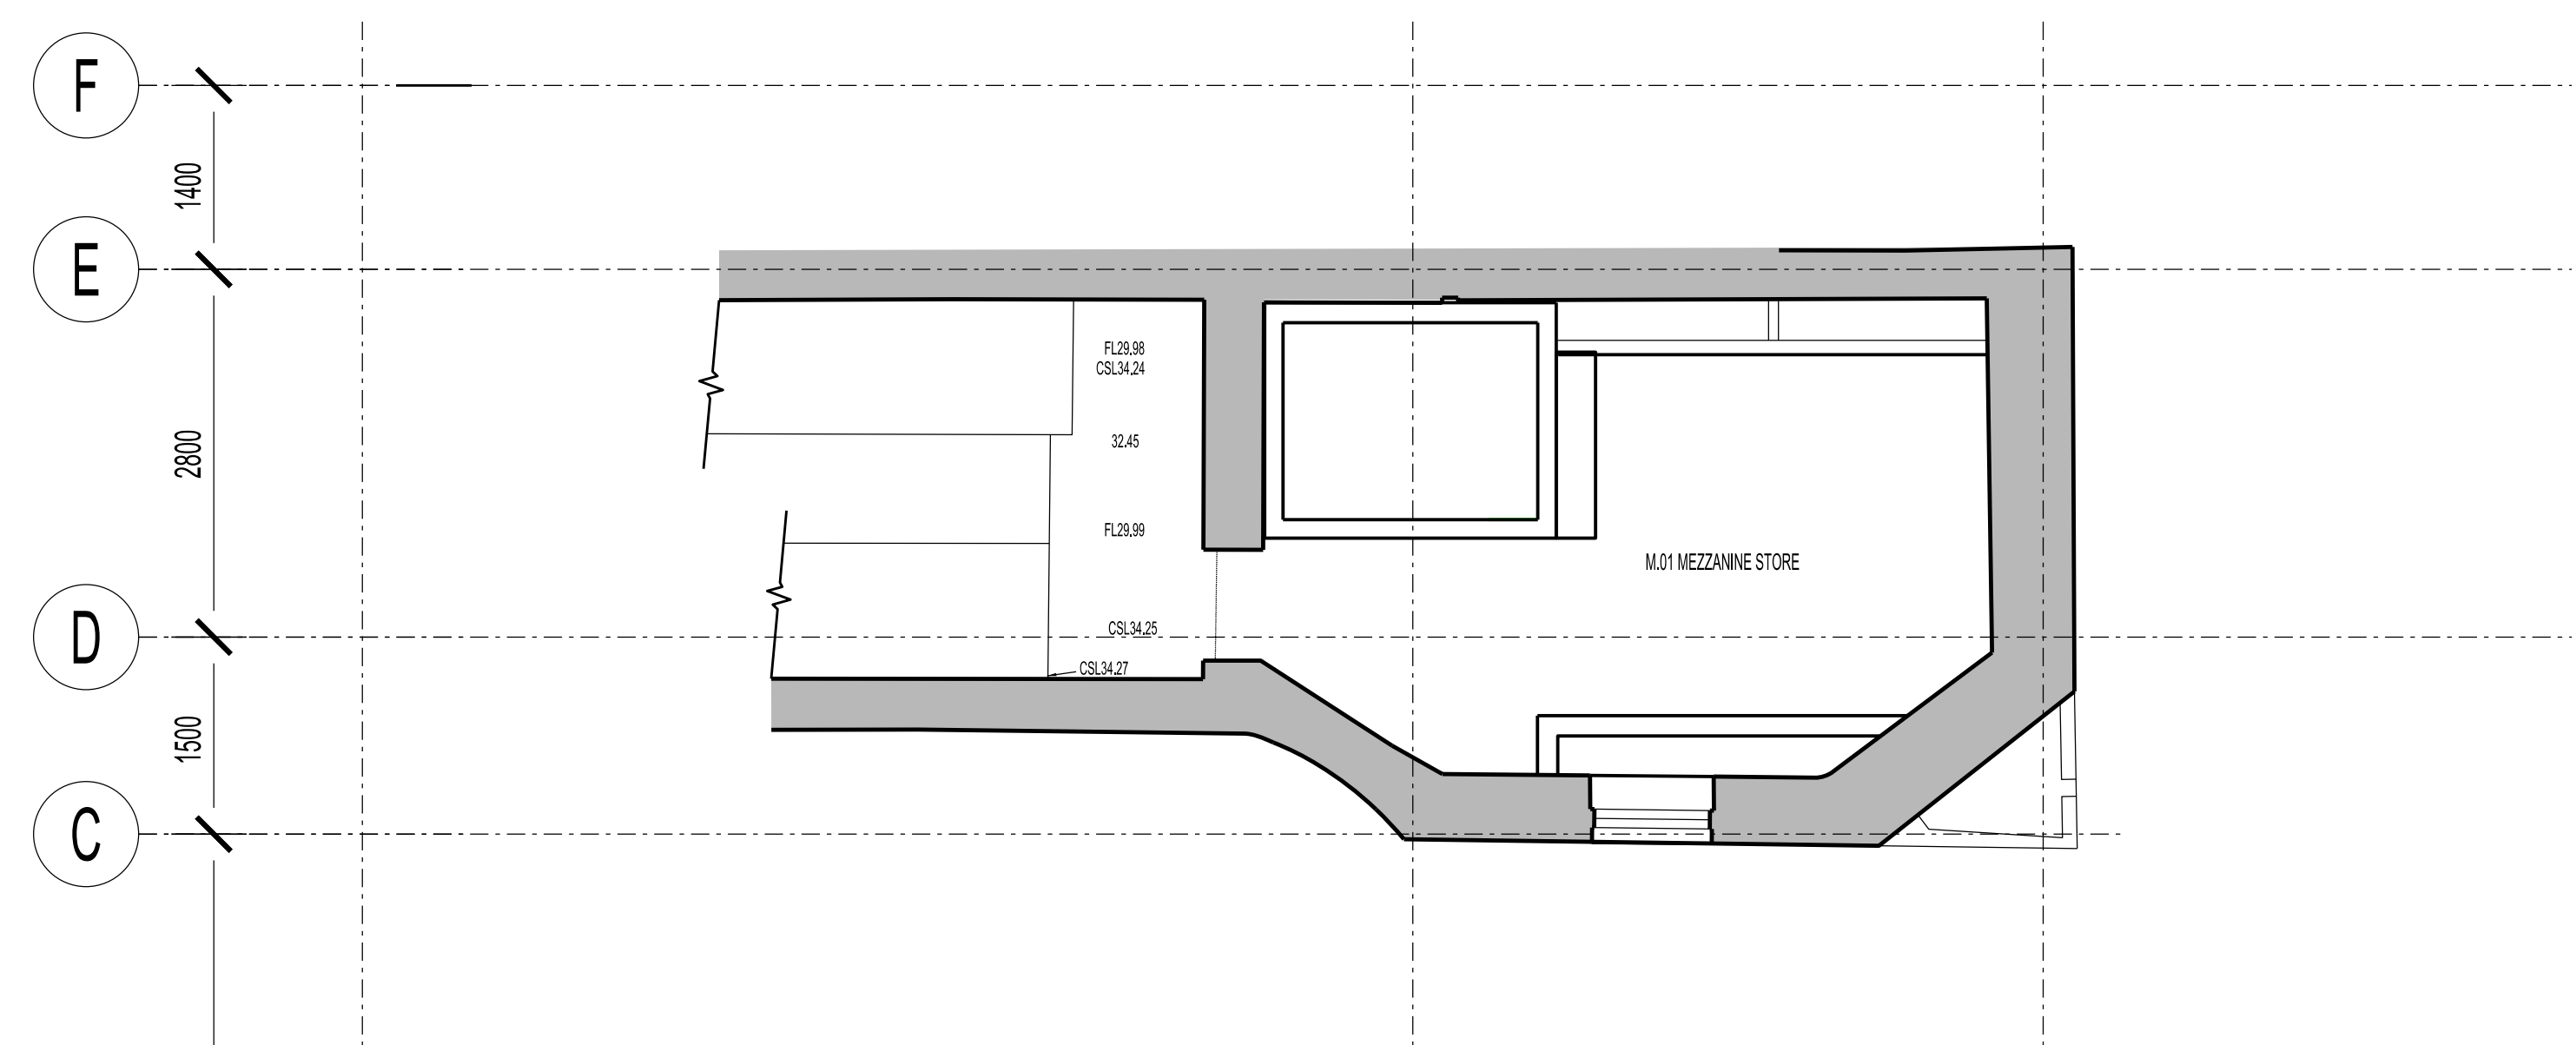


SECTION O - O

CURRENT AS BUILT CONDITION




0	1	2	3	4	5

 Ceiling Spotlight  Unknown Electrical Feed
 Aspirator
 Smoke Detector
 Strip Light
 Ceiling Pendant
 Heat Detector

42 BEDFORD SQUARE


PROJECT NUMBER P2005698		SCALE @ 50'
DRAWING TITLE PRINCIPAL HOUSE GROUND FLOOR REFLECTED CEILING PLAN CURRENT AS BUILT CONDITION		DATE 12.2017
DRAWING NO. (26)AC122		REVISION B

B- LBC APPLICATION	GP	MB	14.12.2017
A- LBC APPLICATION - DRAFT FOR COMMENTS	GP	MB	08.12.2017
- LBC APPLICATION - DRAFT FOR COMMENTS	GP	MB	01.12.2017

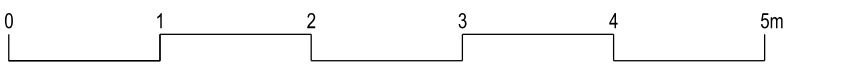

BDP.

[illegible]

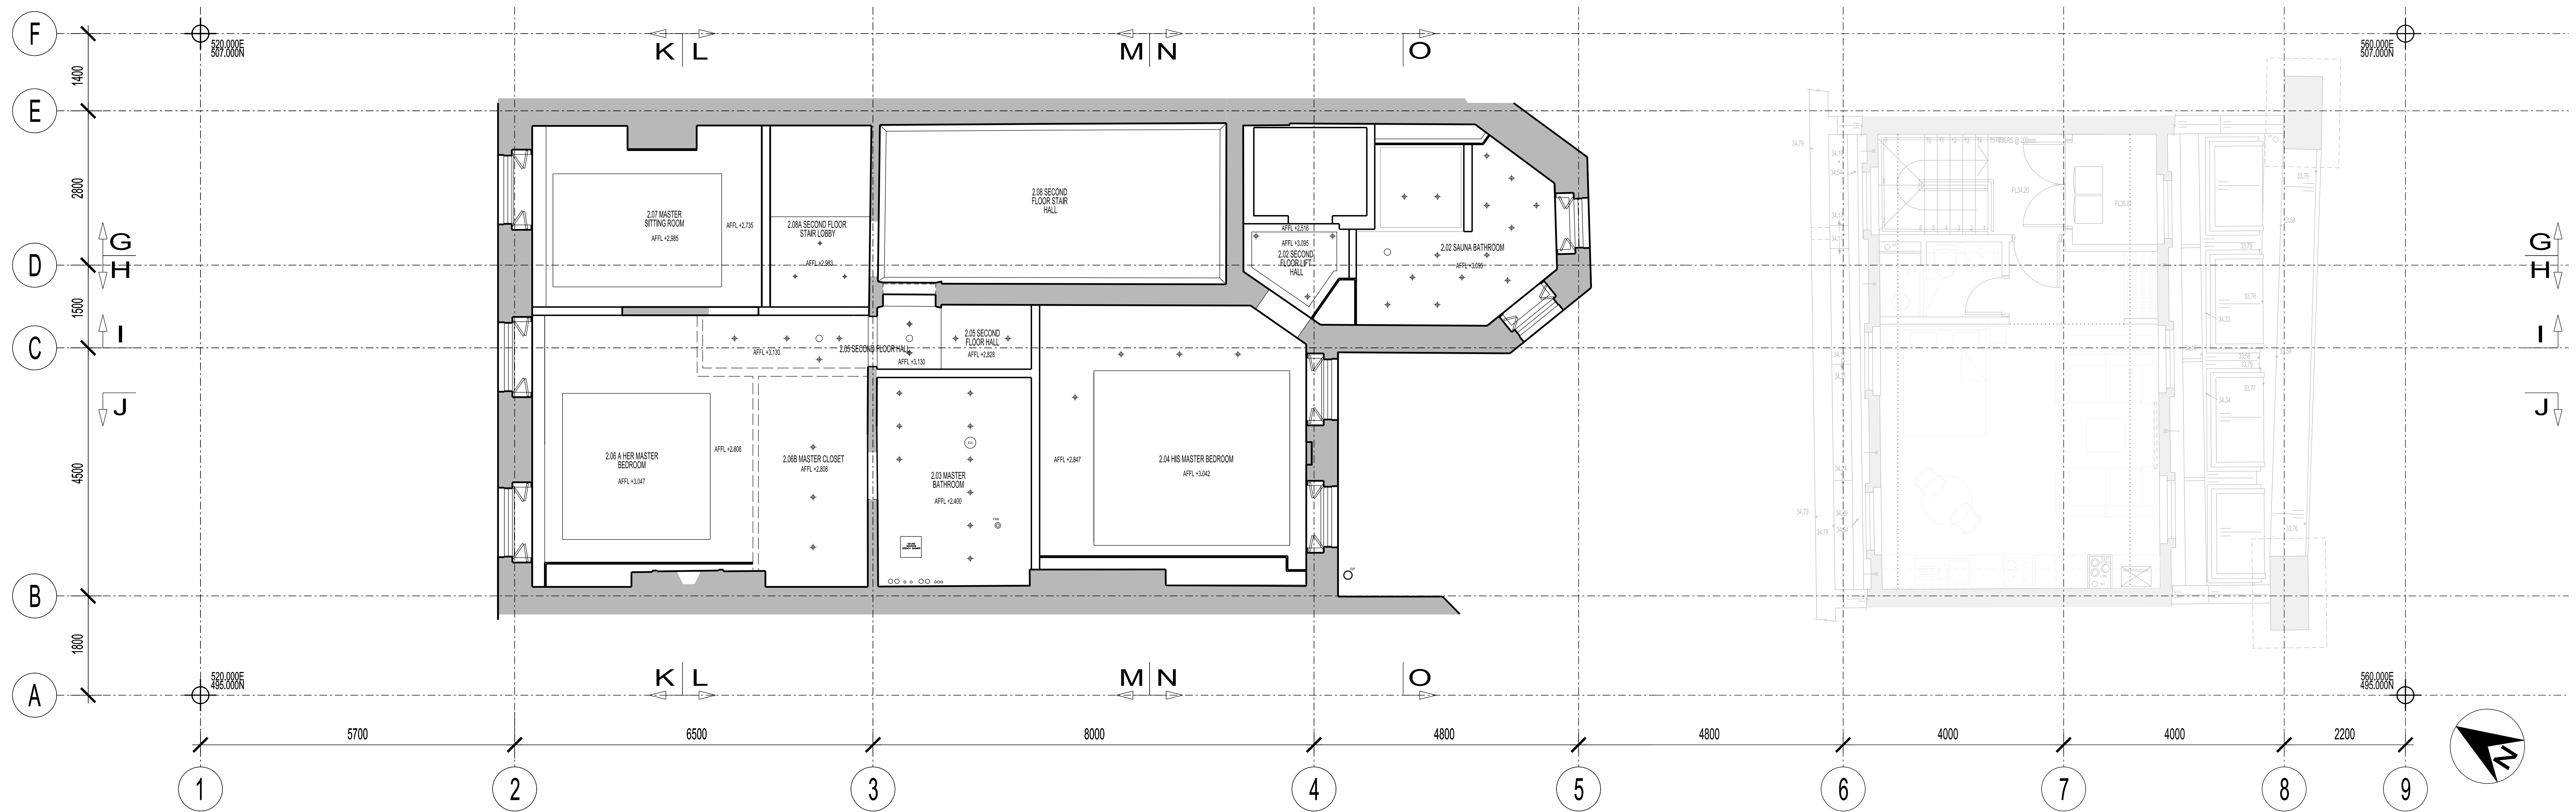

CURRENT AS BUILT CONDITION

BUILDING DESIGN PARTNERSHIP LTD SHALL HAVE NO RESPONSIBILITY FOR ANY USE MADE OF THIS DOCUMENT OTHER THAN FOR THAT WHICH IT WAS PREPARED AND ISSUED.

ALL DIMENSIONS SHOULD BE CHECKED ON SITE.


DO NOT SCALE FROM THIS DRAWING.

ANY DRAWING ERRORS OR OMISSIONS SHOULD BE BROUGHT TO THE ATTENTION OF BUILDING DESIGN PARTNERSHIP LTD AT THE ADDRESS SHOWN.

- Celling Spotlight
- Aspirator
- Smoke Detector
- Strip Light
- Celling Pendant
- Heat Detector
- Unknown Electrical Feed

REVISION DESCRIPTION	DATE	REVISION DESCRIPTION	DATE	REVISION DESCRIPTION	DATE	REVISION DESCRIPTION	DATE	REVISION DESCRIPTION	DATE	REVISION DESCRIPTION	DATE	REVISION DESCRIPTION	DATE	REVISION DESCRIPTION	DATE	REVISION DESCRIPTION	DATE
----------------------	------	----------------------	------	----------------------	------	----------------------	------	----------------------	------	----------------------	------	----------------------	------	----------------------	------	----------------------	------

BDP.		42 BEDFORD SQUARE	
16 Brewhouse Yard Clarendon London, EC1V 4LJ United Kingdom T +44 (0)20 7812 8000 F +44 (0)20 7812 8999 www.bdp.com		PROJECT NO. P2005698	
PRINCIPAL HOUSE SECOND FLOOR REFLECTED CEILING PLAN CURRENT AS BUILT CONDITION		SCALE 1:50	
DATE 12.2017		DRAWN BY B	

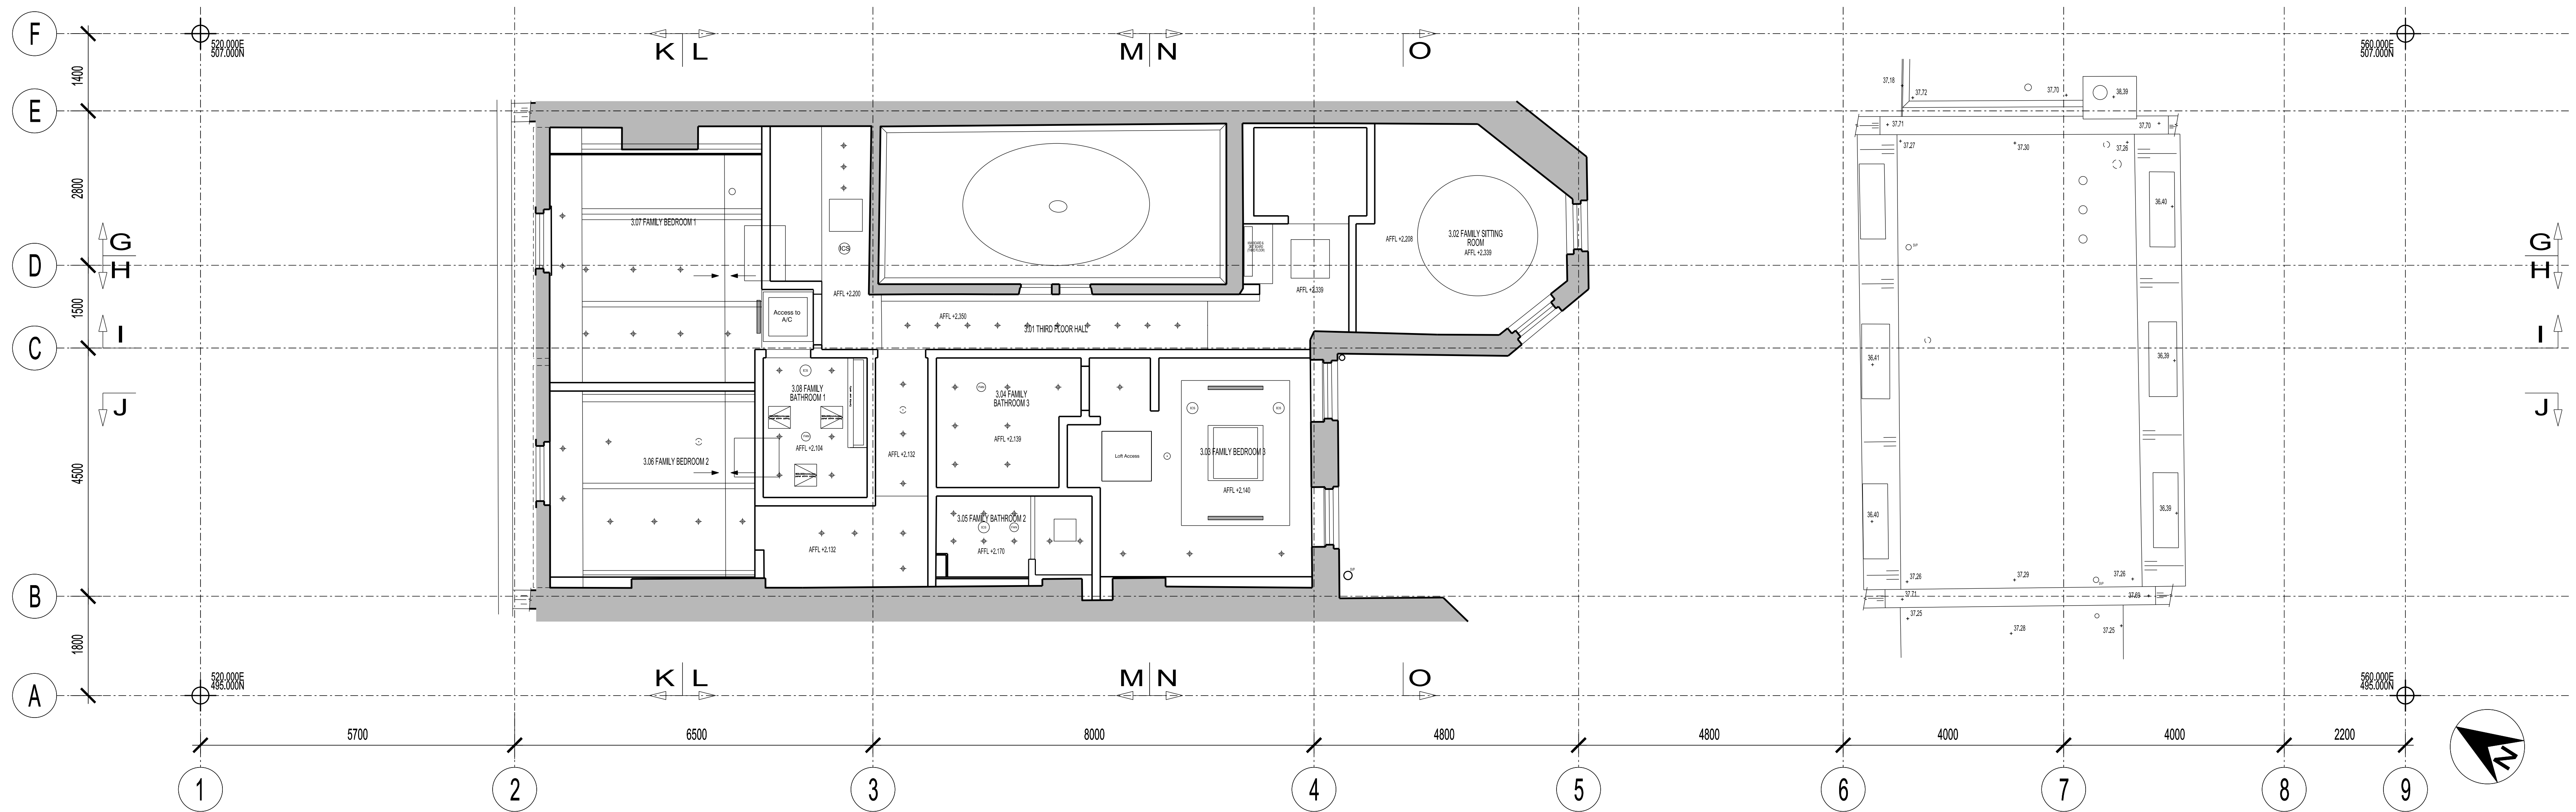

CURRENT AS BUILT CONDITION

<p>BUILDING DESIGN PARTNERSHIP LTD SHALL HAVE NO RESPONSIBILITY FOR ANY USE MADE OF THIS DOCUMENT OTHER THAN FOR THAT WHICH IT WAS PREPARED AND ISSUED.</p> <p>ALL DIMENSIONS SHOULD BE CHECKED ON SITE.</p> <p>DO NOT SCALE FROM THIS DRAWING.</p> <p>ANY DRAWING ERRORS OR DIVERGENCES SHOULD BE BROUGHT TO THE ATTENTION OF BUILDING DESIGN PARTNERSHIP LTD AT THE ADDRESS SHOWN.</p>	<p>☛ Ceiling Spotlight</p> <p>☉ Aspirator</p> <p>⊕ Smoke Detector</p> <p>⏏ Strip Light</p> <p>☛ Ceiling Pendant</p> <p>⊕ Heat Detector</p>	<p>○ Unknown Electrical Feed</p>																																																																																																																																																																																																																																																																																																																																																																																																																																																																																																																																																																																																																																																																																																																																																																																																																																																																																																																																																																																																																																																																																																																																																																																																																																																																																																																																																						
--	--	----------------------------------	--	--	
g General Arrangement Drawings - as Proposed



