



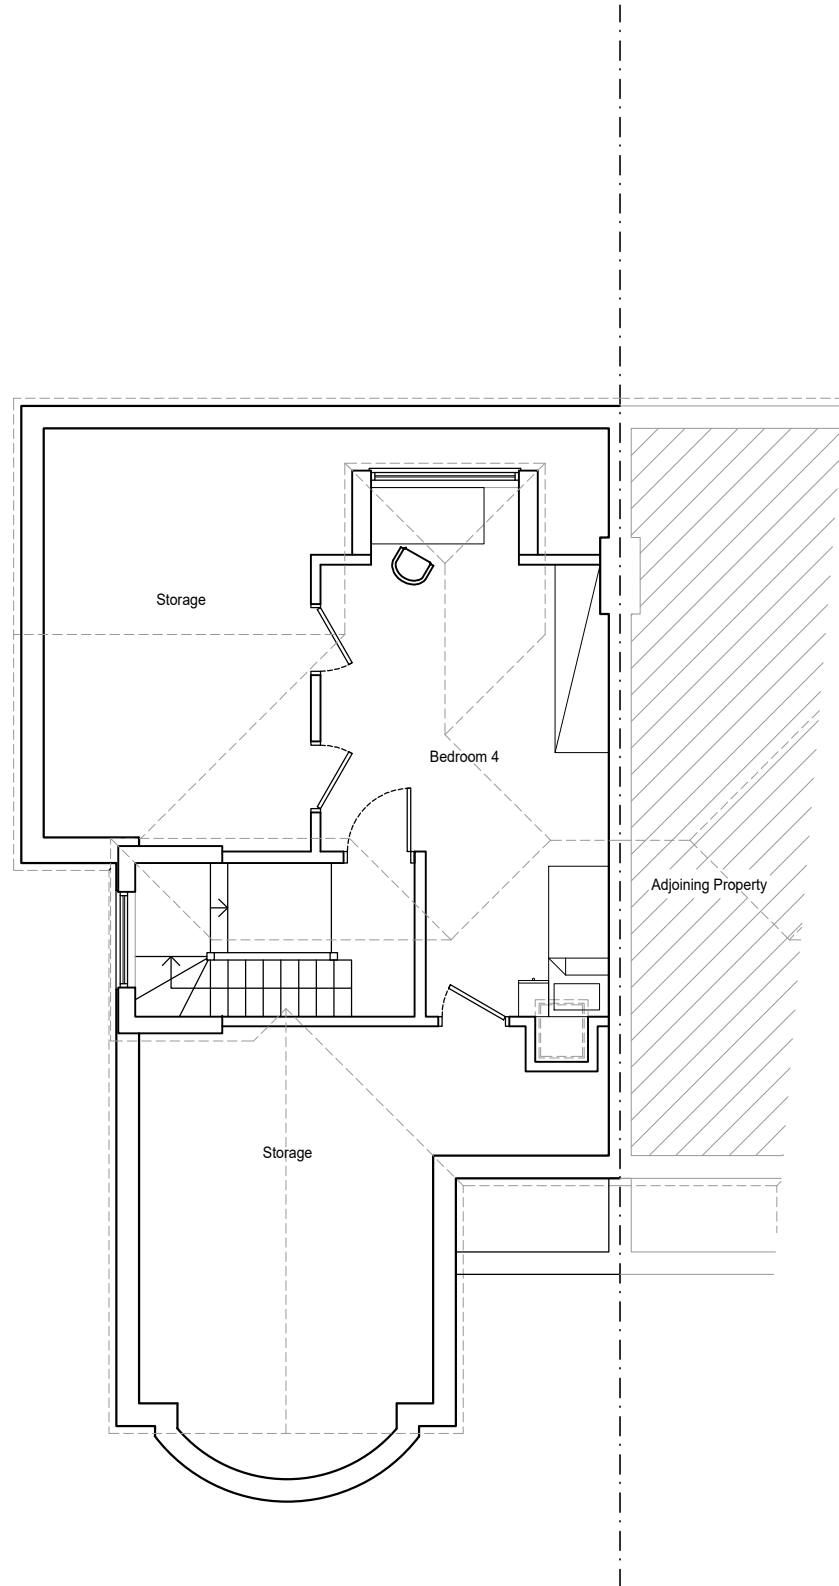


Second Floor Plan as Built

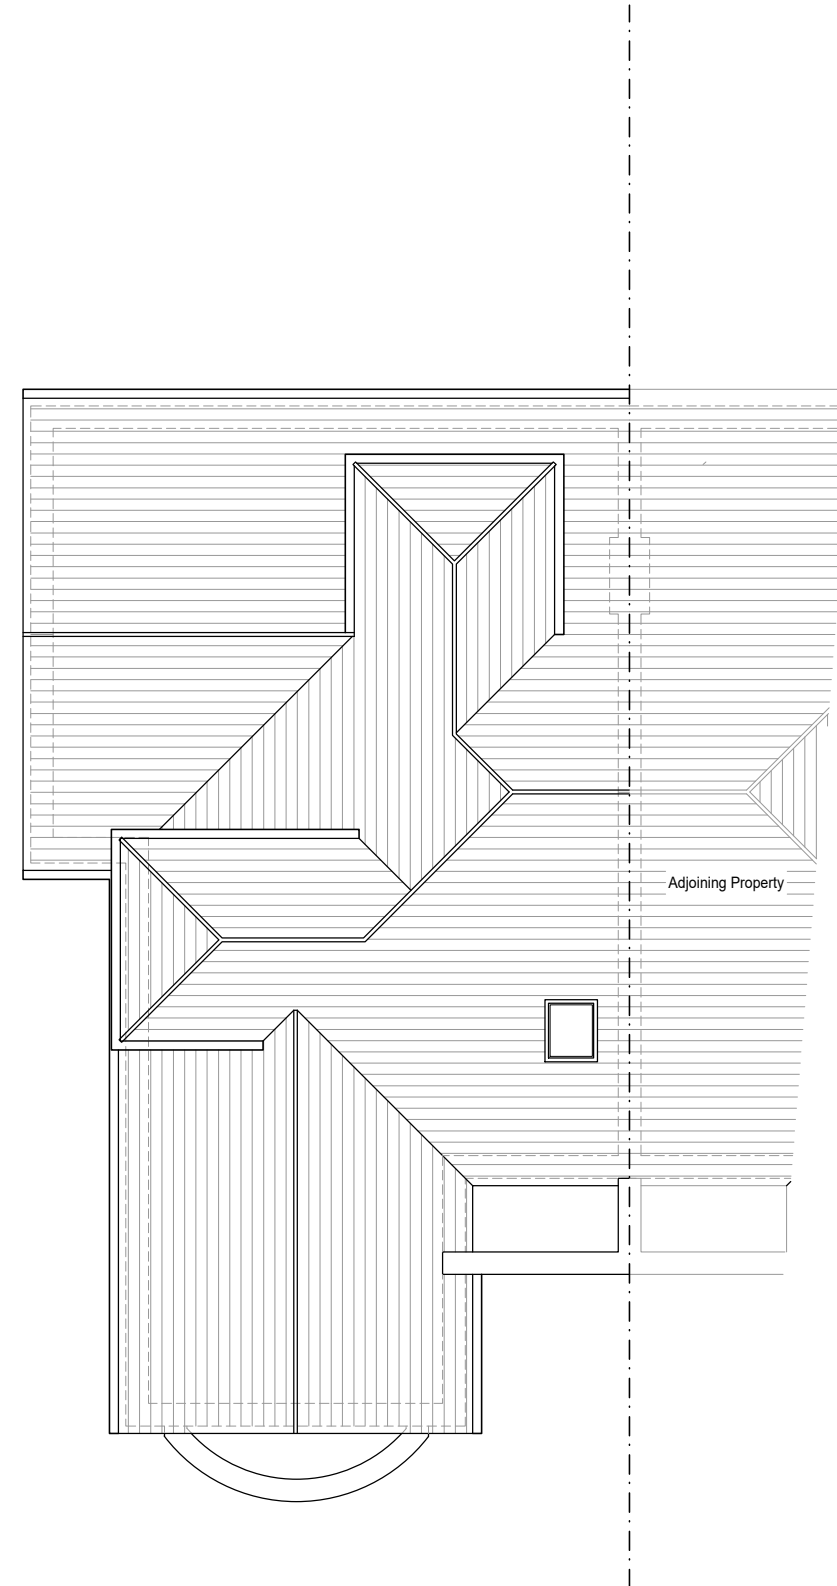

Roof Plan as Built

Issue:
Retrospective
Planning Application

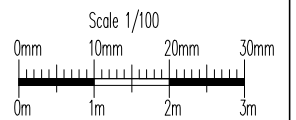

Revisions			
Rev	Description	Drawn by	Date

CG ARCHITECTS

221 East Barnet Road, Barnet, Herts EN4 8QS
Tel: 020 8449 5100 Fax: 020 8449 5170

Client:
Whitegold Prop. Ltd

Site:
**8 Hillway
Highgate, London
N6 6QD**

Title:
Plans as Built 2

Scale: 1:100 @ A3	Drawn: D.P.	Checked: C.G.
Date: June 2020		
Drg No 1371/34	REV #	