





FRONT ELEVATION 1:100

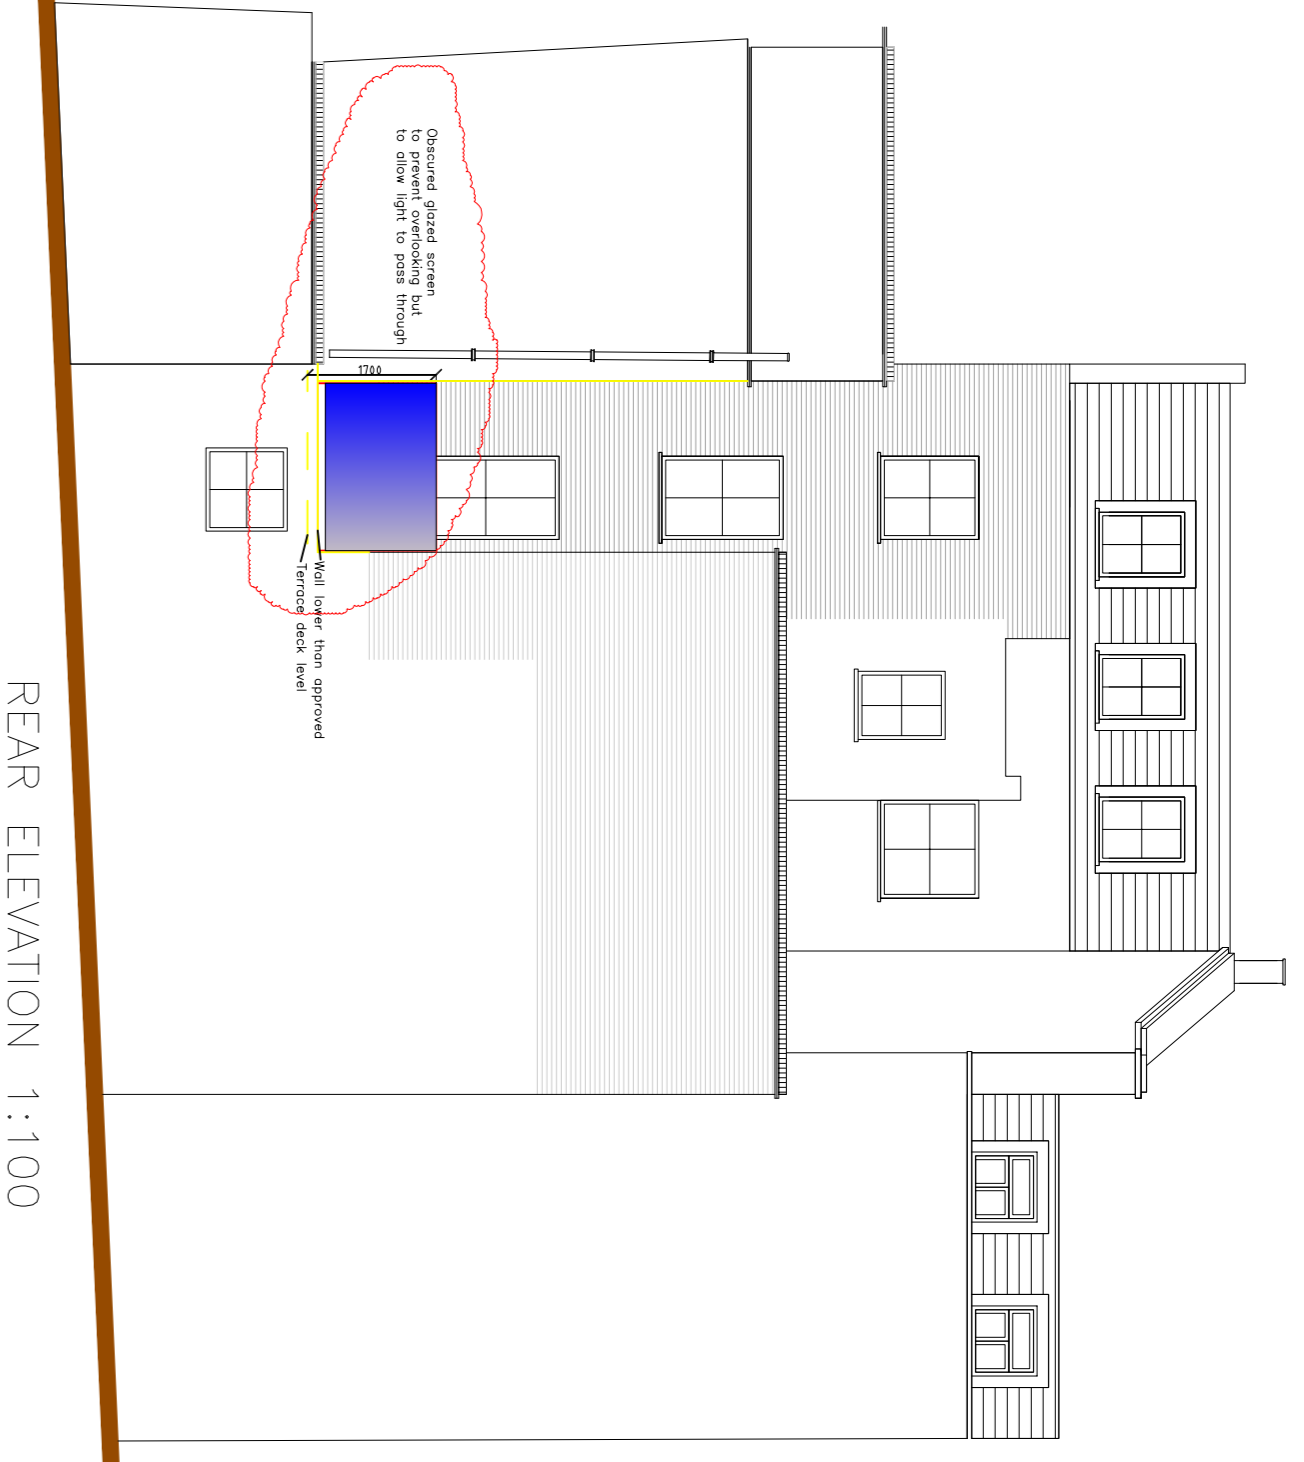


REAR ELEVATION 1:100




SECTION / SIDE ELEVATION 1:100

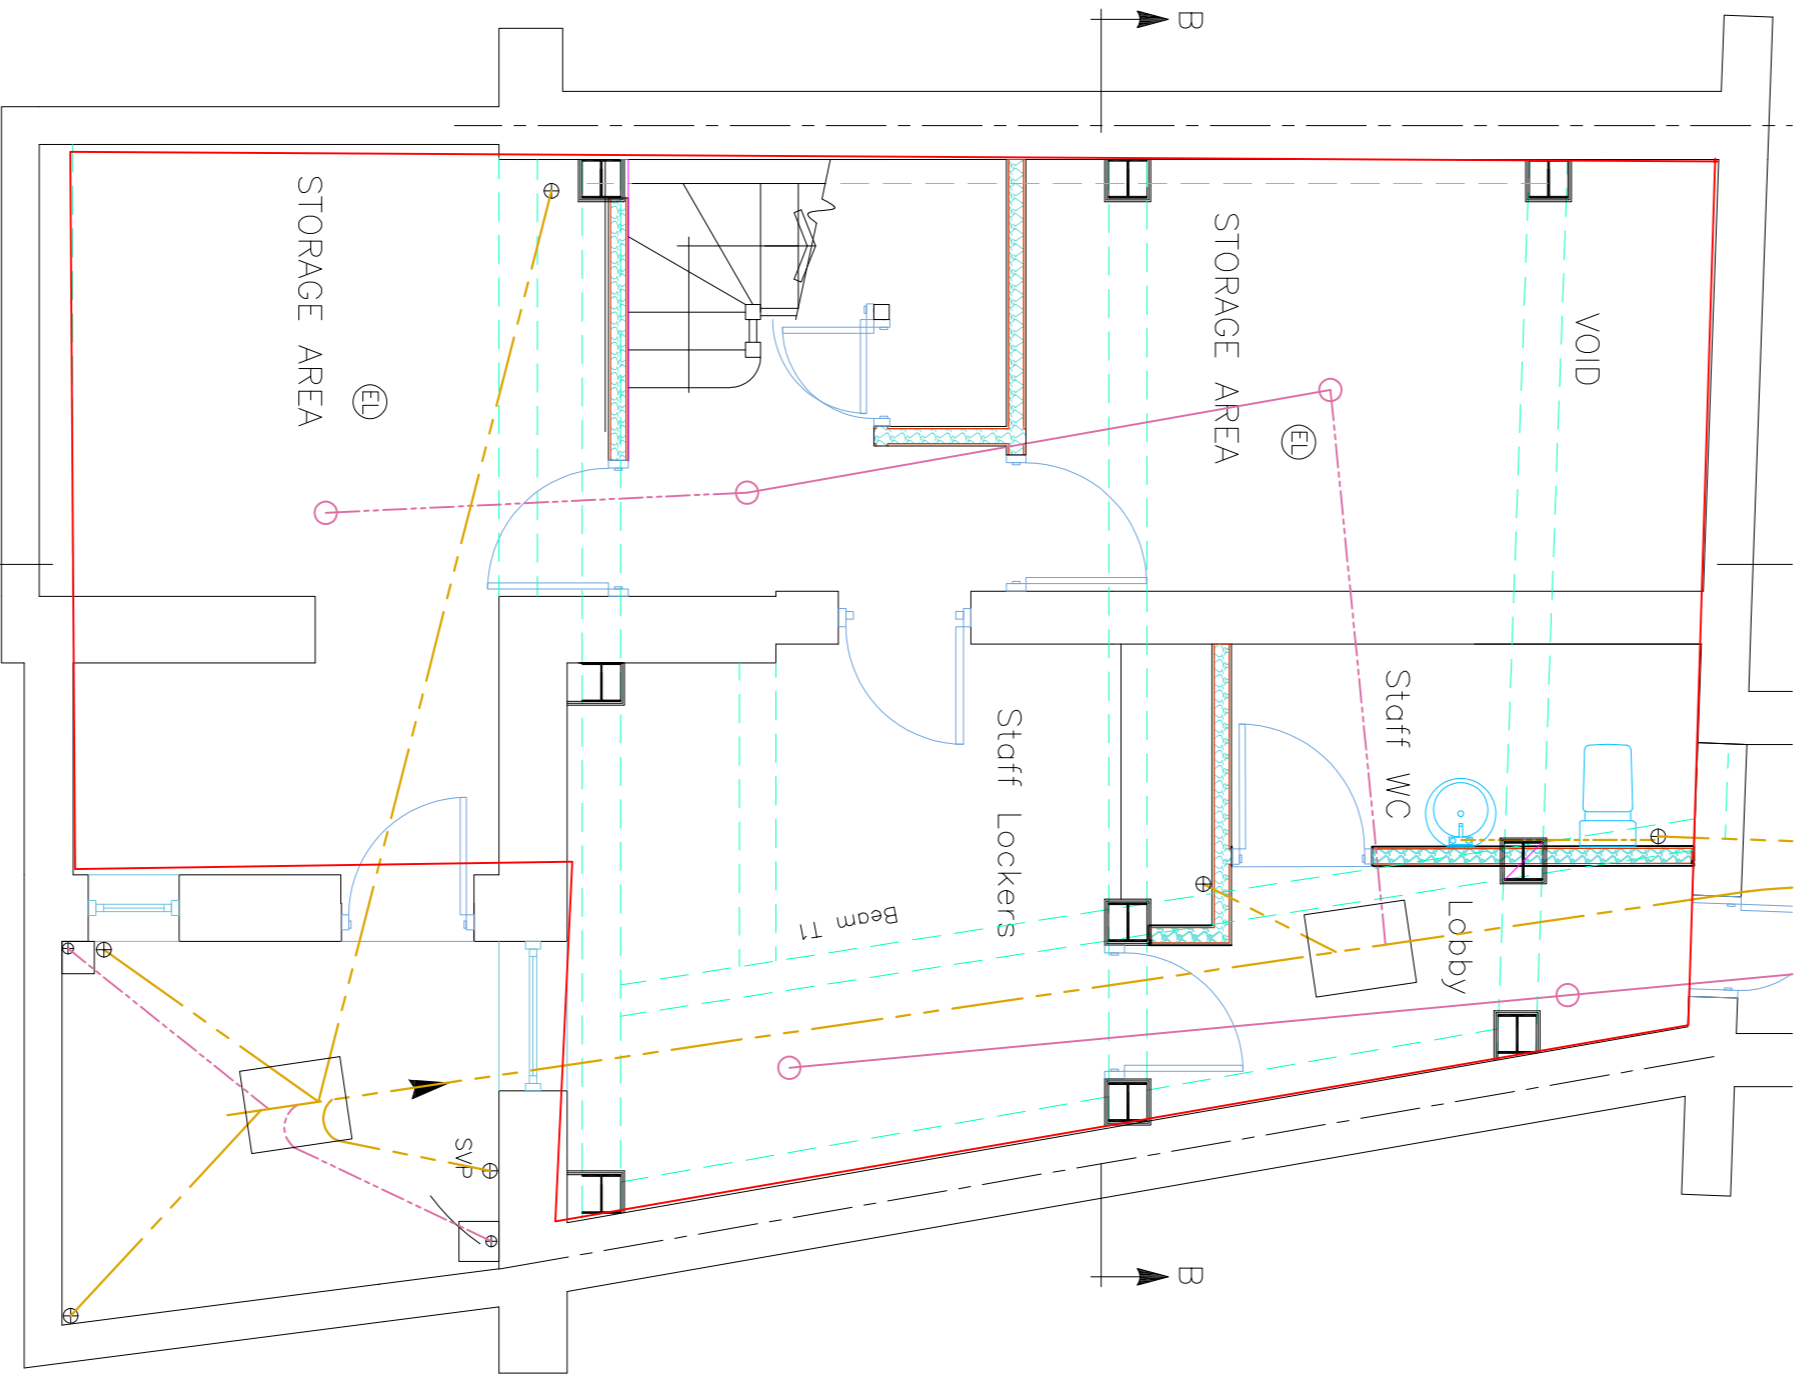

BASEMENT PLAN 1:50

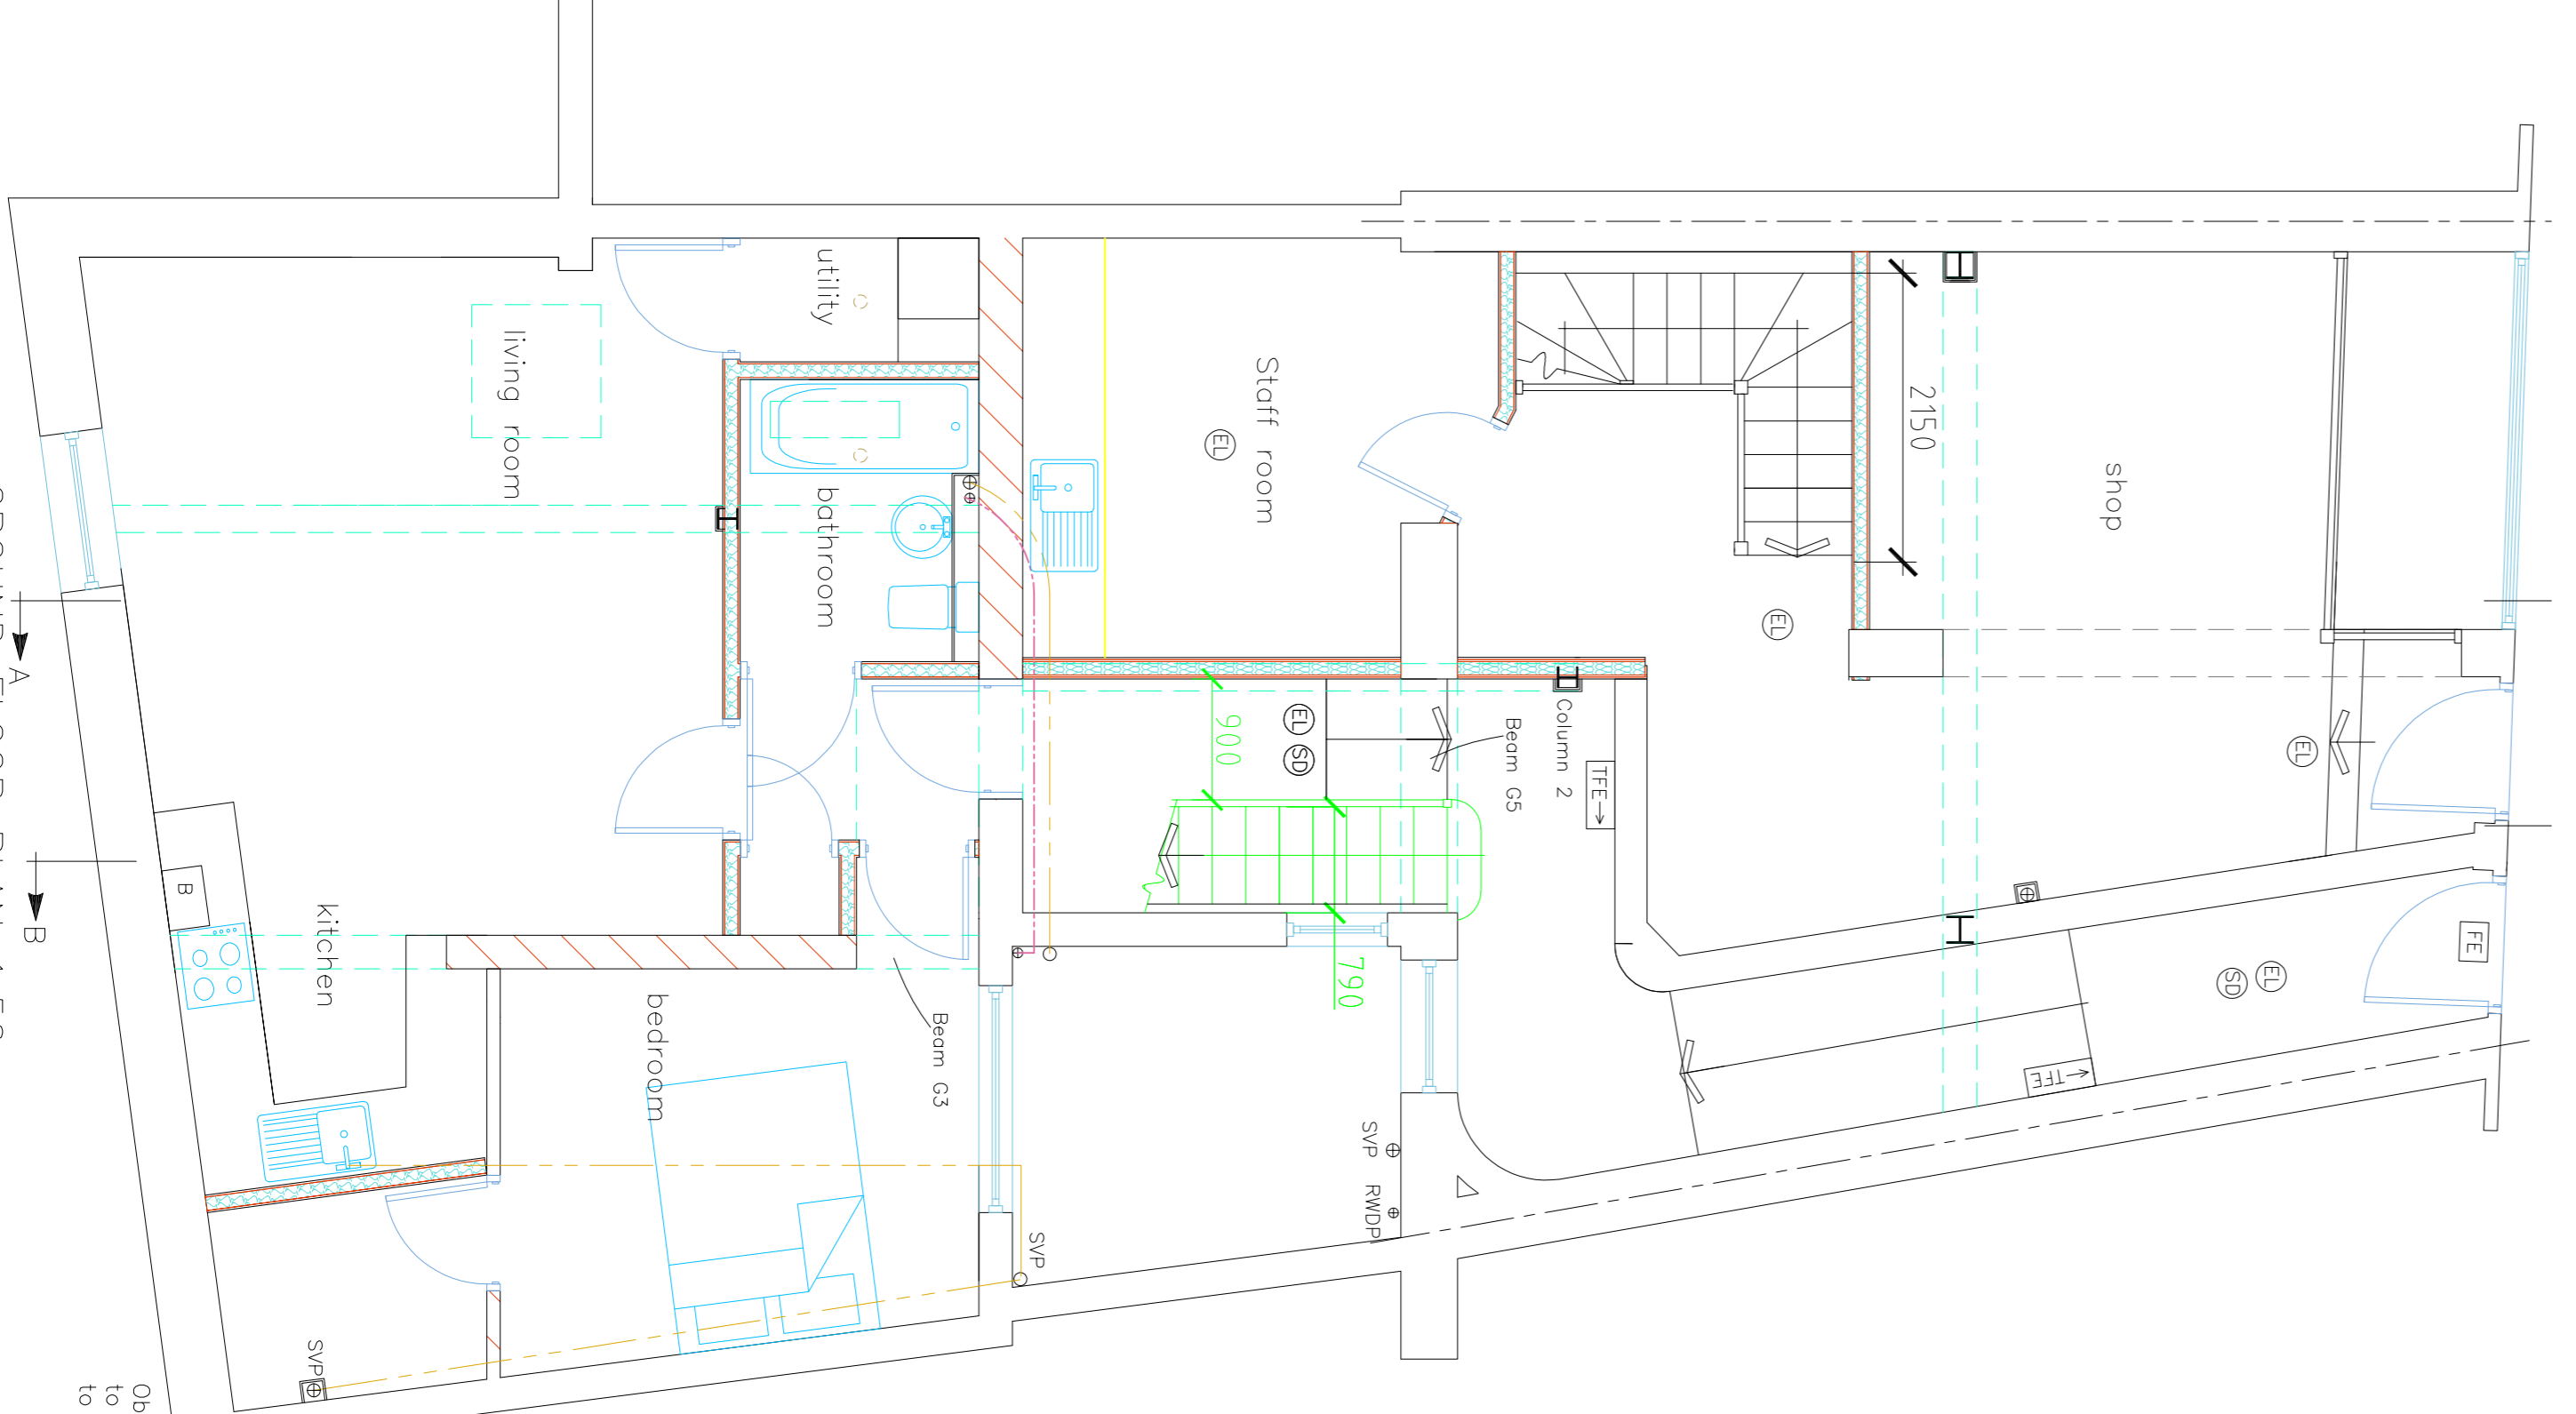

GROUND FLOOR PLAN 1:50

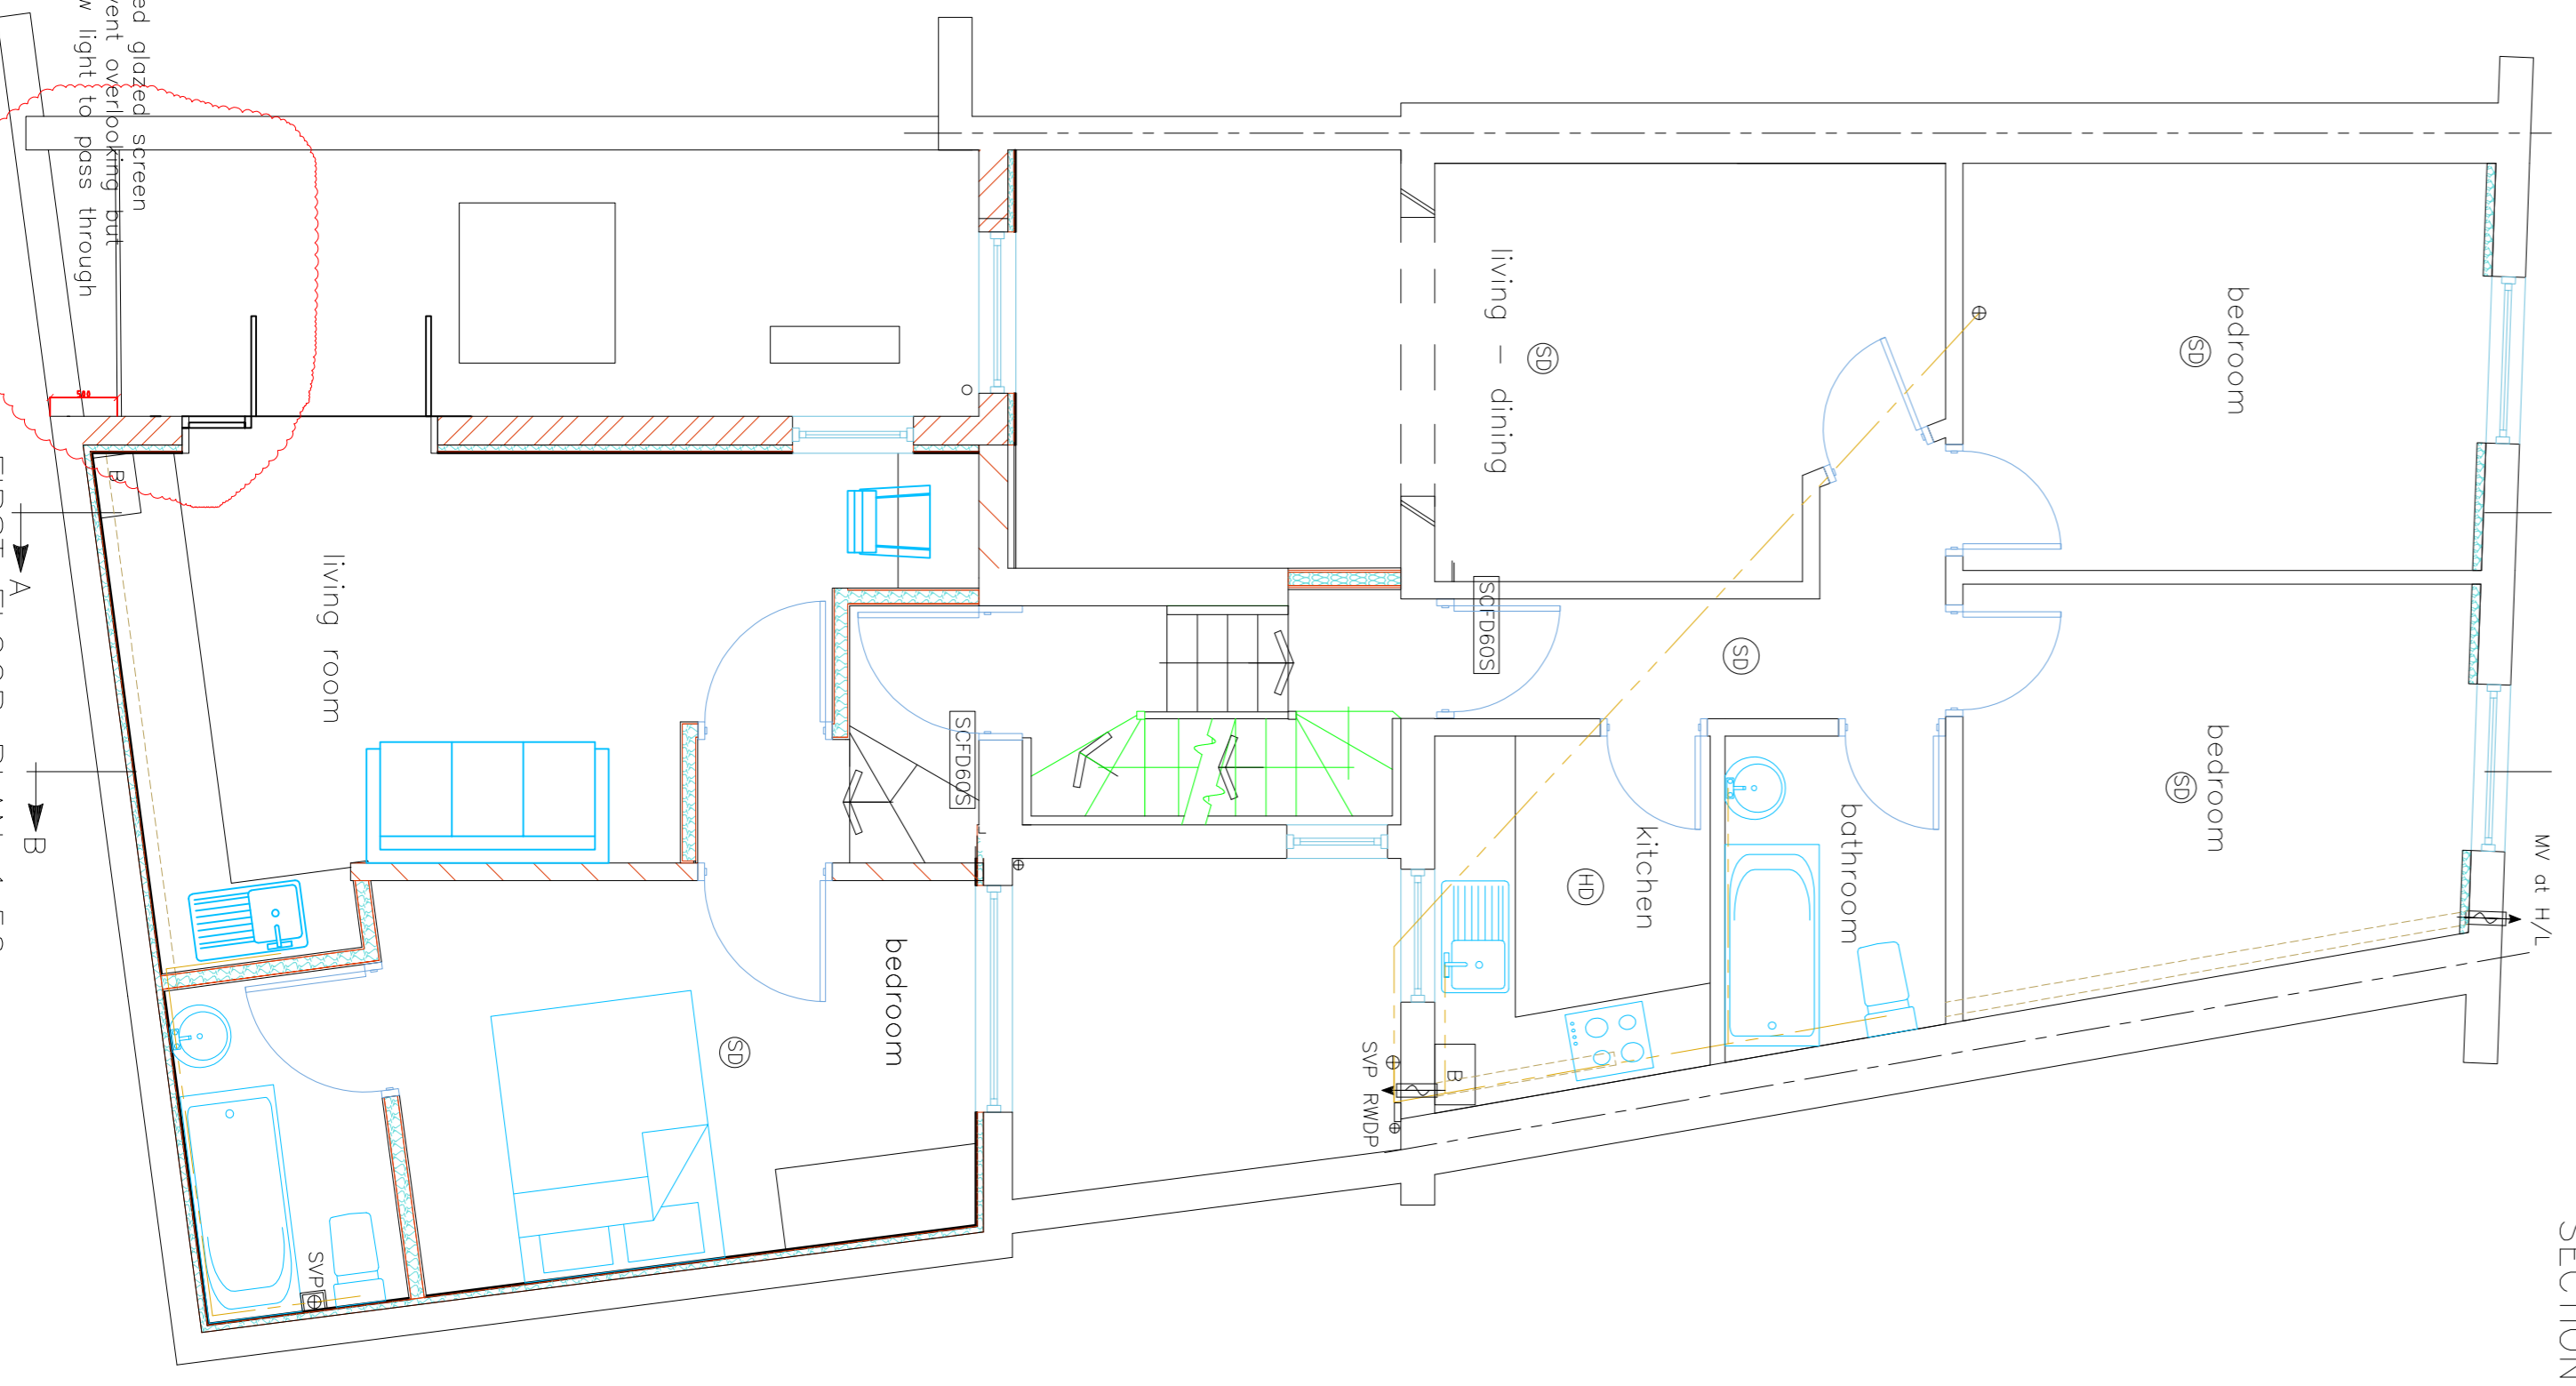

FIRST FLOOR PLAN 1:50

Notes: All dimensions must be checked on site and not scaled from this drawing.

© Copyright

C	5.2020	Balcony Rev	A.L.C
B	5.2020	Balcony Rev	A.L.C

Simon Hands and Associates
 Chartered Surveyors & Architects
 12 Redlip Road
 Middlesbrough
 1466 9GN
 Tel: 020 8575 5959
 Fax: 020 8575 8866
 email: enquiries@simonhands.co.uk

Client: **Fabrizio Indalcato**
 Job Title: **Proposed Works at 129 Kings Cross Road London WC1X 9BJ**

Drawing Title: **AS CONSTRUCTED PLANS & ELEVATIONS**

Scale	1:50 1:100	Paper Size	A1
Date	25/10/19	Drawn By	CEC
Job No	2019161	Rev	C