




SUBJECT TO BUILDING REGULATIONS APPROVAL
DO NOT SCALE FROM THIS DRAWING
DRAWING ONLY TO BE USED FOR PURPOSES AS
STATED.
SUBJECT TO DETAILED SITE SURVEY
COPYRIGHT FOR THIS DRAWING IS THE
PROPERTY OF NWCA

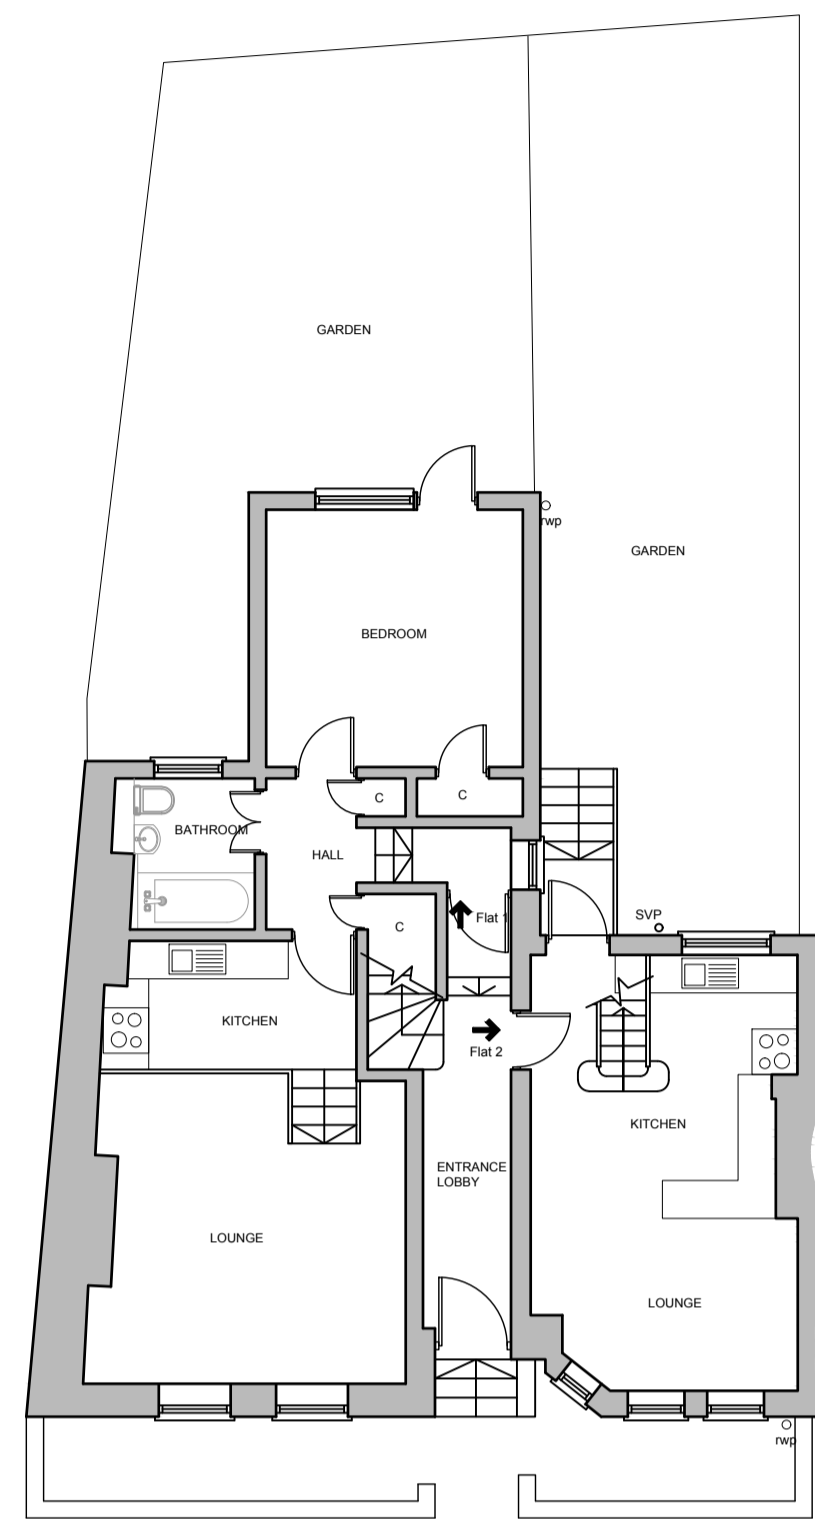

GROUND FLOOR

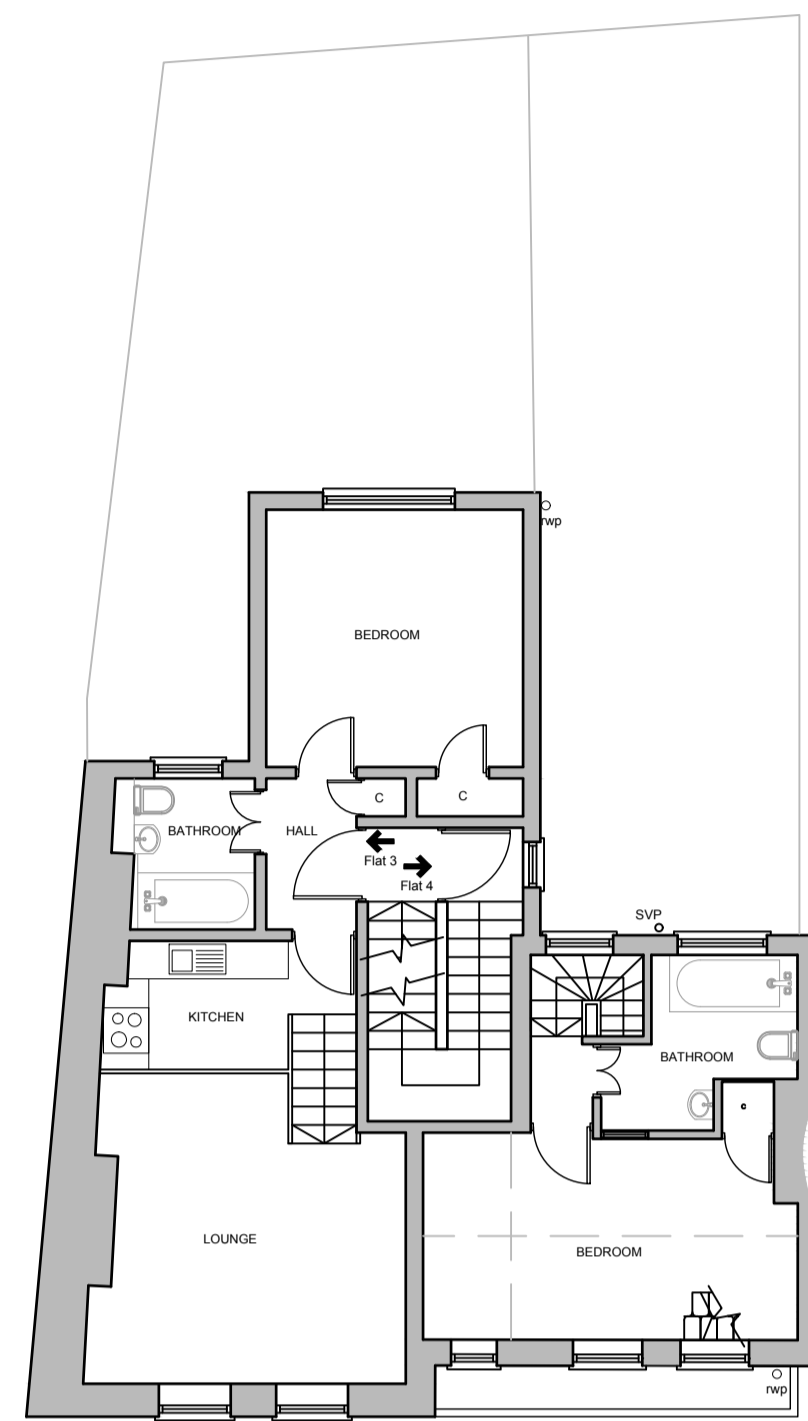


FIRST FLOOR

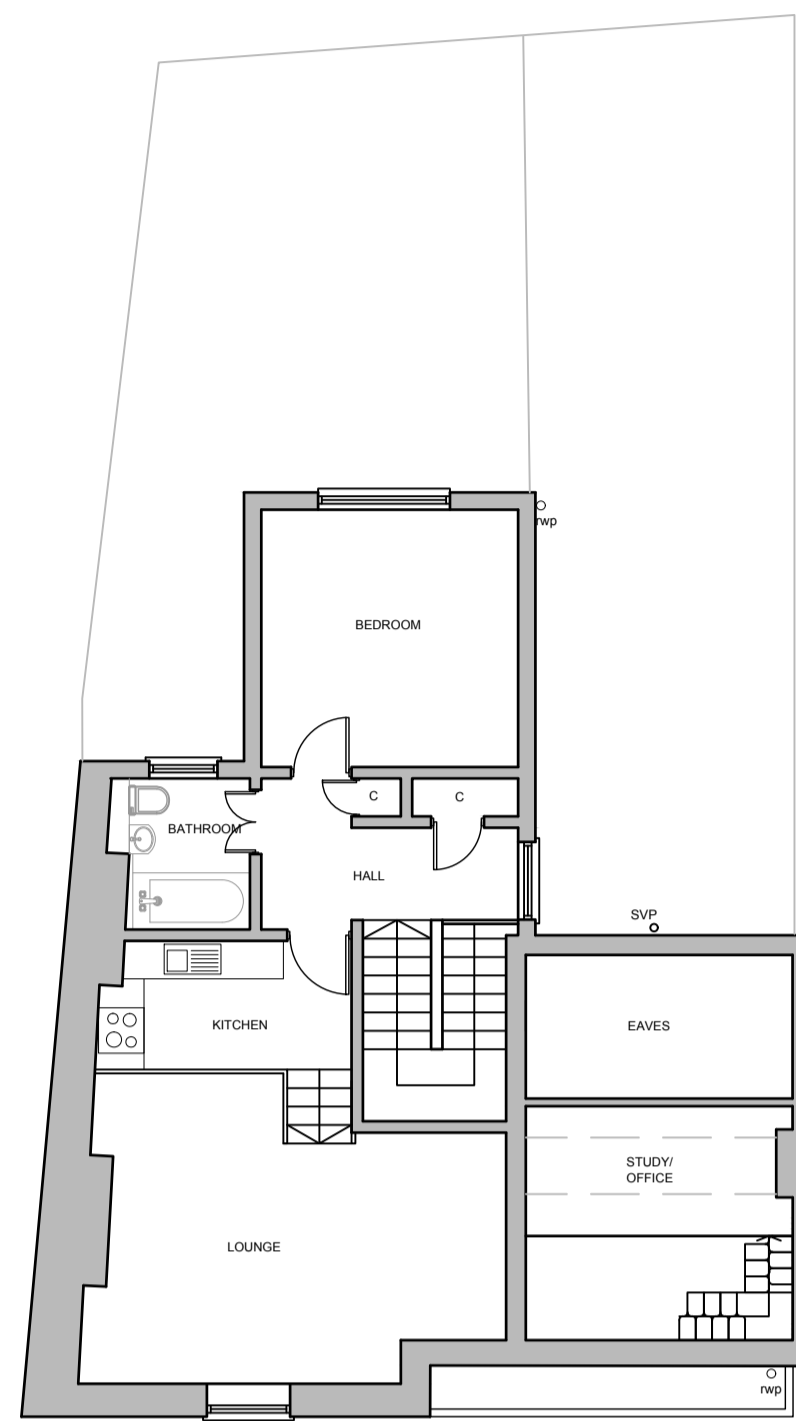


SECOND FLOOR


PLANS AS PRIOR TO BUILD
Scale 1:100@A1

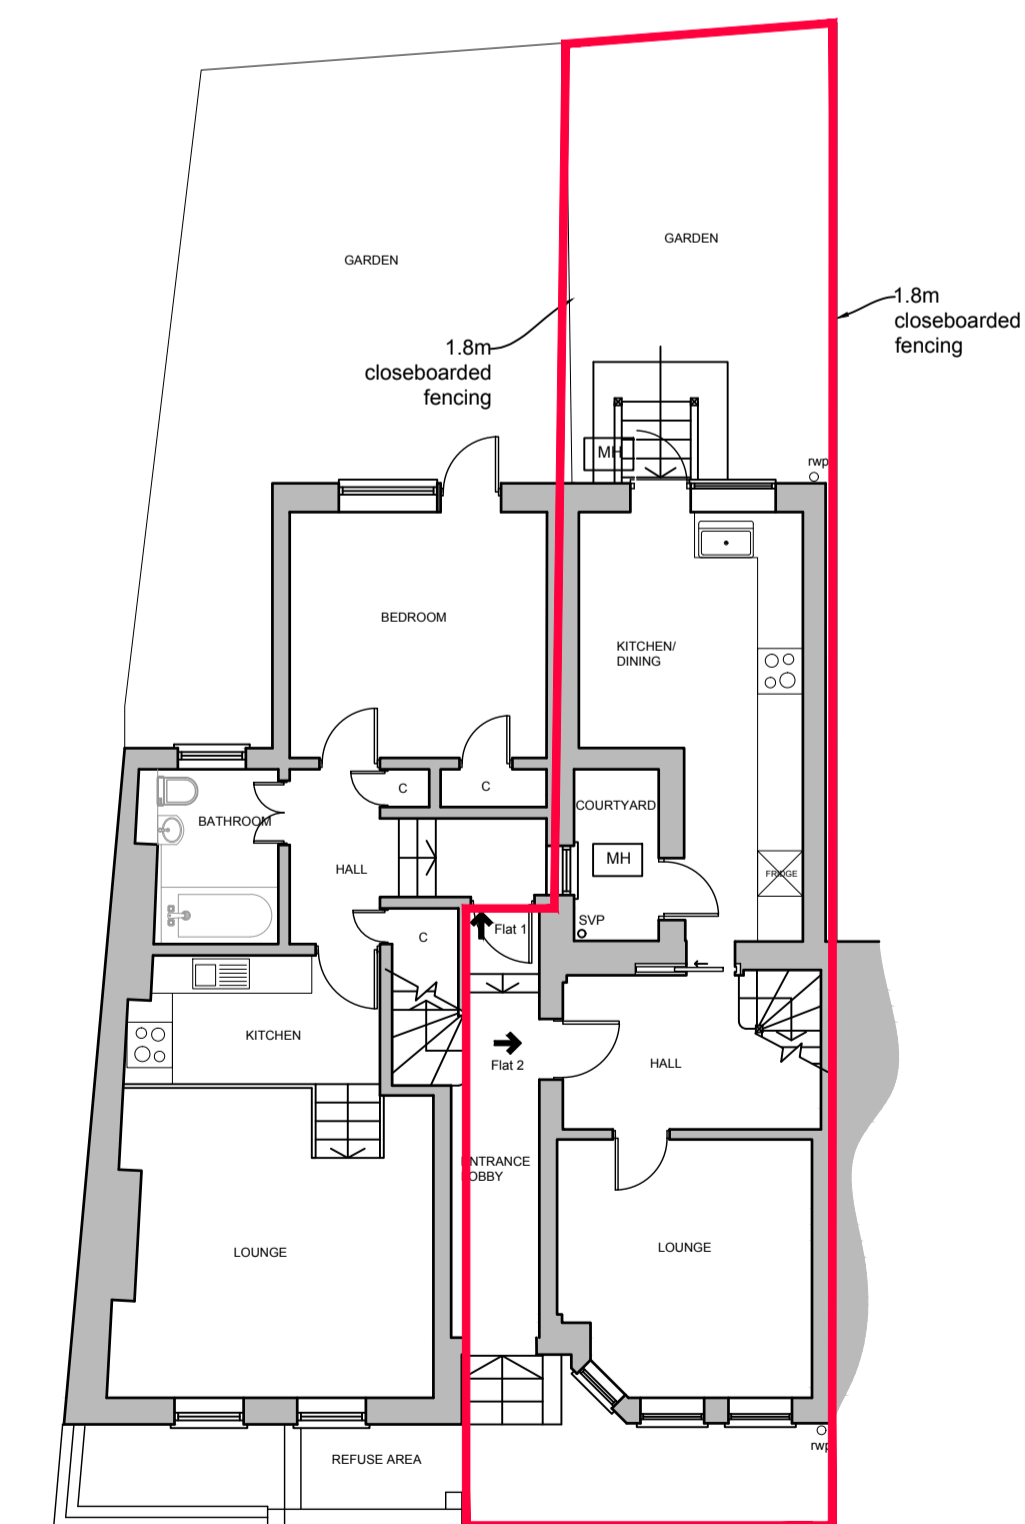

GROUND FLOOR

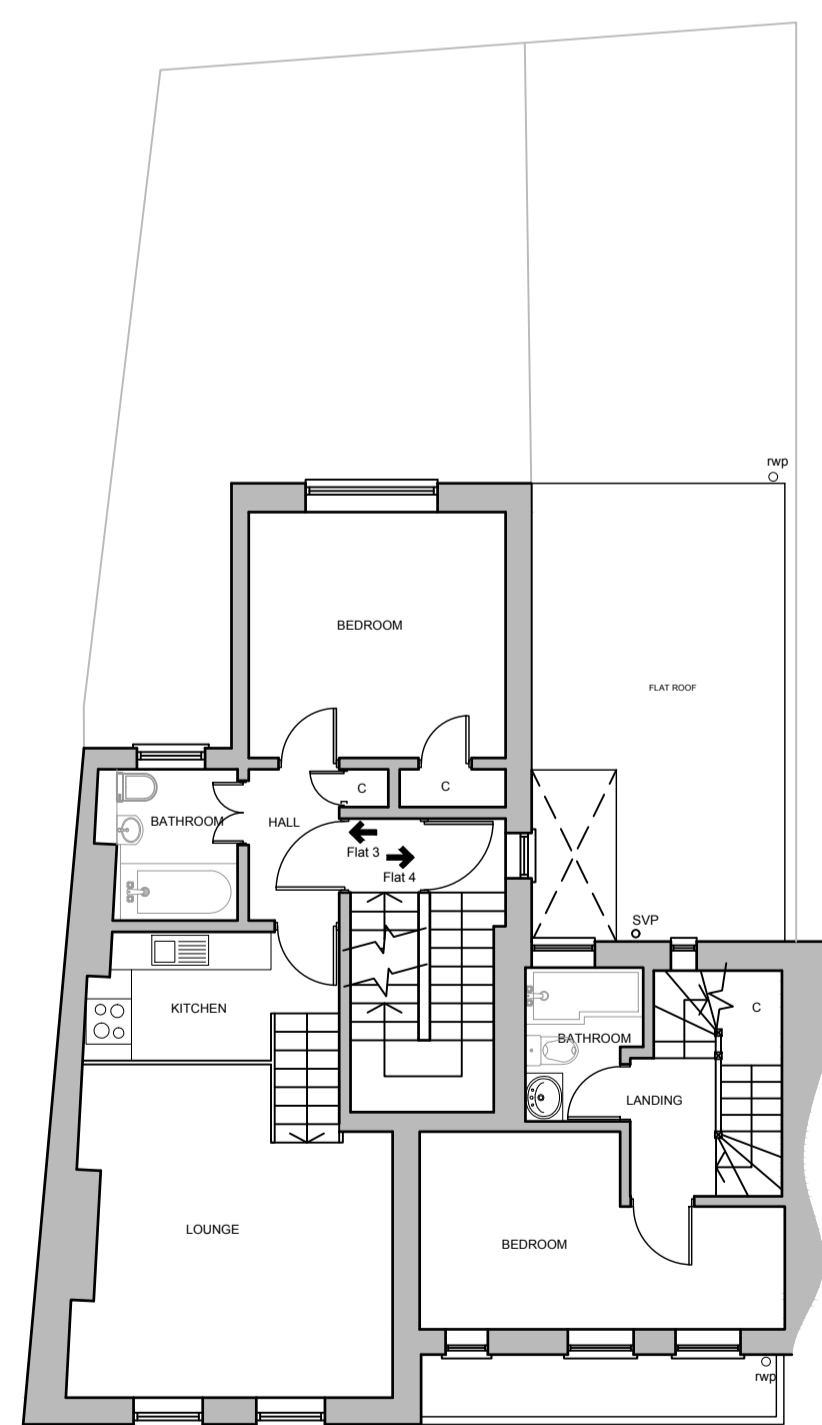

FIRST FLOOR

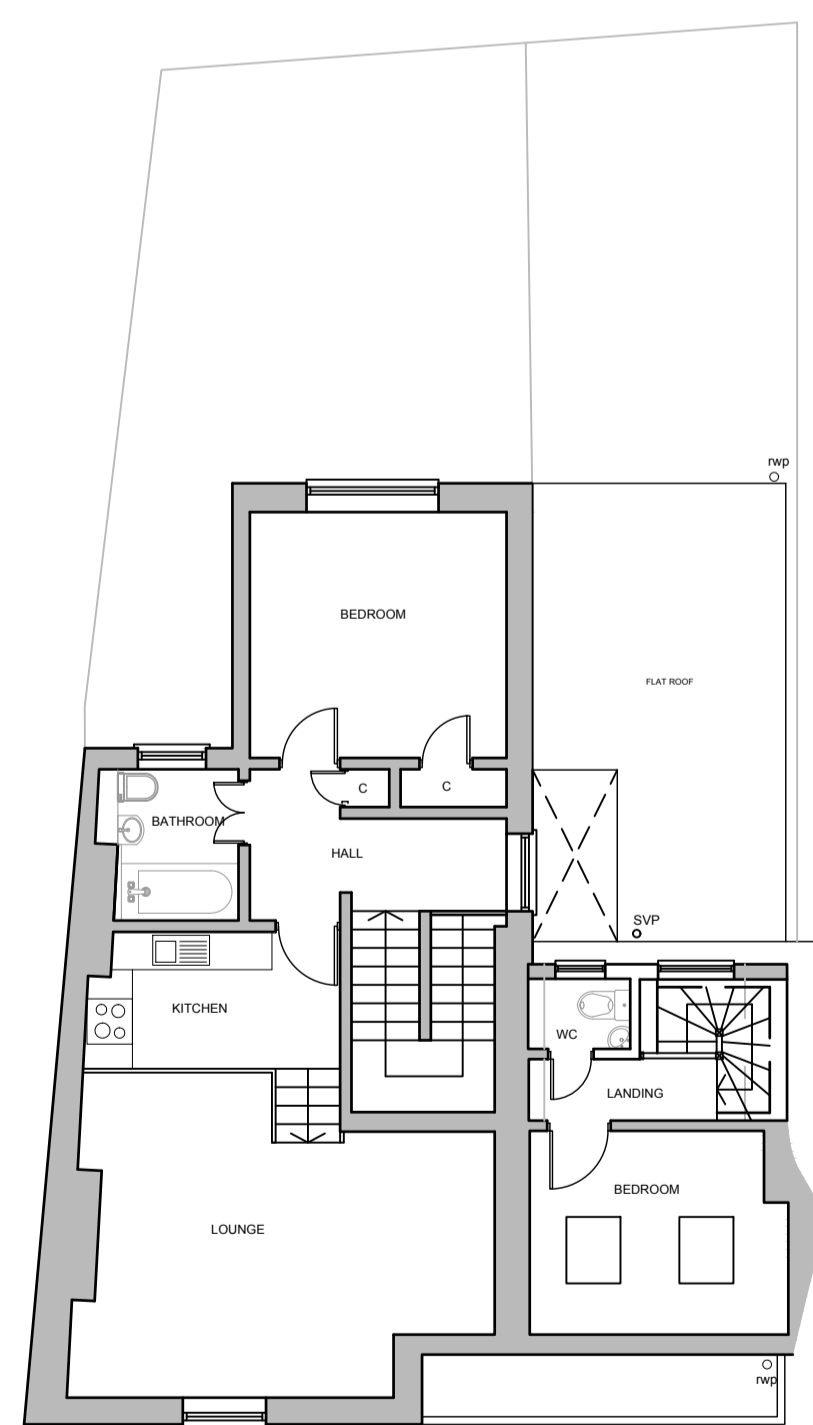


SECOND FLOOR

PLANS AS BUILT
Scale 1:100@A1




FRONT ELEVATION

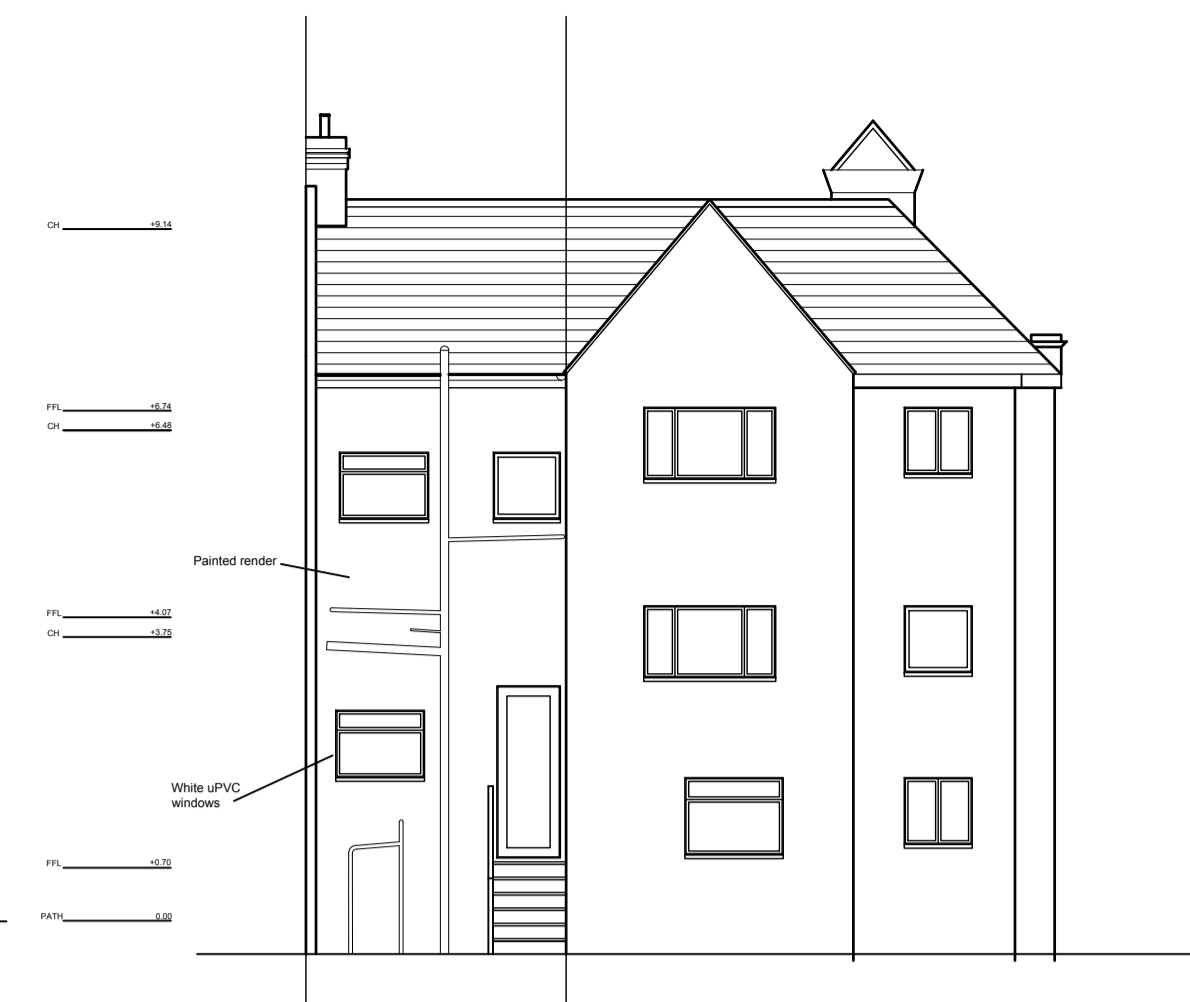


REAR ELEVATION

ELEVATIONS AS PRIOR TO BUILD
Scale 1:100@A1

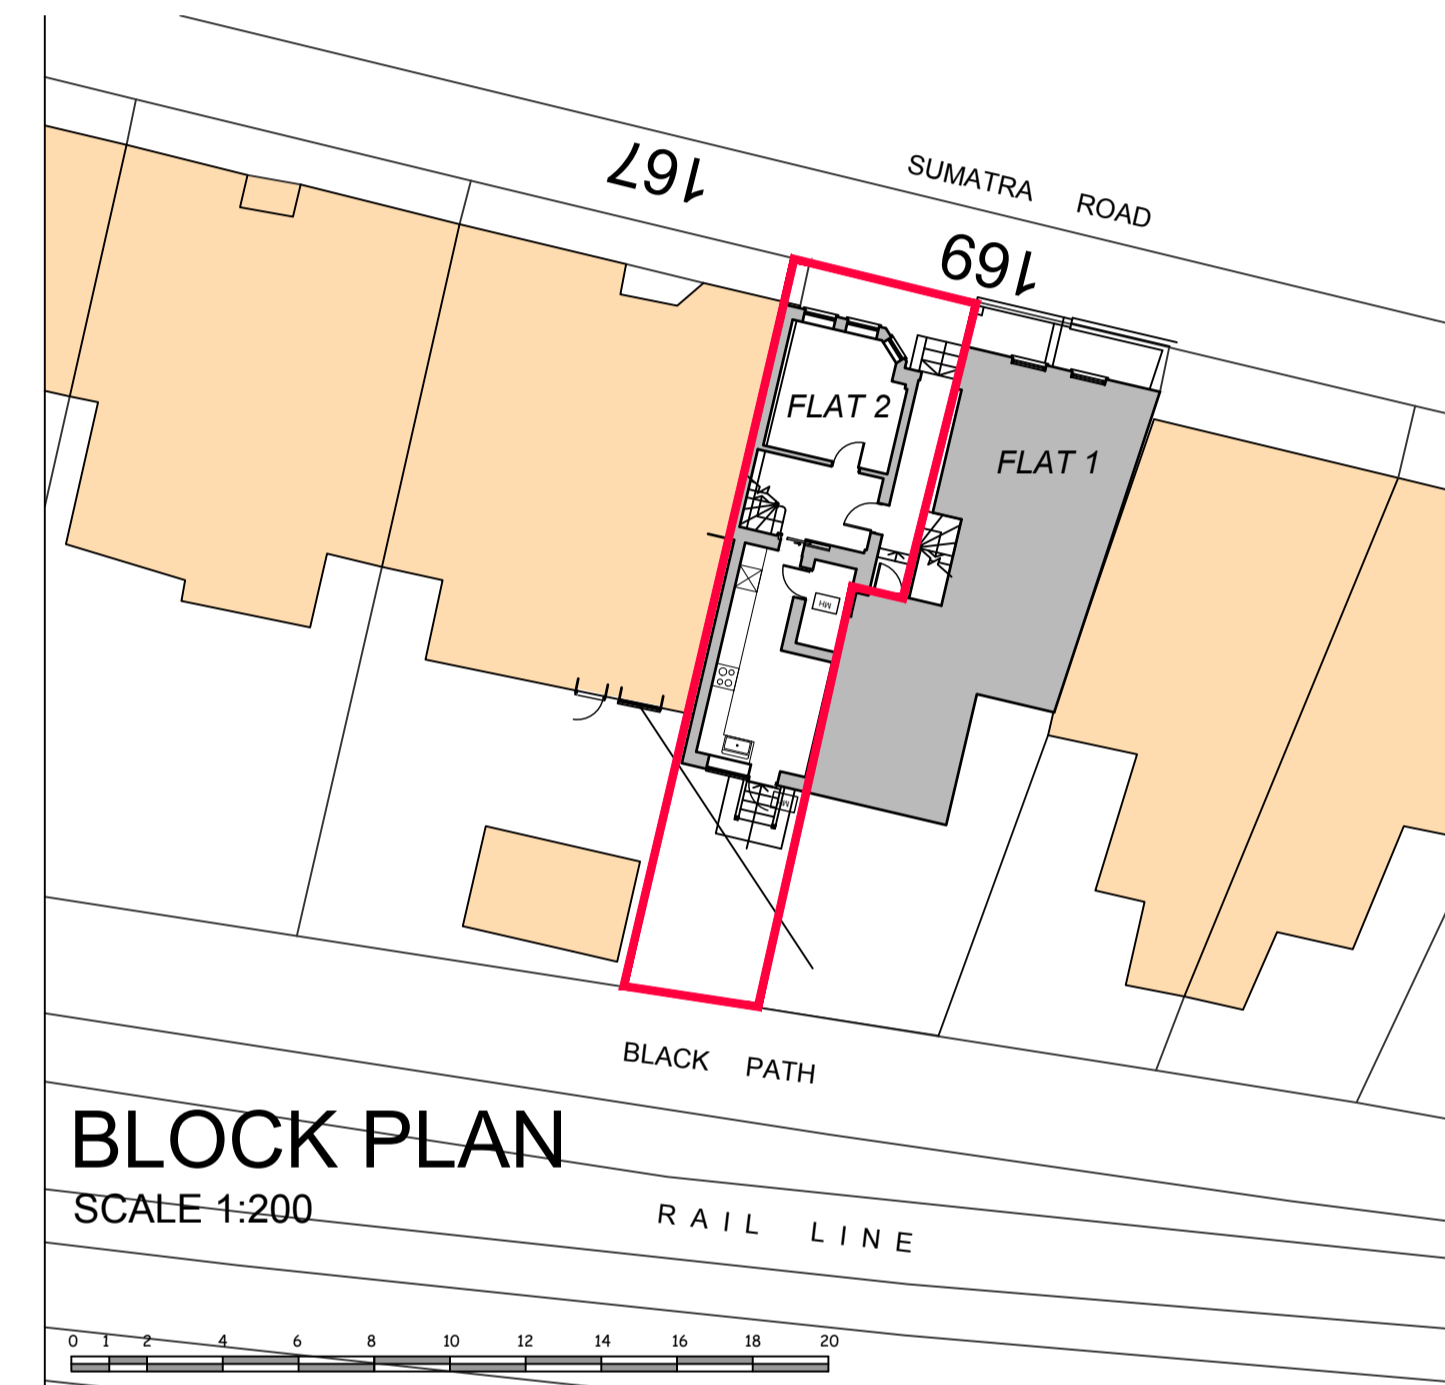

BLOCK PLAN
SCALE 1:200

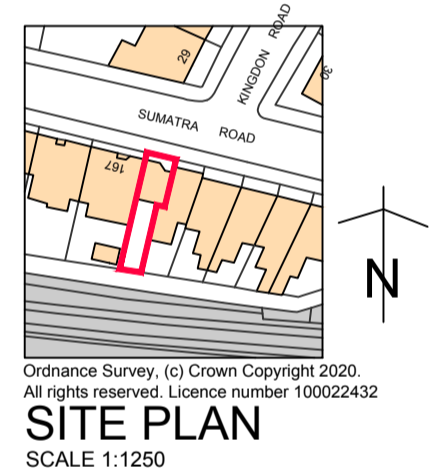

SITE PLAN
SCALE 1:1250



FRONT ELEVATION



REAR ELEVATION

ELEVATIONS AS BUILT
Scale 1:100@A1

PLANNING

client
ODED LACHISH

site
FLAT 2
169 SUMATRA ROAD, WEST HAMPSTEAD

drawing
PLANNING DRAWING

scale	author	scale
VARIES	ncw	JUNE 2020
proj. no.	draw. no.	revision
N128	SK100	-

Nicholas C Williams RIBA

ncwarchitecture@gmail.com