




Head Office:
Becket House
1 Lambeth Palace Road
London SE1 7EU
Tel: 020 7401 0020

Taylor Wimpey

Central London

KEY PLAN:

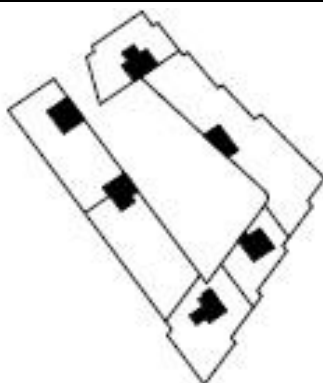

Mount Pleasant - Phase 1

Plans illustrating access control systems

	Name	Signature	Date
Designed by	---		
Drawn by	DAPO		16.06.20
Checked	---		
Approved	---		

NTS @ A4
SCALE & FORMAT

For Review
PROPOSED STATUS

16.06.20
DATE OF 1ST ISSUE

FILE NAME

MP1
PROJECT

BYG
ORIGINATOR/
ISSUER

ALL
BUILDING/
AREA

SL
LEVELS/
LOCATIONS

GA
TYPE

A10
DISCIPLINE/
TRADE

900000
SEQUENCE NUMBER

A
REV

THIS BOOKLET CONTAINS :

Page 01 - TITLE

A	16.06.20	FIRST ISSUE


REV	Date	Revision Title
-----	------	----------------

ALL REVISIONS




**BOUYGUES MARK UP OF
ROLLER SHUTTERS**
12th June 2020

LEGEND

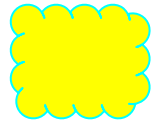

HIGHLIGHTED AREA SHOWS
LOCATION OF ROLLER SHUTTER

RESIDENTS PARKING ROLLER SHUTTER G1-HD

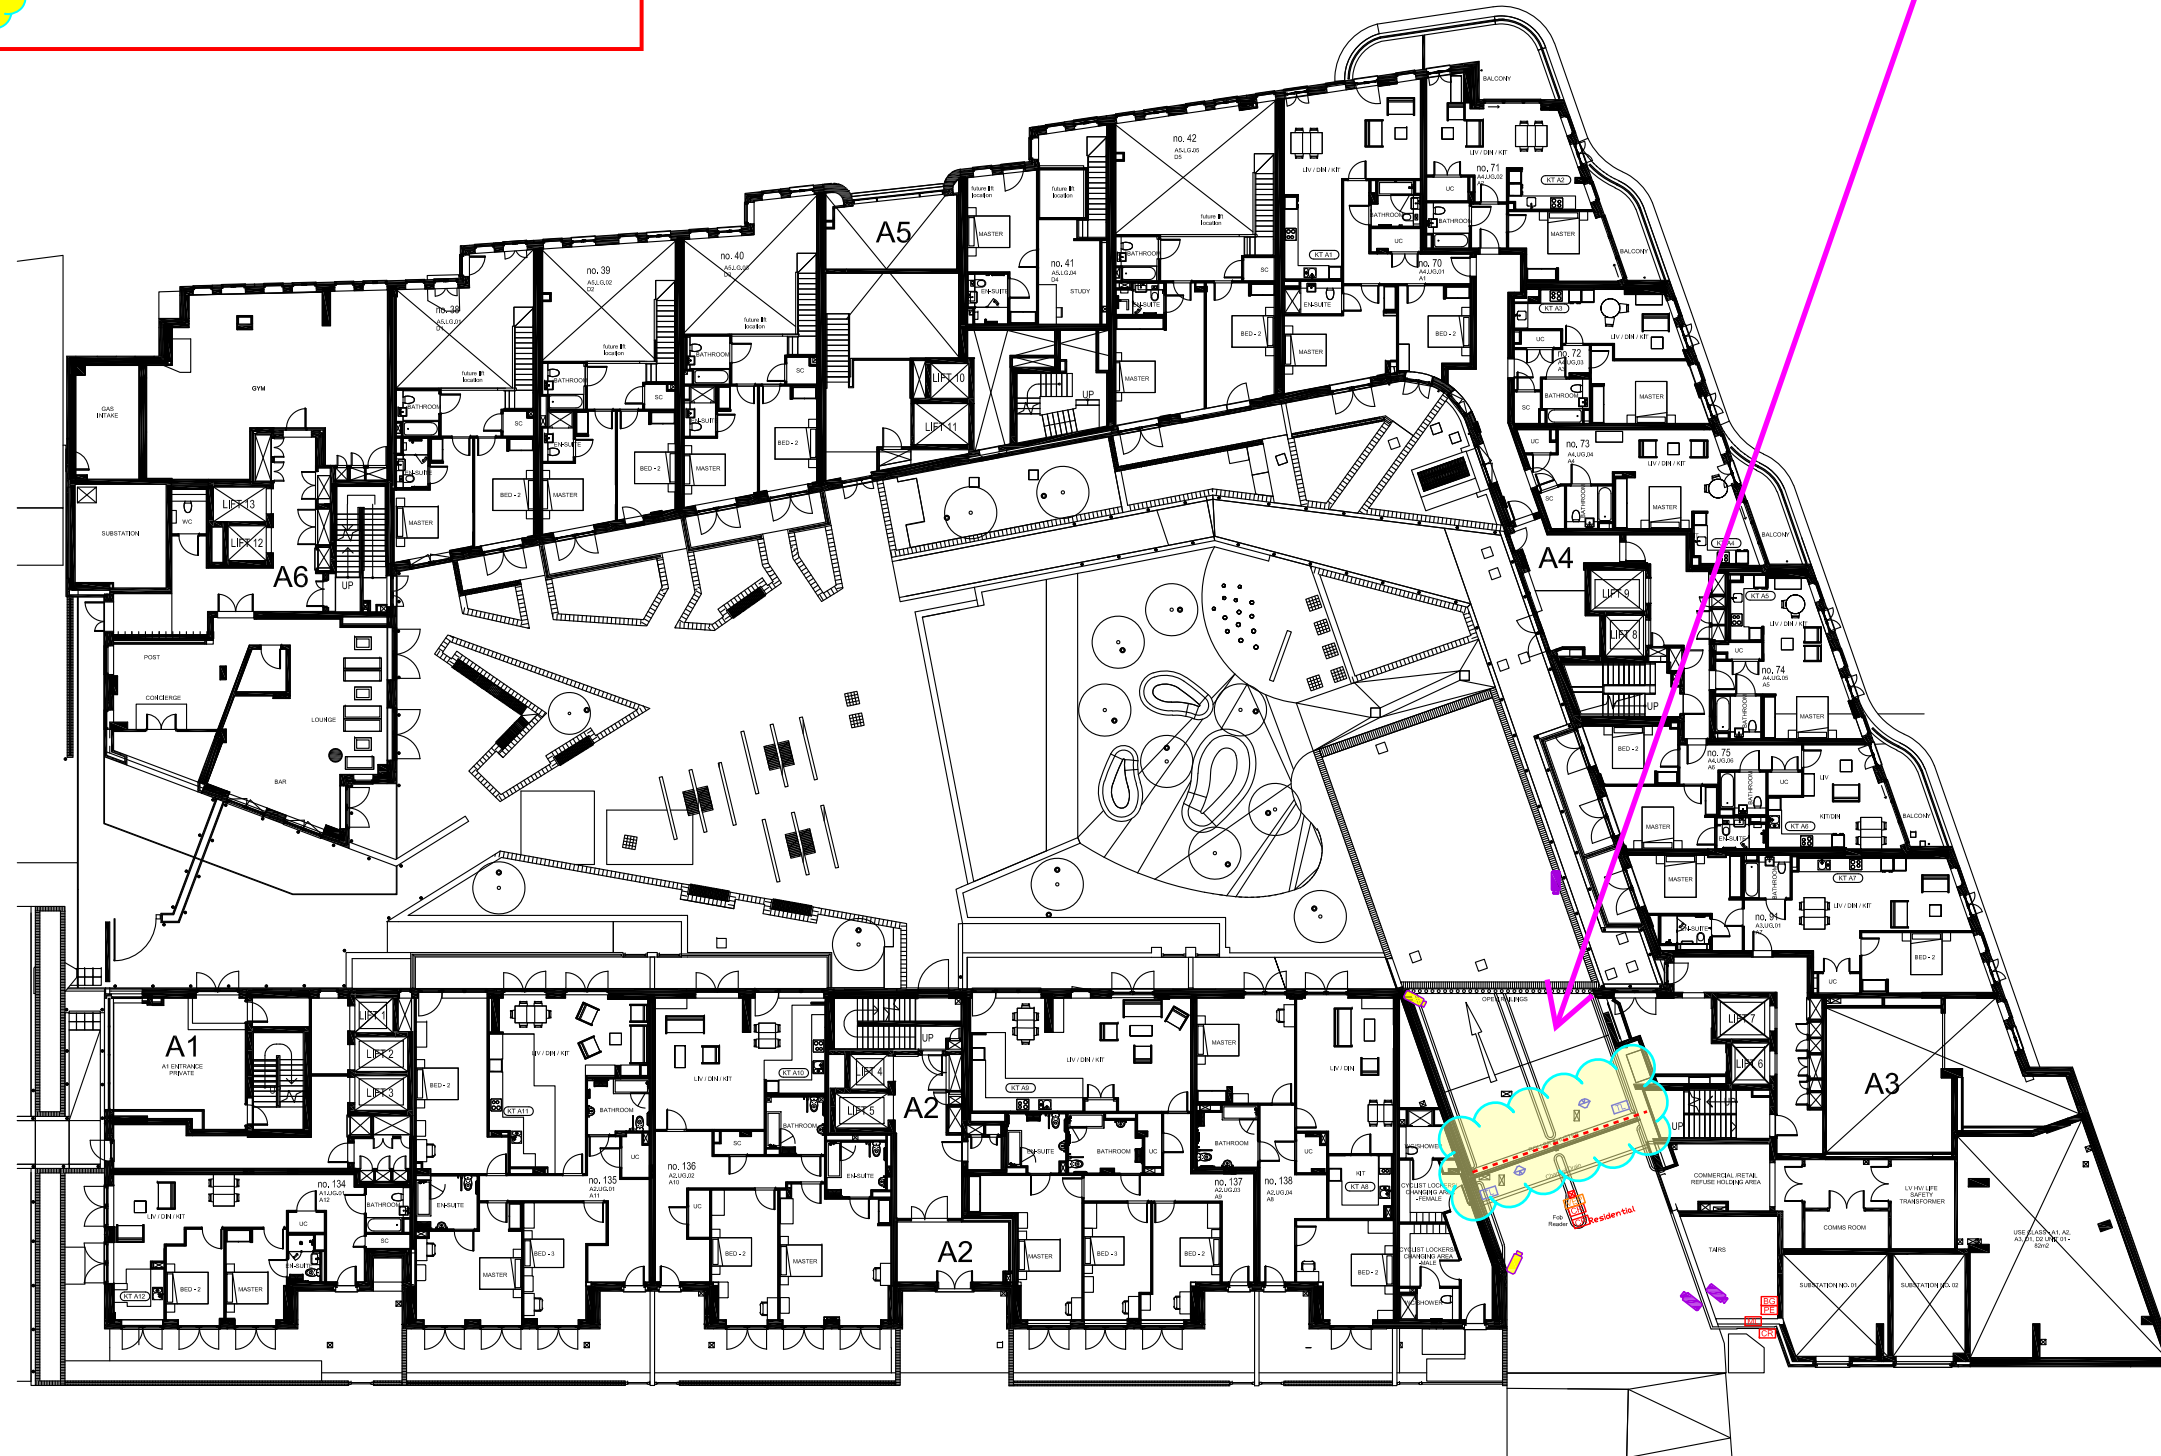

LEGEND	
	Magnetic Lock
	Proximity Card Reader
	Push To Exit Button
	Emergency Break Glass Unit
	Video Entry Panel
	Static CCTV Camera
	Detector
	Traffic Lights
	Residential CCTV

C1	Issued For Comment	19/02/20
Rev	Comments	Date

CLIENT Cilantro

PROJECT Mount Pleasant
Phoenix Place
Block A (P1)

CONTRACTOR **WLS**
 WLS Ltd
 TEL: 020 8676 4300 22-36 Paxton Place
 E-MAIL: info@wls.ltd London
 WEBSITE: www.westlondonsecurity.com SE27 9SS

DRAWING TITLE Upper Ground Floor
Royal Mail Security Systems Layouts

Name	Signature	Date	SCALE	DRAWING STATUS
Designed			NTS	FOR COMMENT
Drawn By	DB		REVISION	DATE
Checked	JC		C1	19/02/20
Approved	JC			

DRAWING REFERENCE
WLS / LD121 / SEC / UG / 002




BOUYGUES MARK UP OF ROLLER SHUTTERS
12th June 2020

LEGEND



HIGHLIGHTED AREA SHOWS LOCATION OF ROLLER SHUTTERS AND AUTOMATIC BARRIERS

RESIDENTS PARKING ROLLER SHUTTER G1-HD

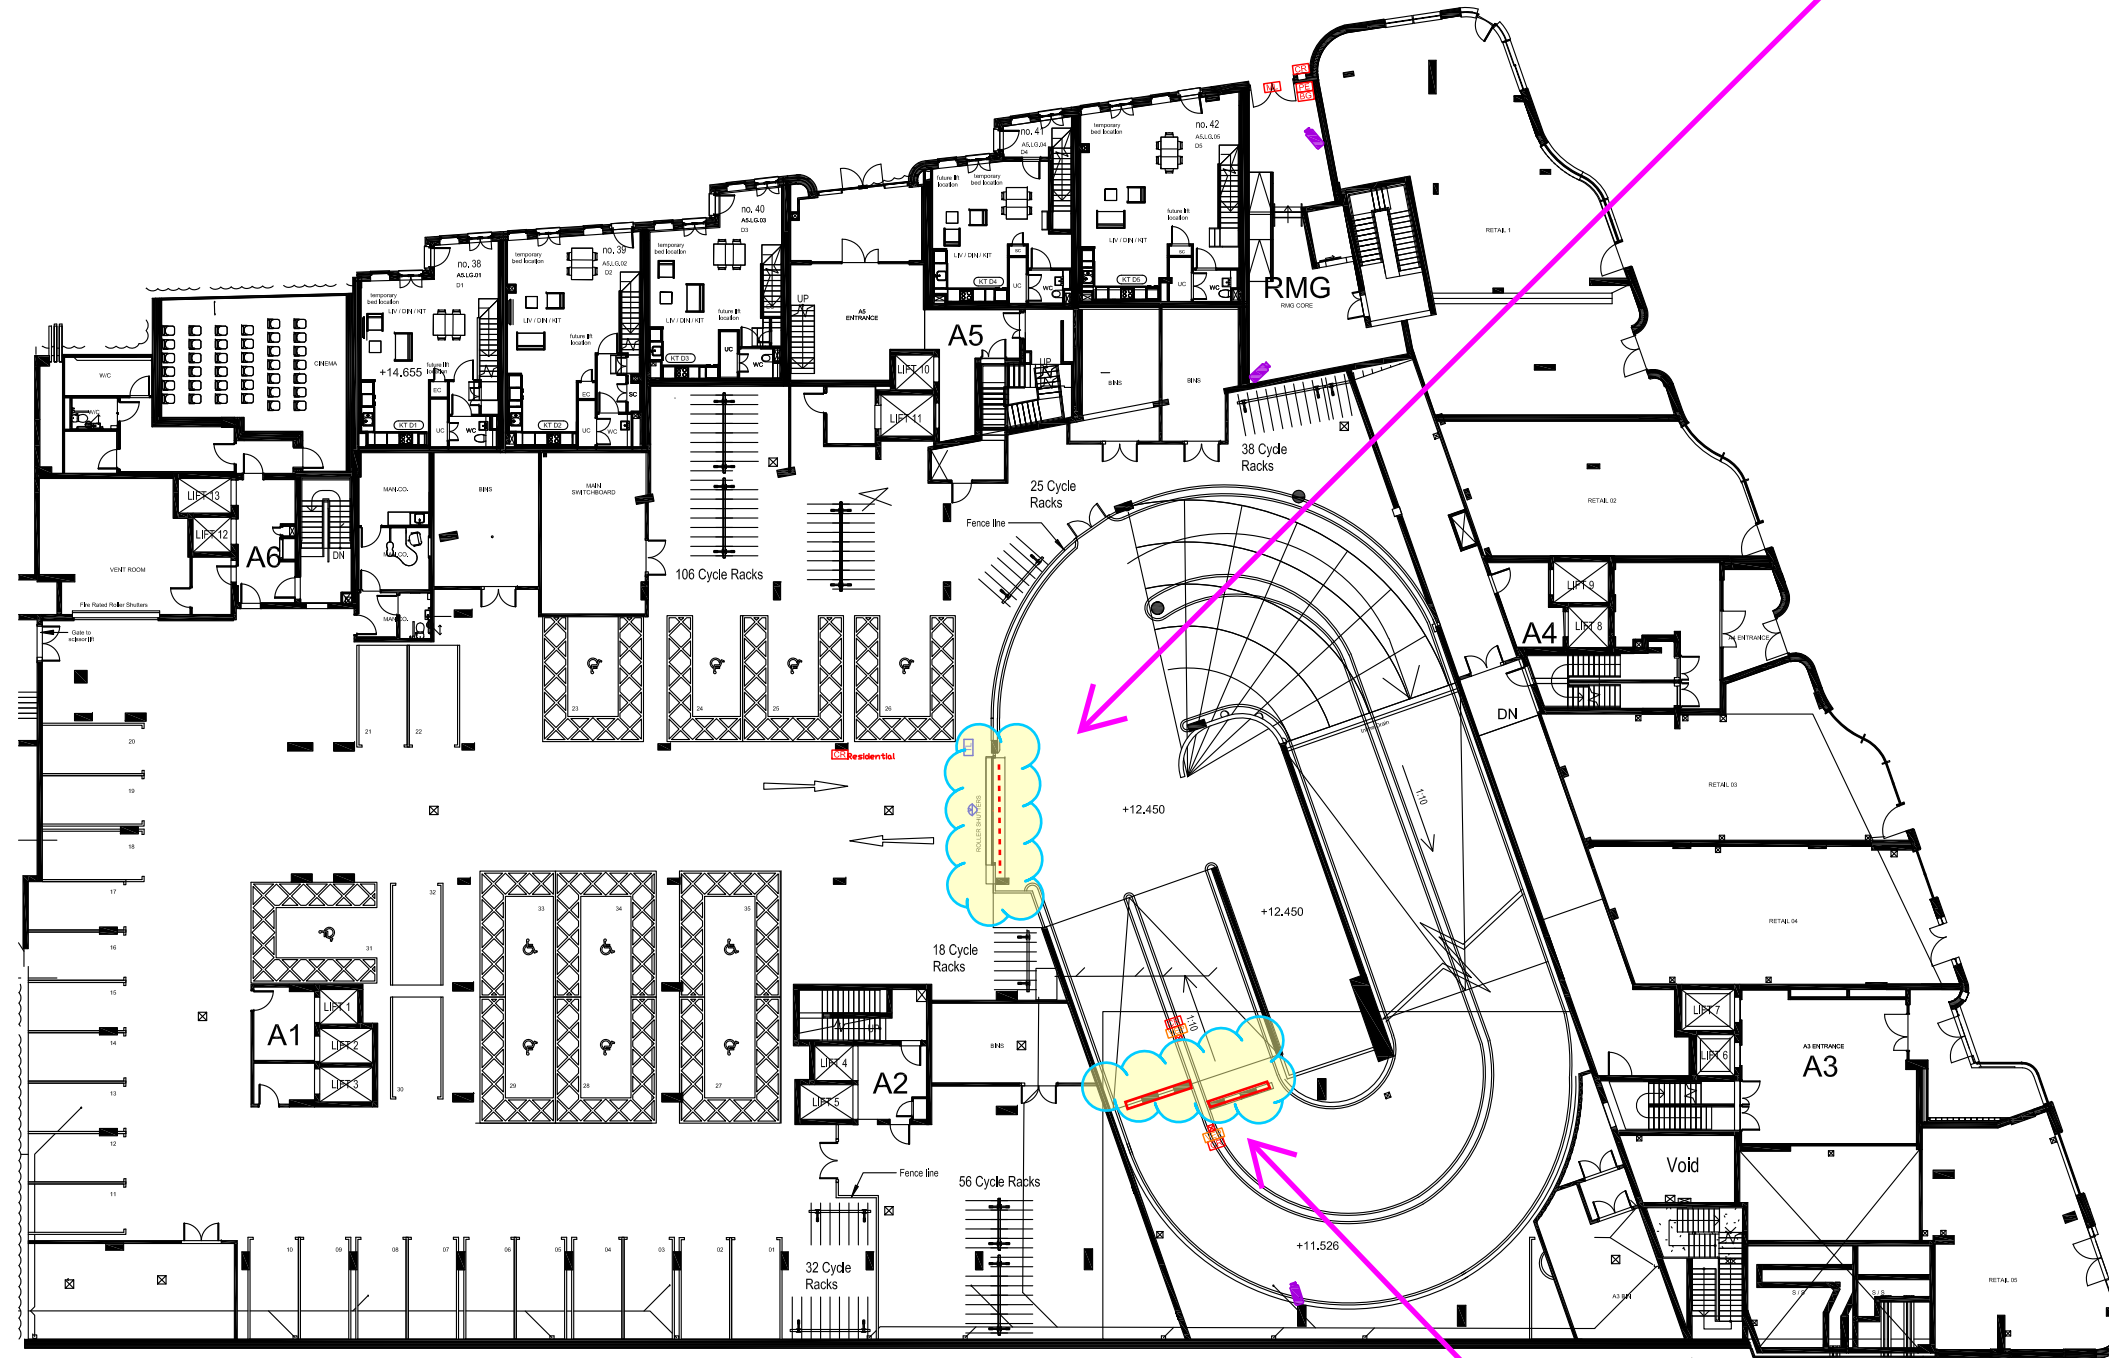

RMG PARKING BARRIERS - FAAC 620 AUTOMATIC BARRIERS

LEGEND	
	Magnetic Lock
	Proximity Card Reader
	Push To Exit Button
	Emergency Break Glass Unit
	Video Entry Panel
	Static CCTV Camera
	Detector
	Traffic Lights

C1	Issued For Comment	19/02/20
Rev	Comments	Date

WLS

Creating safe space

CLIENT Cilantro

PROJECT Mount Pleasant
Phoenix Place
Block A (P1)

CONTRACTOR **WLS**
WLS Ltd
TEL: 020 8676 4300
E-MAIL: info@wls.ltd
WEBSITE: www.westlondonsecurity.com
22-36 Paxton Place
London
SE27 9SS

DRAWING TITLE Lower Ground Floor
Royal Mail Security Systems Layouts

Name	Signature	Date	SCALE	DRAWING STATUS
Designed			NTS	FOR COMMENT
Drawn By	DB		REVISION	DATE
Checked	JC		C1	19/02/20
Approved	JC			

DRAWING REFERENCE
WLS / LD121 / SEC / LG / 002