




Head Office:
Becket House
1 Lambeth Palace Road
London SE1 7EU
Tel: 020 7401 0020

Taylor Wimpey Central London

KEY PLAN:

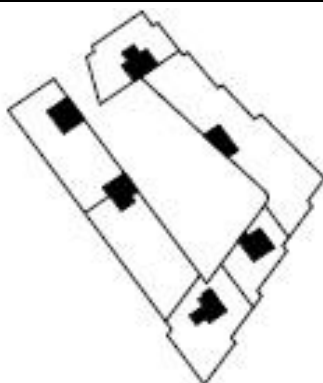

Mount Pleasant - Phase 1

Plans detailing the location of the roller shutters, fire shutter and automatic barriers

	Name	Signature	Date
Designed by	---		
Drawn by	DAPO		16.06.20
Checked	---		
Approved	---		

NTS @ A4
SCALE & FORMAT

For Review
PROPOSED STATUS

16.06.20
DATE OF 1ST ISSUE

FILE NAME

MP1
PROJECT

BYG
ORIGINATOR/ ISSUER

ALL
BUILDING/ AREA

SL
LEVELS/ LOCATIONS

GA
TYPE

A10
DISCIPLINE/ TRADE

900001
SEQUENCE NUMBER

A
REV

THIS BOOKLET CONTAINS :

Page 01 - TITLE

A	16.06.20	FIRST ISSUE


REV	Date	Revision Title
-----	------	----------------

ALL REVISIONS




BOUYGUES MARK UP OF
ROLLER SHUTTERS
A.PETRASEVIC 21/04/2020

LEGEND

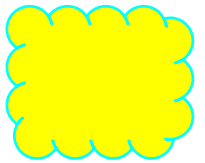

HIGHLIGHTED AREA SHOWS
LOCATION OF ROLLER DOOR

MAIN ENTRANCE ROLLER SHUTTER G1-HD

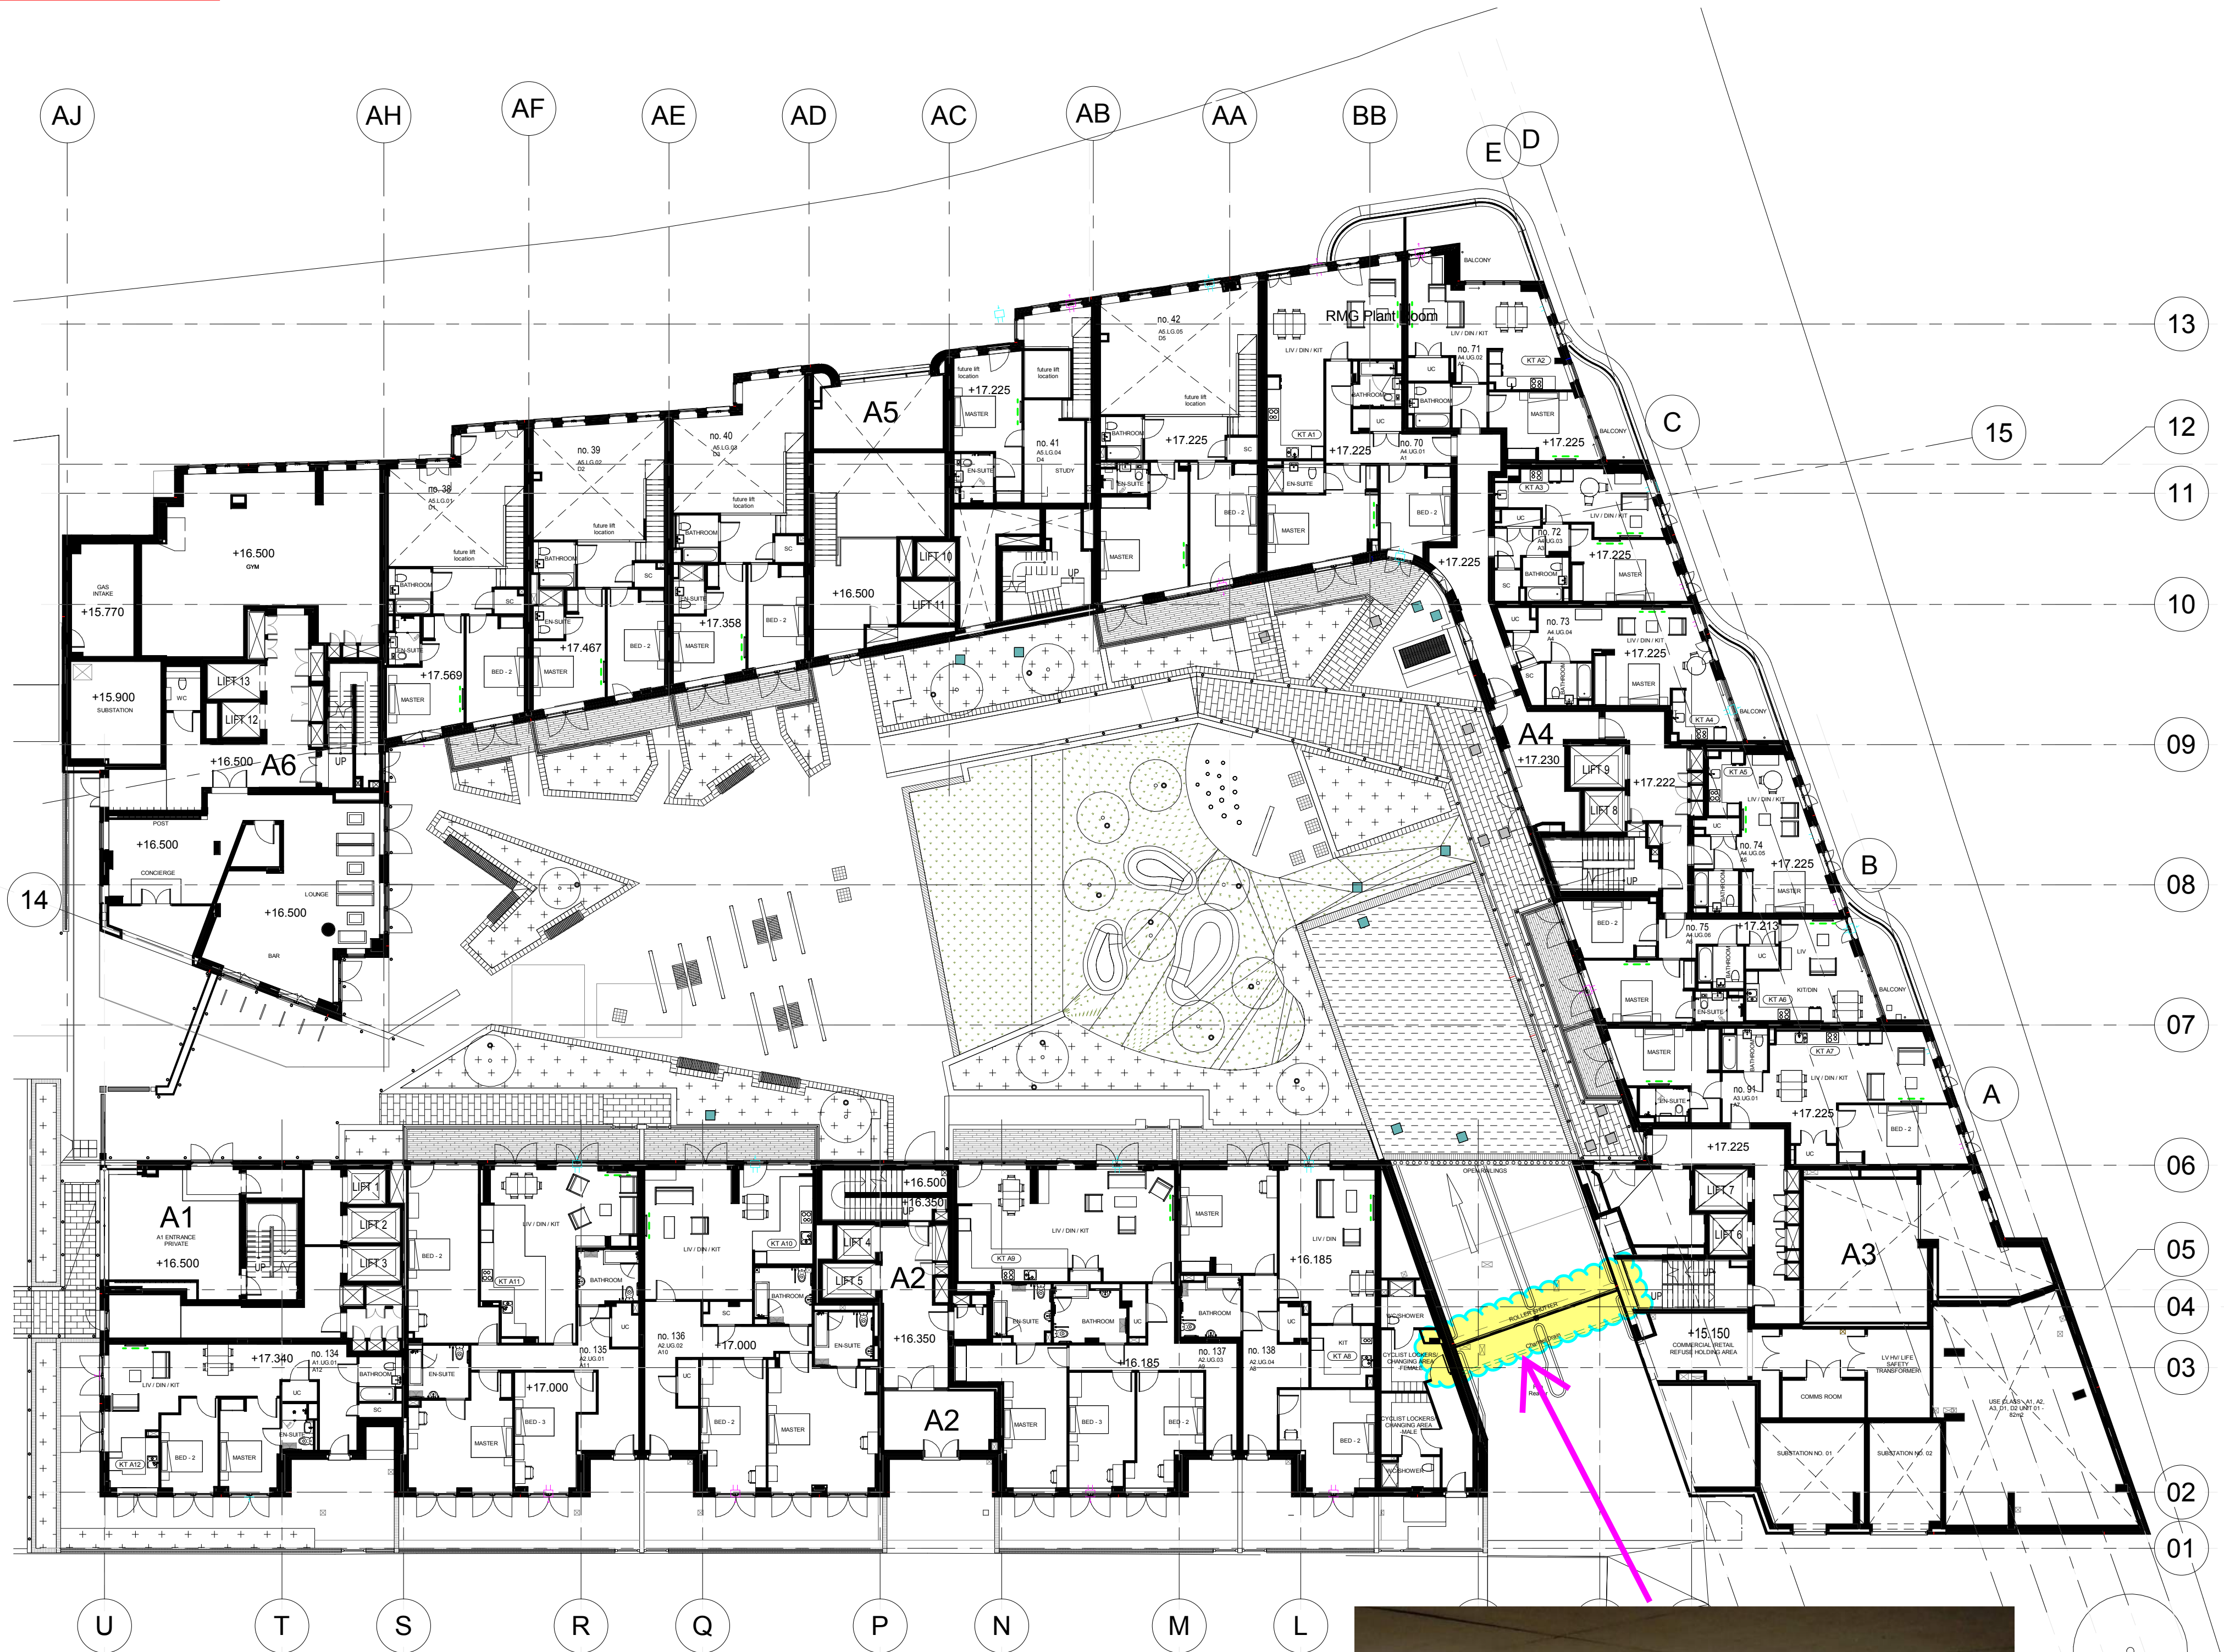

1 00 Upper Ground Level GA
Scale 1 : 200



Reference list:

Notes:
Copyright of this drawing and contents remain with Broadway Malyan.
Do not scale from drawing.
The contractor and all sub-contractors have to verify dimensions on site prior to the commencement of any works.
Any discrepancies are to be reported to the Architect / Supervising Officer immediately. If in doubt - seek clarification.

All work must comply with the current Building Regulations. No materials are to be used or method of workmanship employed unless conformity with the current Codes of the Practice & British Standards is ensured.

Refer to drawings:

- MP1-BMA-ALL-SL-GA-A31-903xxx for Site Layout Plans
- MP1-BMA-ALL-SL-SEC-A31-904xxx for GA Sections
- MP1-BMA-ALL-SL-ELV-A31-905xxx for External Elevations
- MP1-BMA-ALL-xx-GA-A31-921xxx for External Wall Setting Out
- MP1-BMA-ALL-xx-GA-A31-921xxx for External Door & Windows References
- MP1-BMA-ALL-xx-GA-A31-922xxx for Dry Lining Setting Out & Internal Door Ref.
- MP1-BMA-ALL-xx-GA-A31-935xxx for Reflected Ceiling Plans
- MP1-BMA-ALL-xx-GA-A31-968xxx for Fire Strategy Plans
- MP1-BMA-ALL-SL-SCH-A31-973500 for Kitchen Types Specifications


Rev	DATE	REVISION HISTORY	Dsg	Drw	Chk	App
N	06.12.19	Drawing amended following comments				
M	28.02.19	Builders works update				
L	04.02.19	Added notes, Lift Numbers, Apartment numbers, FFL information, Stairs runs, Room names and updated Roof plant locations				

ALL REVISIONS

CLIENT LOGO

**Taylor Wimpey**
Central London

www.bouygues-uk.com

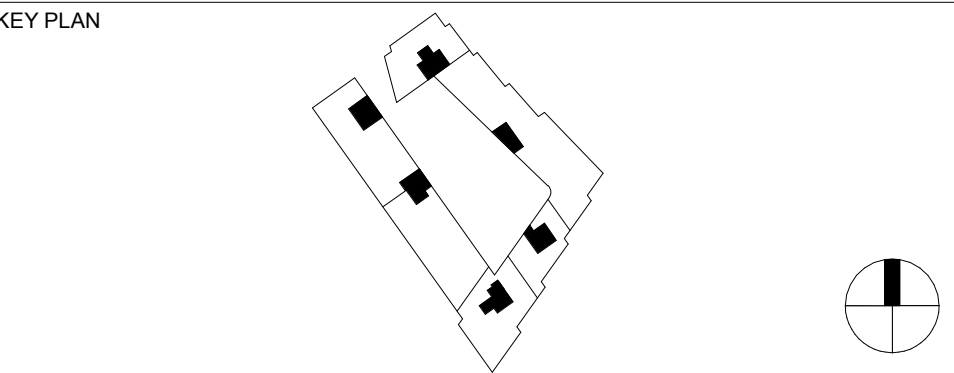

ORIGINATOR

BroadwayMalyan^{BM}
2 Castle Street, Castlefield, Manchester. M3 4LZ.
0161 819 2277

DRAWING TITLE

Mount Pleasant Phase 1
Upper Ground Plan

	Name	Signature	Date
Designed by	BMA	Broadway Malyan	06.12.19
Drawn by	VA	V. Alyas for Broadway Malyan	06.12.19
Checked	SMC	S. mcallen Broadway Malyan	06.12.19
Approved	SMC	s.mc allen Broadway Malyan	06.12.19

SCALE	@ A1	BIM FILE NAME	---
As indicated			
FIRST ISSUE DATE	03/06/18	PROPOSED STATUS	For Construction

PROJECT	ISSUER	AREA	LEVEL	TYPE	TRADE	SEQUENCE	REV
MP1	BMA	BA1	UG	GA	A31	103003	N



BOUYGUES MARK UP OF
ROLLER SHUTTERS
A.PETRASEVIC 21/04/2020

LEGEND



HIGHLIGHTED AREA SHOWS
LOCATION OF ROLLER DOOR

RESIDENTS PARKING ROLLER SHUTTER G1-HD



RMG PARKING BARRIERS - FAAC 620 AUTOMATIC BARRIERS

1 00 Lower Ground Level GA
Scale 1 : 200

Reference list:

Notes:
Copyright of this drawing and contents remain with Broadway Malyan.
Do not scale from drawing.
The contractor and all sub-contractors have to verify dimensions on site prior to the commencement of any works.
Any discrepancies are to be reported to the Architect / Supervising Officer immediately. If in doubt - seek clarification.

All work must comply with the current Building Regulations. No materials are to be used or method of workmanship employed unless conformity with the current Codes of the Practice & British Standards is ensured.

Refer to drawings :

MP1-BMA-ALL-SL-GA-A31-903xxx for Site Layout Plans
MP1-BMA-ALL-SL-SEC-A31-904xxx for GA Sections
MP1-BMA-ALL-SL-ELV-A31-905xxx for External Elevations
MP1-BMA-ALL-xx-GA-A31-921xxx for External Wall Setting Out
MP1-BMA-ALL-xx-GA-A31-921xxx for External Door & Windows References
MP1-BMA-ALL-xx-GA-A31-922xxx for Dry Lining Setting Out & Internal Door Ref.
MP1-BMA-ALL-xx-GA-A31-935xxx for Reflected Ceiling Plans
MP1-BMA-ALL-xx-GA-A31-968xxx for Fire Strategy Plans
MP1-BMA-ALL-SCH-A31-973500 for Kitchen Types Specifications

P	09.12.19	Drawing amended following comments			
O	19.11.19	Drawing amended following comments			
N	23.07.19	Bouygues comments incorporated. BWIC revised as instructed by the contractors and as Ciantros markup. Issued for construction			
M	29.04.19	Articulated barrier added, temp structural columns omitted			
L	28.02.19	Builders works update			

Rev	DATE	REVISION HISTORY	Dsg	Drw	Chk	App
-----	------	------------------	-----	-----	-----	-----


ALL REVISIONS



www.bouygues-uk.com

CLIENT LOGO



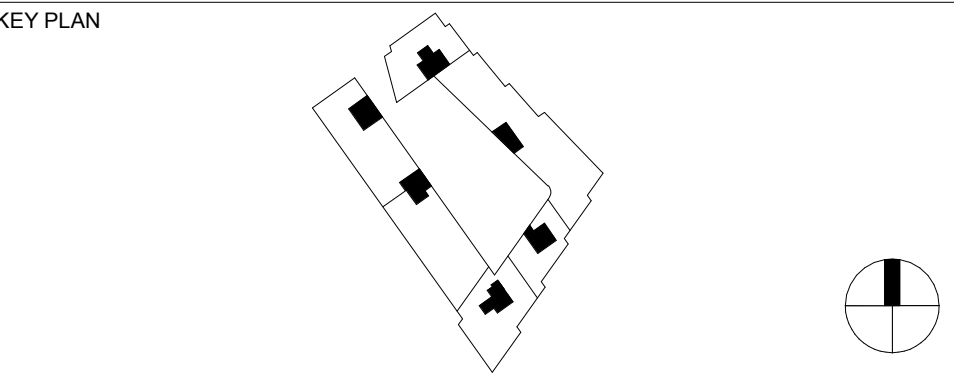

ORIGINATOR



2 Castle Street, Castlefield, Manchester. M3 4LZ.
0161 819 2277

DRAWING TITLE

Mount Pleasant Phase 1
Lower Ground Plan

	Name	Signature	Date
Designed by	BMA	Broadway Malyan	09.12.19
Drawn by	VA	V. Alyas for Broadway Malyan	09.12.19
Checked	SMC	S. mcallen Broadway Malyan	09.12.19
Approved	SMC	s.mc allen Broadway Malyan	09.12.19


SCALE	@ A1	BIM FILE NAME	---
As indicated			
FIRST ISSUE DATE	03/06/18	PROPOSED STATUS	FOR CONSTRUCTION

PROJECT	ISSUER	AREA	LEVEL	TYPE	TRADE	SEQUENCE	REV
MP1	BMA	BA1	LG	GA	A31	103002	P



BOUYGUES MARK UP OF
ROLLER SHUTTERS
A.PETRASEVIC 21/04/2020

LEGEND

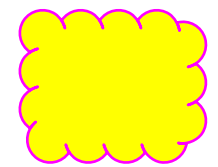

HIGHLIGHTED AREA SHOWS
LOCATION OF FIRE SHUTTER

ENERGY CENTRE FIRE SHUTTER - FG01



1 -01 Basement Level GA
Scale 1 : 200

Reference list:

Notes:

Copyright of this drawing and contents remain with Broadway Malayan.
Do not scale from drawing.
The contractor and all sub-contractors have to verify dimensions on site prior to the commencement of any works.
Any discrepancies are to be reported to the Architect / Supervising Officer immediately. If in doubt - seek clarification.

All work must comply with the current Building Regulations. No materials are to be used or method of workmanship employed unless conformity with the current Codes of the Practice & British Standards is ensured.

Refer to drawings :

MP1-BMA-ALL-SL-GA-A31-903xxx for Site Layout Plans
MP1-BMA-ALL-SL-SEC-A31-904xxx for GA Sections
MP1-BMA-ALL-SL-ELV-A31-905xxx for External Elevations
MP1-BMA-ALL-xx-GA-A31-921xxx for External Wall Setting Out
MP1-BMA-ALL-xx-GA-A31-321xxx for External Door & Windows References
MP1-BMA-ALL-xx-GA-A31-922xxx for Dry Lining Setting Out & Internal Door Ref.
MP1-BMA-ALL-xx-GA-A31-935xxx for Reflected Ceiling Plans
MP1-BMA-ALL-xx-GA-A31-968xxx for Fire Strategy Plans
MP1-BMA-ALL-SL-SCH-A31-973500 for Kitchen Types Specifications

Denotes Parking Space for Electric Car with Charging Facility


W	10.12.19	Drawing amended following comments			
V	19.11.19	Drawing amended following comments			
U	29.04.19	Whiteline corrected, Armcoat barriers added, temp. structural columns omitted			
T	01.03.19	Builders works & MEP update as per comments, Kitchen type tags added.			

Rev	DATE	REVISION HISTORY	Dsg	Drw	Chk	App
-----	------	------------------	-----	-----	-----	-----

ALL REVISIONS

www.bouygues-uk.com

CLIENT LOGO

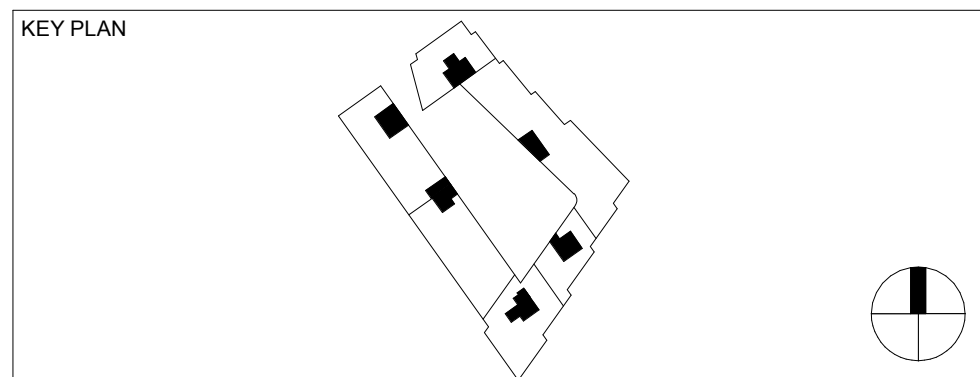

ORIGINATOR

2 Castle Street, Castlefield, Manchester. M3 4LZ.
0161 819 2277

DRAWING TITLE

Mount Pleasant Phase 1
Basement Plan

	Name	Signature	Date
Designed by	BMA	Broadway Malayan	10.12.19
Drawn by	VA	V. Alyas for Broadway Malayan	10.12.19
Checked	SMC	S. mcallen Broadway Malayan	10.12.19
Approved	SMC	s.mc allen Broadway Malayan	10.12.19

SCALE	@ A1	BIM FILE NAME	---
As indicated			
FIRST ISSUE DATE	03/06/18	PROPOSED STATUS	REVIEW

PROJECT	ISSUER	AREA	LEVEL	TYPE	TRADE	SEQUENCE	REV
MP1	BMA	BA1	BAS	GA	A31	103001	W