


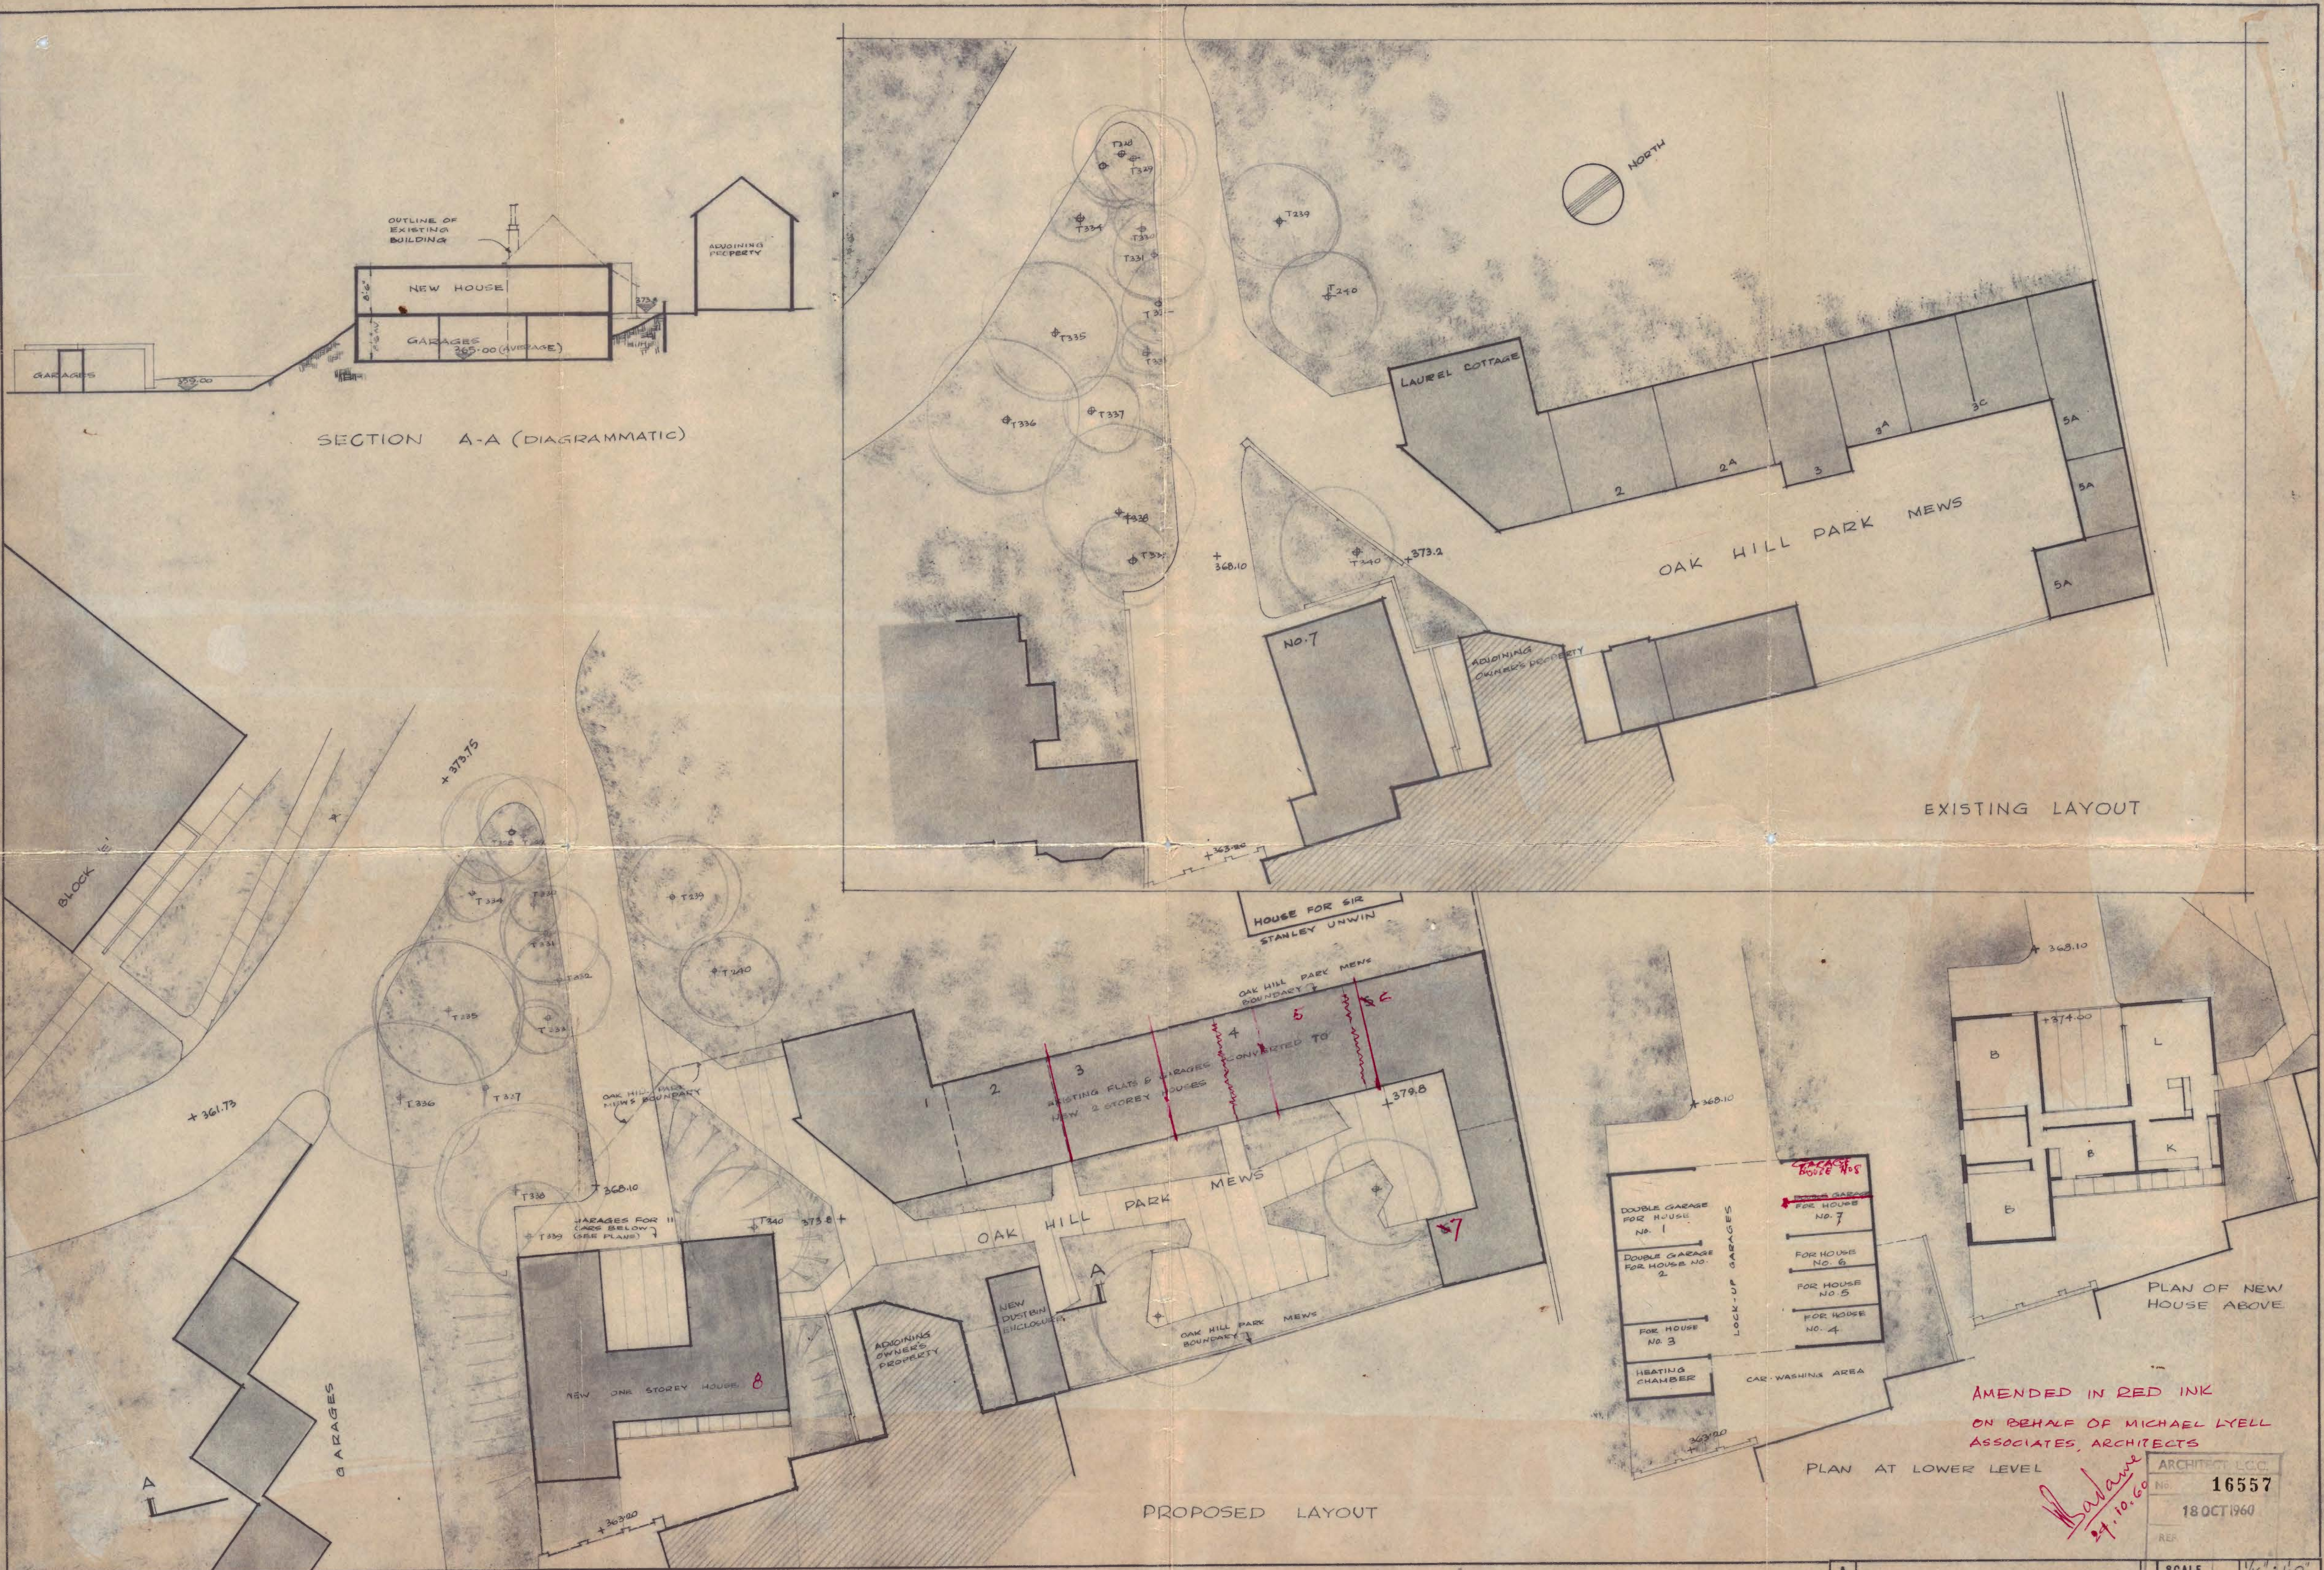

Michael Lyell ARIBA AA(Hons)Dipl
CHARTERED ARCHITECT
 16 YEOMANS ROW · BROMPTON ROAD · LONDON SW3 · KENSINGTON 9259

REDEVELOPMENT OF OAK HILL PARK, HAMPSTEAD, N.W. 3

A B C D E	SCALE	1/16" = 1'-0"
	DRAWN BY	VVB
	DATE	30.9.60
	JOB CODE	DRG. No. REV.
	OPM	10

AMENDED IN RED INK
 ON BEHALF OF MICHAEL LYELL
 ASSOCIATES, ARCHITECTS

Barrow
 24.10.60

ARCHITECT LCC.
 No. 16557
 18 OCT 1960
 REF