


HAMPSTEAD ROAD



All dimensions to be verified on site by Main Contractor before the start of any shop drawings or work whatsoever either on their own behalf or that of sub-contractors.  
Report any discrepancies to the Contract Administrator at once.  
This drawing is to be read with all relevant Architect's and Engineer's drawings and other relevant information.  
© Ingleton Wood LLP

LEGEND: DO NOT SCALE

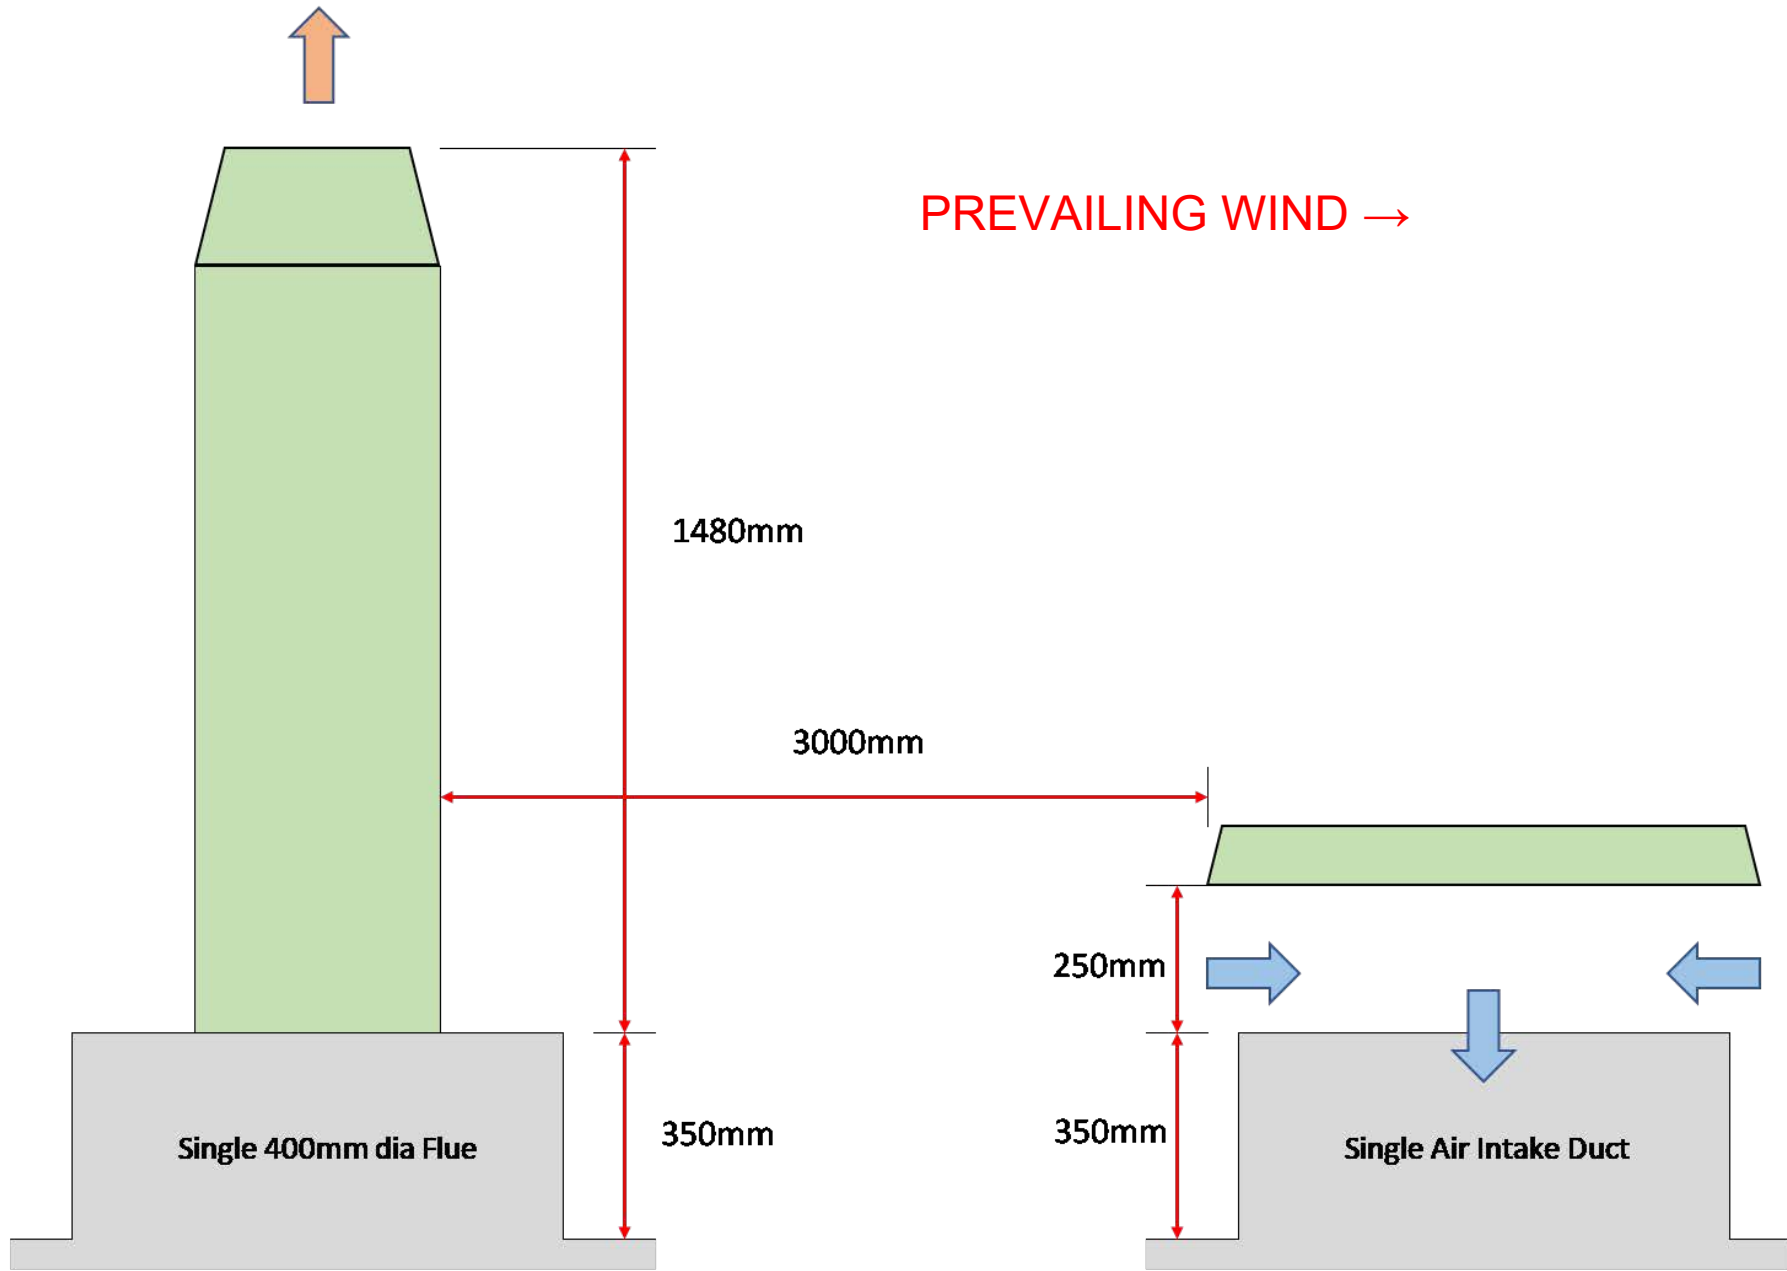

| Rev | Date | Description | AS  | NK  |
|-----|------|-------------|-----|-----|
|     |      |             | Chk | App |



**Billerica**  
**Cambridge**  
**Colchester**  
**London**  
**Norwich**

London  
1 Alle Street  
London E1 8DE  
T: 020 7680 4400  
www.ingletonwood.co.uk

Project No:  
84922

Project:  
Regents Park Estate  
Plot 2 - Rydal Water Open Space

Drawing Title:  
MVHR Information For Planning

Client:  
Lovell Partnership Ltd.

| File Ref:                              | Revision: |
|--|-----------|
| RWOS - IW - XX - ZZ - DR - M - SK27.01 |           |
| Status:                                | Scale:    |
| AB                                     | 1 : 50    |
| Purpose of Issue:                      | Size:     |
| AS BUILT                               | A1        |