



All dimensions to be verified on site by Main Contractor before the start of any shop drawings or work whatsoever either on their own behalf or that of sub-contractors.

Report any discrepancies to the Contract Administrator at once.

This drawing is to be read with all relevant Architect's and Engineer's drawings and other relevant information.

© Ingleton Wood LLP

LEGEND: DO NOT SCALE

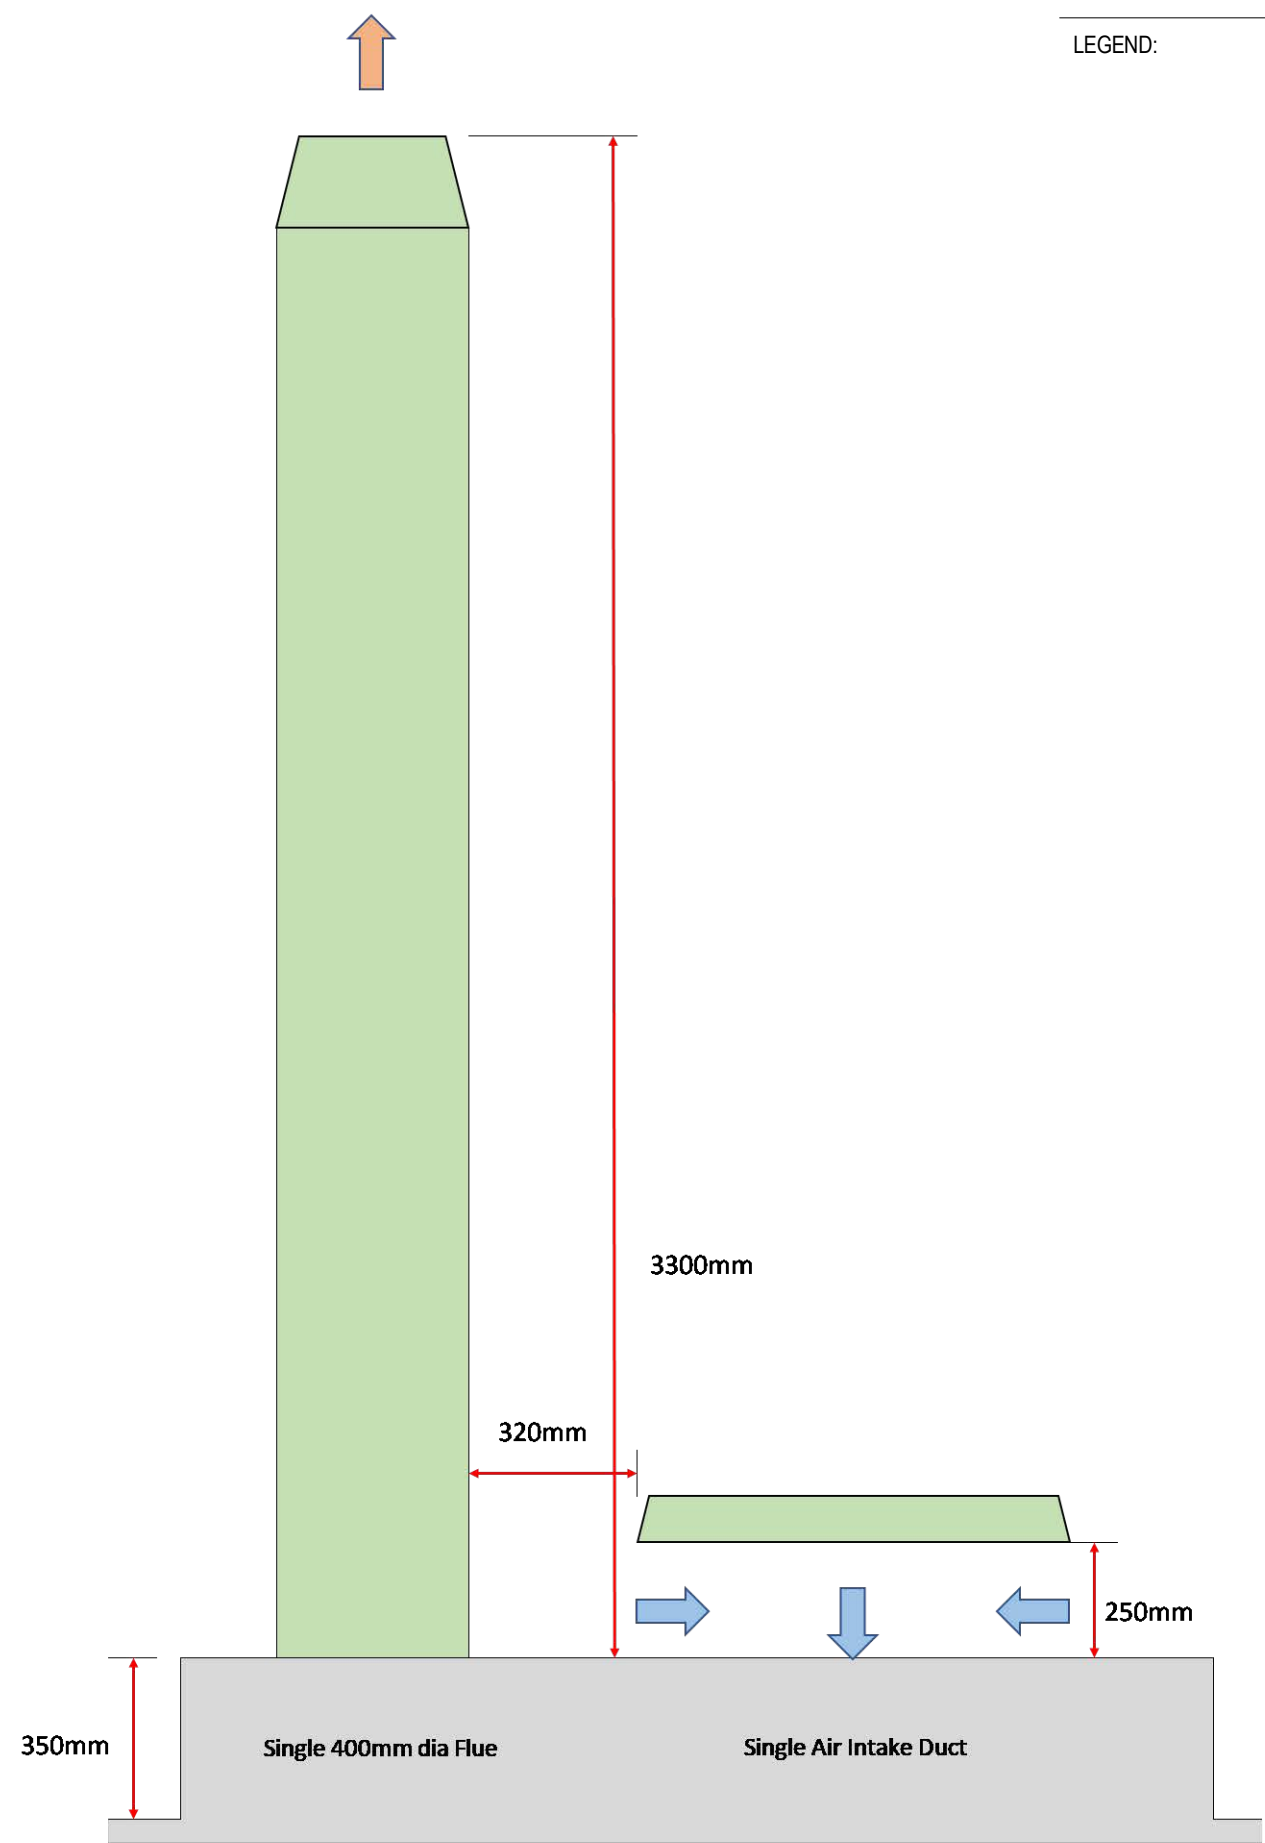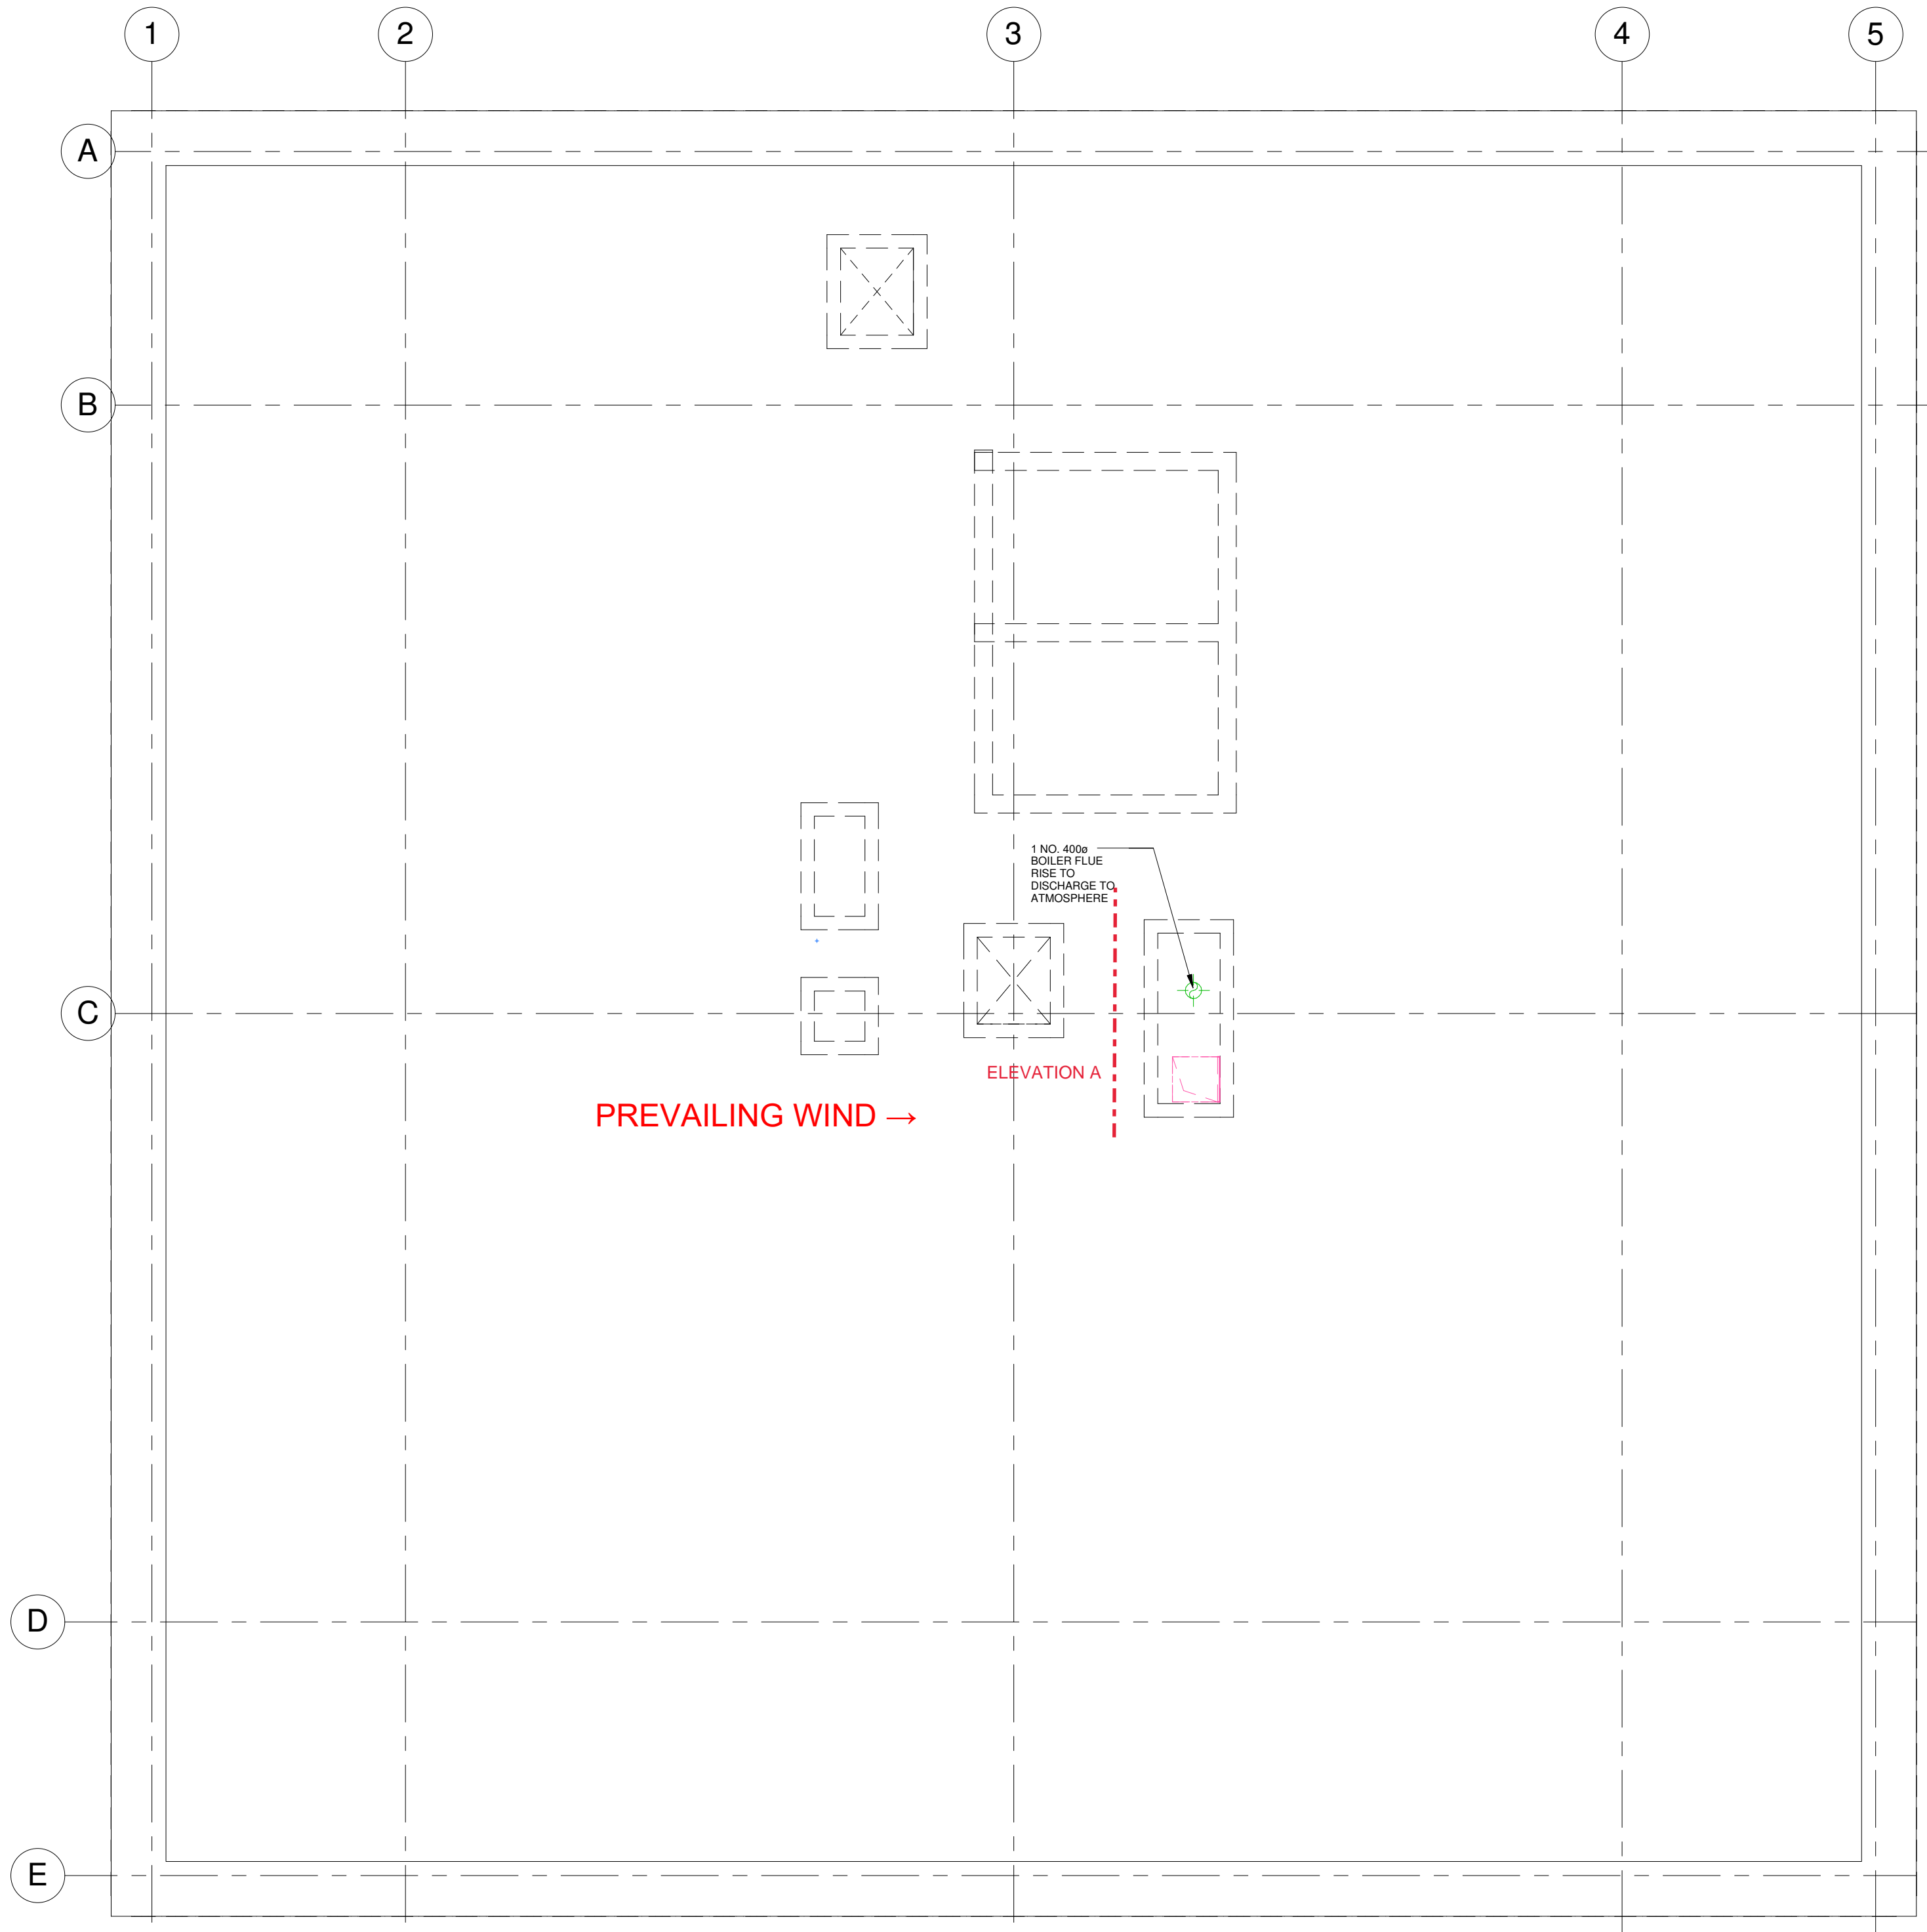

LINDALE ROOFTOP ELEVATION A



Rev	Date	Description	AS	NK



Billerica
Cambridge
Colchester
London
Norwich

London
1 Alle Street
London E1 8DE
T: 020 7680 4400
www.ingletonwood.co.uk

Project No:
84922

Project:
Regents Park Estate
Plot 4 - Newlands

Drawing Title:
Roof Mechanical Services

Client:
Lovell Partnership Ltd.

File Ref:	Revision:	
NL - IW - XX - R11 - DR - M - 27.32		
Status:	Purpose of Issue:	Scale:
AB	AS BUILT	1 : 50
Size:	A1	

1 Roof Mechanical Services
1 : 50