



PROPOSED ALTERATION TO BARTER STREET ELEVATION

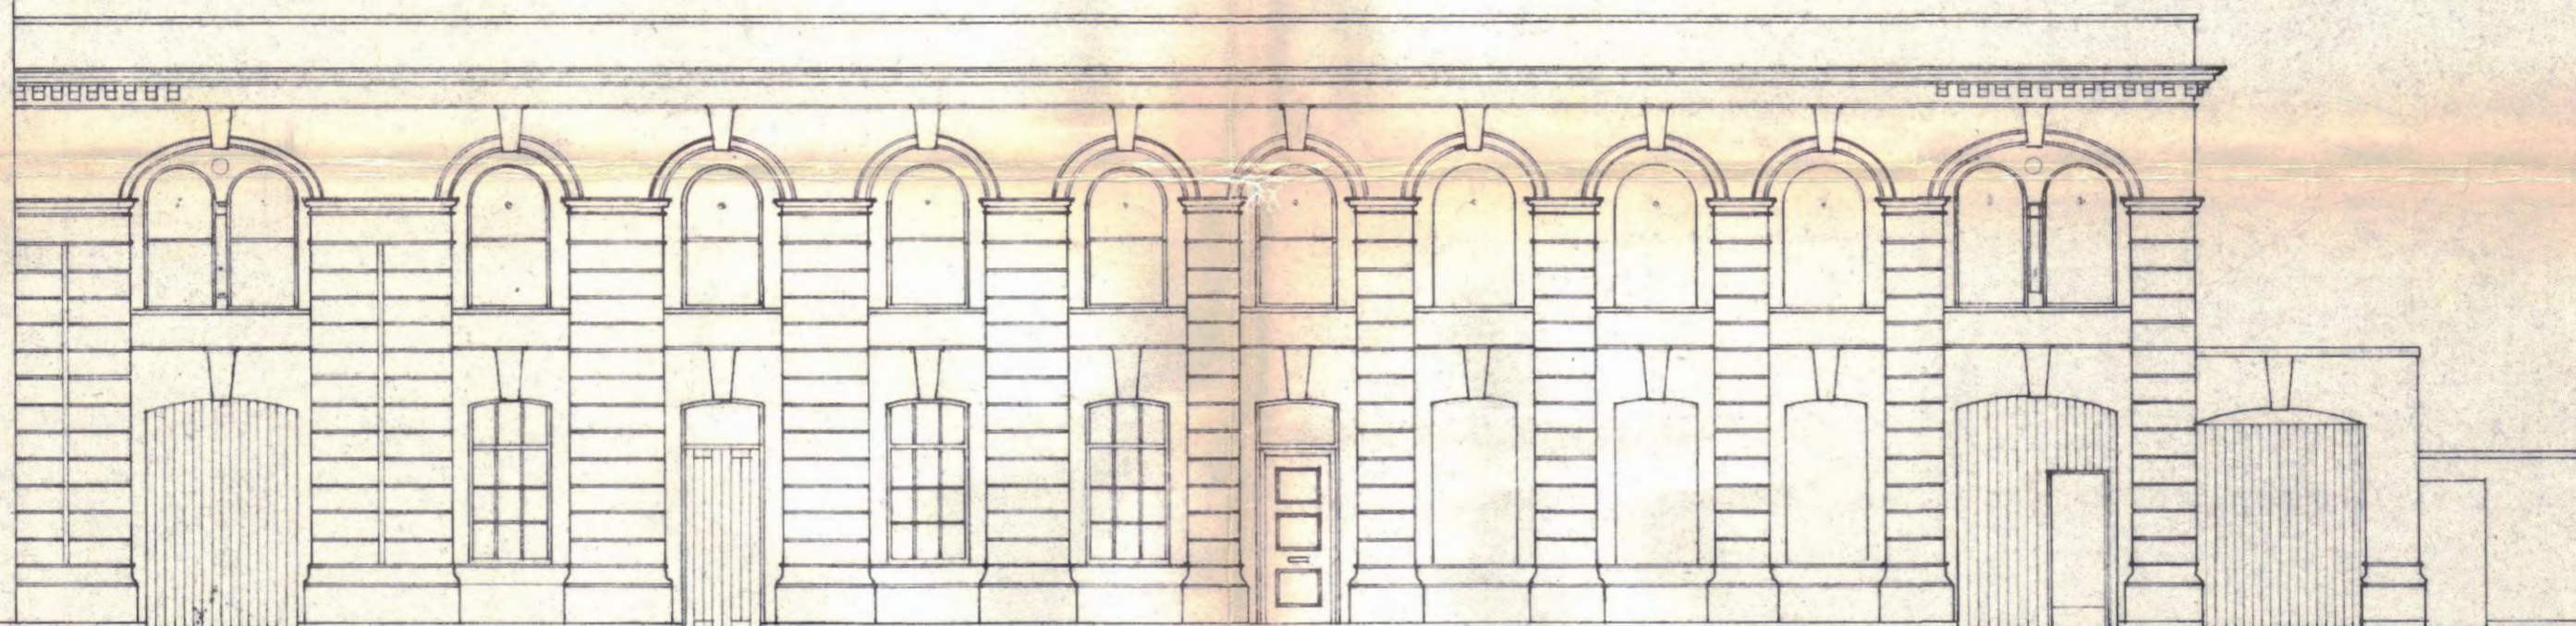

EXISTING BARTER STREET ELEVATION

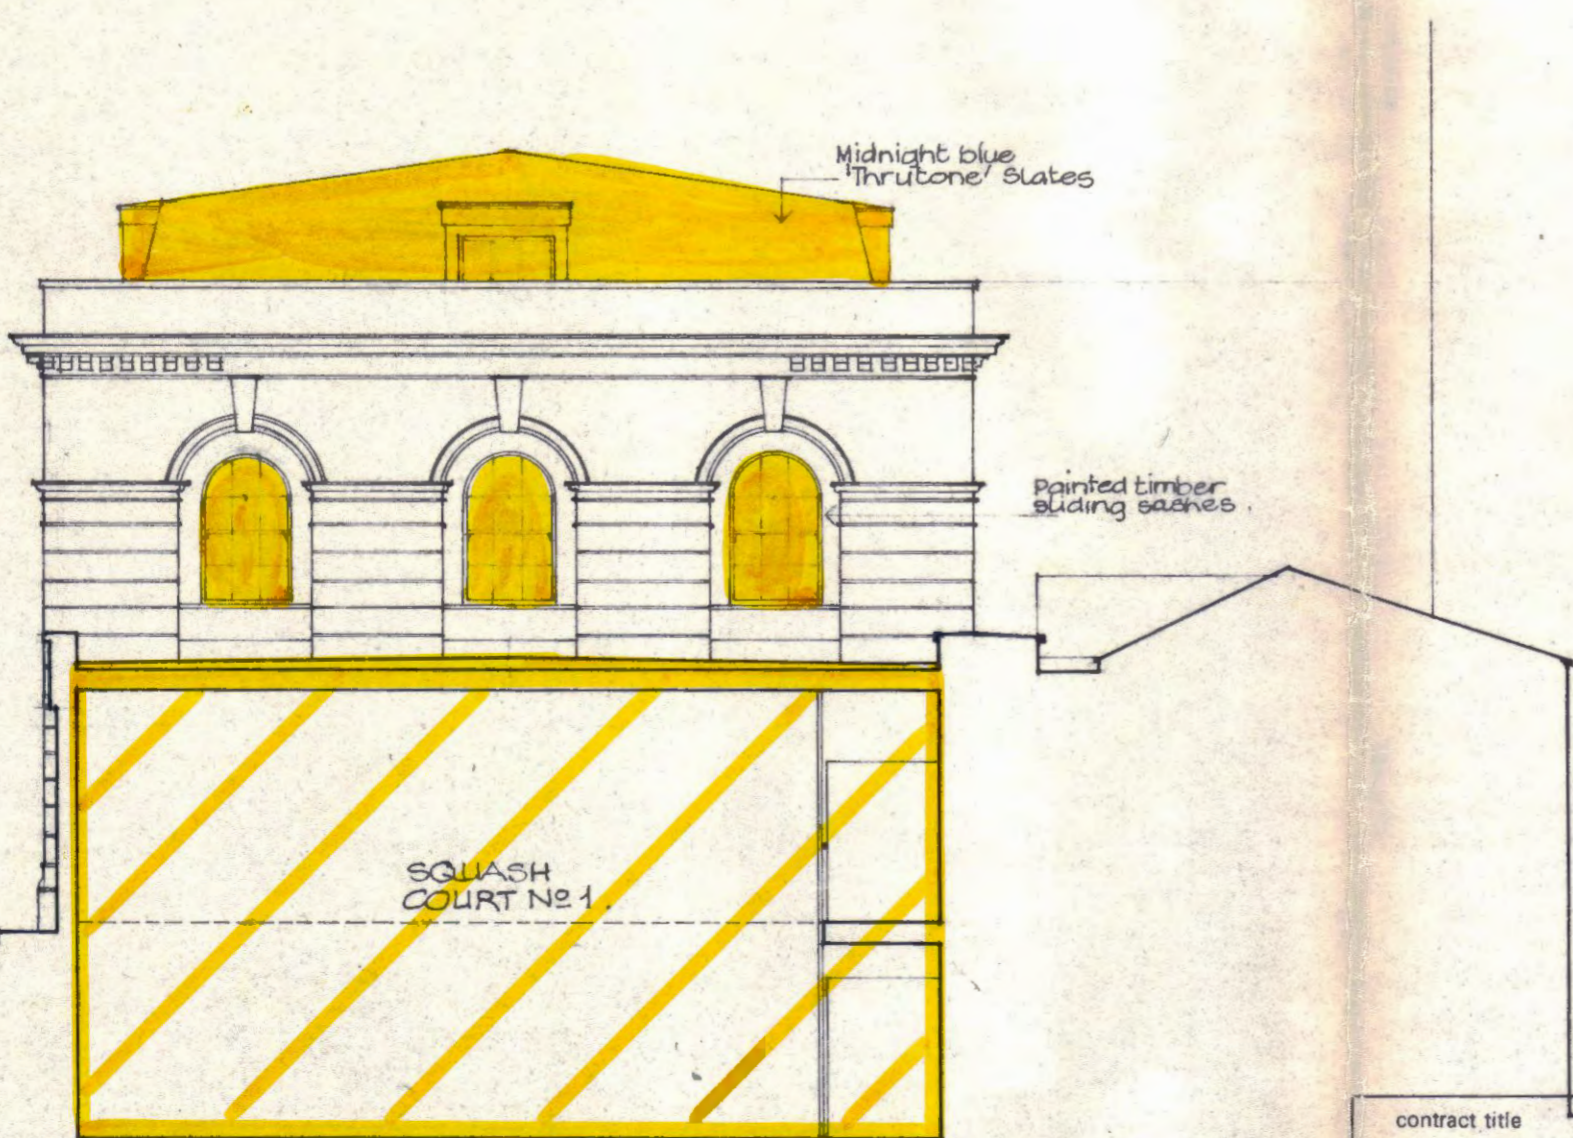


NORTH-EAST ELEVATION - Showing new Squash Court & Mansard Roof.

new work shown yellow

existing

29.1.79. A.S.

REV. A. Ent. door in proposed scheme restored to original position

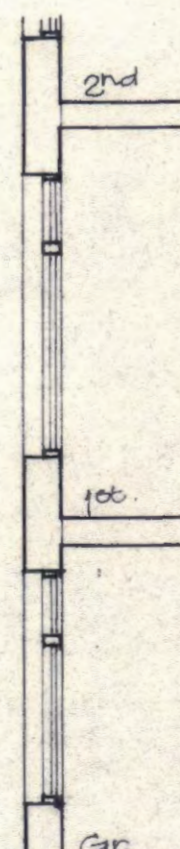

LONDON BOROUGH OF CAMDEN
TOWN AND COUNTRY PLANNING ACTS
27 JUN 1979
PLANS ~~NOT APPROVED~~ APPROVED
ON BEHALF OF THE COUNCIL

LONDON BOROUGH OF CAMDEN
TOWN AND COUNTRY PLANNING ACTS
16 MAY 1979 *Dated*
PLANS ~~NOT APPROVED~~ APPROVED
ON BEHALF OF THE CO.

2 & 3 BLOOMSBURY SQUARE

CTP/M4/23/E 127989
2482121

contract title		drawing title		scale
PROPOSED REFURBISHMENT 21, BARTER STREET		ELEVATIONS SCHEME 2		1:100
T P Bennett & Son Chartered Architects 262 High Holborn WC1V 7DU Telephone 01 405 9277		contract	drawing number	date
		5206	SK 22	Jan. 1979
				drawn
				A.S.
				revision
				A