
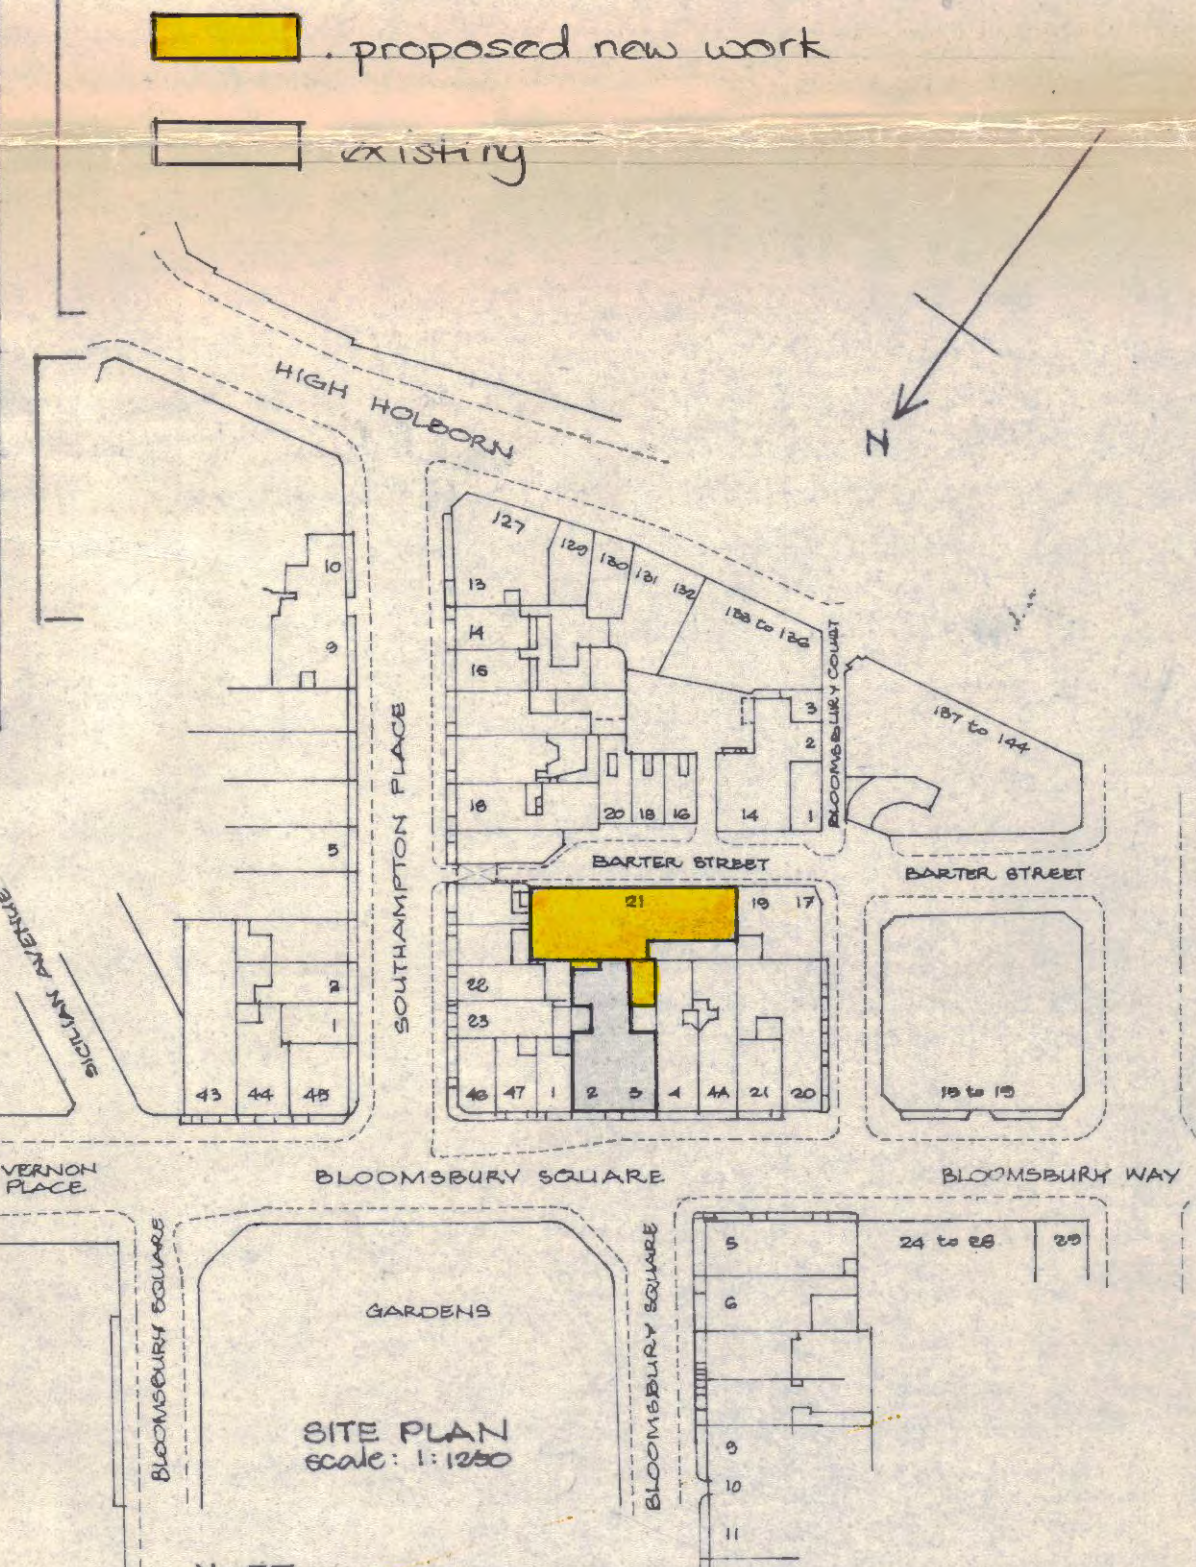
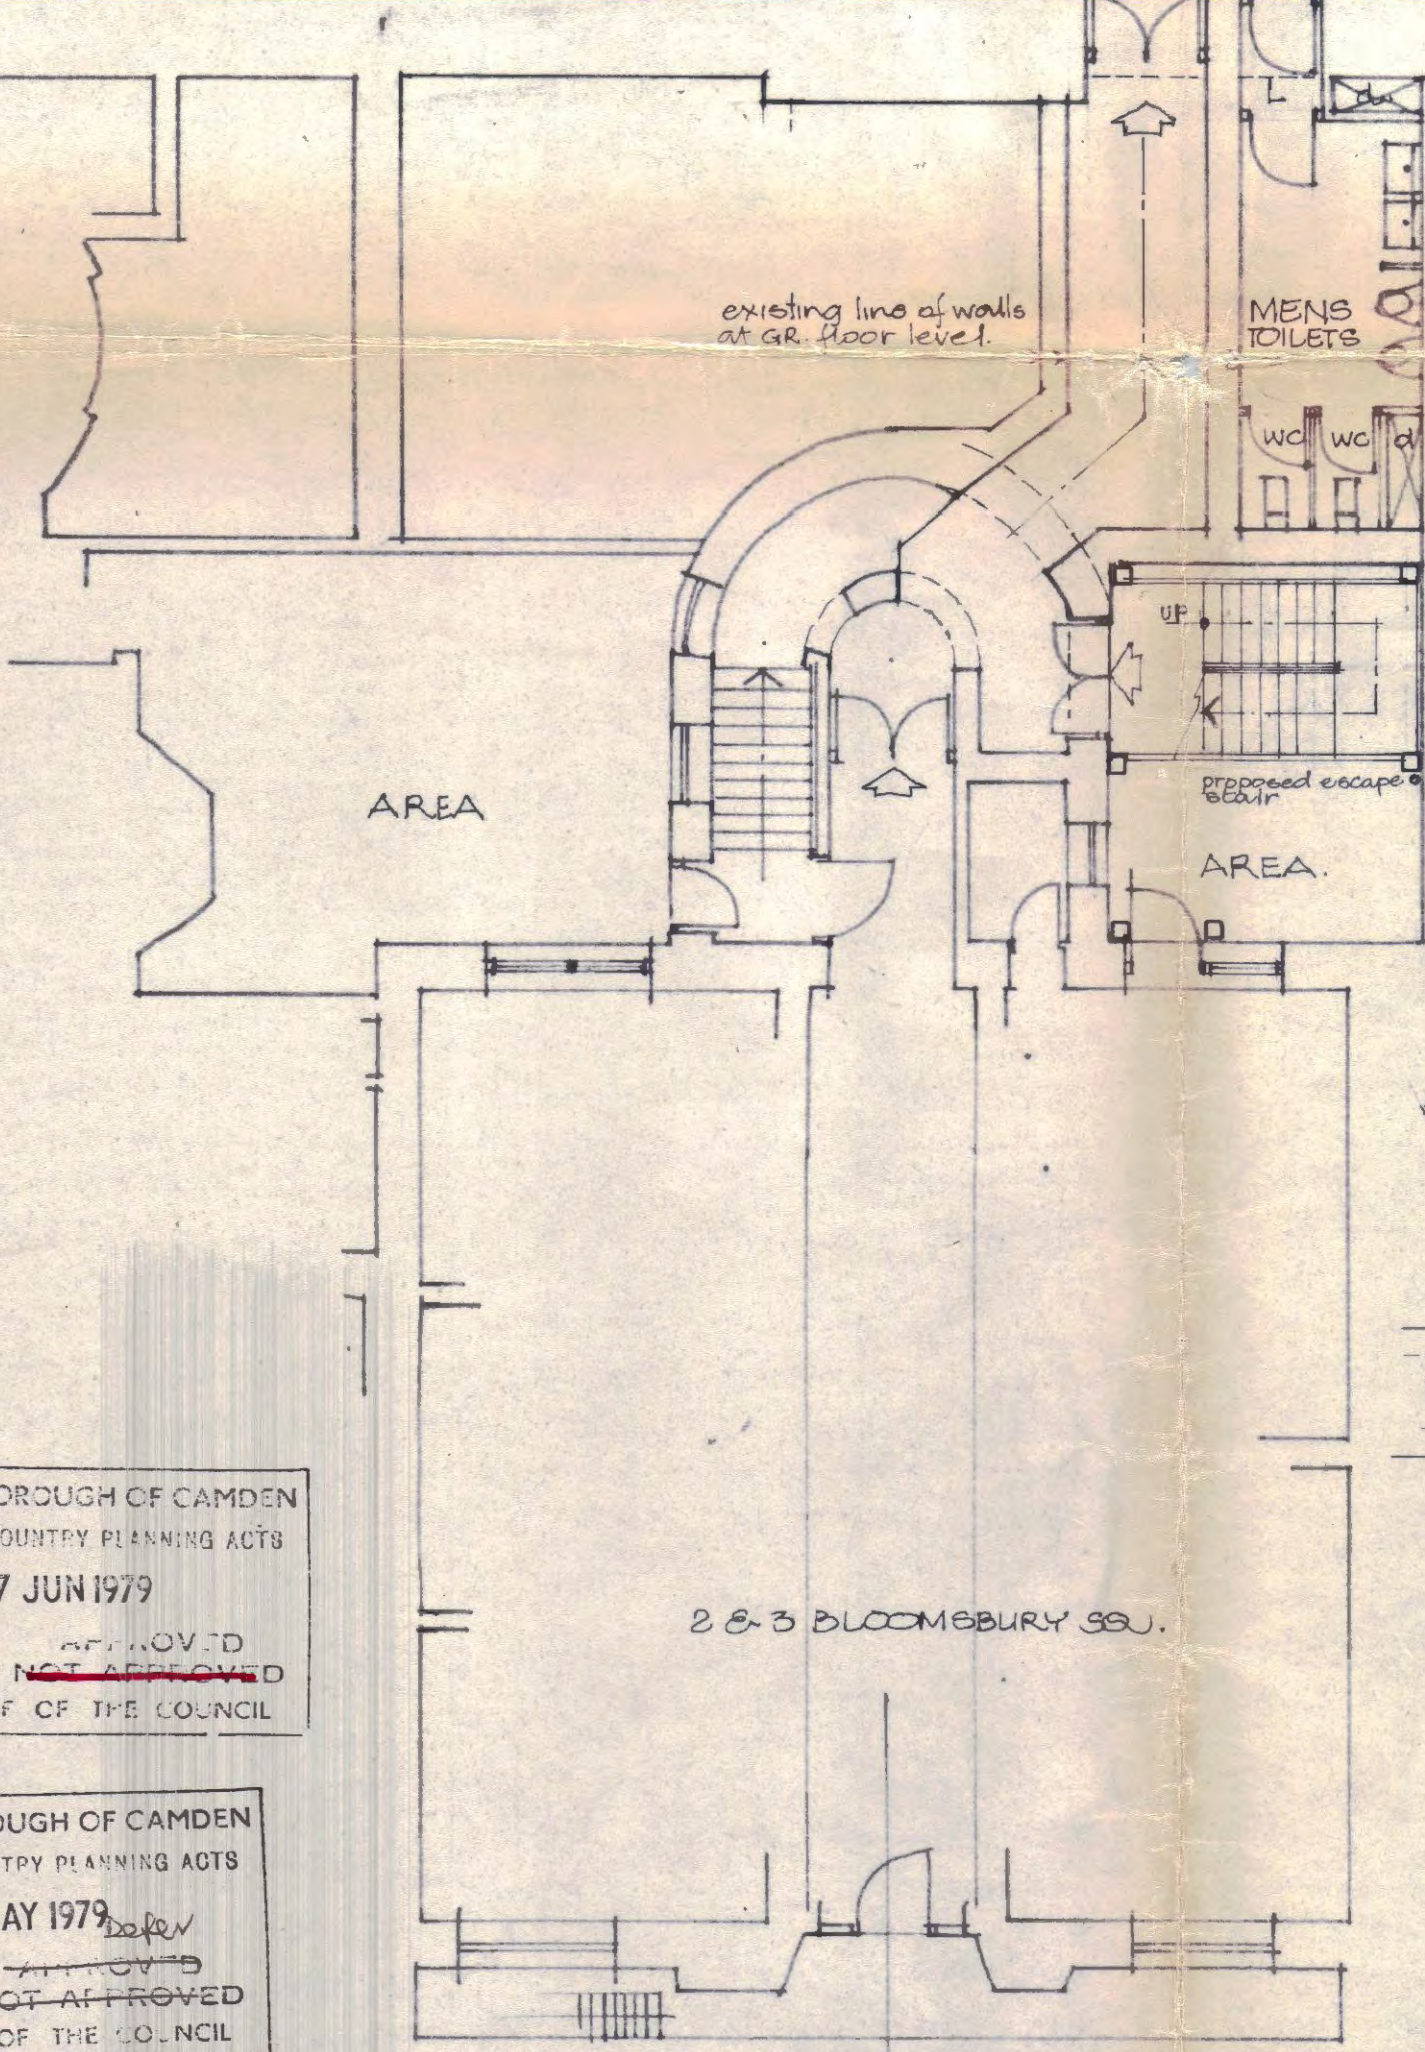


Barter Street.

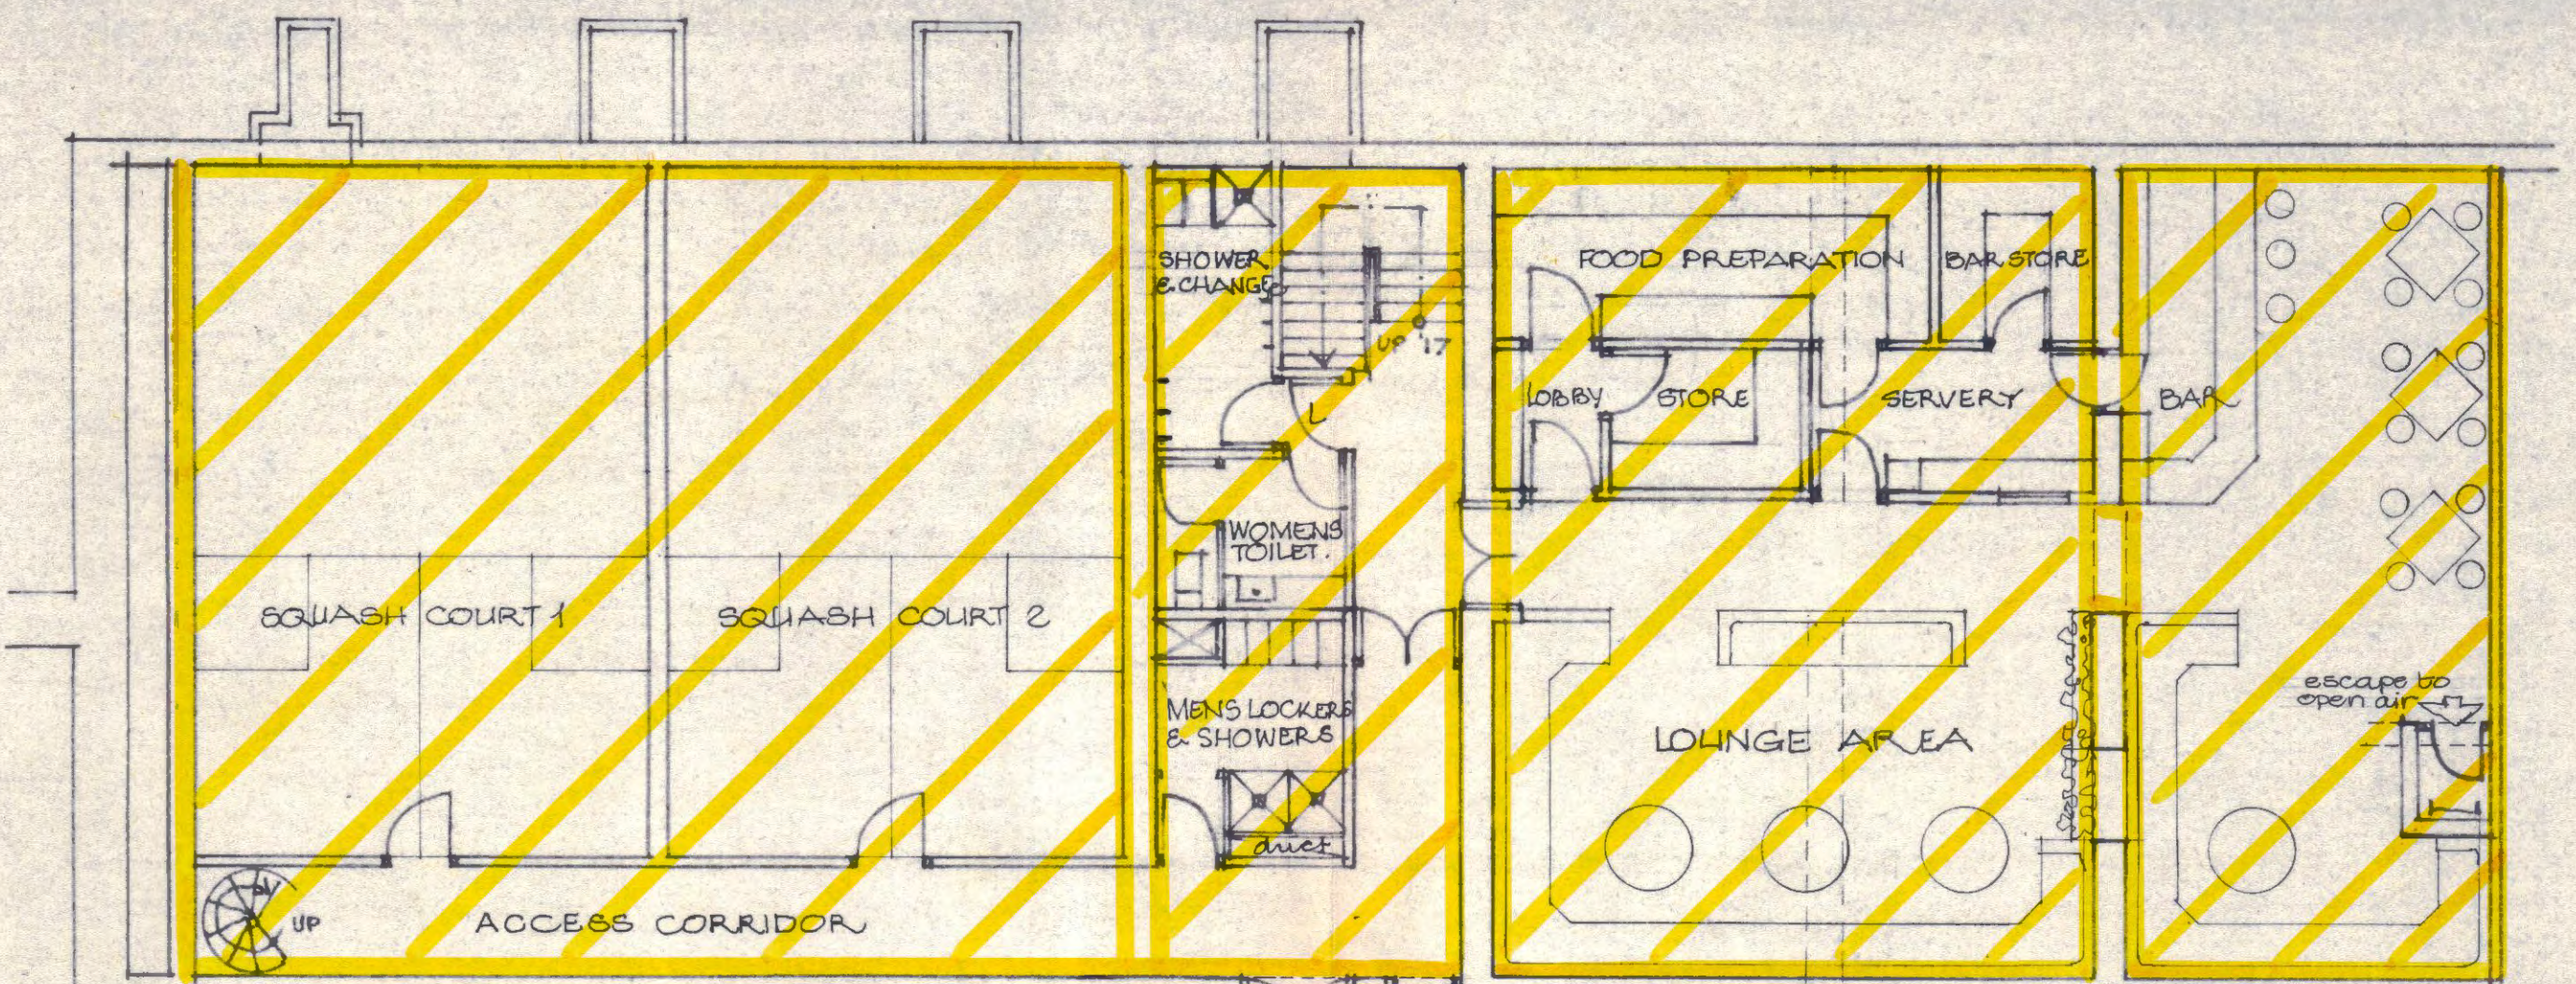

NOTE:
THIS SCHEME INCORPORATES A 'LINK' CORRIDOR WITH 2 & 3 BLOOMSBURY SQ. AND SOME TOILETS ARE SHOWN OUTSIDE 21 BARTER ST., I.E., ALONG SIDE THIS LINK

CTP/N14/23/E/27989
24782121

LONDON BOROUGH OF CAMDEN
TOWN AND COUNTRY PLANNING ACTS
27 JUN 1979
PLANS ~~NOT APPROVED~~
ON BEHALF OF THE COUNCIL

LONDON BOROUGH OF CAMDEN
TOWN AND COUNTRY PLANNING ACTS
16 MAY 1979
PLANS ~~NOT APPROVED~~
ON BEHALF OF THE COUNCIL

Bloomsbury Square

contract title	drawing title	scale
PROPOSED REFURBISHMENT 21, BARTER STREET	BASEMENT PLAN SCHEME 2	1:100
T P Bennett & Son Chartered Architects 262 High Holborn WC1V 7DU Telephone 01 405 9277	contract	date
	drawing number	DEC. 1978
	5206 SK. 11	drawn AdS
		revision
		B

Rev. B. stair & toilets altered
Rev. A. Squash courts amended